



DIVERSIFIED
energy

47-103-01656

Well Plugging Map

Legend



Well



Pits



Pad



Access Road





Public Roads

RECEIVED
Office of Oil and Gas

JUL 22 2026

WV Department of
Environmental Protection

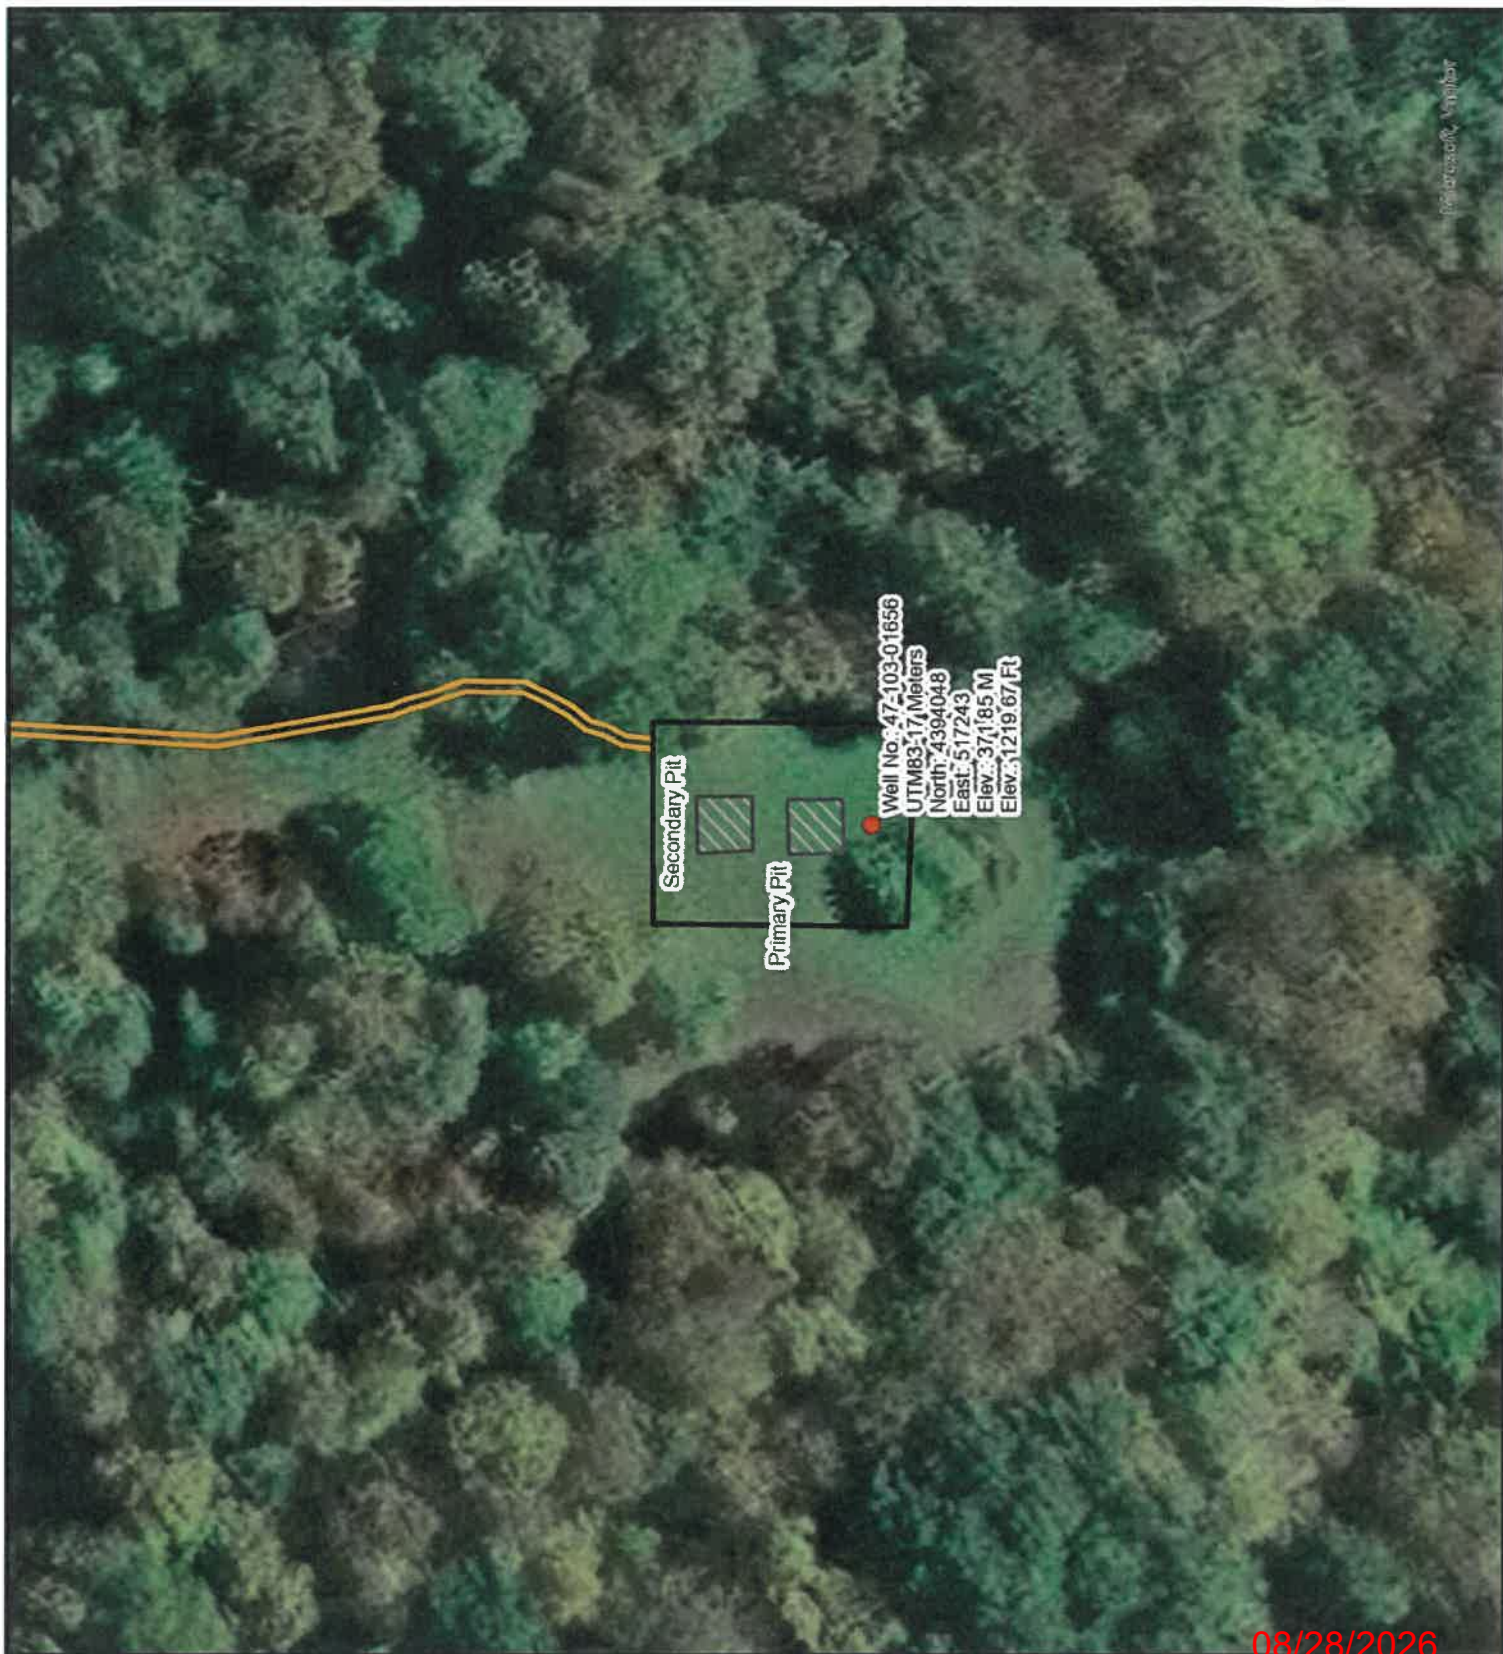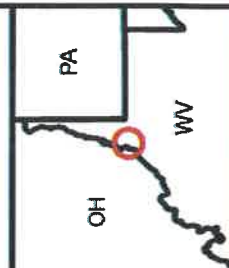

08/28/2026



DIVERSIFIED
energy

47-103-01656

Well Plugging Map

Legend



Well

Pits

Pad

Access Road

Public Roads

RECEIVED
Office of Oil and Gas


JUL 22 2026

WV Department of
Environmental Protection

PA

WV

OH

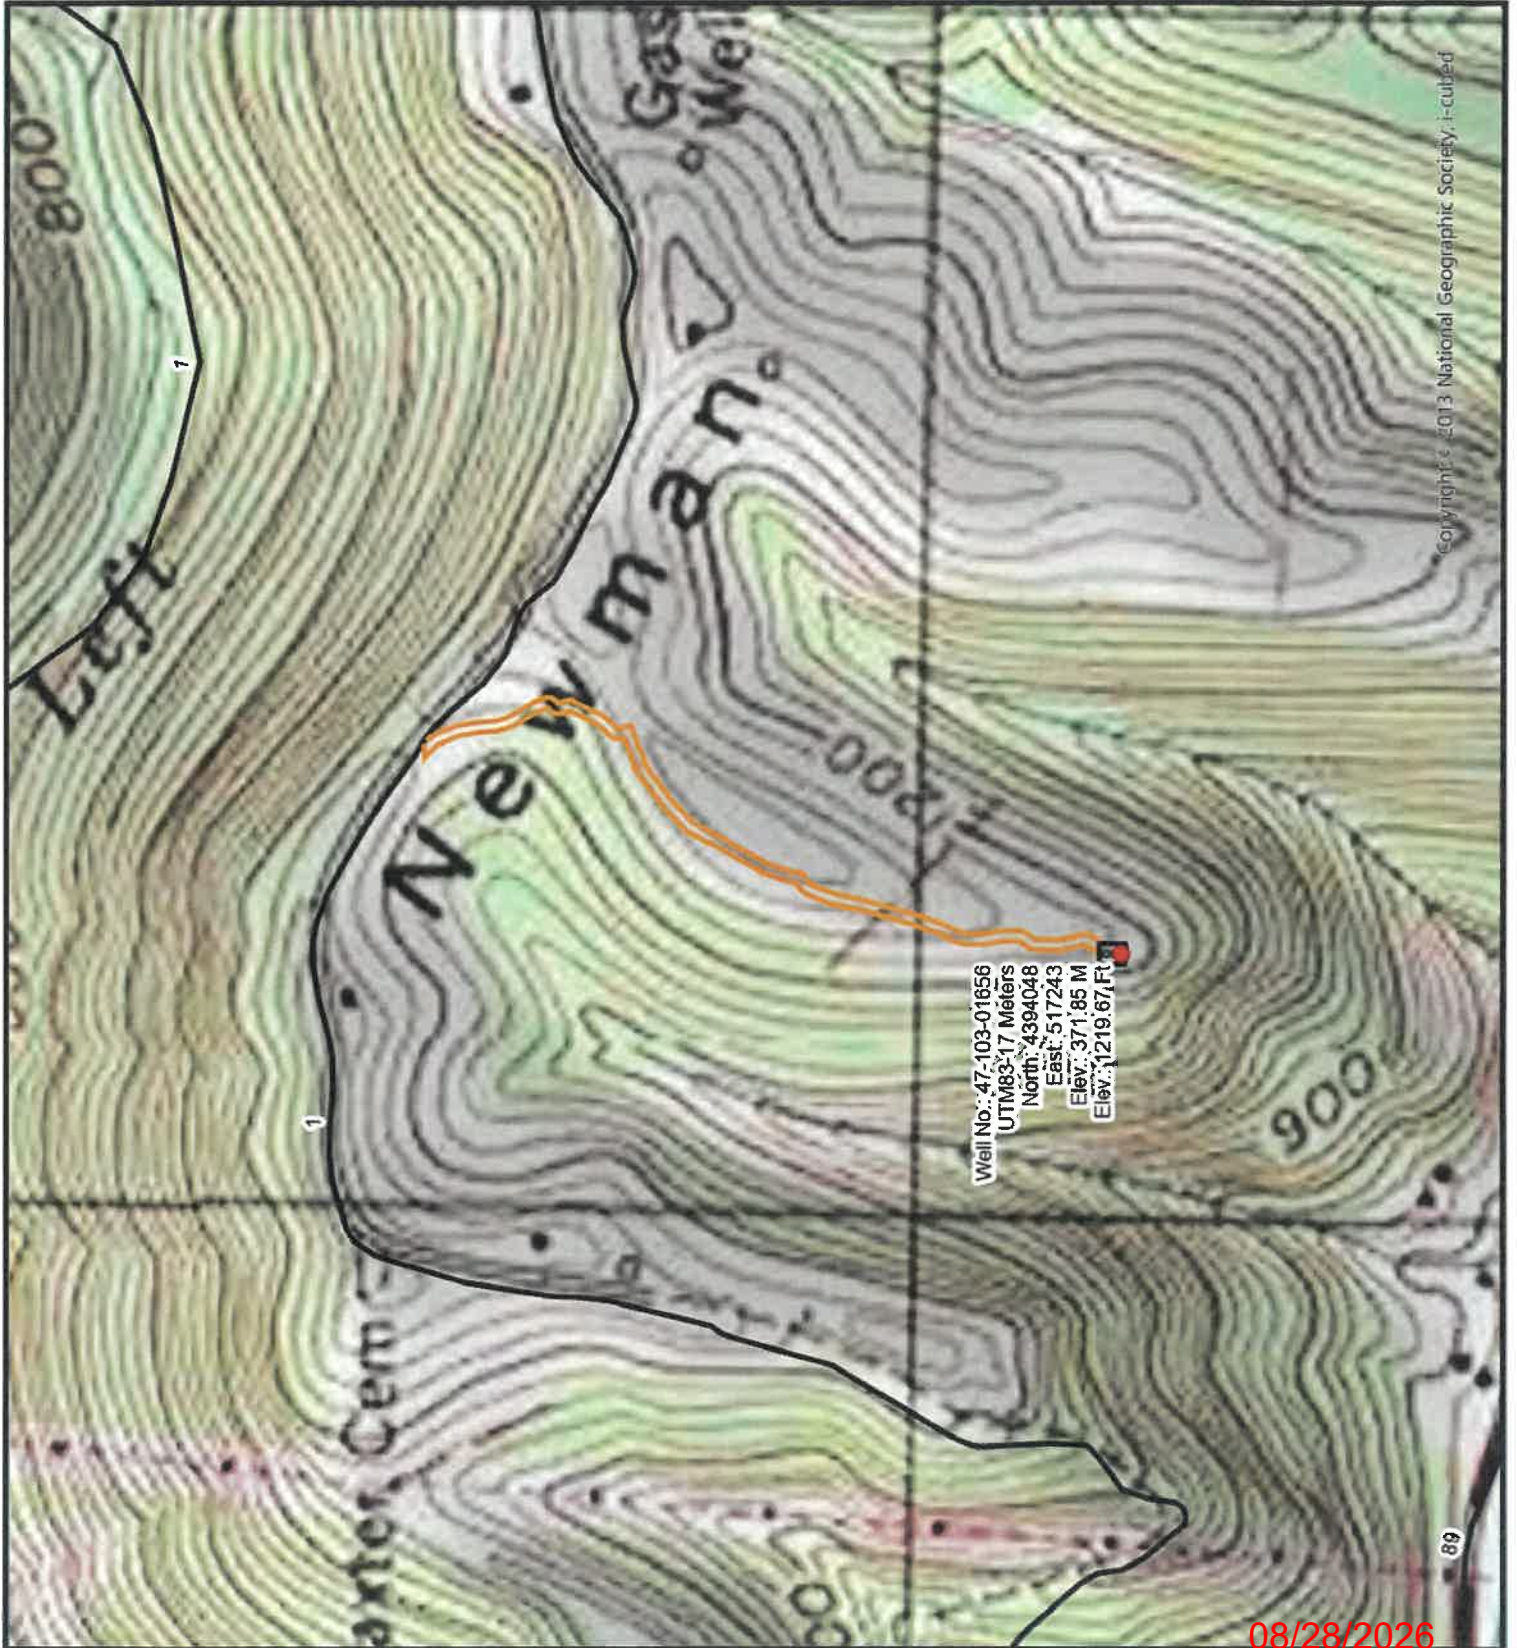

Well No.: 47-103-01656
UTM83: 17 Meters
North: 4394048
East: 517243
Elev.: 371.85 M
Elev.: 1219.67 Ft

Copyright © 2013 National Geographic Society, i-cubed

WW-7
8-30-06



West Virginia Department of Environmental Protection
Office of Oil and Gas
WELL LOCATION FORM: GPS

API: 4710301656 WELL NO.: NEWMAN 1

FARM NAME: John L. Newman

RESPONSIBLE PARTY NAME: Diversified Production, LLC

COUNTY: Wetzel DISTRICT: Proctor

QUADRANGLE: New Martinsville 7.5'

SURFACE OWNER: Austin Postlethwait & Marlene Postlethwait

ROYALTY OWNER: Deborah Knisely & Douglas Newman

UTM GPS NORTHING: 4394048

UTM GPS EASTING: 517243 GPS ELEVATION: 1219.67'

The Responsible Party named above has chosen to submit GPS coordinates in lieu of preparing a new well location plat for a plugging permit or assigned API number on the above well. The Office of Oil and Gas will not accept GPS coordinates that do not meet the following requirements:

1. Datum: NAD 1983, Zone: 17 North, Coordinate Units: meters, Altitude: height above mean sea level (MSL) – meters.
2. Accuracy to Datum – 3.05 meters
3. Data Collection Method:

Survey grade GPS ____: Post Processed Differential ____


Real-Time Differential ____

Mapping Grade GPS X: Post Processed Differential X

Real-Time Differential ____

4. Letter size copy of the topography map showing the well location.

I the undersigned, hereby certify this data is correct to the best of my knowledge and belief and shows all the information required by law and the regulations issued and prescribed by the Office of Oil and Gas.

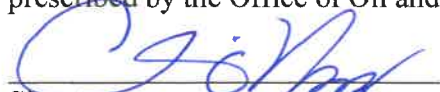
Signature

Chris Veazey - Director of Administration

Title

7/15/2026
Date

RECEIVED
Office of Oil and Gas

JUL 22 2026

WV Department of
Environmental Protection

08/28/2026