




Diversified Gas & Oil
Corporation
100 Diversified Way
Pikeville KY, 41051

47-103-01761

Well Plugging Map

Legend

- Well
- ▨ Pits
- Pad
- ▬ Access Road
- ▬ Public Roads

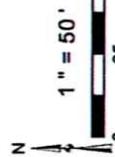

Source: Esri, DigitalGlobe, GeoEye, Earthstar, United States, AeroGRID, IGN, Esri, DeLorme, NAVTEQ, SwireHaworth, Swire





Diversified Gas & Oil Corporation
100 Diversified Way
Pikeville KY, 41051

47-103-01761

Well Plugging Map

Legend

- Well
- ▨ Pits
- Pad
- ▬ Access Road
- ▬ Public Roads

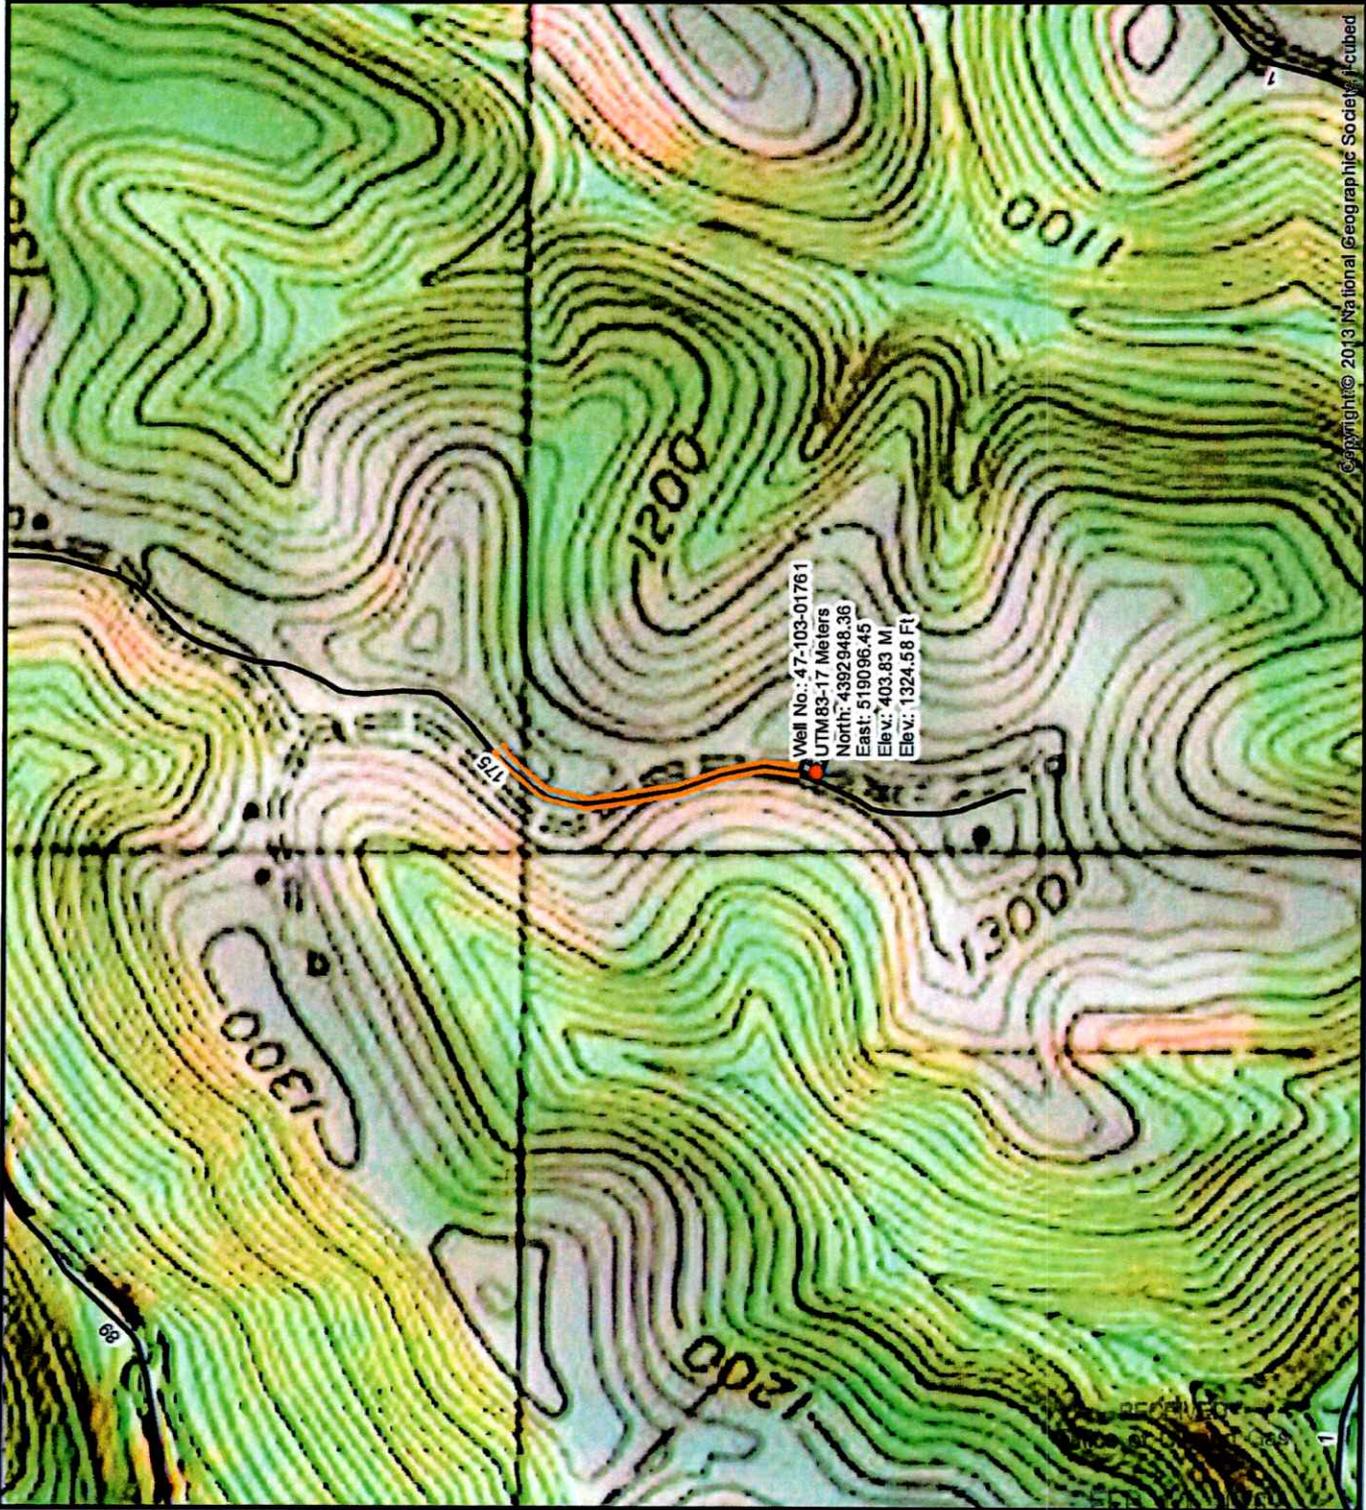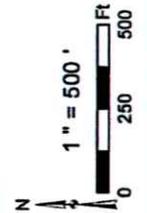

Well No.: 47-103-01761
UTM83-17 Meters
North: 4392948.36
East: 519096.45
Elev.: 403.83 M
Elev.: 1324.58 Ft

Copyright © 2013 National Geographic Society. All rights reserved.

WW-7
8-30-06



West Virginia Department of Environmental Protection
Office of Oil and Gas
WELL LOCATION FORM: GPS

API: 4710301761 WELL NO.: HALL OLAN 1

FARM NAME: Olan Hall

RESPONSIBLE PARTY NAME: Diversified Production, LLC

COUNTY: Wetzel DISTRICT: Proctor

QUADRANGLE: New Martinsville 7.5'

SURFACE OWNER: TH Exploration, LLC c/o EQT Production Co.

ROYALTY OWNER: Mitchell & Karen White, Diversified Production LLC, Diversified ABS LLC, Diversified ABS II LLC, Diversified ABS III, Diversified Energy ABS V

UTM GPS NORTHING: 4392948.36

UTM GPS EASTING: 519096.45 GPS ELEVATION: 1324.58'

The Responsible Party named above has chosen to submit GPS coordinates in lieu of preparing a new well location plat for a plugging permit or assigned API number on the above well. The Office of Oil and Gas will not accept GPS coordinates that do not meet the following requirements:

- Datum: NAD 1983, Zone: 17 North, Coordinate Units: meters, Altitude: height above mean sea level (MSL) – meters.
- Accuracy to Datum – 3.05 meters
- Data Collection Method:
Survey grade GPS : Post Processed Differential

Real-Time Differential

Mapping Grade GPS : Post Processed Differential

Real-Time Differential

- Letter size copy of the topography map showing the well location.

I the undersigned, hereby certify this data is correct to the best of my knowledge and belief and shows all the information required by law and the regulations issued and prescribed by the Office of Oil and Gas.

Signature

Nick Bumgardner - Supervisor Plugging Operations

Title

2/5/2026
Date

RECEIVED
Office of Oil and Gas

FEB 11 2026

WV Department of
Environmental Protection

02/20/2026