

4710302017 P

WW-7
8-30-06



West Virginia Department of Environmental Protection
Office of Oil and Gas

WELL LOCATION FORM: GPS

API: 47-103-02017 WELL NO.: 850-2

FARM NAME: Leona Barr

RESPONSIBLE PARTY NAME: Monument Oil & Gas LLC

COUNTY: Wetzel DISTRICT: Grant

QUADRANGLE: Big Run

SURFACE OWNER: Coastal Forest Resources

ROYALTY OWNER: Western Pocohontas Properties LP

UTM GPS NORTHING: 4380799

UTM GPS EASTING: 540291 GPS ELEVATION: 948

The Responsible Party named above has chosen to submit GPS coordinates in lieu of preparing a new well location plat for a plugging permit or assigned API number on the above well. The Office of Oil and Gas will not accept GPS coordinates that do not meet the following requirements:

1. Datum: NAD 1983, Zone: 17 North, Coordinate Units: meters, Altitude: height above mean sea level (MSL) – meters.
2. Accuracy to Datum – 3.05 meters
3. Data Collection Method:

Survey grade GPS ____: Post Processed Differential ____
Real-Time Differential ____


Mapping Grade GPS ____: Post Processed Differential ____
Real-Time Differential ____

4. Letter size copy of the topography map showing the well location.

I the undersigned, hereby certify this data is correct to the best of my knowledge and belief and shows all the information required by law and the regulations issued and prescribed by the Office of Oil and Gas.

[Signature] Land Manager 03/03/22
Signature Title Date

CNX 850-2

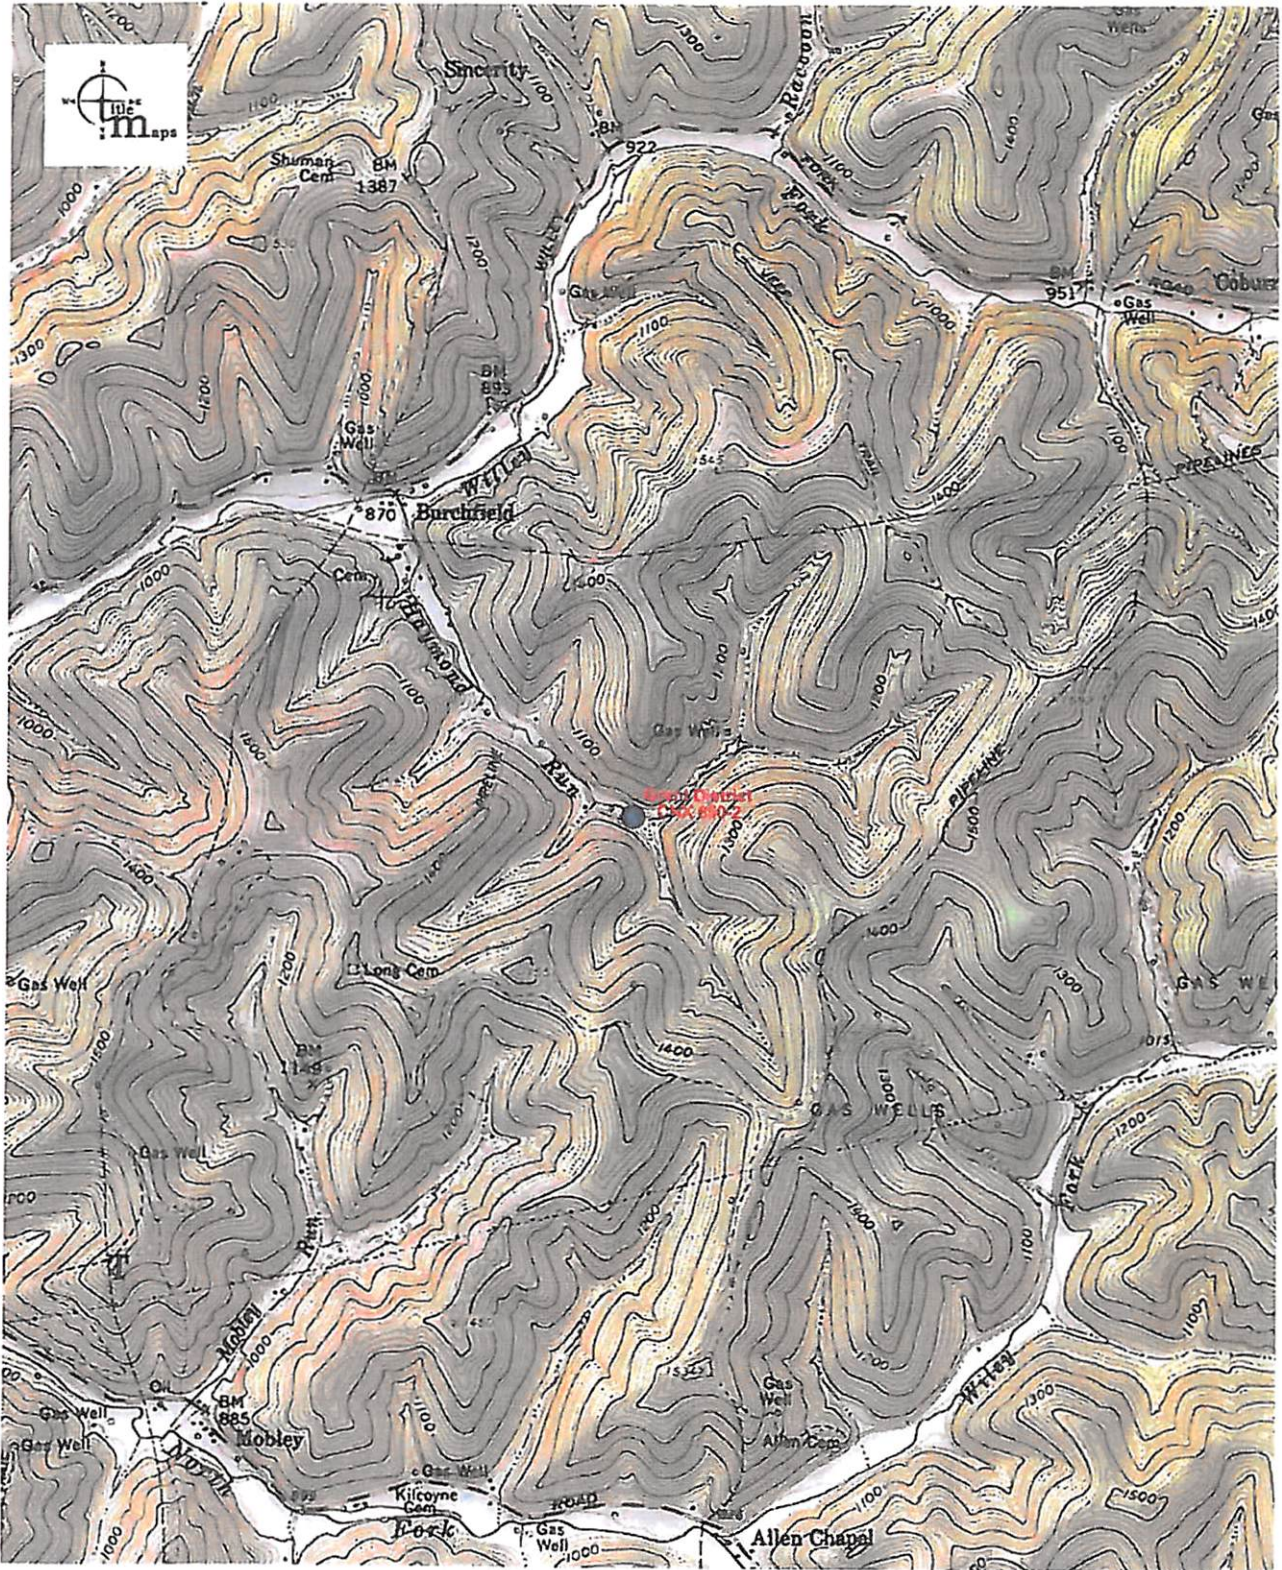

2000ft
Approximate Scale 1:24,000

03/03/2022 - 02:46:27 PM

Disclaimer: The map information shown is from various sources including but not limited to tax maps and state and federal agency web sites. The map information does not represent and should not be relied upon as a land survey or legal depiction of the property or information shown. Title Maps LLC does not warrant the accuracy or correctness of the map information shown hereon.

04/15/2022