



**DIVERSIFIED**  
energy

47-103-02037  
Well Plugging Map


Legend

- Well
- Pits
- Pad
- Access Road
- Public Roads

RECEIVED  
Office of Oil and Gas

FEB 25 2026

WV Department of  
Environmental Protection

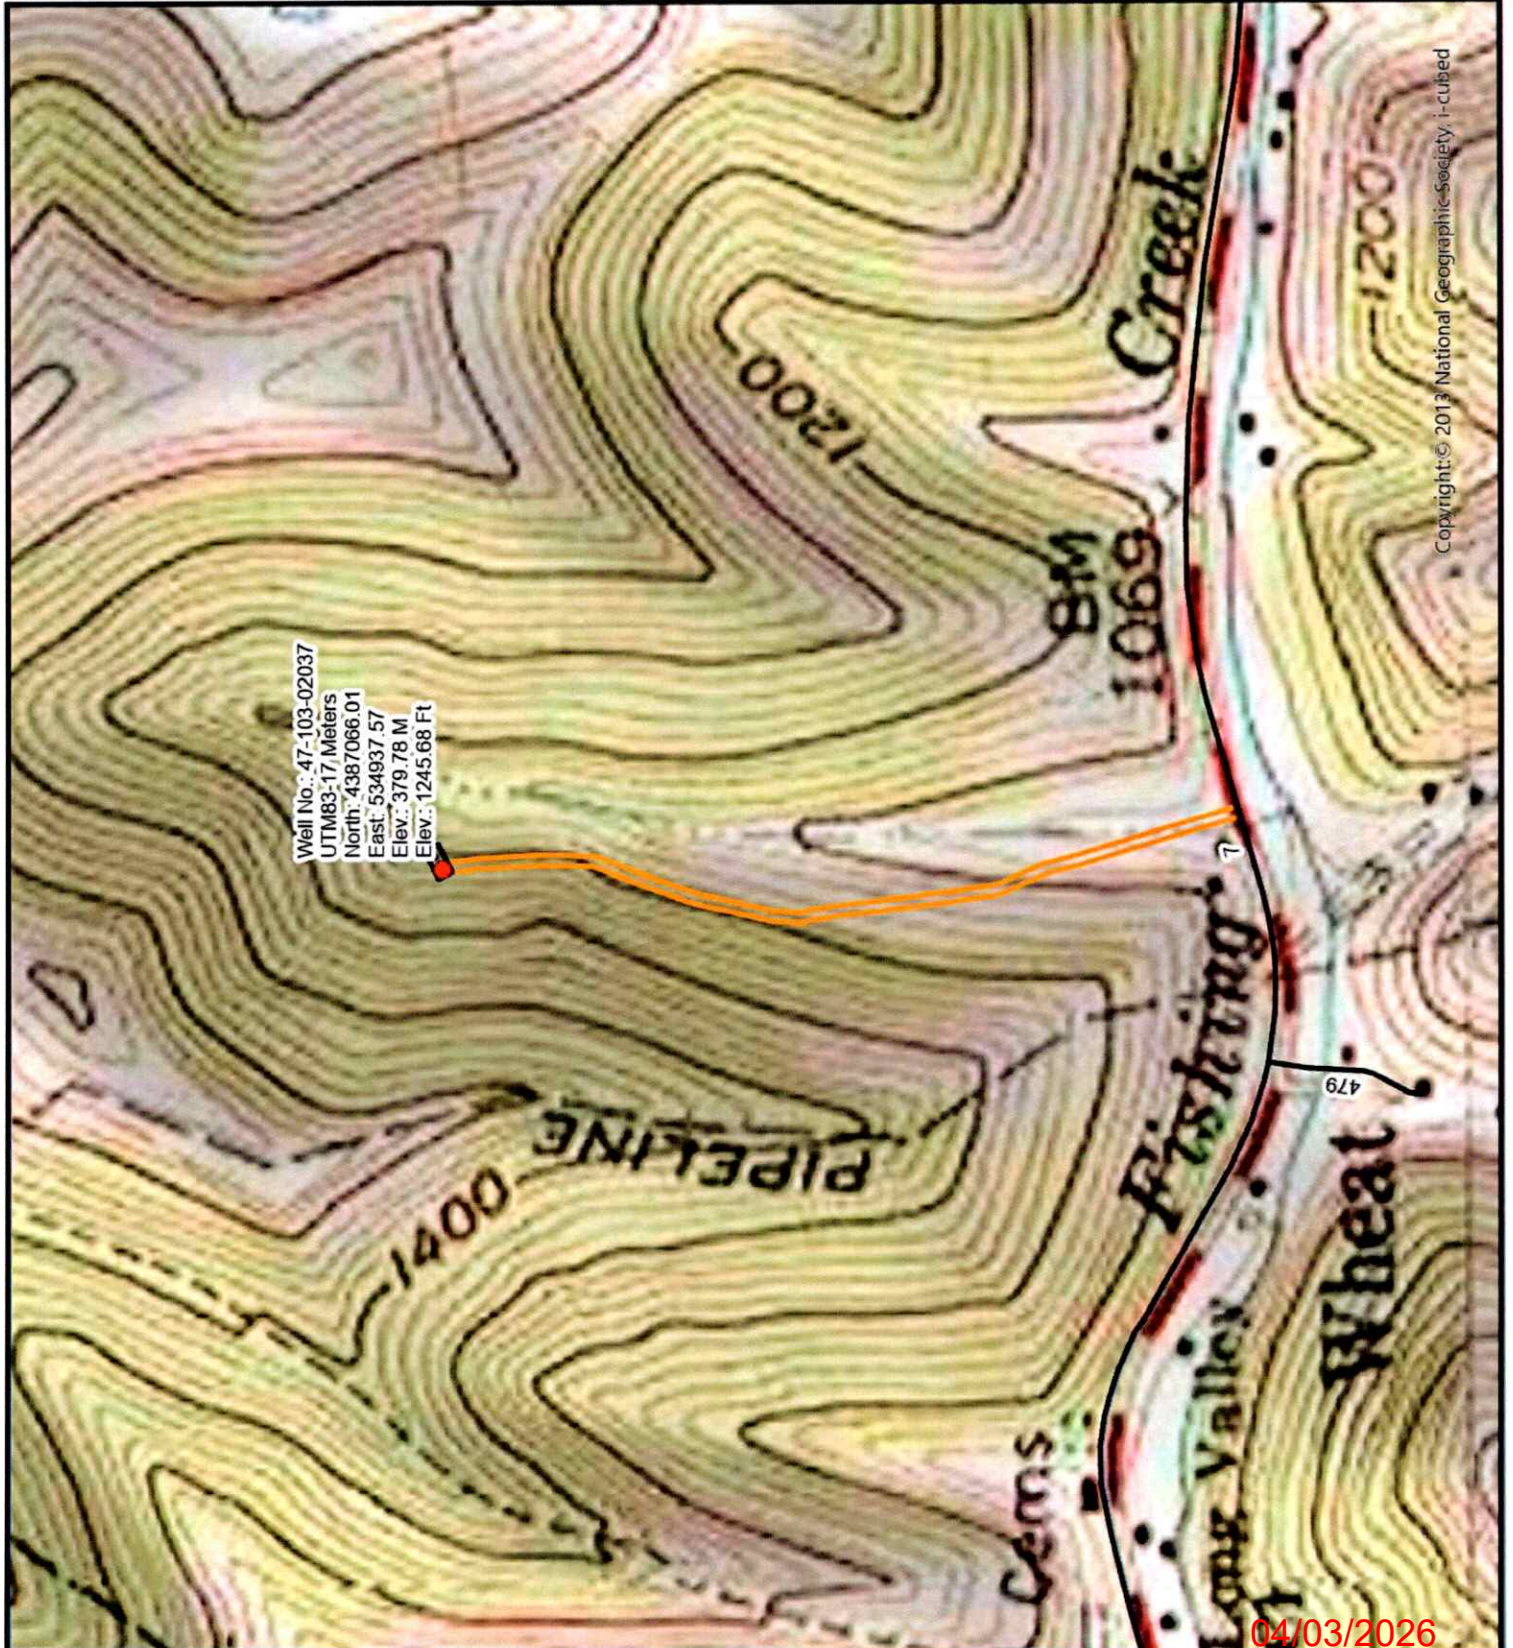

Well No.: 47-103-02037  
UTM83: 17 Meters  
North: 4387066.01  
East: 534937.57  
Elev.: 379.78 M  
Elev.: 1245.68 Ft

Copyright: © 2013 National Geographic Society, i-cubed

04/03/2026



**DIVERSIFIED**  
energy

47-103-02037  
Well Plugging Map


Legend

- Well
- Pits
- Pad
- Access Road
- Public Roads

RECEIVED  
Office of Oil and Gas

FEB 25 2026

WV Department of  
Environmental Protection

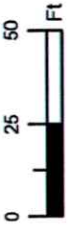

04/03/2026

WW-7  
8-30-06

RECEIVED  
Office of Oil and Gas

FEB 25 2026

WV Department of  
Environmental Protection



West Virginia Department of Environmental Protection  
Office of Oil and Gas  
**WELL LOCATION FORM: GPS**

API: 4710302037 WELL NO.: BRIGGS 1 WV

FARM NAME: Elvin & Margaret Briggs

RESPONSIBLE PARTY NAME: Diversified Production, LLC

COUNTY: Wetzel DISTRICT: Center

QUADRANGLE: Littleton 7.5'

SURFACE OWNER: Phyllis R. Bohrer

ROYALTY OWNER: William Francik, Thomas Iacoboni Acropolis Inc., Morris Mountaineer O&G LLC, Sidney Austin Smith Trust LLC

UTM GPS NORTHING: 4387066.01

UTM GPS EASTING: 534937.57 GPS ELEVATION: 1245.68'

The Responsible Party named above has chosen to submit GPS coordinates in lieu of preparing a new well location plat for a plugging permit or assigned API number on the above well. The Office of Oil and Gas will not accept GPS coordinates that do not meet the following requirements:

1. Datum: NAD 1983, Zone: 17 North, Coordinate Units: meters, Altitude: height above mean sea level (MSL) – meters.
2. Accuracy to Datum – 3.05 meters
3. Data Collection Method:

Survey grade GPS  : Post Processed Differential   
Real-Time Differential

Mapping Grade GPS  : Post Processed Differential   
Real-Time Differential

4. **Letter size copy of the topography map showing the well location.**

I the undersigned, hereby certify this data is correct to the best of my knowledge and belief and shows all the information required by law and the regulations issued and prescribed by the Office of Oil and Gas.

Austin Sutler  
Signature

Austin Sutler - Manager Plugging Operations  
Title

2/18/26  
Date

04/03/2026