

4710302041P

WW-7
8-30-06



West Virginia Department of Environmental Protection
Office of Oil and Gas

WELL LOCATION FORM: GPS

API: 47-103-02041 WELL NO.: LE-2

FARM NAME: Earl & Julia Madison

RESPONSIBLE PARTY NAME: Monument Oil & Gas LLC

COUNTY: Wetzel DISTRICT: Church

QUADRANGLE: Hundred

SURFACE OWNER: Tyler W. Tedrow

ROYALTY OWNER: Western Pocahontas Properties, LP

UTM GPS NORTHING: 4393430

UTM GPS EASTING: 549729 GPS ELEVATION: 1465'

The Responsible Party named above has chosen to submit GPS coordinates in lieu of preparing a new well location plat for a plugging permit or assigned API number on the above well. The Office of Oil and Gas will not accept GPS coordinates that do not meet the following requirements:

1. Datum: NAD 1983, Zone: 17 North, Coordinate Units: meters, Altitude: height above mean sea level (MSL) – meters.
2. Accuracy to Datum – 3.05 meters
3. Data Collection Method:

Survey grade GPS ____: Post Processed Differential ____

Real-Time Differential ____

Mapping Grade GPS ____: Post Processed Differential ____

Real-Time Differential ____

4. Letter size copy of the topography map showing the well location.

I the undersigned, hereby certify this data is correct to the best of my knowledge and belief and shows all the information required by law and the regulations issued and prescribed by the Office of Oil and Gas.


Signature

Land Manager
Title

03/03/22
Date

06/10/2022

Round Bottom

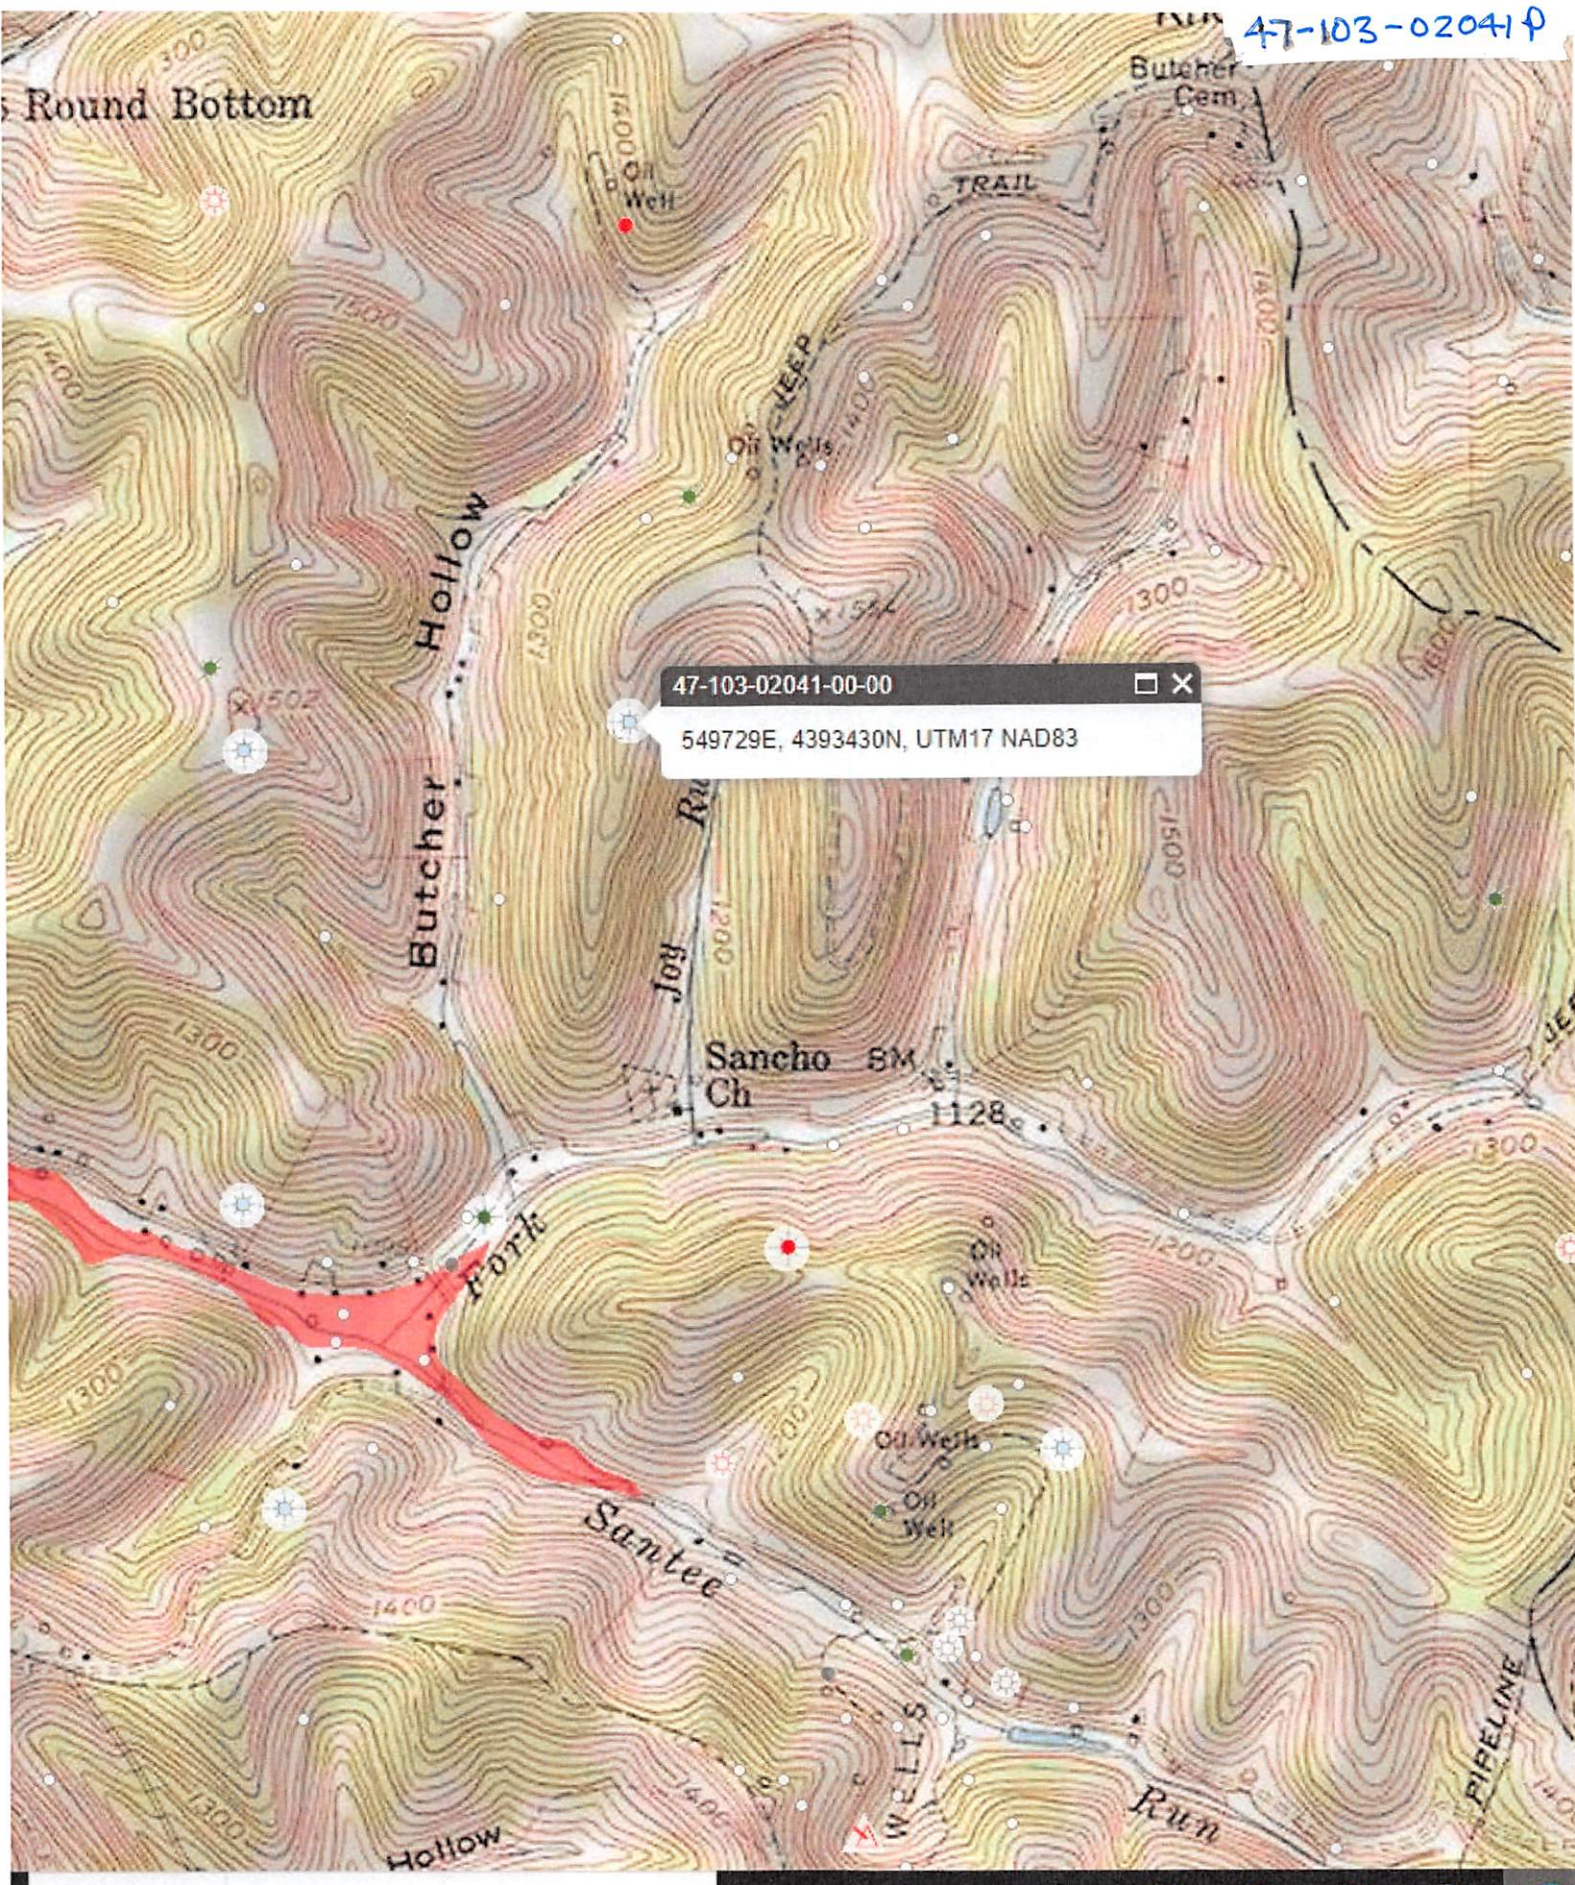

47-103-02041-00-00
549729E, 4393430N, UTM17 NAD83