

DIVERSIFIED energy

47-103-02117


Well Plugging Map

Legend


- Well
- Pits
- Pad
- Access Road
- Public Roads

RECEIVED
Office of Oil and Gas
SEP 03 2026
WV Department of Environmental Protection

4710302117

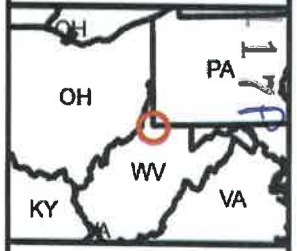



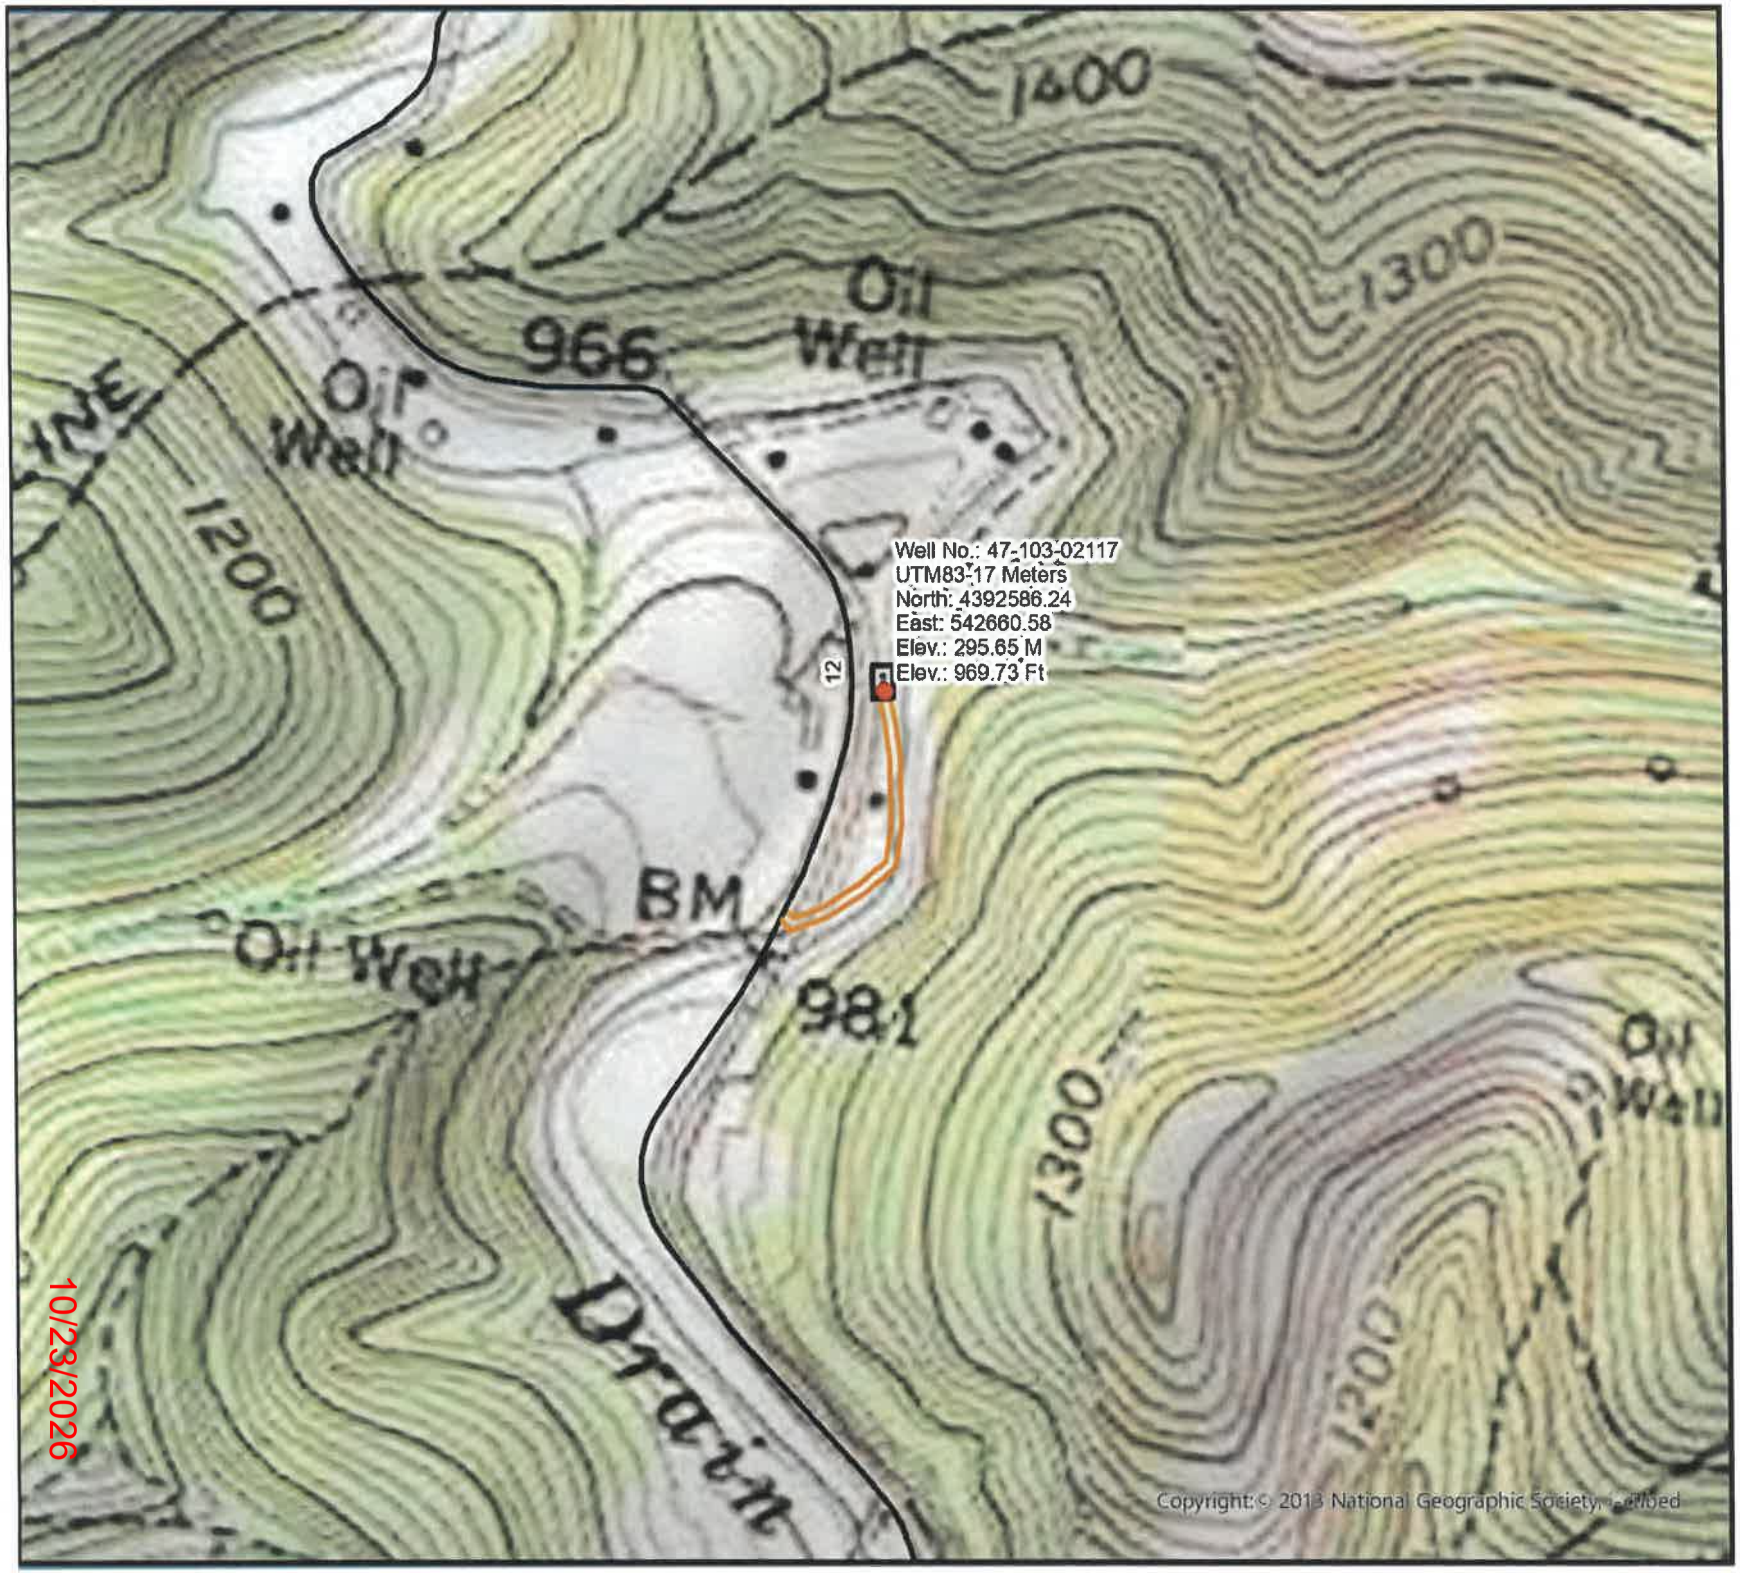

DIVERSIFIED energy


47-103-02117

Well Plugging Map

Legend

- Well
- Pits
- Pad
- Access Road
- Public Roads

RECEIVED
Office of Oil and Gas
SEP 03 2026
WV Department of Environmental Protection

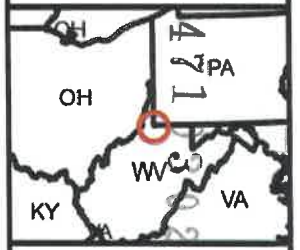

0 250 500 Ft

4710302117 P

WW-7
8-30-06

West Virginia Department of Environmental Protection
Office of Oil and Gas
WELL LOCATION FORM: GPS

API: 4710302117 **WELL NO.:** FDS 1A _70000

FARM NAME: Stephen Varner

RESPONSIBLE PARTY NAME: Diversified Production, LLC

COUNTY: Wetzel **DISTRICT:** Clay

QUADRANGLE: Littleton 7.5'

SURFACE OWNER: Stephen Varner

ROYALTY OWNER: None Identified

UTM GPS NORTHING: 4392586.24

UTM GPS EASTING: 542660.58 **GPS ELEVATION:** 969.73'

RECEIVED
Office of Oil and Gas
SEP 03 2026
WV Department of
Environmental Protection

The Responsible Party named above has chosen to submit GPS coordinates in lieu of preparing a new well location plat for a plugging permit or assigned API number on the above well. The Office of Oil and Gas will not accept GPS coordinates that do not meet the following requirements:

1. Datum: NAD 1983, Zone: 17 North, Coordinate Units: meters, Altitude: height above mean sea level (MSL) – meters.
2. Accuracy to Datum – 3.05 meters
3. Data Collection Method:

Survey grade GPS ____: Post Processed Differential _____

Real-Time Differential _____

Mapping Grade GPS __X__: Post Processed Differential __X__

Real-Time Differential _____

4. **Letter size copy of the topography map showing the well location.**

I the undersigned, hereby certify this data is correct to the best of my knowledge and belief and shows all the information required by law and the regulations issued and prescribed by the Office of Oil and Gas.

Signature

Chris Veazey - Director of Administration
Title

8/20/2026
Date

10/23/2026