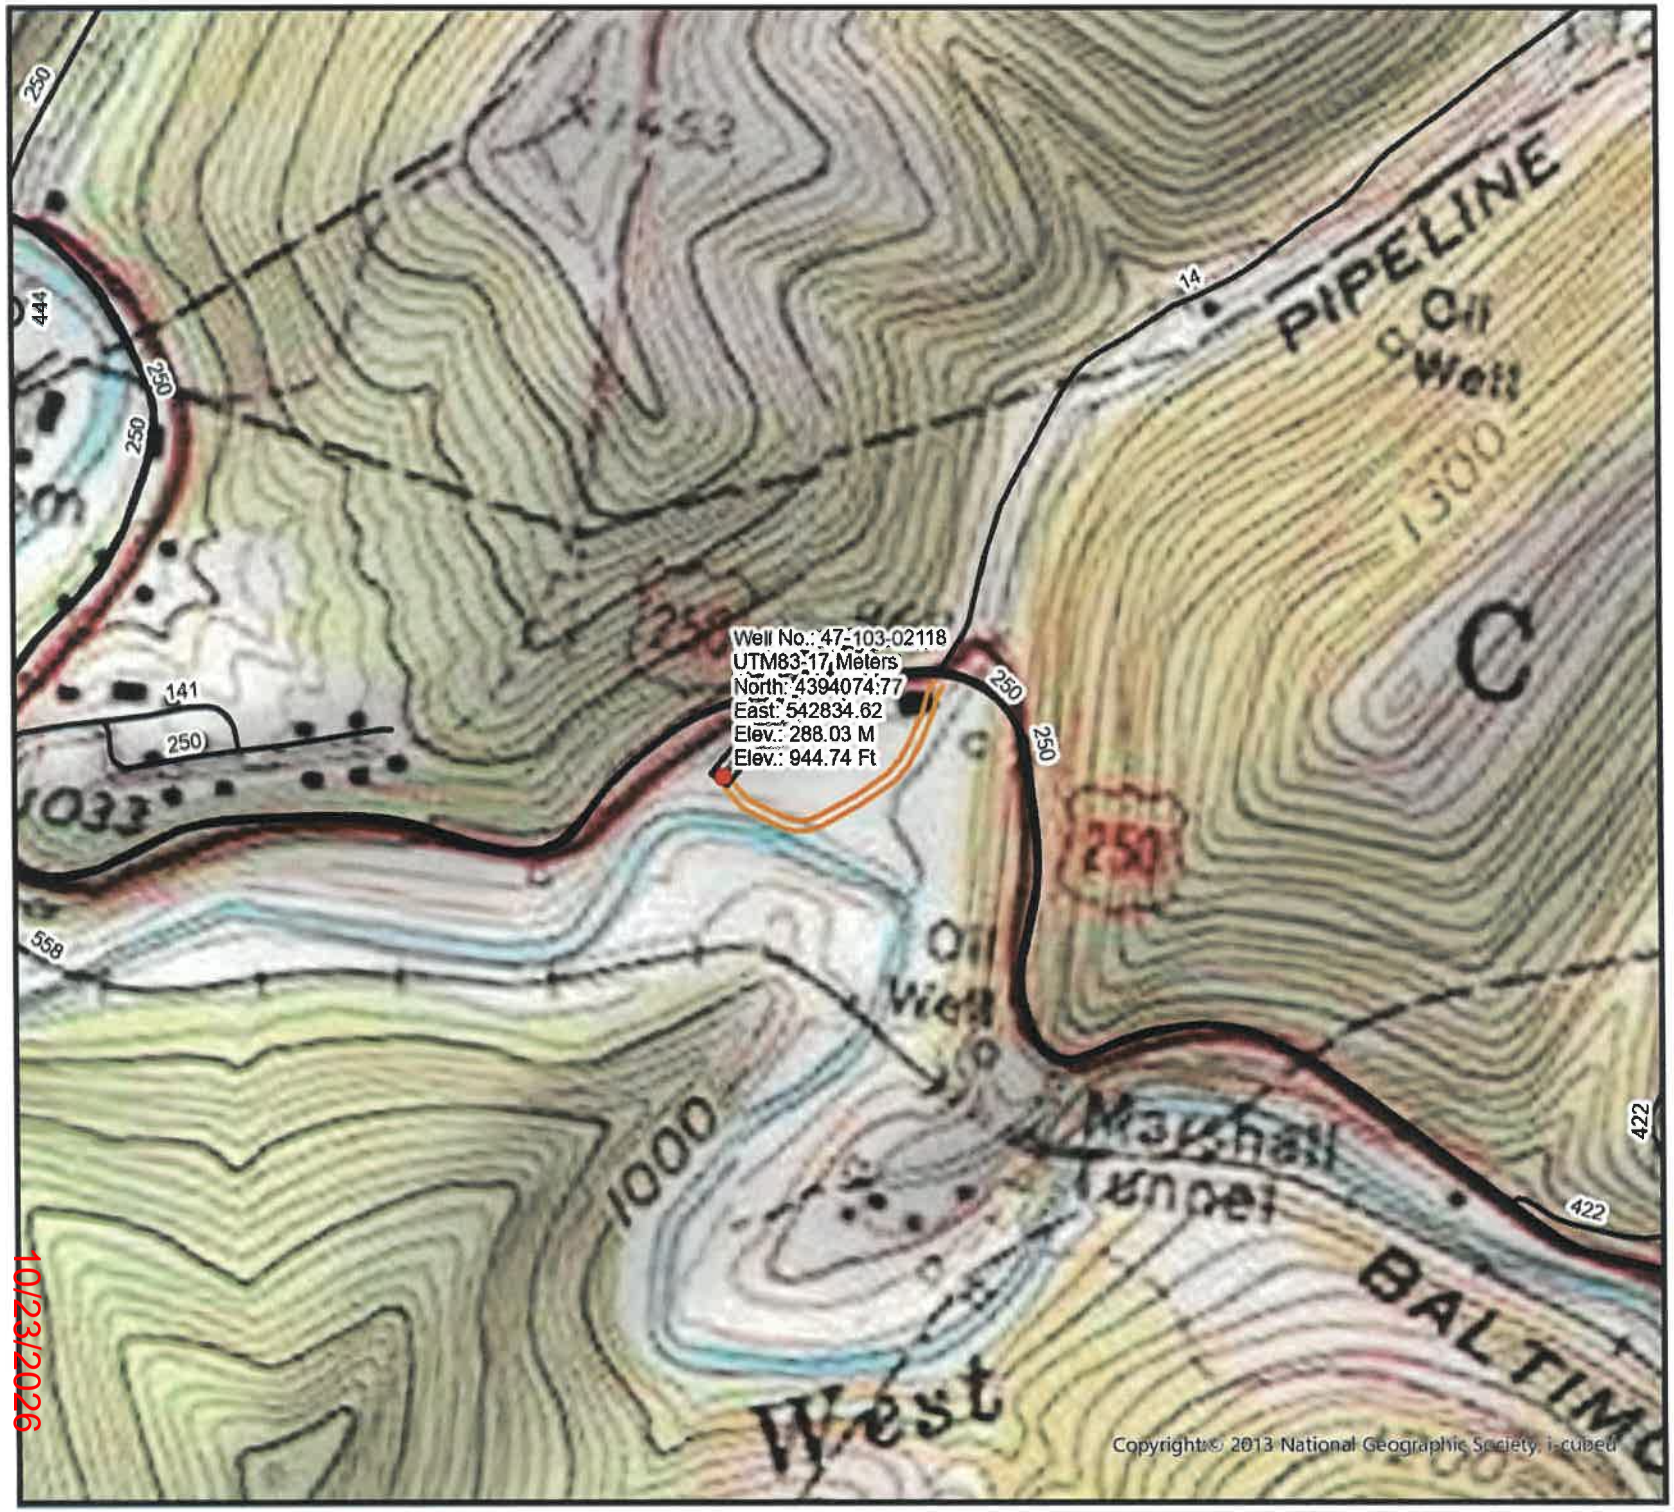


DIVERSIFIED energy

47-103-02118

Well Plugging Map

Legend

- Well
- Pits
- Pad
- Access Road
- Public Roads

RECEIVED
Office of Oil & Gas
OCT 23 2026
WV Department of
Environmental Protection



0 250 500 Ft

10/23/2026

4710302118P




DIVERSIFIED energy

47-103-02118

Well Plugging Map

Legend

- Well
- Pits
- Pad
- Access Road
- Public Roads

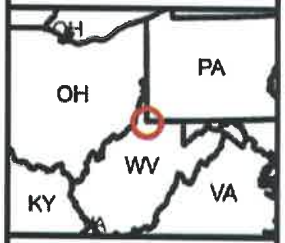



10/23/2026

4710302118P



Oil&Gas

Wells, Horizontal Only

WellStatus

- Active Well
- Permit Issued
- Permit Application
- Plugged

Wells, Active Status Only

WellUse

- Brine Disposal
- Fluid Injection
- Gas Production
- House Gas
- Observation
- Oil Production
- Production
- Solution Mining
- Storage
- Vent
- <all other values>

Wells, Other than Active Status

WellUse

- Brine Disposal
- Fluid Injection
- Gas Production
- House Gas
- Observation
- Oil Production
- Production
- Solution Mining
- Storage

begin date

end date

10/23/2026

rainfall tota

update

4710302118 P

WW-7
8-30-06

RECEIVED
Office of Oil and Gas
SEP 23 2026
WV Department of
Environmental Protection

West Virginia Department of Environmental Protection
Office of Oil and Gas
WELL LOCATION FORM: GPS

API: 4710302118 **WELL NO.:** FD51B

FARM NAME: Hundred Volunteer Fire Department Company

RESPONSIBLE PARTY NAME: Diversified Production, LLC

COUNTY: Wetzel **DISTRICT:** Clay

QUADRANGLE: Littleton 7.5'

SURFACE OWNER: Wetzel County Board of Education

ROYALTY OWNER: None Identified

UTM GPS NORTHING: 4390474.77

UTM GPS EASTING: 542834.62 **GPS ELEVATION:** 944.74'

The Responsible Party named above has chosen to submit GPS coordinates in lieu of preparing a new well location plat for a plugging permit or assigned API number on the above well. The Office of Oil and Gas will not accept GPS coordinates that do not meet the following requirements:

1. Datum: NAD 1983, Zone: 17 North, Coordinate Units: meters, Altitude: height above mean sea level (MSL) – meters.
2. Accuracy to Datum – 3.05 meters
3. Data Collection Method:

Survey grade GPS ____: Post Processed Differential _____

Real-Time Differential _____

Mapping Grade GPS __X__: Post Processed Differential __X__

Real-Time Differential _____

4. **Letter size copy of the topography map showing the well location.**

I the undersigned, hereby certify this data is correct to the best of my knowledge and belief and shows all the information required by law and the regulations issued and prescribed by the Office of Oil and Gas.

Signature | Chris Veazey - Director of Administration (Title) | 9/15/2026 (Date)

10/23/2026