


05/15/2026

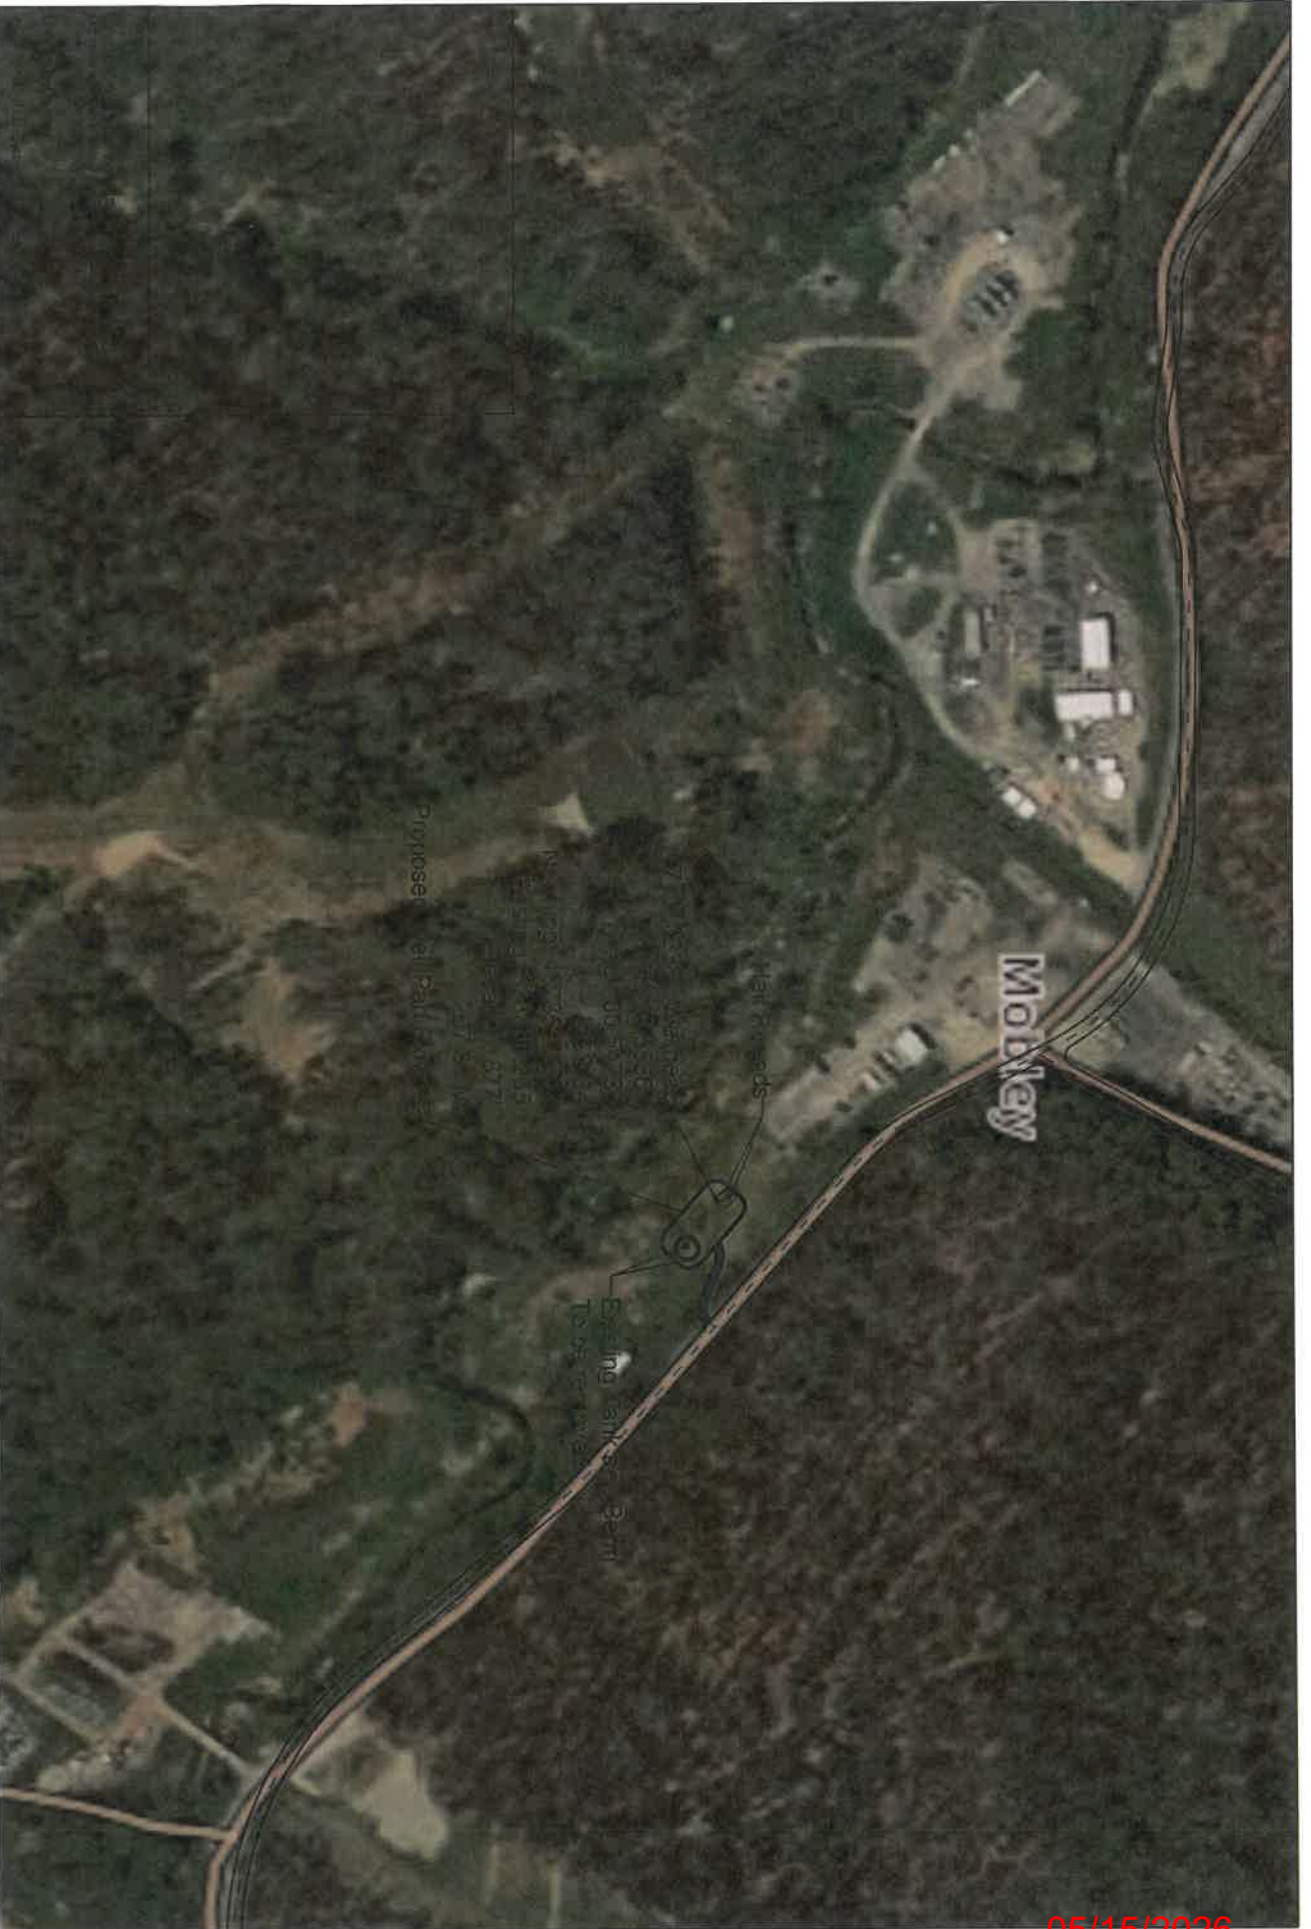

DIVERSIFIED
energy




4710302384

Site Details

Drawn By: NB

Date: 3/23/2026

Not To Scale
Sketch Only

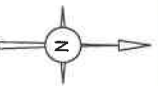

obley

1100

COR

Half Rounds

4710302384 Wellhead
 Lat: 39.55567
 Long: -80.54738
 UGS 84

Northing: 4378540.532
 Easting: 538885.265
 Elevation: 877'
 267.31 M

Existing Tank and Berm
 To be removed

Proposed Well Pad Extents

RECEIVED
Office of Oil and Gas

APR 09 2026

WV Department of
Environmental Protection

05/15/2026



DIVERSIFIED
energy

NEXT
LVL
ENERGY


4710302384

Site Details

Drawn By: NB

Date: 3/23/2026

Not To Scale
Sketch Only

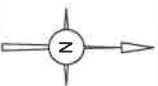

WW-7
8-30-06



RECEIVED
Office of Oil and Gas
APR 09 2026
WV Department of
Environmental Protection

West Virginia Department of Environmental Protection
Office of Oil and Gas
WELL LOCATION FORM: GPS

API: 4710302384 WELL NO.: WYCOFF 1

FARM NAME: John W. Wycoff

RESPONSIBLE PARTY NAME: Diversified Production, LLC

COUNTY: Wetzel DISTRICT: Grant

QUADRANGLE: Littleton 7.5'

SURFACE OWNER: Melvin Delaney & Molly Delaney-Kilcovne

ROYALTY OWNER: Bounty Minerals LLC, Ridgetop Appalachia LLC

UTM GPS NORTHING: 4378540.532

UTM GPS EASTING: 538885.265 GPS ELEVATION: 877'

The Responsible Party named above has chosen to submit GPS coordinates in lieu of preparing a new well location plat for a plugging permit or assigned API number on the above well. The Office of Oil and Gas will not accept GPS coordinates that do not meet the following requirements:

- Datum: NAD 1983, Zone: 17 North, Coordinate Units: meters, Altitude: height above mean sea level (MSL) – meters.
- Accuracy to Datum – 3.05 meters
- Data Collection Method:
Survey grade GPS ____ : Post Processed Differential ____

Real-Time Differential ____

Mapping Grade GPS X : Post Processed Differential X

Real-Time Differential ____

- Letter size copy of the topography map showing the well location.**

I the undersigned, hereby certify this data is correct to the best of my knowledge and belief and shows all the information required by law and the regulations issued and prescribed by the Office of Oil and Gas.

Signature

Chris Veazey - Director of Administration
Title

03/31/2026
Date

05/15/2026