

West Virginia Department of Environmental Protection  
Office of Oil & Gas  
**WELL LOCATION FORM: GPS**

API: 47- 103 - 2598 WELL NO: 4

FARM NAME: E.M. Hoge No.4

RESPONSIBLE PARTY NAME: H.G. Energy, LLC

COUNTY: Wetzel DISTRICT: Green

QUADRANGLE: Centerpoint 7.5'

SURFACE OWNER: W.Va. Dept. of Natural Resources

ROYALTY OWNER: H.G. Energy, LLC

UTM GPS NORTHING: 4,371,137 (NAD 83)

UTM GPS EASTING: 525,368 (NAD 83) GPS ELEVATION: 323 m. (1059')

The Responsible Party named above has chosen to submit GPS coordinates in lieu of preparing a new well location plat for a plugging permit on the above well. The Office of Oil & Gas will not accept GPS coordinates that do not meet the following requirements:

1. Datum: NAD 1983, Zone:17 North, Coordinate Units: meters, Altitude: height above mean sea level (MSL) - meters.
2. Accuracy to Datum - 3.05 meters
3. Data Collection Method:

Survey Grade GPS	<input type="checkbox"/>	Post Processed Differential	<input type="checkbox"/>
		Real-Time Differential	<input type="checkbox"/>
Mapping Grade GPS	<input checked="" type="checkbox"/>	Post Processed Differential	<input checked="" type="checkbox"/>
		Real-Time Differential	<input type="checkbox"/>

Received  
Office of Oil & Gas  
JUN 16 2016

I the undersigned, hereby certify this data is correct to the best of my knowledge and belief and shows all the information required by law and the regulations issued and prescribed by the Office of Oil and Gas.

Diane White Diane C. White  
Signature


Designated Agent  
Title

May 26, 2016  
Date



SUBJECT WELL  
E.M. Hoge No. 4  
47-103-2598

AND OTHER

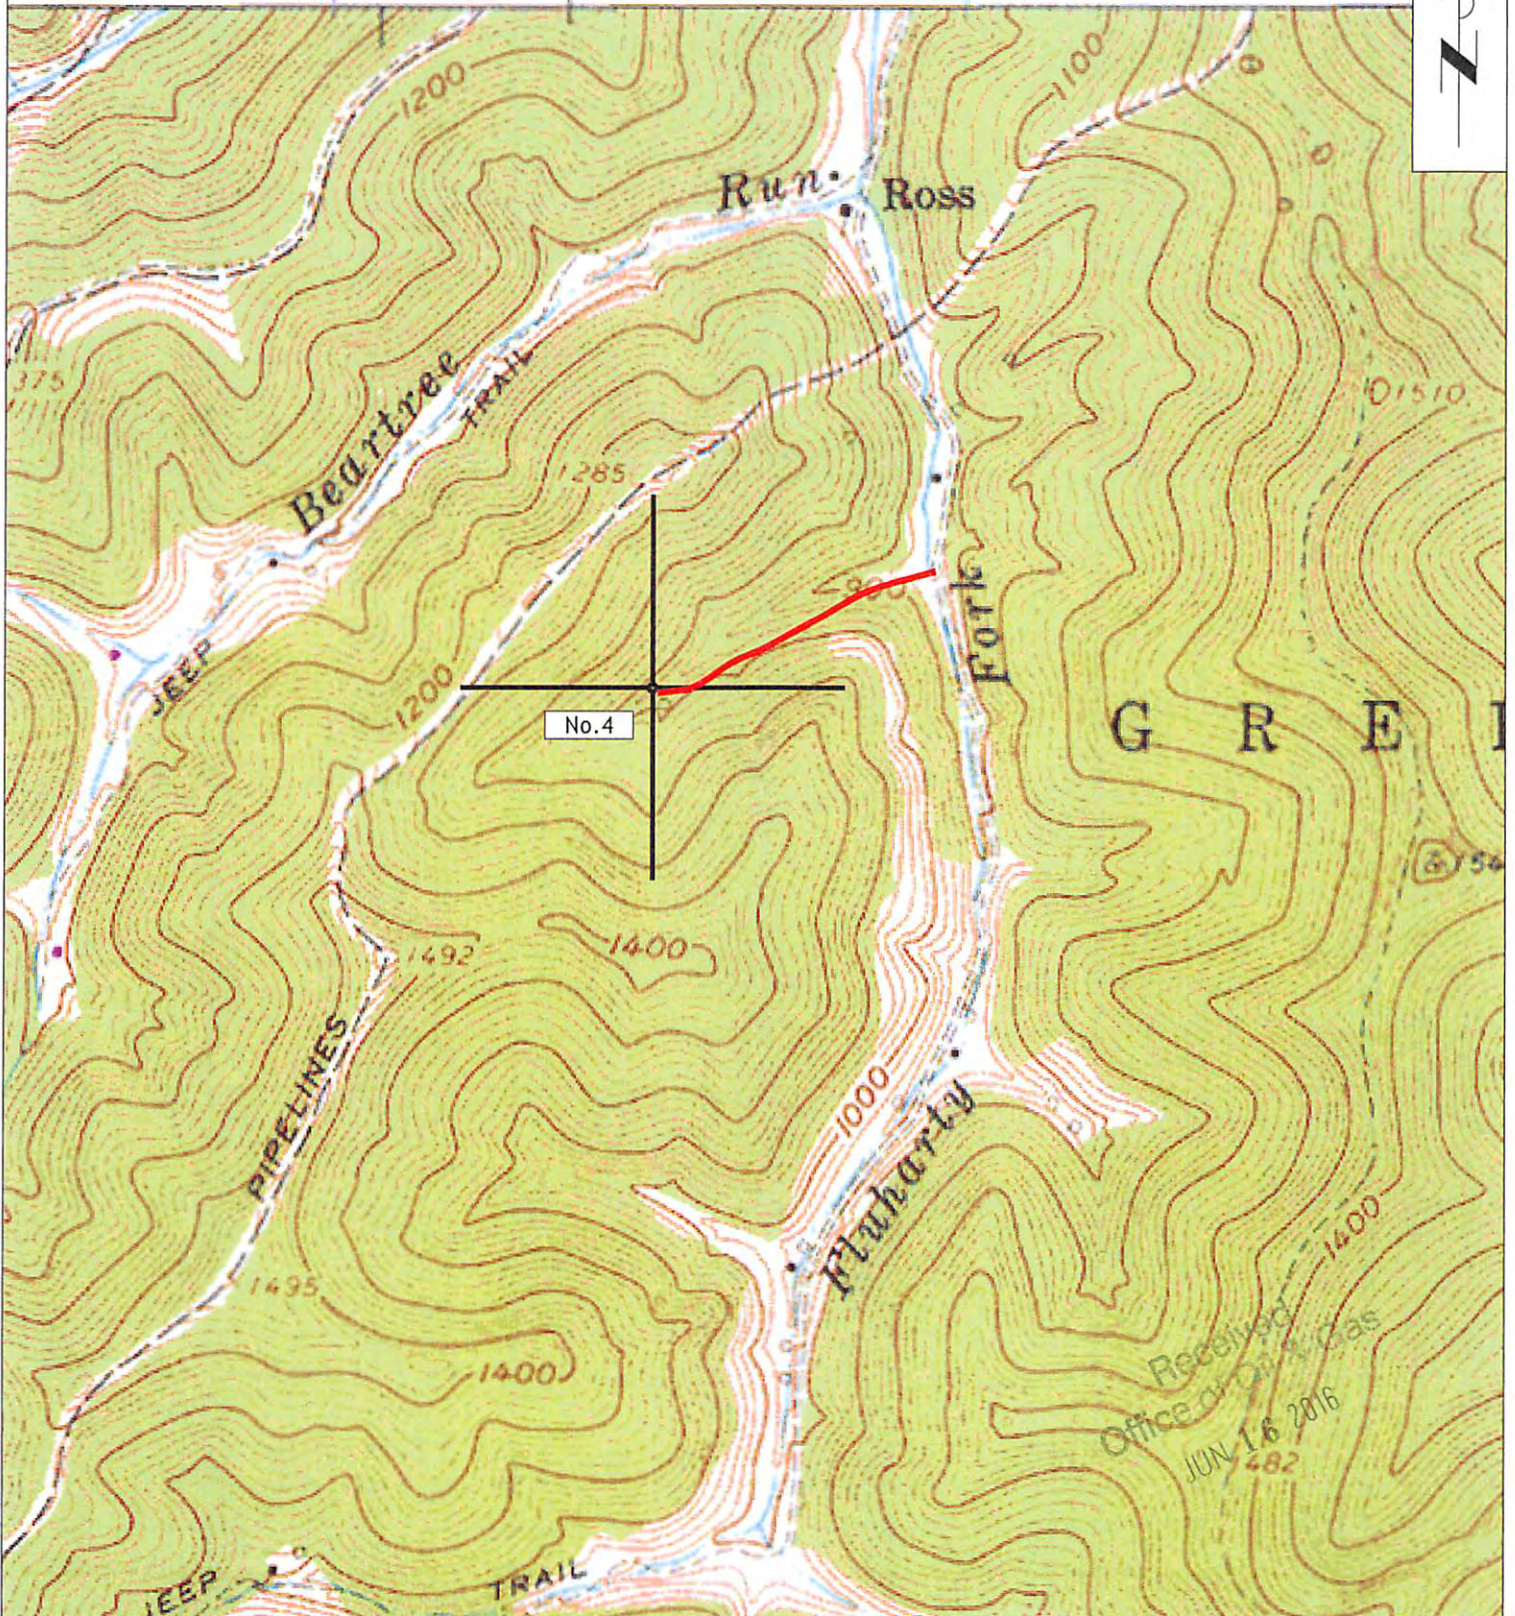

Received  
Office of Oil & Gas  
JUN 16 2016  
482

Section of  
Centerpoint 7.5' Quadrangle  
SCALE 1"=1000 07/01/2016