

ZMBG #3H (47-103-02894) AS-DRILLED

**ZMBG #3H
BOTTOM HOLE**

STATE PLANE
COORDINATES
NORTH ZONE-NAD 27
(N) 423753
(E) 1624393

L & L DECIMAL
NAD 27
39.65579
80.83409

UTM (NAD 83)
ZONE 17
METERS
4389576
514248

SCHEIBELHOOD
74.76 ACRES±
4-17

HEINZMAN
138.239 ACRES±
5-8

RICHTER
80.5 ACRES±
5-10

LLOYD
40.25 ACRES±
4-24

HEAVEN PARTNERSHIP
74.8 ACRES±
5-24

NICE
93.91 ACRES±
4-32

GODDARD
54.65 ACRES±
5-29

SCHUPBACH
99.75 ACRES±
5-30

BURTON
66.94 ACRES±
5-31

NICE
23.85 ACRES±
4-34

HOWELL
38.26 ACRES±
8-1

ZUMPETTA, ET AL
79.47 ACRES±
8-3

DALLISON LUMBER INC.
ET AL
35 ACRES±
8-2

ZUMPETTA, ET AL
37.91 ACRES±
8-11

HELMICK
35.40 ACRES±
8-10

ZUMPETTA, ET AL
27 ACRES±
8-21

ZMBG #3H
LANDING POINT

ZMBG #3H

NOTES ON SURVEY

1. NO DWELLINGS WITHIN 625' WERE FOUND.
2. NO WATER WELLS OR DEVELOPED SPRINGS WITHIN 250' WERE FOUND.
3. TIES TO WELLS AND CORNERS ARE BASED ON STATE PLANE GRID NORTH WY NORTH ZONE '27.
4. WELL LAT./LONG. ESTABLISHED BY SG-GPS(OPUS).
5. SURFACE OWNER AND ADJOINER INFORMATION TAKEN FROM THE ASSESSOR AND COUNTY CLERK RECORDS OF WETZEL COUNTY IN MARCH, 2015 AND INFORMATION PROVIDED BY STONE ENERGY CORPORATION.
6. WELLS SHOWN ARE TAKEN FROM RECORDS OF WDEP.
7. AS-DRILLED INFORMATION PROVIDED BY STONE ENERGY CORPORATION.

ZMBG #3H LANDING POINT


STATE PLANE
COORDINATES
NORTH ZONE-NAD 27
(N) 418986
(E) 1626097

L & L DECIMAL
NAD 27
39.64281
80.82459

UTM (NAD 83)
ZONE 17
METERS
4388137
515068



LEGEND

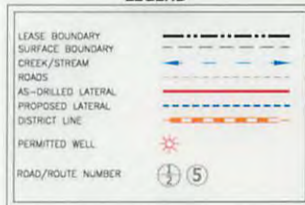

ZMBG #3H SURFACE HOLE

STATE PLANE
COORDINATES
NORTH ZONE-NAD 27
(N) 418332
(E) 1628055

L & L DECIMAL
NAD 27
39.64108
80.82080

UTM (NAD 83)
ZONE 17
METERS
4387943
515391

I THE UNDERSIGNED, HEREBY CERTIFY THAT THIS PLAT IS CORRECT TO THE BEST OF MY KNOWLEDGE AND BELIEF AND SHOWS ALL THE INFORMATION REQUIRED BY LAW AND THE RULES ISSUED AND PRESCRIBED BY THE DEPARTMENT OF ENVIRONMENTAL PROTECTION.

Doyle Hupp Jr.



(+) DENOTES LOCATION OF WELL ON UNITED STATES TOPOGRAPHIC MAPS.

DATE JULY 15, 20 15

OPERATORS WELL NO. ZMBG #3H

P.S.
834

HUPP Surveying & Mapping
P.O. Box 647 Grantsville, WV 26147
(304) 354-7035 EMAIL: hupp@frontiernet.net

API WELL NO. 47-103-02894

STATE COUNTY PERMIT

MINIMUM DEGREE OF ACCURACY 1/2500 FILE NO. W2068 (BK 77-29)

PROVEN SOURCE OF ELEVATION SG-GPS(OPUS) SCALE 1" = 1000'

STATE OF WEST VIRGINIA
DIVISION OF ENVIRONMENTAL PROTECTION
OFFICE OF OIL AND GAS



WELL TYPE : OIL GAS LIQUID INJECTION WASTE DISPOSAL IF "GAS" PRODUCTION STORAGE DEEP SHALLOW

LOCATION : ELEVATION 1,340' WATERSHED TRIBUTARY OF DOOLIN RUN

DISTRICT MAGNOLIA COUNTY WETZEL QUADRANGLE NEW MARTINSVILLE 7.5'

SURFACE OWNER LAWRENCE ZUMPETTA, et al ACREAGE 79.47±

ROYALTY OWNER LAWRENCE ZUMPETTA, et al LEASE ACREAGE 472.02± **10/16/2015**

PROPOSED WORK : LEASE NO. _____

DRILL CONVERT DRILL DEEPER REDRILL FRACTURE OR STIMULATE PLUG OFF OLD

FORMATION PERFORATE NEW FORMATION PLUG AND ABANDON CLEAN OUT AND REPLUG OTHER _____

PHYSICAL CHANGE IN WELL (SPECIFY) _____ TARGET FORMATION MARCELLUS

ESTIMATED DEPTH TVD 6,637' MD 12,807'

WELL OPERATOR STONE ENERGY CORPORATION DESIGNATED AGENT TIM MCGREGOR

ADDRESS P.O. BOX 52807 LAFAYETTE, LA 70508 ADDRESS 1300 FORT PIERPONT DR., SUITE 201 MORGANTOWN, WV 26508

COUNTY NAME
PERMIT