

WW-7
8-30-06



West Virginia Department of Environmental Protection
Office of Oil and Gas
WELL LOCATION FORM: GPS

API: 47-103-02936 WELL NO.: Shuman Haynes 1H

FARM NAME: Haynes

RESPONSIBLE PARTY NAME: Antero Resources Corporation

COUNTY: Wetzel DISTRICT: Center

QUADRANGLE: Pine Grove

SURFACE OWNER: John A. & Phillip K. Haynes

ROYALTY OWNER: _____

UTM GPS NORTHING: 4385905.41 m

UTM GPS EASTING: 529713.67 m GPS ELEVATION: 840.0 ft

The Responsible Party named above has chosen to submit GPS coordinates in lieu of preparing a new well location plat for a plugging permit or assigned API number on the above well. The Office of Oil and Gas will not accept GPS coordinates that do not meet the following requirements:

1. Datum: NAD 1983, Zone: 17 North, Coordinate Units: meters, Altitude: height above mean sea level (MSL) – meters.
2. Accuracy to Datum – 3.05 meters
3. Data Collection Method:

Survey grade GPS : Post Processed Differential _____
Real-Time Differential _____

Mapping Grade GPS : Post Processed Differential _____
Real-Time Differential _____


4. Letter size copy of the topography map showing the well location.

I the undersigned, hereby certify this data is correct to the best of my knowledge and belief and shows all the information required by law and the regulations issued and prescribed by the Office of Oil and Gas.

[Signature] _____ Permitting Manager _____ 4/10/24
Signature Title Date

05/10/2024

Antero Resources Corporation
Shuman Haynes 1H
API # 47-103-02936-0000

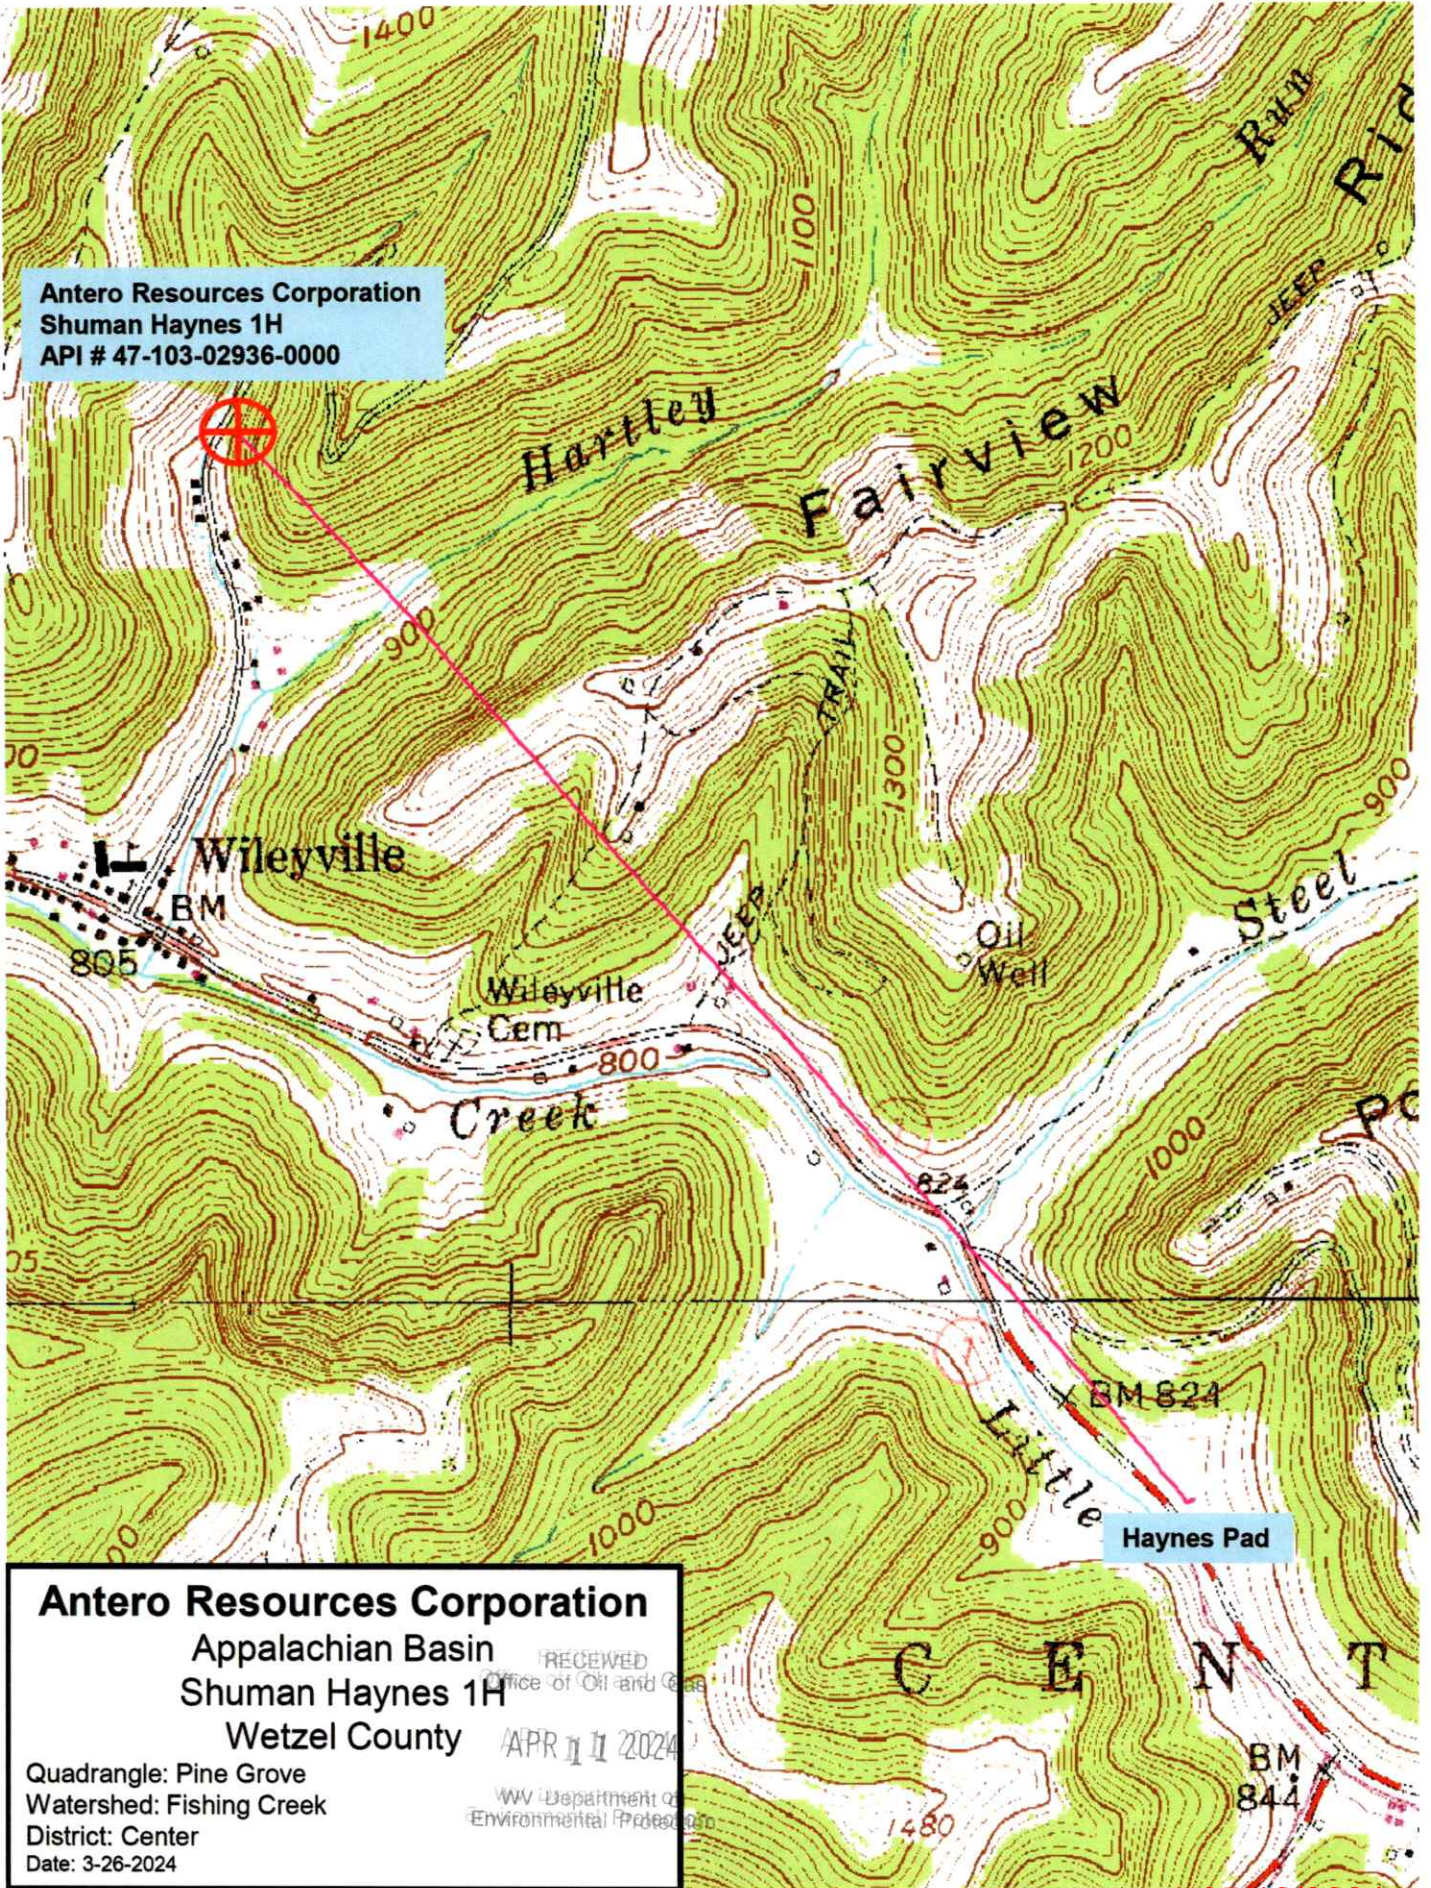

Antero Resources Corporation
Appalachian Basin
Shuman Haynes 1H
Wetzel County

Quadrangle: Pine Grove
Watershed: Fishing Creek
District: Center
Date: 3-26-2024

RECEIVED
Office of Oil and Gas
APR 11 2024
West Virginia Department of Environmental Protection

Haynes Pad

05/10/2024