


FILE #: AE003  
 DRAWING #: 2651  
 SCALE: PLAT - 1" = 600'  
 TICK MARK - 1" = 2000'  
 MINIMUM DEGREE OF ACCURACY: 1/200  
 PROVEN SOURCE OF ELEVATION: SUBMETER MAPPING GRADE GPS

I, THE UNDERSIGNED, HEREBY CERTIFY THAT THIS PLAT IS CORRECT TO THE BEST OF MY KNOWLEDGE AND BELIEF AND SHOWS ALL THE INFORMATION REQUIRED BY LAW AND THE REGULATIONS ISSUED AND PRESCRIBED BY THE DEPARTMENT OF ENVIRONMENTAL PROTECTION.

Signed: *[Signature]*  
 L.L.S. #2124 : Ernest J. Benchek III

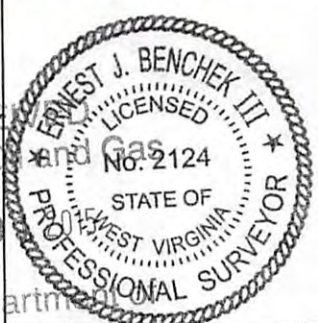

(+) DENOTES LOCATION OF WELL ON UNITED STATES TOPOGRAPHIC MAPS  
 WYDEP  
 OFFICE OF OIL & GAS  
 601 57TH STREET  
 CHARLESTON, WV 25304

Well Type:  Oil  Waste Diposal  Production  Deep  
 Gas  Liquid Injection  Storage  Shallow

WATERSHED: FISHING CREEK  
 COUNTY/DISTRICT: WETZEL / GREEN  
 SURFACE OWNER: WEST VIRGINIA DIVISION OF NATURAL RESOURCES  
 OIL & GAS ROYALTY OWNER:  
 LEASE NUMBERS:

DRILL  CONVERT  DRILL DEEPER  REDRILL  FRACTURE OR STIMULATE   
 PLUG OFF FORMATION  PERFORATE NEW FORMATION  PLUG & ABANDON   
 CLEAN OUT & REPLUG  OTHER CHANGE  (SPECIFY):

DATE: NOVEMBER 20, 2015  
 OPERATOR'S WELL #: FLUHARTY WILLIAM No. 15  
 API WELL #: 47 STATE 103 COUNTY 03146N PERMIT

ELEVATION: 1015'  
 QUADRANGLE: CENTER POINT, WV  
 ACREAGE: 168.50 +/-  
 ACREAGE: 168.50 +/-

WV Department of Environmental Protection  
 Ernest J. Benchek III  
 State of West Virginia  
 Professional Surveyor  
 License No. 2124

WELL OPERATOR: Ascent Resources-Marcellus LLC. ADDRESS: 3501 NW 63rd Street CITY: Oklahoma City STATE: OK ZIP CODE: 73116  
 DESIGNATED AGENT: Eric B. Gillespie ADDRESS: 103 Taryn Lane CITY: Cross Lanes STATE: WV ZIP CODE: 25313

12/04/2015



West Virginia Department of Environmental Protection  
Office of Oil and Gas  
**WELL LOCATION FORM: GPS**

API: 47-103-03146 WELL NO.: 15

FARM NAME: Fluharty William

RESPONSIBLE PARTY NAME: Ascent Resources - Marcellus, LLC

COUNTY: Wetzel DISTRICT: Green

QUADRANGLE: Center Point

SURFACE OWNER: WV Division of Natural Resources

ROYALTY OWNER: \_\_\_\_\_

UTM GPS NORTHING: 4369854.8

UTM GPS EASTING: 525797.6 GPS ELEVATION: 1015'

The Responsible Party named above has chosen to submit GPS coordinates in lieu of preparing a new well location plat for a plugging permit or assigned API number on the above well. The Office of Oil and Gas will not accept GPS coordinates that do not meet the following requirements:

- Datum: NAD 1983, Zone: 17 North, Coordinate Units: meters, Altitude: height above mean sea level (MSL) – meters.
- Accuracy to Datum – 3.05 meters
- Data Collection Method:  
Survey grade GPS \_\_\_\_\_: Post Processed Differential \_\_\_\_\_

Real-Time Differential \_\_\_\_\_

Mapping Grade GPS X: Post Processed Differential \_\_\_\_\_

Real-Time Differential X \_\_\_\_\_

RECEIVED  
Office of Oil and Gas  
DEC 01 2015

4. Letter size copy of the topography map showing the well location. I the undersigned, hereby certify this data is correct to the best of my knowledge and belief and shows all the information required by law and the regulations issued and prescribed by the Office of Oil and Gas.

[Signature] Regulatory Technician 11/30/2015  
Signature Title Date