

Topo Quad: Big Run 7.5'

Scale: 1" = 1000'

County: Wetzel

Date: January 30, 2025


District: Grant

Project No: 352-18-M-23

Water

Big 177 Well Pad

5 Potential Water Sources within 2500'

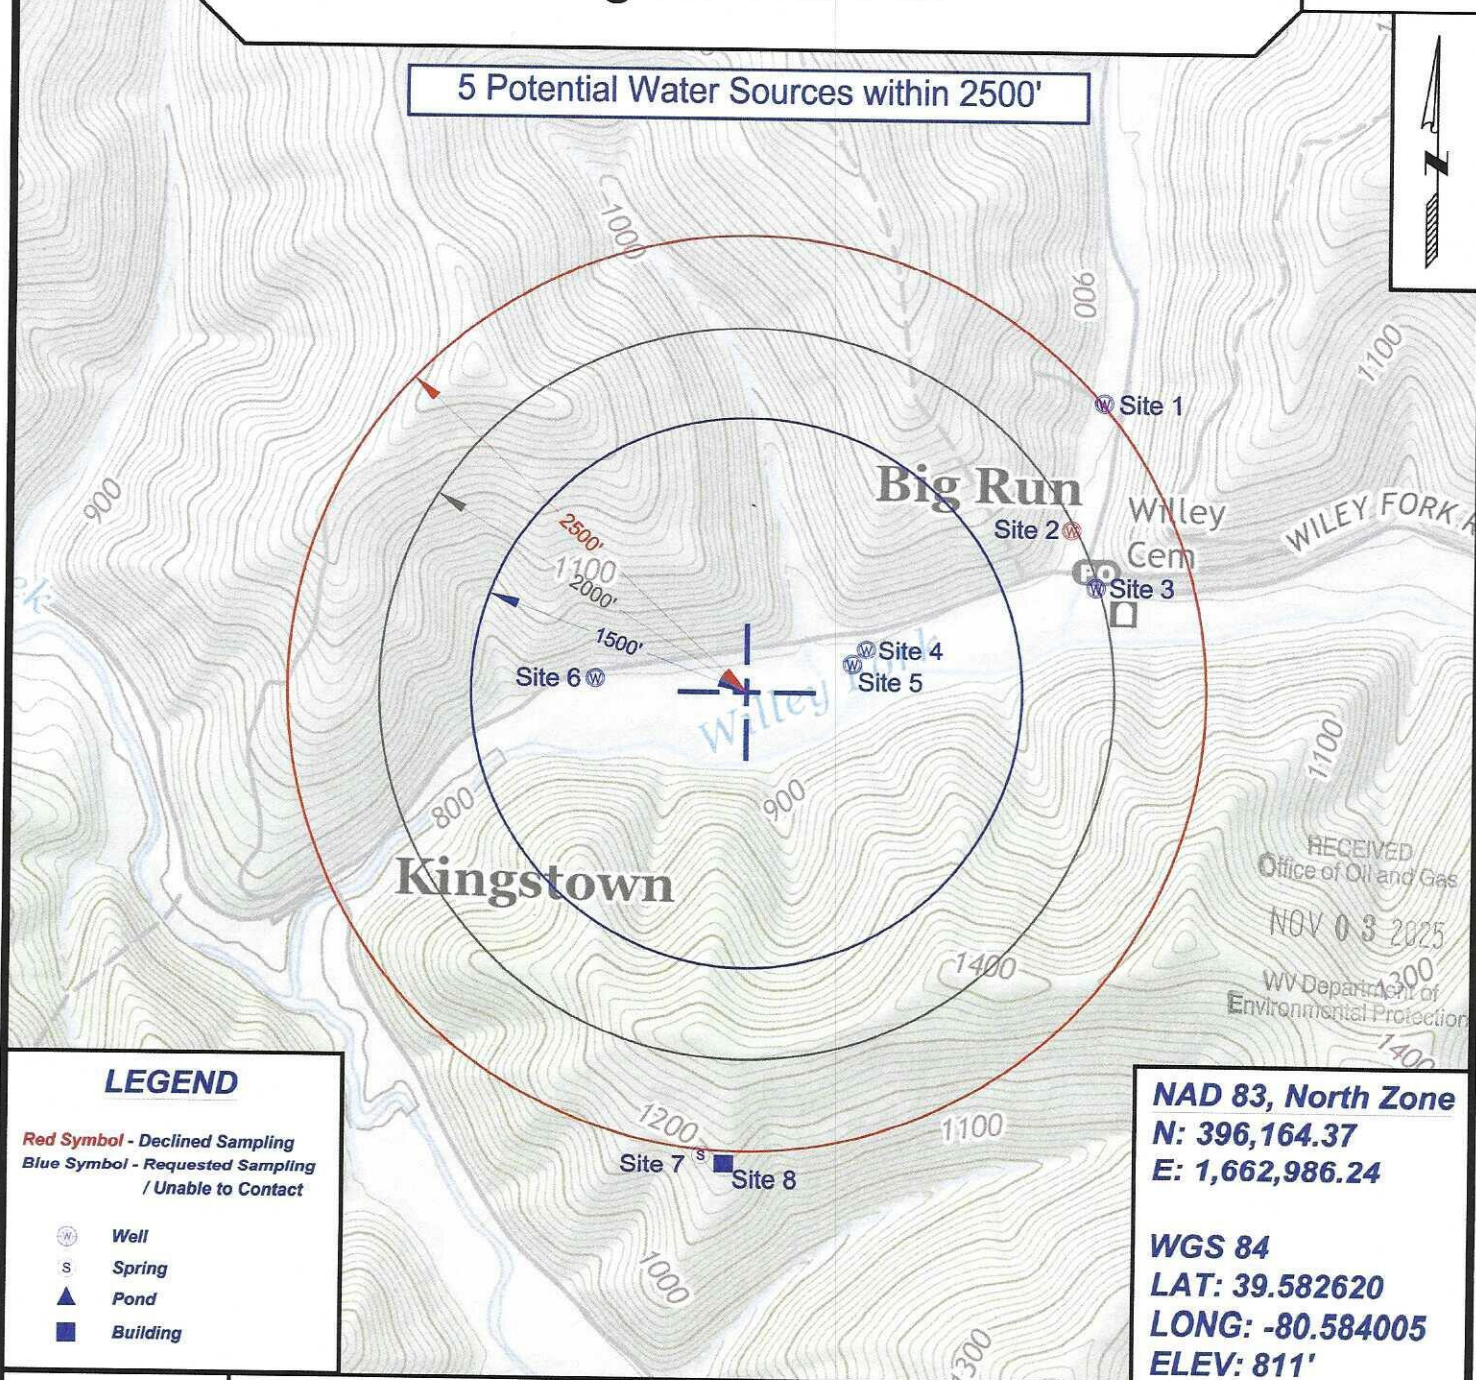

SURVEYING AND MAPPING SERVICES PERFORMED BY:

ALLEGHENY SURVEYS, INC.


1-800-482-8606
237 Birch River Road
Birch River, WV 26610
PH: (304) 649-8606
FAX: (304) 649-8608

PREPARED FOR:

EQT Production Company

400 Woodcliff Drive
Canonsburg, PA 15317

12/05/2025

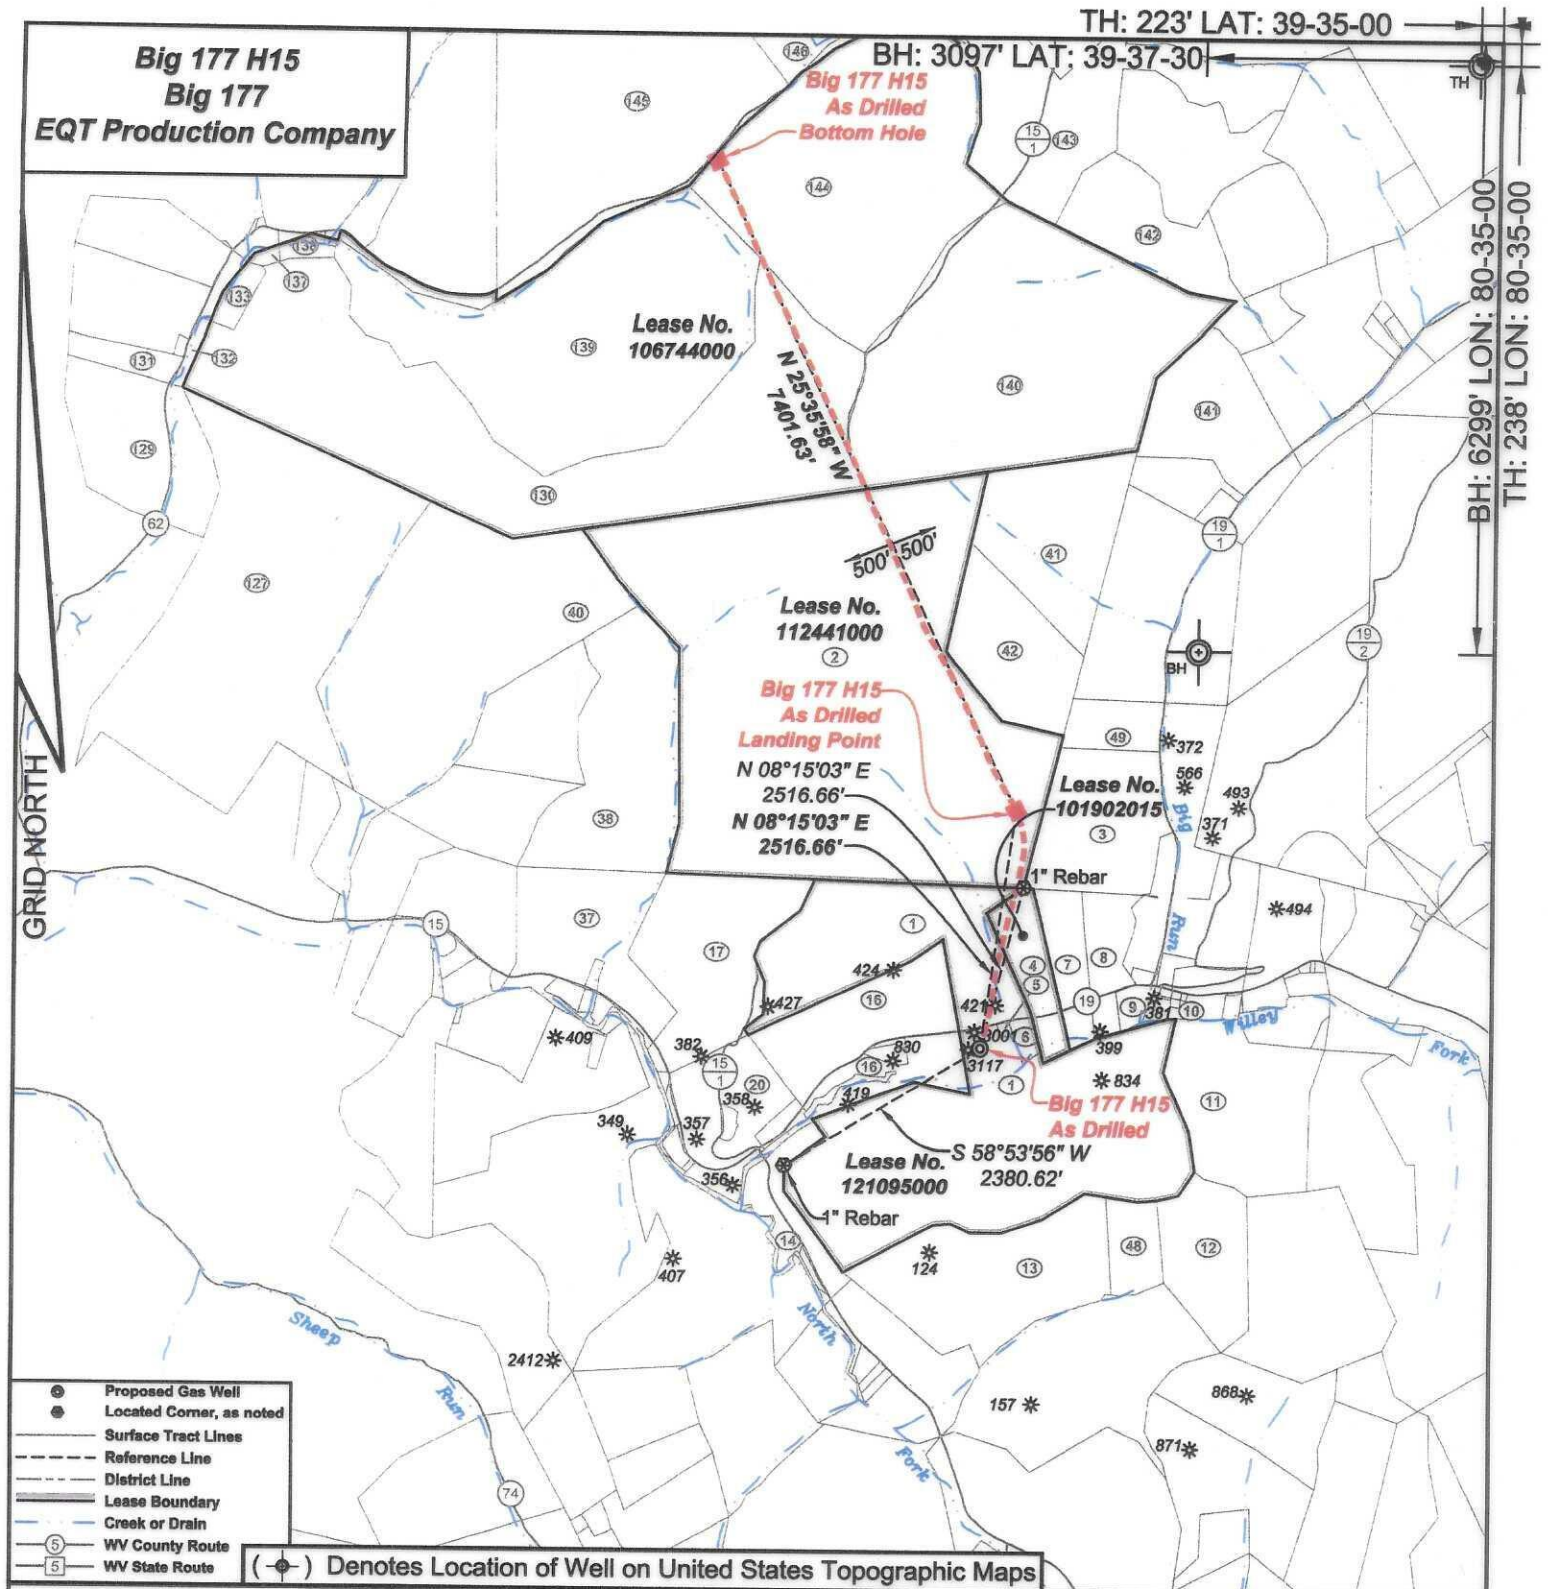

I, the undersigned, hereby certify that this plat is correct to the best of my knowledge and belief and shows all the information required by law and the regulations issued and prescribed by the Department of Environmental Protection.

Ben R. Singleton
P.S. 2092



SEAL

FILE NO: 352-23
DRAWING NO: Big 177 H15
SCALE: 1" = 2000'
MINIMUM DEGREE OF ACCURACY: 1:2500
PROVEN SOURCE OF ELEVATION: NGS CORS Station

STATE OF WEST VIRGINIA
DEPARTMENT OF ENVIRONMENTAL PROTECTION
OIL AND GAS DIVISION

DATE: October 10 20 25
OPERATOR'S WELL NO.: Big 177 H15
API WELL NO
47 - 103 - 03191
STATE COUNTY PERMIT


WELL TYPE: ☐ OIL ☒ GAS ☐ LIQUID INJECTION ☐ WASTE DISPOSAL
(IF GAS) PRODUCTION: ☐ STORAGE ☐ DEEP ☒ SHALLOW
LOCATION: ELEVATION: 810.5' WATERSHED Willey Fork of North Fork Fishing Creek QUADRANGLE: Big Run
DISTRICT: Grant COUNTY: Wetzel
SURFACE OWNER: Coastal Forest Resources Company ACREAGE: 217.19
ROYALTY OWNER: Coastal Forest Resources Company, et al. LEASE NO: 121095000 ACREAGE: 300
PROPOSED WORK: ☒ DRILL ☐ CONVERT ☐ DRILL DEEPER ☒ FRACTURE OR STIMULATE ☐ PLUG OFF OLD FORMATION
☐ PERFORATE NEW FORMATION ☐ OTHER PHYSICAL CHANGE IN WELL (SPECIFY)
☐ PLUG AND ABANDON ☐ CLEAN OUT AND REPLUG TARGET FORMATION: Marcellus ESTIMATED DEPTH: 6849'

WELL OPERATOR: EQT Production Company
ADDRESS: 2200 Energy Drive
Canonsburg, PA 15317


DESIGNATED AGENT: Joseph C. Mallow
ADDRESS: 427 Midstate Drive
Clarksburg, WV 26301

Big 177 H15
Big 177
EQT Production Company

Tract I.D.	Tax Map No.	Parcel No.	County	District	Surface Tract Owner	Acres
1	13	6	Wetzel	Grant	Coastal Forest Resources Company	217.19
2	8	18	Wetzel	Grant	Coastal Forest Resources Company	337
3	8	23.2	Wetzel	Grant	James L. Dulaney	43.19
4	8	35	Wetzel	Grant	John D. Parks	15.5
5	8	66	Wetzel	Grant	EQM Gathering OPOO LLC	0.418
6	8	65	Wetzel	Grant	Ikey, Joe & Tina M. Willey	2.15
7	8	36	Wetzel	Grant	James L. & Karen Dulaney	14.1
8	8	37	Wetzel	Grant	James L. & Karen Dulaney	14.1
9	8	43	Wetzel	Grant	Judy K. Utt	3.25
10	8	45	Wetzel	Grant	Dale K. Dulaney	9.828
11	13	7	Wetzel	Grant	Mansel Lee McDiffitt, et al.	51.8
12	13	15	Wetzel	Grant	Robert Scott & Alfred Bryan Cole	27.75
13	13	13	Wetzel	Grant	Linda L. Dunn	67.5
14	13	12	Wetzel	Grant	Leslie Lydick & Susan Miracle	15.02
16	13	6.1	Wetzel	Grant	Coastal Forest Resources Company	55.06
17	8	34	Wetzel	Grant	Hallie M. & Paul E. Hardbarger	54.01
20	13	4	Wetzel	Grant	Jeffrey L. & Beth Willey	26.8
37	7	34	Wetzel	Grant	Kenneth E. Wildman Life Estate	44.6
38	8	17	Wetzel	Grant	Kenneth E. Wildman Life Estate	67
40	7	10	Wetzel	Grant	Coastal Forest Resources Company	120
41	8	10	Wetzel	Grant	Mark W. Minor, et al.	48.1
42	8	19	Wetzel	Grant	Phillip Brent & Kimberly Shreve	46.45
48	13	14	Wetzel	Grant	Linda L. Dunn	12.5
49	8	23	Wetzel	Grant	Dale K. Dulaney	43.19
127	7	9	Wetzel	Grant	Coastal Forest Resources Company	170.88
129	7	5	Wetzel	Grant	Christopher M. Morgan, et al.	74
130	7	3	Wetzel	Grant	Coastal Forest Resources Company	178
131	7	60	Wetzel	Grant	Oody Norris	10
132	7	2.2	Wetzel	Grant	Oody Norris	2.43
133	7	3.1	Wetzel	Grant	Edward L. Dulaney, et al.	4
137	2	15	Wetzel	Grant	Teora L. & Sandra J. Dulaney	1.023
138	2	16	Wetzel	Grant	Teora L. & Sandra J. Dulaney	3.187
139	7	3.2	Wetzel	Grant	Coastal Forest Resources Company	156.98
140	8	1	Wetzel	Grant	Danny & Dustin Stockslager	170
141	8	12	Wetzel	Grant	Shirley A. Titus	41.9
142	3	24	Wetzel	Grant	Coastal Forest Resources Company	35.89
143	3	14	Wetzel	Grant	Owen E. & Saloma D. Schmucker	70.5
144	3	23	Wetzel	Grant	Coastal Forest Resources Company	167.75
145	3	13	Wetzel	Grant	Edward L. Dulaney	164.75
146	3	5	Wetzel	Grant	Coastal Forest Resources Company	179

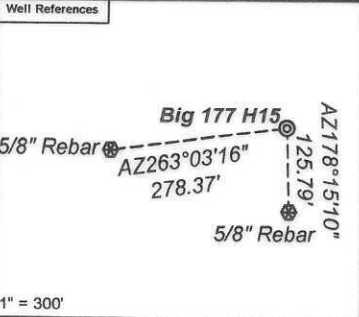

As Drilled Well Information:
Big 177 H15 coordinates are
NAD 27 N: 396,134.06 E: 1,694,465.38
NAD 83 UTM N: 4,381,518.73 E: 535,736.68
Big 177 H15 Landing Point coordinates are
NAD 27 N: 398,624.64 E: 1,694,826.42
NAD 83 UTM N: 4,382,279.36 E: 535,834.04
Big 177 H15 Bottom Hole coordinates are
NAD 27 N: 405,299.73 E: 1,691,628.15
NAD 83 UTM N: 4,384,296.71 E: 534,825.77
West Virginia Coordinate system of 1927 (North Zone)
based upon Differential GPS Measurements.
Plat orientation, corner and well ties are based upon
the grid north meridian.
Well location references are based upon the grid north
meridian.
UTM coordinates are NAD83, Zone 17, Meters.

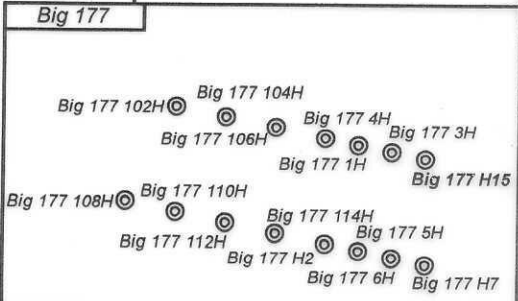

Lease No.	Owner	Acres
121095000	Coastal Forest Resources Company, et al.	300
101902015	ET Blue Grass, LLC., et al.	16
112441000	EQT Production Company	300
106744000	Shiben Estates, Inc., et al.	1030

