

WW-7  
8-30-06



West Virginia Department of Environmental Protection  
Office of Oil and Gas

**WELL LOCATION FORM: GPS**

API: 47-103-71027 WELL NO.: 7182

FARM NAME: LLOYD F. CAIN

RESPONSIBLE PARTY NAME: CONSOLIDATION COAL COMPANY

COUNTY: WETZEL DISTRICT: GRANT

QUADRANGLE: FOLSOM WV 7.5'

SURFACE OWNER: EVERETT & EDITH HAUGHT

ROYALTY OWNER: \_\_\_\_\_

UTM GPS NORTHING: 4,370,946 m (1489')

UTM GPS EASTING: 541,432 m GPS ELEVATION: 454 m

The Responsible Party named above has chosen to submit GPS coordinates in lieu of preparing a new well location plat for a plugging permit or assigned API number on the above well. The Office of Oil and Gas will not accept GPS coordinates that do not meet the following requirements:

1. Datum: NAD 1983, Zone: 17 North, Coordinate Units: meters, Altitude: height above mean sea level (MSL) – meters.
2. Accuracy to Datum – 3.05 meters
3. Data Collection Method:

Survey grade GPS \_\_\_\_\_: Post Processed Differential \_\_\_\_\_

Real-Time Differential \_\_\_\_\_

Mapping Grade GPS X: Post Processed Differential X

Real-Time Differential \_\_\_\_\_

4. **Letter size copy of the topography map showing the well location.**

I the undersigned, hereby certify this data is correct to the best of my knowledge and belief and shows all the information required by law and the regulations issued and prescribed by the Office of Oil and Gas.

Professional Surveyor

APRIL 4, 2019

Signature


Title

Date

RECEIVED  
Office of Oil and Gas  
APR 10 2019  
WV Department of  
Environmental Protection

FOLSOM QUADRANGLE  
WEST VIRGINIA  
7.5 MINUTE SERIES (TOPOGRAPHIC)  
NE/4 CENTER POINT 15' QUADRANGLE

4710303309P  
06/14/2019  
496310 (2019)  
(GLOVER)

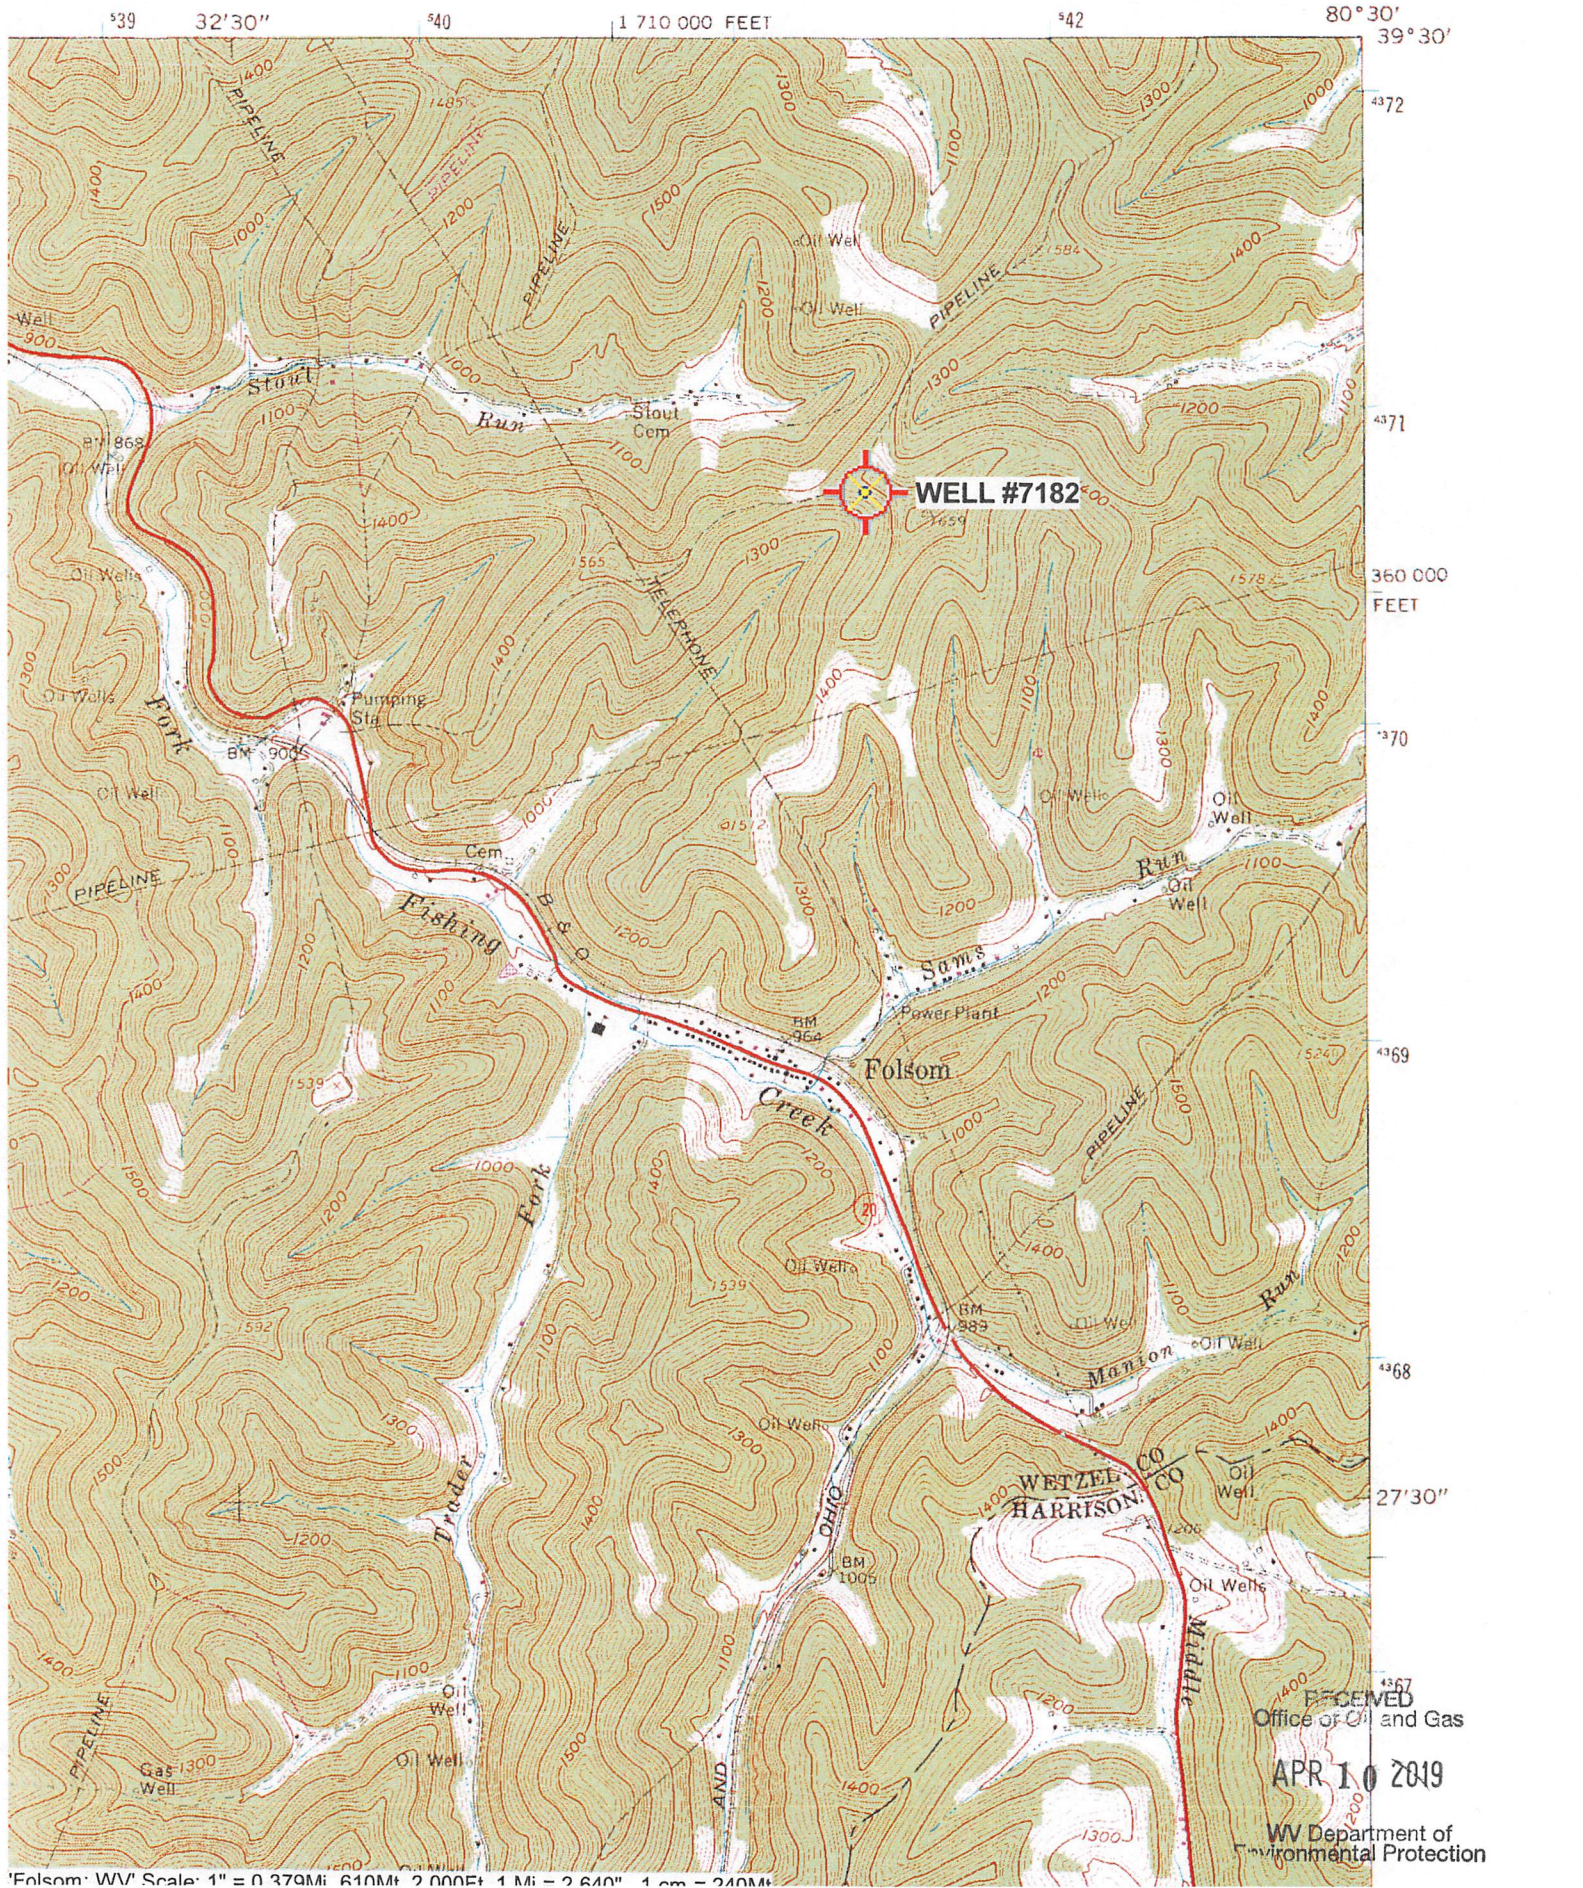

Folsom: WV Scale: 1" = 0.379Mi 610M 2.000ft 1 Mi = 2.640" 1 cm = 240M

RECEIVED  
Office of Oil and Gas  
APR 10 2019  
WV Department of Environmental Protection