


|                                     |
|-------------------------------------|
| <b>SURFACE HOLE LOCATION (SHL):</b> |
| <b>GEOGRAPHIC (NAD83):</b>          |
| <b>LATITUDE: 39.654558°</b>         |
| <b>LONGITUDE: -80.679166°</b>       |
| <b>BOTTOM HOLE LOCATION (BHL):</b>  |
| <b>GEOGRAPHIC (NAD83):</b>          |
| <b>LATITUDE: 39.677132°</b>         |
| <b>LONGITUDE: -80.720929°</b>       |
| <b>SURFACE HOLE LOCATION (SHL):</b> |
| <b>GEOGRAPHIC (NAD83):</b>          |
| <b>LATITUDE: 39.654558°</b>         |
| <b>LONGITUDE: -80.679166°</b>       |
| <b>BOTTOM HOLE LOCATION (BHL):</b>  |
| <b>GEOGRAPHIC (NAD83):</b>          |
| <b>LATITUDE: 39.677135°</b>         |
| <b>LONGITUDE: -80.720925°</b>       |

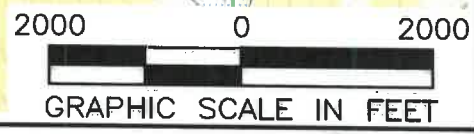

**NOTES ON SURVEY**

1. SURFACE AND ROYALTY OWNER INFORMATION AND THEIR BOUNDARIES SHOWN HEREON WERE PLOTTED FROM DEEDS AND/OR TAX PARCEL MAPS PROVIDED BY CLIENT AND/OR FIELD LOCATIONS.
2. THIS PLAT DOES NOT REPRESENT A BOUNDARY SURVEY OF THE PARCELS SHOWN HEREON.
3. ALL INSETS ARE GRID NORTH UNLESS OTHERWISE DEPICTED.

**LEGEND:**

- EXISTING BOTTOM HOLE
- ⊙ EXISTING / PRODUCING WELLHEAD
- LPL\* EXISTING LANDING POINT LOCATION
- PROPOSED SURFACE HOLE / BOTTOM HOLE
- LPL\* PROPOSED LANDING POINT LOCATION
- ACCESS ROAD
- PUBLIC ROAD
- FLOOD PLAIN
- LEASE BOUNDARY
- ASDRILLED PATH
- PROPOSED PATH

08/13/2021

|  |  |                             |                             |
|--|--|-----------------------------|-----------------------------|
| <b>WELL OPERATOR:</b><br>SWN PRODUCTION COMPANY, LLC                         | <b>WELL (FARM) NAME:</b><br>CONSTANCE TAYLOR WTZ         | <b>WELL #</b><br>201H       | <b>SERIAL #</b><br>XXXX     |
| <b>ADDRESS:</b><br>1300 FORT PIERPONT DRIVE, SUITE 201, MORGANTOWN, WV 26508 | <b>COUNTY:</b><br>WETZEL                                 | <b>CODE:</b><br>103         | <b>DISTRICT:</b><br>PROCTOR |
| <b>SURFACE OWNER:</b><br>CONSTANCE A. TAYLOR                                 | <b>USGS 7 1/2 QUADRANGLE MAP NAME:</b><br>WILEYVILLE, WV |                             |                             |
|  |  | <b>API #</b><br>47-103-3354 |                             |