

WW-7
8-30-06

4710303379P
PREVIOUS API No
47-103-71020



West Virginia Department of Environmental Protection
Office of Oil and Gas
WELL LOCATION FORM: GPS

API: 47-103-71020 WELL NO.: 6731

FARM NAME: GENINE ROBINSON

RESPONSIBLE PARTY NAME: WEST VIRGINIA LAND RESOURCES INC.

COUNTY: WETZEL DISTRICT: GRANT

QUADRANGLE: FOLSOM W.VA

SURFACE OWNER: COASTAL FOREST RESOURCES CO.

ROYALTY OWNER: _____

UTM GPS NORTHING: 4,370,828 m (1476')

UTM GPS EASTING: 542,964 m GPS ELEVATION: 450 m

The Responsible Party named above has chosen to submit GPS coordinates in lieu of preparing a new well location plat for a plugging permit or assigned API number on the above well. The Office of Oil and Gas will not accept GPS coordinates that do not meet the following requirements:

1. Datum: NAD 1983, Zone: 17 North, Coordinate Units: meters, Altitude: height above mean sea level (MSL) – meters.
2. Accuracy to Datum – 3.05 meters
3. Data Collection Method:

Survey grade GPS _____ : Post Processed Differential _____

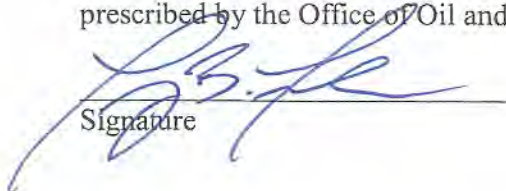
Real-Time Differential _____

Mapping Grade GPS X : Post Processed Differential X

Real-Time Differential _____

4. Letter size copy of the topography map showing the well location.

I the undersigned, hereby certify this data is correct to the best of my knowledge and belief and shows all the information required by law and the regulations issued and prescribed by the Office of Oil and Gas.


Signature

Professional Surveyor
Title

JANUARY 20, 2021
Date

RECEIVED
Office of Oil and Gas

MAR 03 2021

WV Department of
Environmental Protection

04/02/2021

4710303379P

FOLSOM QUADRANGLE
WEST VIRGINIA
7.5 MINUTE SERIES (TOPOGRAPHIC)
NE/4 CENTER POINT 15' QUADRANGLE

1963 II SW
(GLOVER GAP)



WELL #6731

360 000
FEET

RECEIVED
Office of Oil and Gas

MAR 03 2021

WV Department of
Environmental Protection

04/02/2021

'Folsom; WV' Scale: 1" = 0.379Mi 610Mt 2,000Ft, 1 Mi = 2.640" , 1 cm = 240Mt