


4710303577P

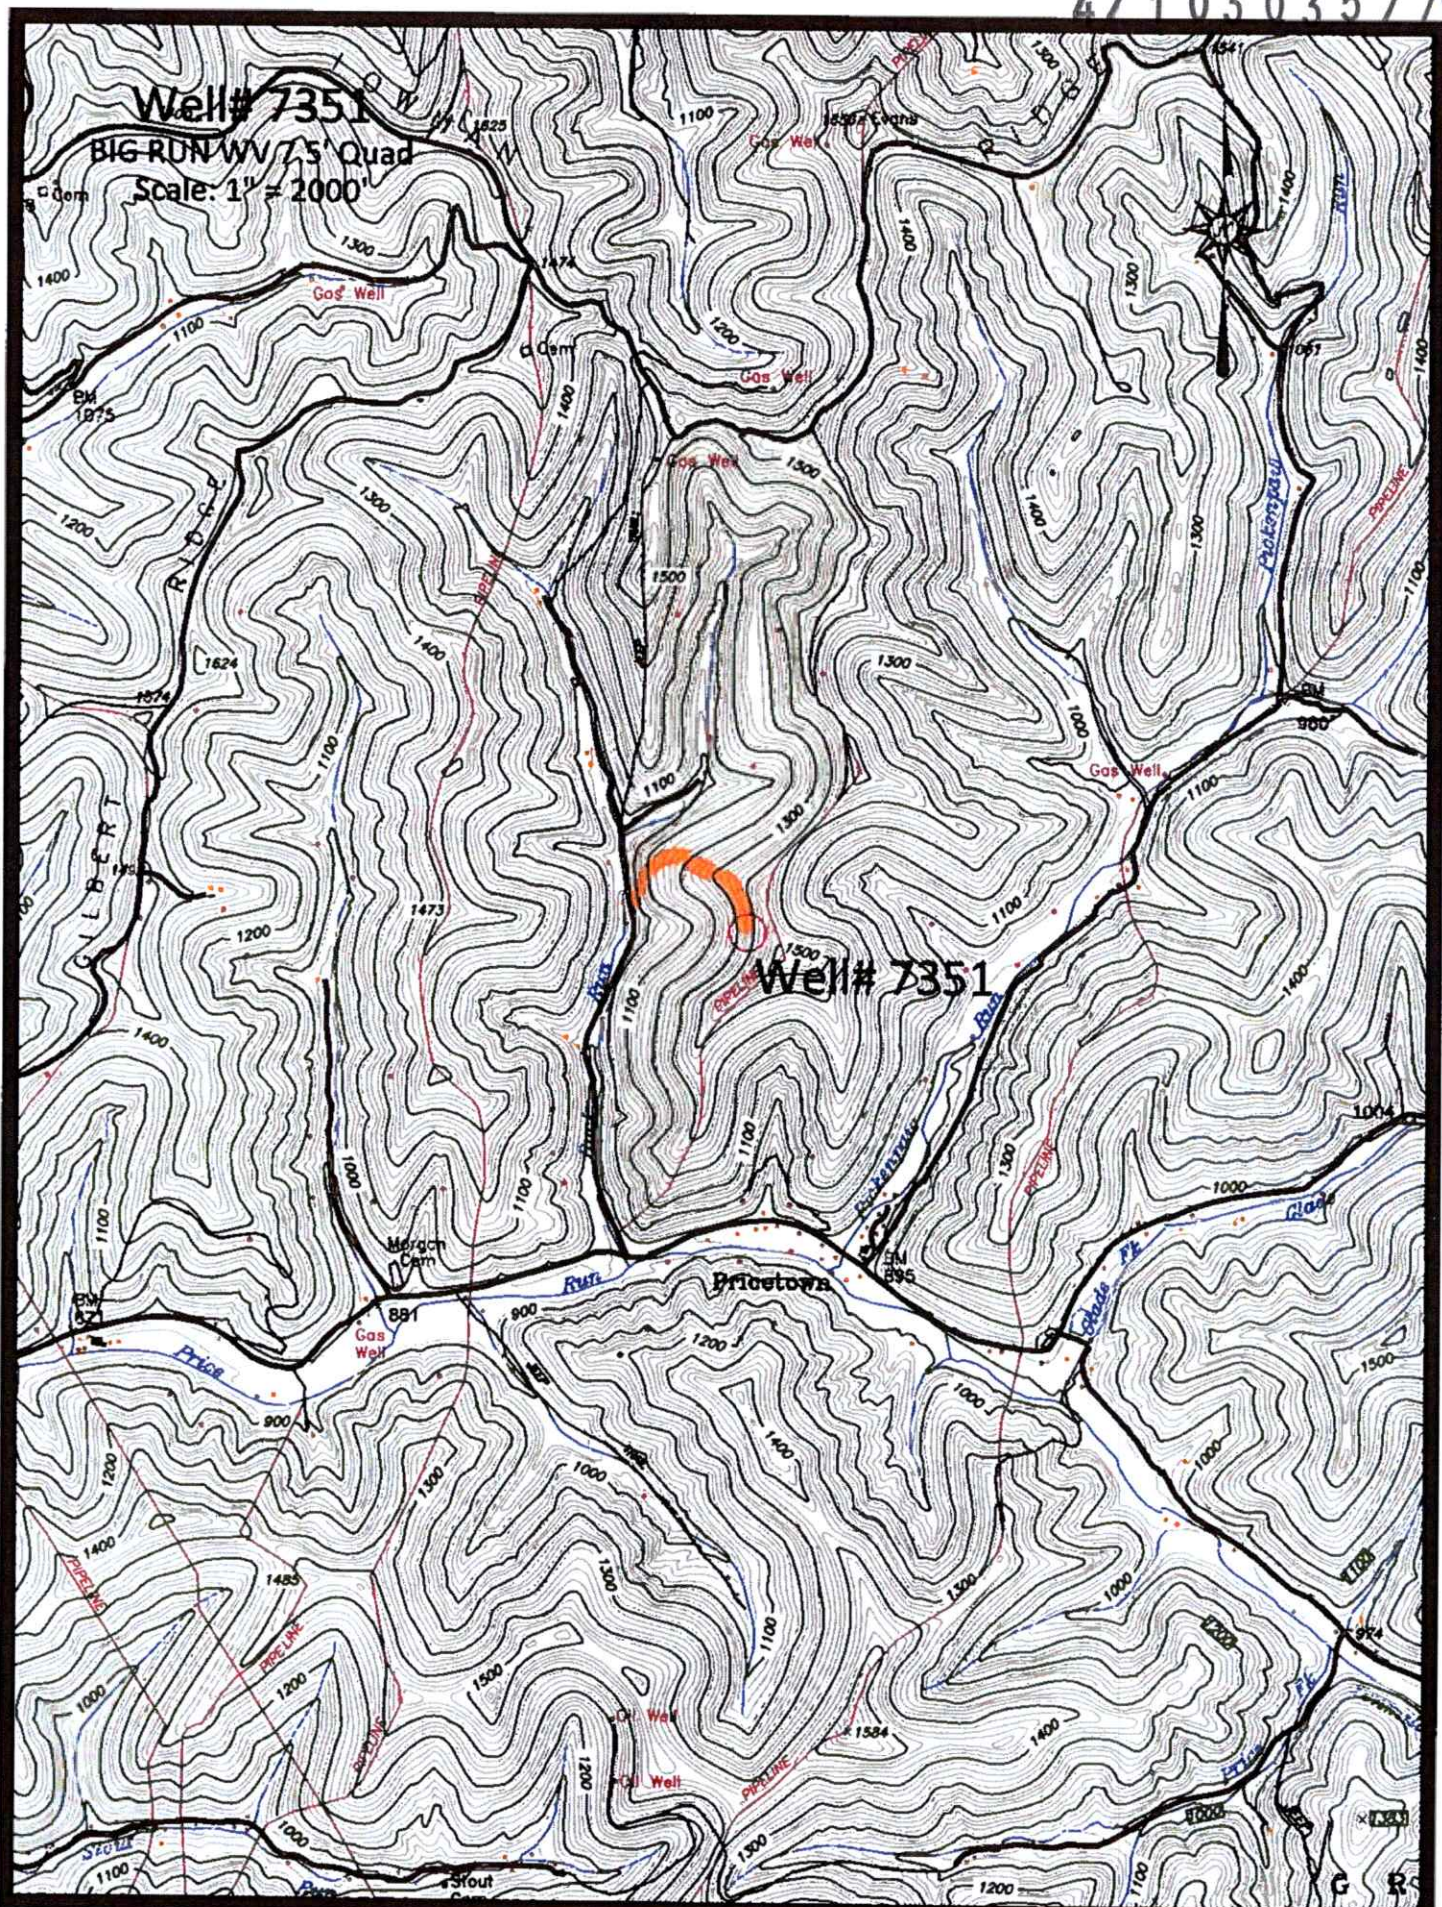

Herace Knot

04/21/2023

0303577P



477
32'30"

476

475

474

47300000

39°30'

80°30'

RECEIVED
Office of Oil and Gas
MAR 20 2023
WV Department of
Environmental Protection

1 MILE
3280 FEET

ROAD CLASSIFICATION

Heavy-duty ——— Light-duty ———

Medium-duty ——— Unimproved dirt - - - - -

State Route



Scale: 1" = 0.379Mi 610M 2,000Ft. 1 Mi = 2,640". 1 cm = 240M

BIG RUN, W. VA.
SE/4 LITTLETON 15' QUADRANGLE
N3930—W8030/7 5

04/21/2023

(WALLACE)
1862 17 NW

4710303577P

WW-7
8-30-06



West Virginia Department of Environmental Protection
Office of Oil and Gas

WELL LOCATION FORM: GPS

API: 47-103-72324 WELL NO.: 7351

FARM NAME: B. W. PETERSON

RESPONSIBLE PARTY NAME: WEST VIRGINIA LAND RESOURCES INC.

COUNTY: WETZEL DISTRICT: GRANT

QUADRANGLE: BIG RUN W.VA

SURFACE OWNER: JOHN DALE COEN

ROYALTY OWNER: _____

UTM GPS NORTHING: 4,374,335 m

UTM GPS EASTING: 541,603 m GPS ELEVATION: 413 m (1355')

The Responsible Party named above has chosen to submit GPS coordinates in lieu of preparing a new well location plat for a plugging permit or assigned API number on the above well. The Office of Oil and Gas will not accept GPS coordinates that do not meet the following requirements:

1. Datum: NAD 1983, Zone: 17 North, Coordinate Units: meters, Altitude: height above mean sea level (MSL) – meters.
2. Accuracy to Datum – 3.05 meters
3. Data Collection Method:

Survey grade GPS _____: Post Processed Differential _____

Real-Time Differential _____

Mapping Grade GPS X: Post Processed Differential X

Real-Time Differential _____

4. Letter size copy of the topography map showing the well location.

I the undersigned, hereby certify this data is correct to the best of my knowledge and belief and shows all the information required by law and the regulations issued and prescribed by the Office of Oil and Gas.

[Signature]
Signature

Professional Surveyor
Title

MARCH 7, 2023
Date

RECEIVED
Office of Oil and Gas
MAR 20 2023
WV Department of
Environmental Protection

Stephen M. [Signature]
04/21/2023