


4710303580P

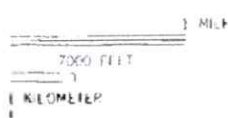

ROAD CLASSIFICATION

- Heavy-duty
- Medium-duty
- Light-duty
- Unimproved dirt
- State Route

RECEIVED
Office of Oil and Gas
WALLACE
486314 NW

APR 14 2023

BIG RUN, W. VA.
SF/4 LITTLETON 15' QUADRANGLE WV Department of
N3930--W8030/7.5 Environmental Protection

16 Big Run: WV Scale: 1" = 0.379Mi 610Mi 2,000Ft. 1 Mi = 2,640' 1 cm = 240Mi

05/05/2023

47 1 03 03 5 8 0 P

WW-7
8-30-06



West Virginia Department of Environmental Protection
Office of Oil and Gas

WELL LOCATION FORM: GPS

API: 47-103-72435 WELL NO.: 7468

FARM NAME: E. Z. HORNER

RESPONSIBLE PARTY NAME: WEST VIRGINIA LAND RESOURCES INC.

COUNTY: WETZEL DISTRICT: GRANT

QUADRANGLE: BIG RUN W.VA

SURFACE OWNER: MOUNTAIN VALLEY PIPELINE LLC.

ROYALTY OWNER: _____

UTM GPS NORTHING: 4,374,033 m (1358')

UTM GPS EASTING: 539,777 m GPS ELEVATION: 414 m

The Responsible Party named above has chosen to submit GPS coordinates in lieu of preparing a new well location plat for a plugging permit or assigned API number on the above well. The Office of Oil and Gas will not accept GPS coordinates that do not meet the following requirements:

1. Datum: NAD 1983, Zone: 17 North, Coordinate Units: meters, Altitude: height above mean sea level (MSL) – meters.
2. Accuracy to Datum – 3.05 meters
3. Data Collection Method:
Survey grade GPS _____: Post Processed Differential _____

Real-Time Differential _____
 Mapping Grade GPS X: Post Processed Differential X
 Real-Time Differential _____


RECEIVED
Office of Oil and Gas

APR 14 2023

WV Department of
Environmental Protection

4. Letter size copy of the topography map showing the well location.

I the undersigned, hereby certify this data is correct to the best of my knowledge and belief and shows all the information required by law and the regulations issued and prescribed by the Office of Oil and Gas.

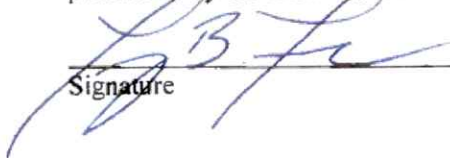

Signature

Professional Surveyor

Title

MARCH 17, 2023

Date

Stephen McCoy
05/05/2023