


4710303721



477
32'30"
476
475
474
473
39°30'
80°30'

39 32'30" 40 41 8420000E

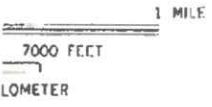

Revisions shown in purple compiled in cooperation with State of West Virginia agencies from aerial photographs taken 1976. This information not field checked.

REQUEST

'Big Run, WV Scale: 1" = 0.379Mi 610Mt 2.000Ft. 1 Mi = 2.640" . 1 cm = 240Mt

ROAD CLASSIFICATION

- Heavy-duty ————
- Medium-duty ————
- Light-duty ————
- Unimproved dirt ————

State Route

RECEIVED
Office of Oil and Gas

FEB 10 2025

WV Department of Environmental Protection

BIG RUN, W. VA.

SE/4 LITTLETON 15' QUADRANGLE
N3930—W8030/7.5

1960
PHOTOREVISED 1976
AMS 4863 II SE—SERIES 03/07/2025

47470303721
10303721

Well# 7452
BIG RUN WV 7.5' Quad
Scale: 1" = 500'




Well# 7452

Run

PIPELINE


RECEIVED
Office of Oil and Gas
FEB 10 2025
WV Department of
Environmental Protection

 Access Road

03/07/2025

Well # 7452
BIG RUN W 7.5' Quad
Scale: 1" = 2000'

Well #7452

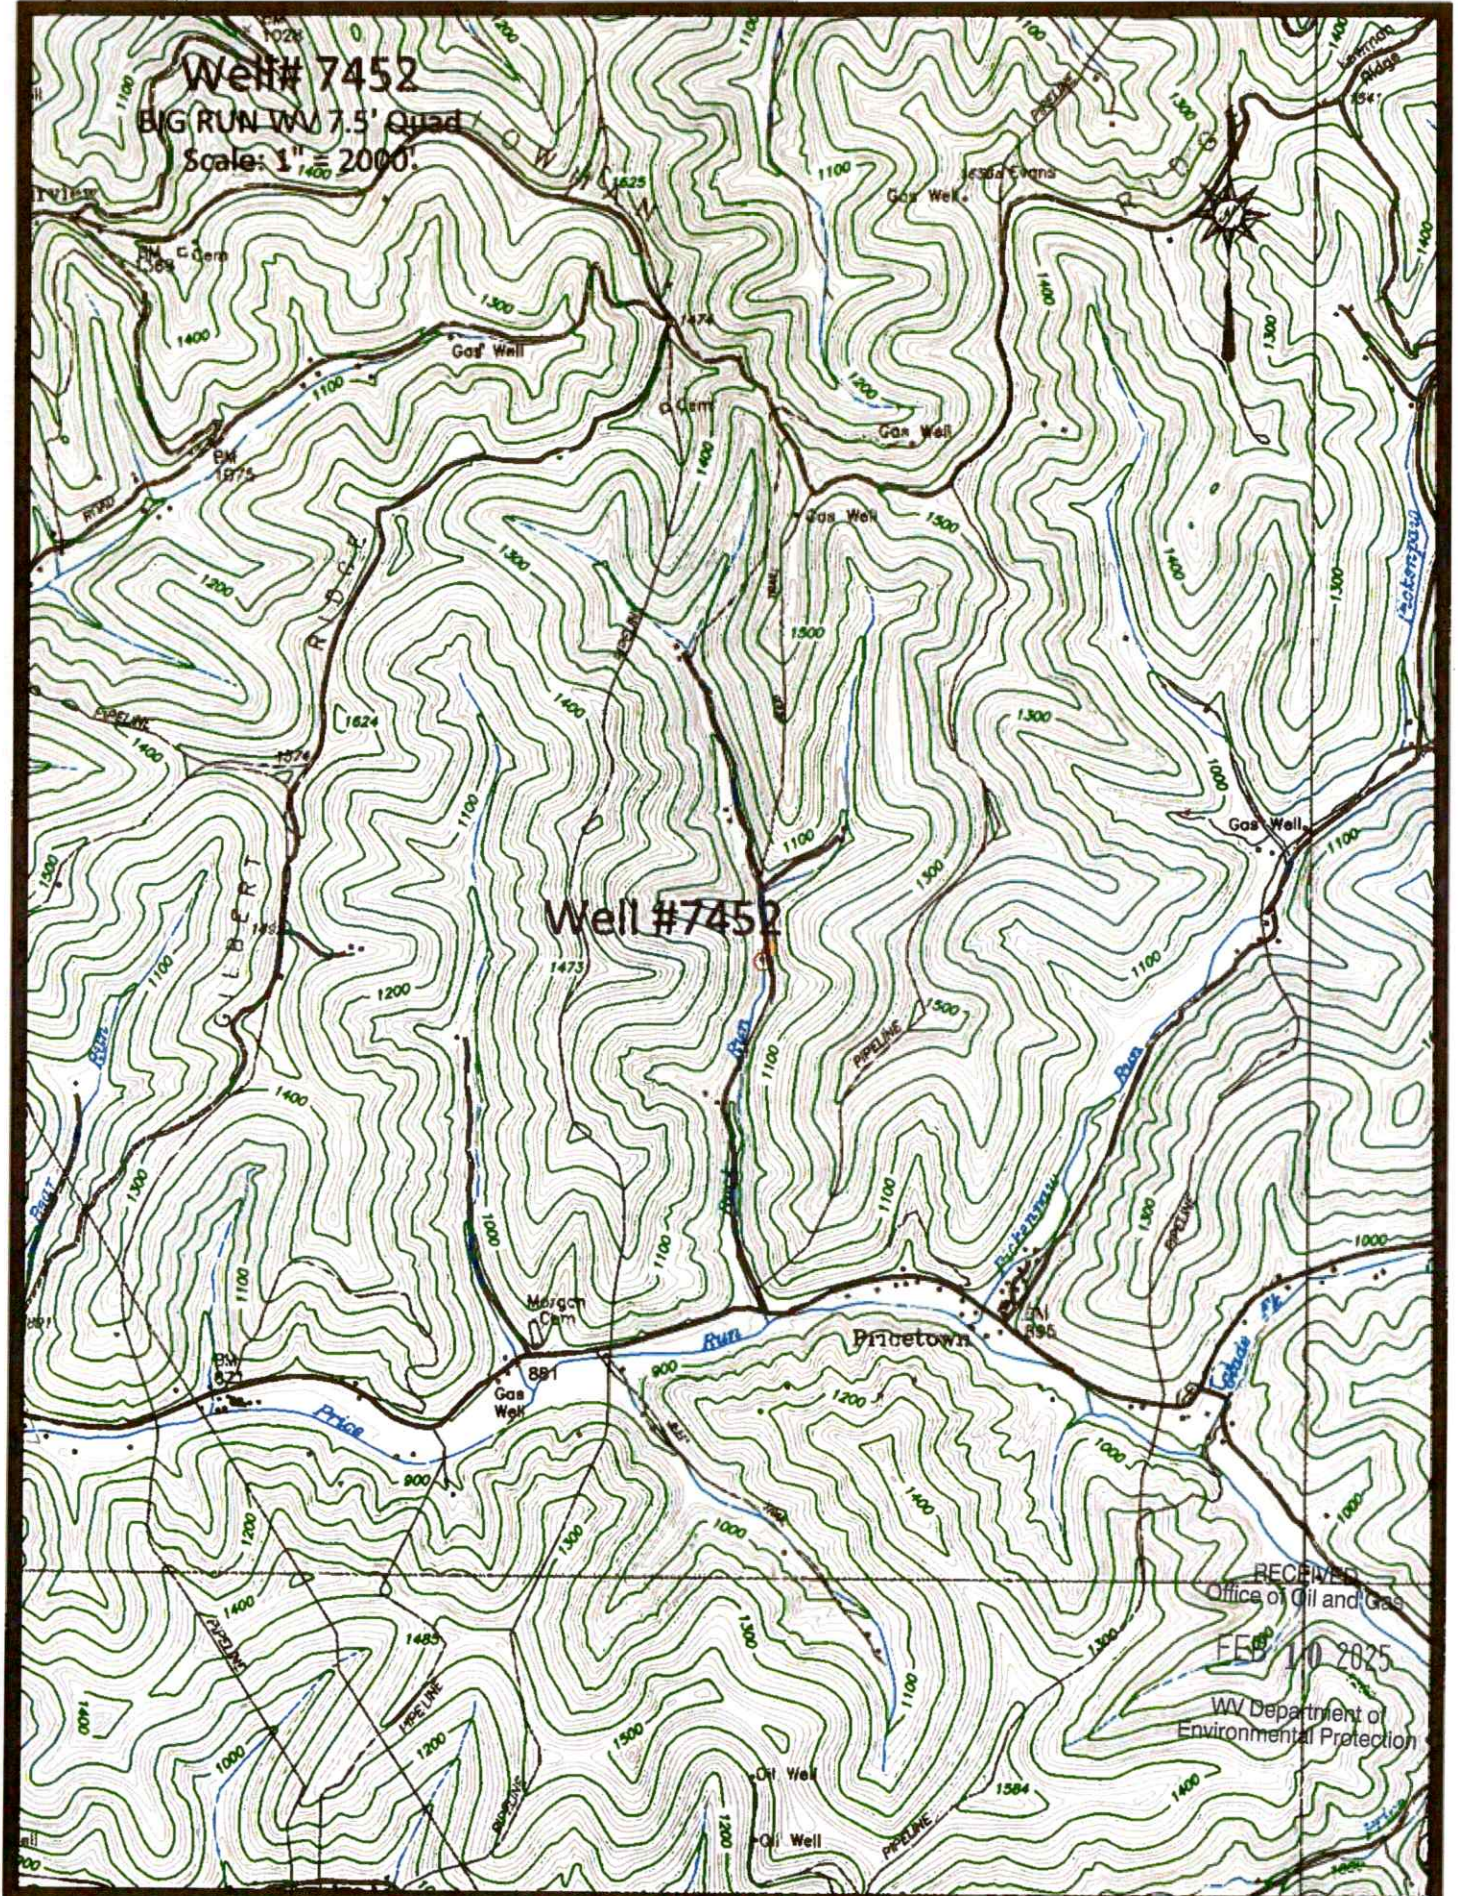

RECEIVED
Office of Oil and Gas
EE 10 2025
WV Department of
Environmental Protection

Horse Road

03/07/2025



4710303721

WW-7
8-30-06



West Virginia Department of Environmental Protection
Office of Oil and Gas
WELL LOCATION FORM: GPS

API: 47-103-72321 WELL NO.: 7452

FARM NAME: ENSMINGER 2

RESPONSIBLE PARTY NAME: WEST VIRGINIA LAND RESOURCES INC.

COUNTY: WETZEL DISTRICT: GRANT

QUADRANGLE: BIG RUN WV

SURFACE OWNER: R L ENSMINGER

ROYALTY OWNER: _____

UTM GPS NORTHING: 4,374,410. m

UTM GPS EASTING: 541,200 m GPS ELEVATION: 290 m

The Responsible Party named above has chosen to submit GPS coordinates in lieu of preparing a new well location plat for a plugging permit or assigned API number on the above well. The Office of Oil and Gas will not accept GPS coordinates that do not meet the following requirements:


- Datum: NAD 1983, Zone: 17 North, Coordinate Units: meters, Altitude: height above mean sea level (MSL) – meters.
- Accuracy to Datum – 3.05 meters
- Data Collection Method:

Survey grade GPS : Post Processed Differential
Real-Time Differential _____

Mapping Grade GPS _____ : Post Processed Differential _____
Real-Time Differential _____

- Letter size copy of the topography map showing the well location.**

I the undersigned, hereby certify this data is correct to the best of my knowledge and belief and shows all the information required by law and the regulations issued and prescribed by the Office of Oil and Gas.

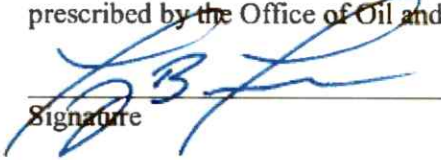
Signature

PS 2002
Title

JANUARY 31, 2025
Date

RECEIVED
Office of Oil and Gas
FEB 10 2025
WV Department of
Environmental Protection

03/07/2025