
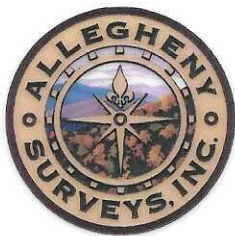


Big 177 104H
Big 177
EQT Production Company

TH: 208' LAT: 39-35-00


BH: 11564' LAT: 39-35-00

ON: 80-32-30
TH: 241' LON: 80-35-00

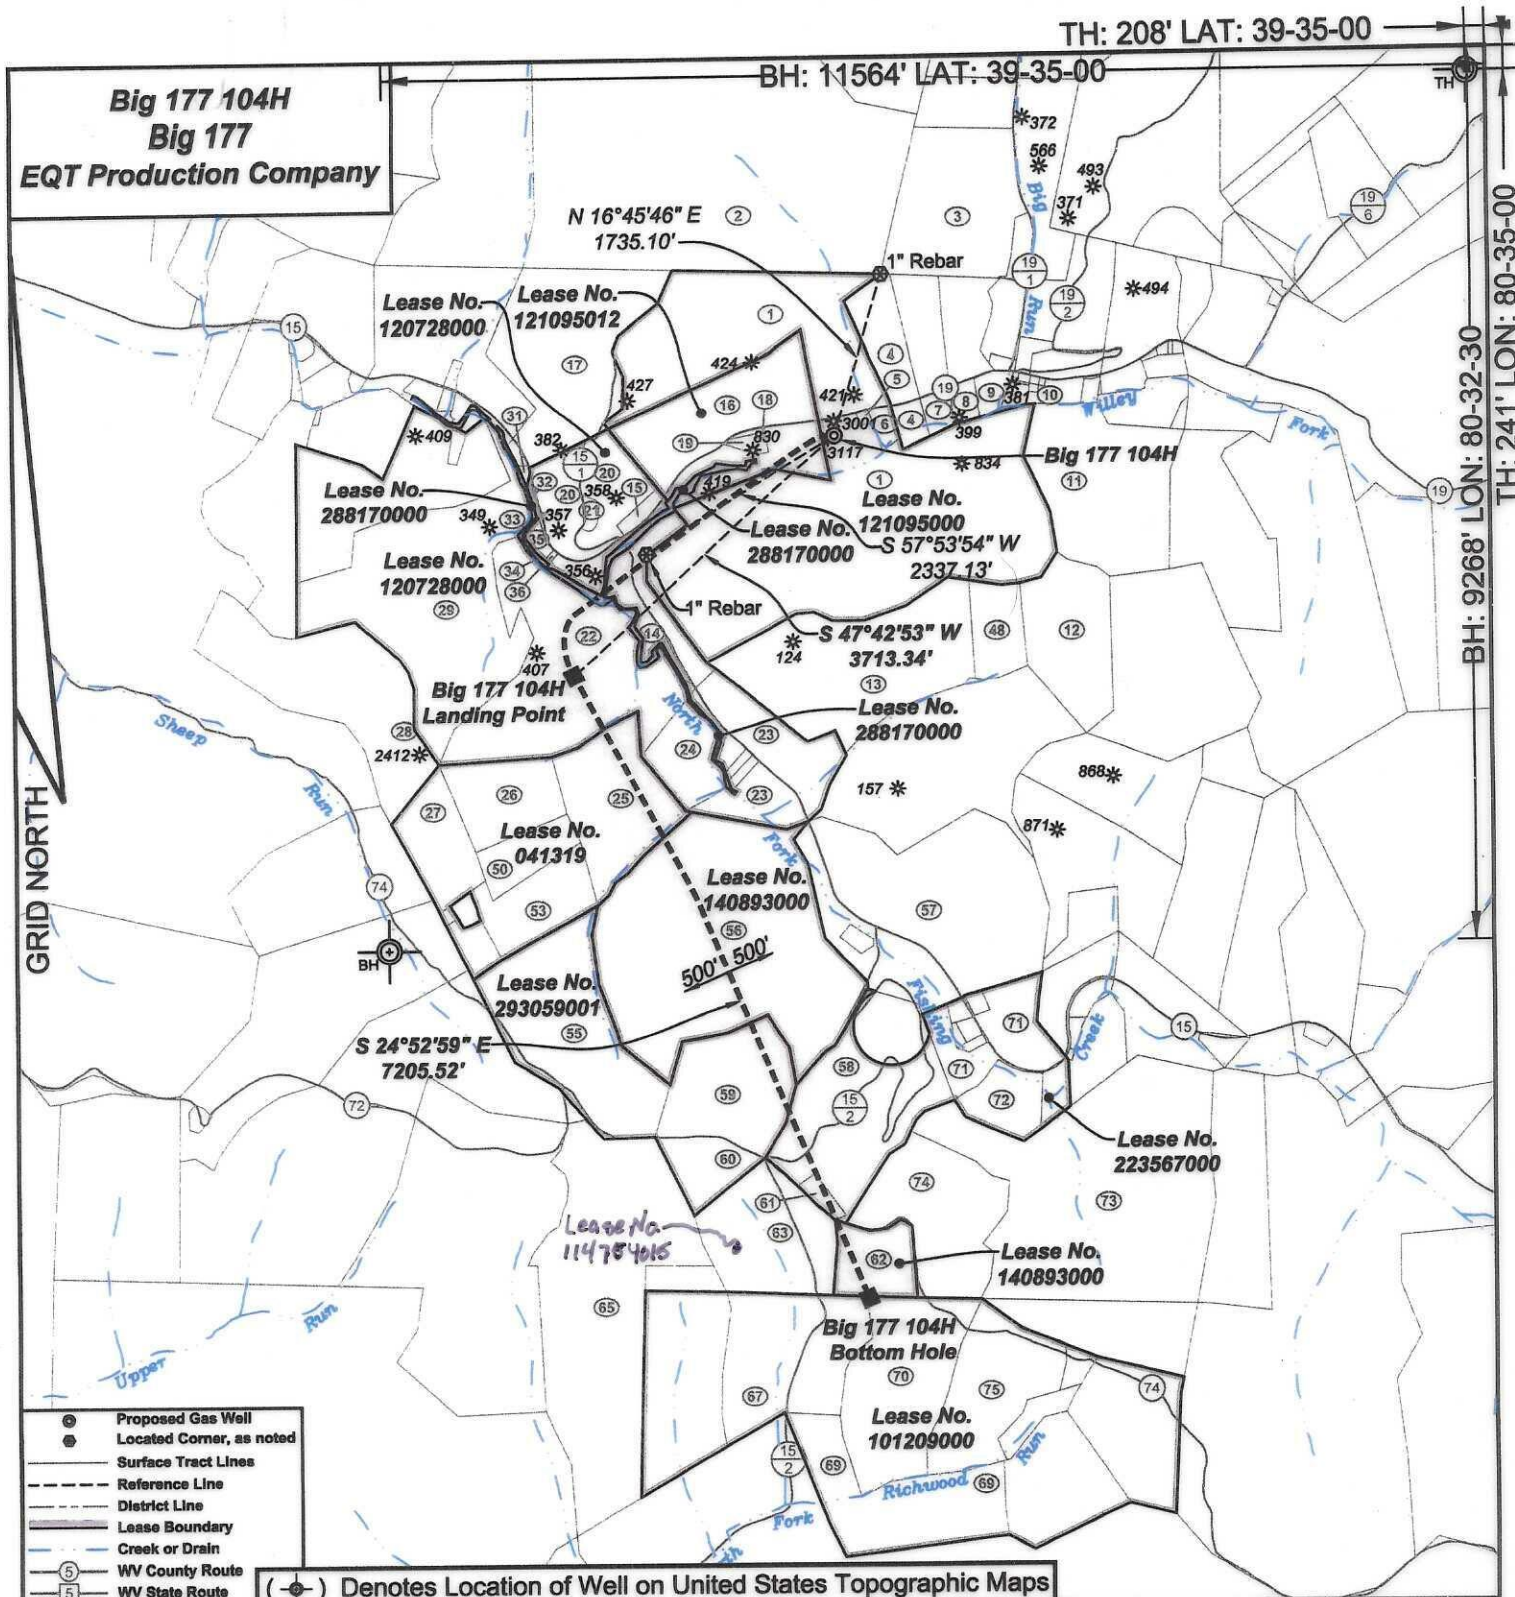

I, the undersigned, hereby certify that this plat is correct to the best of my knowledge and belief and shows all the information required by law and the regulations issued and prescribed by the Department of Environmental Protection.

P.S. 2092

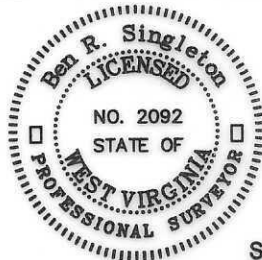

SEAL

FILE NO: 352-23

DRAWING NO: Big 177 104H

SCALE: 1" = 1000'

MINIMUM DEGREE OF ACCURACY:
1:2500

PROVEN SOURCE OF ELEVATION:
NGS CORS Station

STATE OF WEST VIRGINIA
DEPARTMENT OF ENVIRONMENTAL PROTECTION
OIL AND GAS DIVISION

DATE: October 10 20 25

OPERATOR'S WELL NO.: Big 177 104H

API WELL NO

47 - 103 - 03725
STATE COUNTY PERMIT

WELL TYPE: ☐ OIL ☒ GAS ☐ LIQUID INJECTION ☐ WASTE DISPOSAL
(IF GAS) PRODUCTION: ☐ STORAGE ☐ DEEP ☒ SHALLOW

LOCATION: ELEVATION: 810.5' WATERSHED Willey Fork of North Fork Fishing Creek QUADRANGLE: Big Run

DISTRICT: Grant COUNTY: Wetzel

SURFACE OWNER: Coastal Forest Resources Company

ACREAGE: 217.19

ROYALTY OWNER: Coastal Forest Resources Company, et al.

LEASE NO: 121095000

ACREAGE: 300

PROPOSED WORK: ☒ DRILL ☐ CONVERT ☐ DRILL DEEPER ☒ FRACTURE OR STIMULATE ☐ PLUG OFF OLD FORMATION
☐ PERFORATE NEW FORMATION ☐ OTHER PHYSICAL CHANGE IN WELL (SPECIFY) _____

☐ PLUG AND ABANDON ☐ CLEAN OUT AND REPLUG TARGET FORMATION: Marcellus ESTIMATED DEPTH: 6849'

WELL OPERATOR: EQT Production Company

DESIGNATED AGENT: Joseph C. Mallow

ADDRESS: 2200 Energy Drive


ADDRESS: 427 Midstate Drive

Canonsburg, PA 15317


Clarksburg, WV 26301

Big 177 104H
Big 177
EQT Production Company

Tract I.D.	TaxMap No.	Parcel No.	County	District	Surface Tract Owner	Acres
1	13	6	Wetzel	Grant	Coastal Forest Resources Company	217.19
2	8	18	Wetzel	Grant	Coastal Forest Resources Company	337
3	8	23.2	Wetzel	Grant	James L. Dulaney	43.19
4	8	35	Wetzel	Grant	John D. Parks	15.5
5	8	66	Wetzel	Grant	EQM Gathering OPCCO LLC	0.418
6	8	65	Wetzel	Grant	Ikey Joe & Tina M. Willey	2.15
7	8	36	Wetzel	Grant	James L. & Karen Dulaney	14.1
8	8	37	Wetzel	Grant	James L. & Karen Dulaney	14.1
9	8	43	Wetzel	Grant	Judy K. Utt	3.25
10	8	45	Wetzel	Grant	Dale K. Dulaney	9.828
11	13	7	Wetzel	Grant	Mansel Lee McDiffitt, et al.	51.8
12	13	15	Wetzel	Grant	Robert Scott & Alfred Bryan Cole	27.75
13	13	13	Wetzel	Grant	Linda L. Dunn	67.5
14	13	12	Wetzel	Grant	Leslie Lydick & Susan Miracle	15.02
15	13	4.3	Wetzel	Grant	Jeffrey L. & Beth Willey	3.35
16	13	6.1	Wetzel	Grant	Coastal Forest Resources Company	55.06
17	8	34	Wetzel	Grant	Hallie M. & Paul E. Hardbarger	54.01
18	8	58	Wetzel	Grant	Higgins Chapel Church of Christ	0.99
19	8	64	Wetzel	Grant	Mary S. & James Eastham	1.45
20	13	4	Wetzel	Grant	Jeffrey L. & Beth Willey	26.8
21	13	5	Wetzel	Grant	Kingtown Cemetery	1.1
22	13	11	Wetzel	Grant	John R. & Johnna E. Harter	74.771
23	13	23	Wetzel	Grant	Kenneth L. & Nadine R. Oden	26.51
24	13	23.2	Wetzel	Grant	Jennifer L. Archer, et al.	14.54
25	13	22	Wetzel	Grant	John R. & Johnna E. Harter	30
26	13	20	Wetzel	Grant	John R. & Johnna E. Harter	18.25
27	13	19	Wetzel	Grant	Larry D. & Mary A. Huggins	19.25
28	12	22	Wetzel	Grant	Oden Holdings LLC	51.6
29	12	12	Wetzel	Grant	Dallison Lumber Inc.	84
31	8	67	Wetzel	Grant	Edgar S. & Sheena M. Shrum	0.53
32	13	4.2	Wetzel	Grant	Dallison Lumber Inc.	0.6
33	13	54	Wetzel	Grant	Lowman Baptist Church	0.222
34	13	55	Wetzel	Grant	Lowman Baptist Church	0.229
35	13	1	Wetzel	Grant	Lowman Baptist Church	1.5
36	13	3	Wetzel	Grant	Lowman Baptist Church	0.38
48	13	14	Wetzel	Grant	Linda L. Dunn	12.5
50	13	21	Wetzel	Grant	John & Johnna Shay Harter	12
53	13	29	Wetzel	Grant	Kenneth D. Eford	17.5
55	13	36	Wetzel	Grant	Sara P. Miller, et al.	49
56	13	30	Wetzel	Grant	Coastal Forest Resources Company	113.8
57	13	31	Wetzel	Grant	Annette M. Riley	98.7
58	13	38	Wetzel	Grant	Coastal Forest Resources Company	58
59	13	37.1	Wetzel	Grant	Alice D. Hayhurst	30
60	13	37	Wetzel	Grant	Gary White, et al.	16
61	13	38.1	Wetzel	Grant	Angela N. & Christopher Thomas	2
62	18	4	Wetzel	Grant	Dallison Lumber Inc.	13.5
63	18	3	Wetzel	Grant	Gary White, et al.	32.25
65	18	1	Wetzel	Grant	McKinley E. Calvert Heirs	100
67	18	7	Wetzel	Grant	William R. & Joey J. Work	46.47
69	18	18	Wetzel	Grant	Betty Hostutler, et al.	43.4
70	18	8	Wetzel	Grant	Marybeth & Terry L. Henthorn	39.4
71	13	52	Wetzel	Grant	Carl L. & Patsy R. Barr	22.598
72	13	52.6	Wetzel	Grant	Jerry White, et al.	11.42
73	13	48	Wetzel	Grant	Coastal Forest Resources Company	155.8
74	18	5	Wetzel	Grant	Theodore McCoy, et al.	39
75	18	9	Wetzel	Grant	Linda B. Blaw	38.6

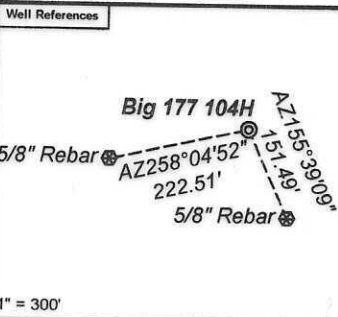

Notes:
Big 177 104H coordinates are
NAD 27 N: 396,146.35 E: 1,694,406.76
NAD 27 Lat: 39.582589 Long: -80.584259
NAD 83 UTM N: 4,381,522.18 E: 535,718.76
Big 177 104H Landing Point coordinates are
NAD 27 N: 393,648.02 E: 1,691,659.78
NAD 27 Lat: 39.575639 Long: -80.593896
NAD 83 UTM N: 4,380,747.04 E: 534,894.52
Big 177 104H Bottom Hole coordinates are
NAD 27 N: 387,111.35 E: 1,694,691.84
NAD 27 Lat: 39.557795 Long: -80.582861
NAD 83 UTM N: 4,378,771.01 E: 535,851.45
West Virginia Coordinate system of 1927 (North Zone)
based upon Differential GPS Measurements.
Plat orientation, corner and well ties are based upon
the grid north meridian.
Well location references are based upon the grid north
meridian.
UTM coordinates are NAD83, Zone 17, Meters.

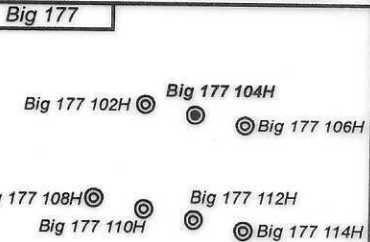

Lease No.	Owner	Acres
121095000	Coastal Forest Resources Company, et al.	300
121095012	Coastal Forest Resources Company, et al.	57.5
120728000	EQT Production Company, et al.	450
288170000	State of West Virginia, Department of Commerce, Division of Natural Resources	4,7938 & 3.1172
041319	CNX Gas Company, LLC., et al.	107
140893000	Stone Hill Minerals Holdings, LLC, et al.	113.80 of 1,588.27
293059001	Stone Hill Minerals Holdings, LLC, et al.	95 of 225.57
223567000	Shiben Estates, Inc.	100
140893000	Stone Hill Minerals Holdings, LLC, et al.	13.5 of 1,588.27
101209000	Shiben Estates, Inc.	297.50

