



4710303741

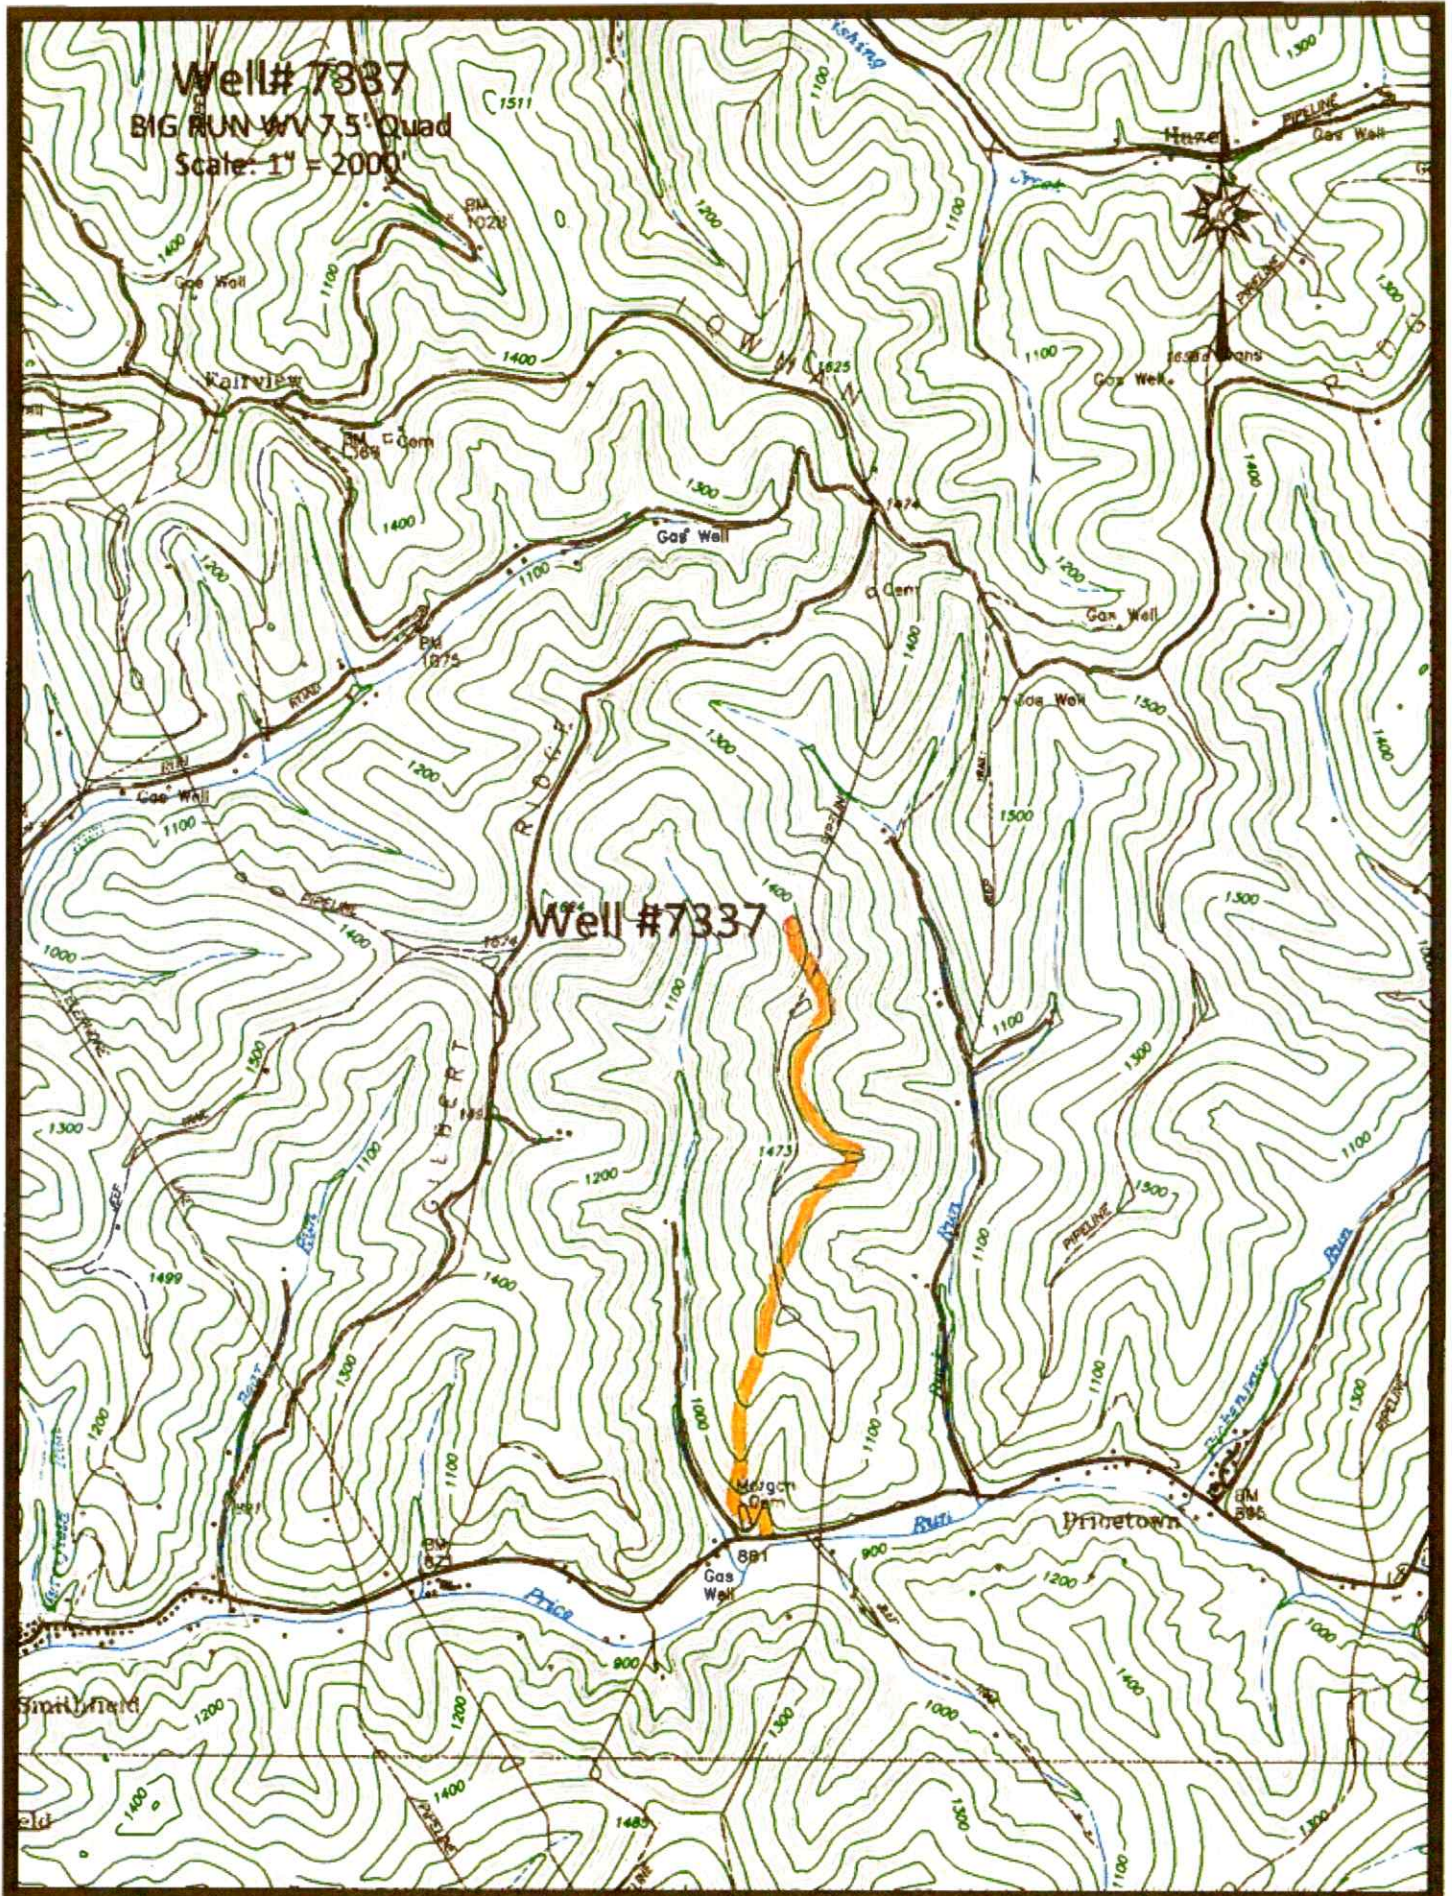

Access Road

07/11/2025

4710303741

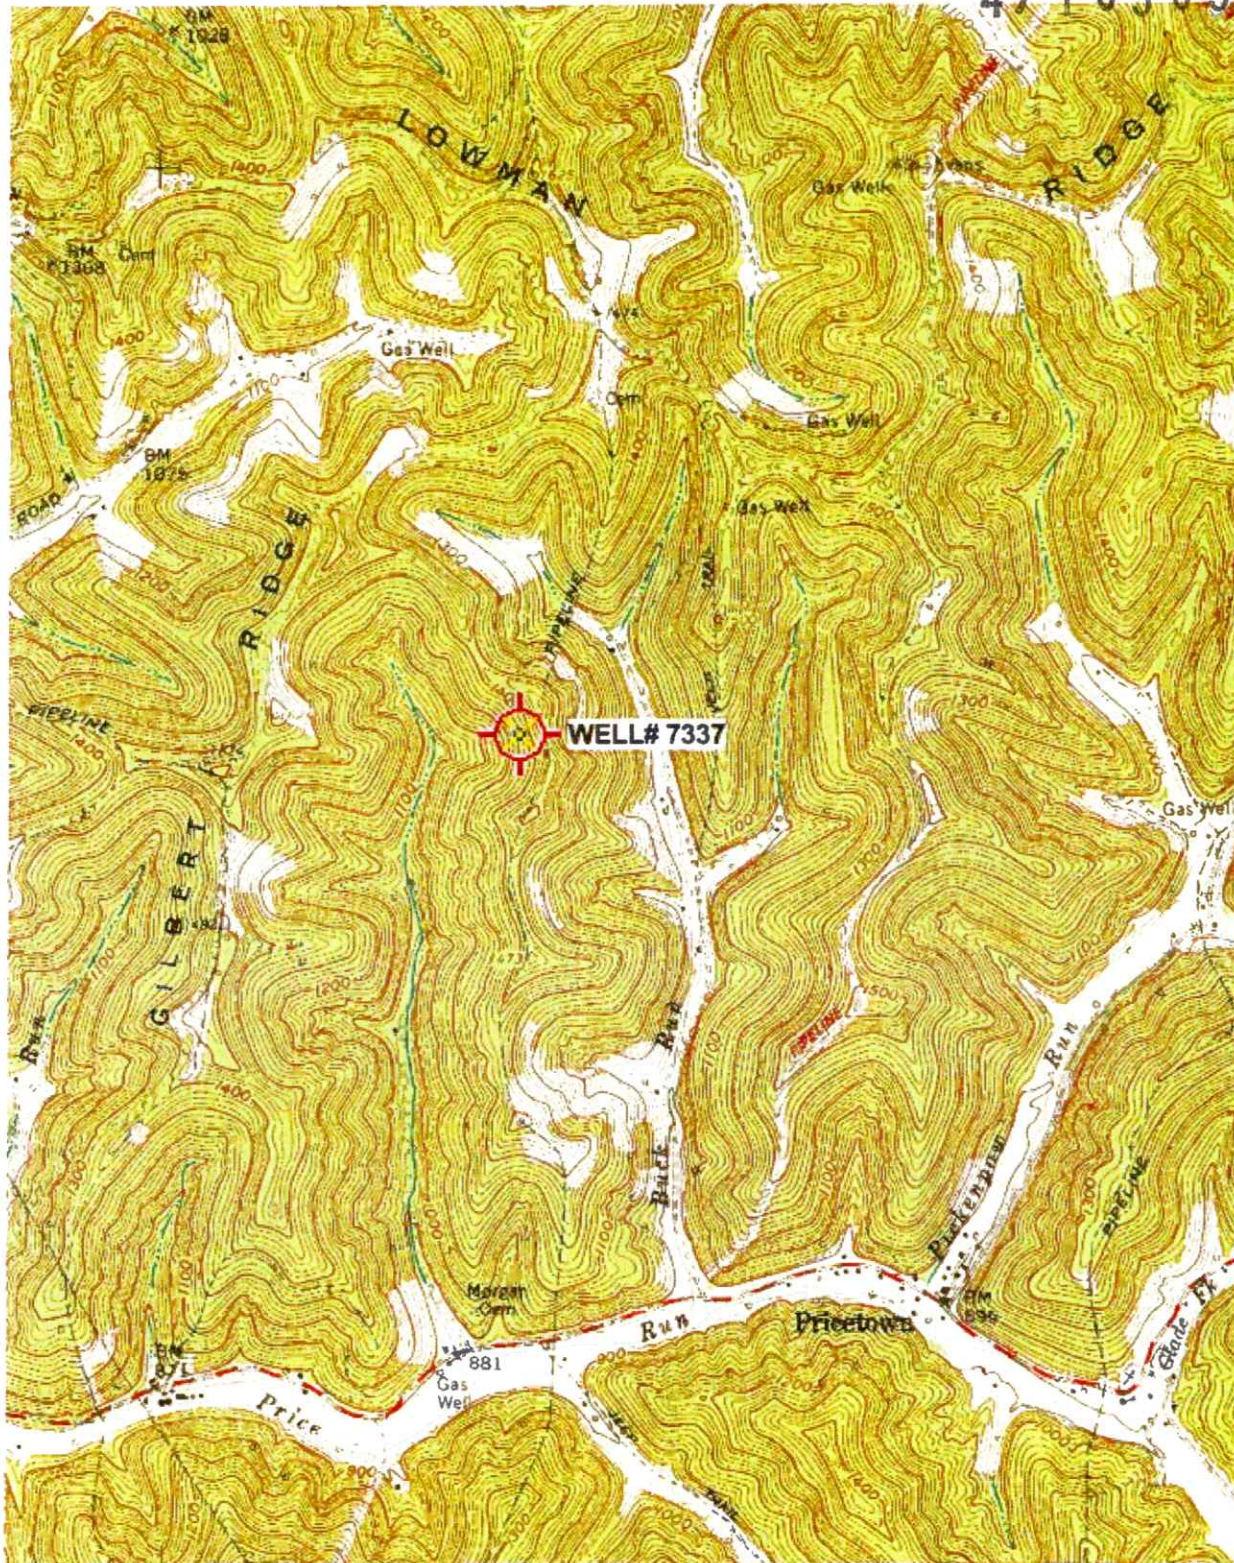

RECEIVED
Office of Oil and Gas

JUN 23 2025

39°30'
80°30'W Department of
Environmental Protection

WALLACE
4822 N NW

1 MILE
500 FEET
1:62,500

ROAD CLASSIFICATION

Heavy-duty ——— Light-duty ———
Medium-duty ——— Unimproved dirt ———
State Route



QUADRANGLE LOCATION

BIG RUN, W. VA.

SE 1/4 LITTLETON 15' QUADRANGLE
N3930—W8030/7.5

Revisions shown in purple compiled in cooperation with
'Big Run, WV' Scale: 1" = 0.379Mi 610M 2,000Ft, 1 Mi = 2.640", 1 cm = 240M

1960

07/11/2025

Well# 7337
BIG RUN WV 7.5' Quad



PIPELINE

Well# 7337

RECEIVED
Office of Oil and Gas
JUN 23 2025
WV Department of
Environmental Protection

1473

1200

Allegany Road

07/11/2025

4710303741

WW-7
8-30-06

West Virginia Department of Environmental Protection
Office of Oil and Gas

WELL LOCATION FORM: GPS

API: 47-103-72342 WELL NO.: 7337
 FARM NAME: B W PETERSON 78
 RESPONSIBLE PARTY NAME: WEST VIRGINIA LAND RESOURCES INC.
 COUNTY: WETZEL DISTRICT: GRANT
 QUADRANGLE: BIG RUN WV
 SURFACE OWNER: DALLISON LUMBER INC
 ROYALTY OWNER: _____
 UTM GPS NORTHING: 4,375,124 m
 UTM GPS EASTING: 540,598 m GPS ELEVATION: 416 m

The Responsible Party named above has chosen to submit GPS coordinates in lieu of preparing a new well location plat for a plugging permit or assigned API number on the above well. The Office of Oil and Gas will not accept GPS coordinates that do not meet the following requirements:

1. Datum: NAD 1983, Zone: 17 North, Coordinate Units: meters, Altitude: height above mean sea level (MSL) – meters.
2. Accuracy to Datum 3.05 meters
3. Data Collection Method:

Survey grade GPS X : Post Processed Differential X

Real-Time Differential _____

Mapping Grade GPS _____ : Post Processed Differential _____

Real-Time Differential _____

4. Letter size copy of the topography map showing the well location.

I the undersigned, hereby certify this data is correct to the best of my knowledge and belief and shows all the information required by law and the regulations issued and prescribed by the Office of Oil and Gas.

Signature

PS 2002

Title

MAY 30, 2025

Date

RECEIVED
Office of Oil and Gas

JUN 23 2025

WV Department of
Environmental Protection

07/11/2025