

4710303743

WELL# 7407
BIG RUN WV 7.5' Quad
Scale: 1" = 500'

Gas Well

1500



TRAIL;

1500

PIPELINE

WELL# 7407

1100

RECEIVED
Office of Oil and Gas

JUN 23 2025


WV Department of
Environmental Protection

1300

Access Road

07/11/2025

4710303743

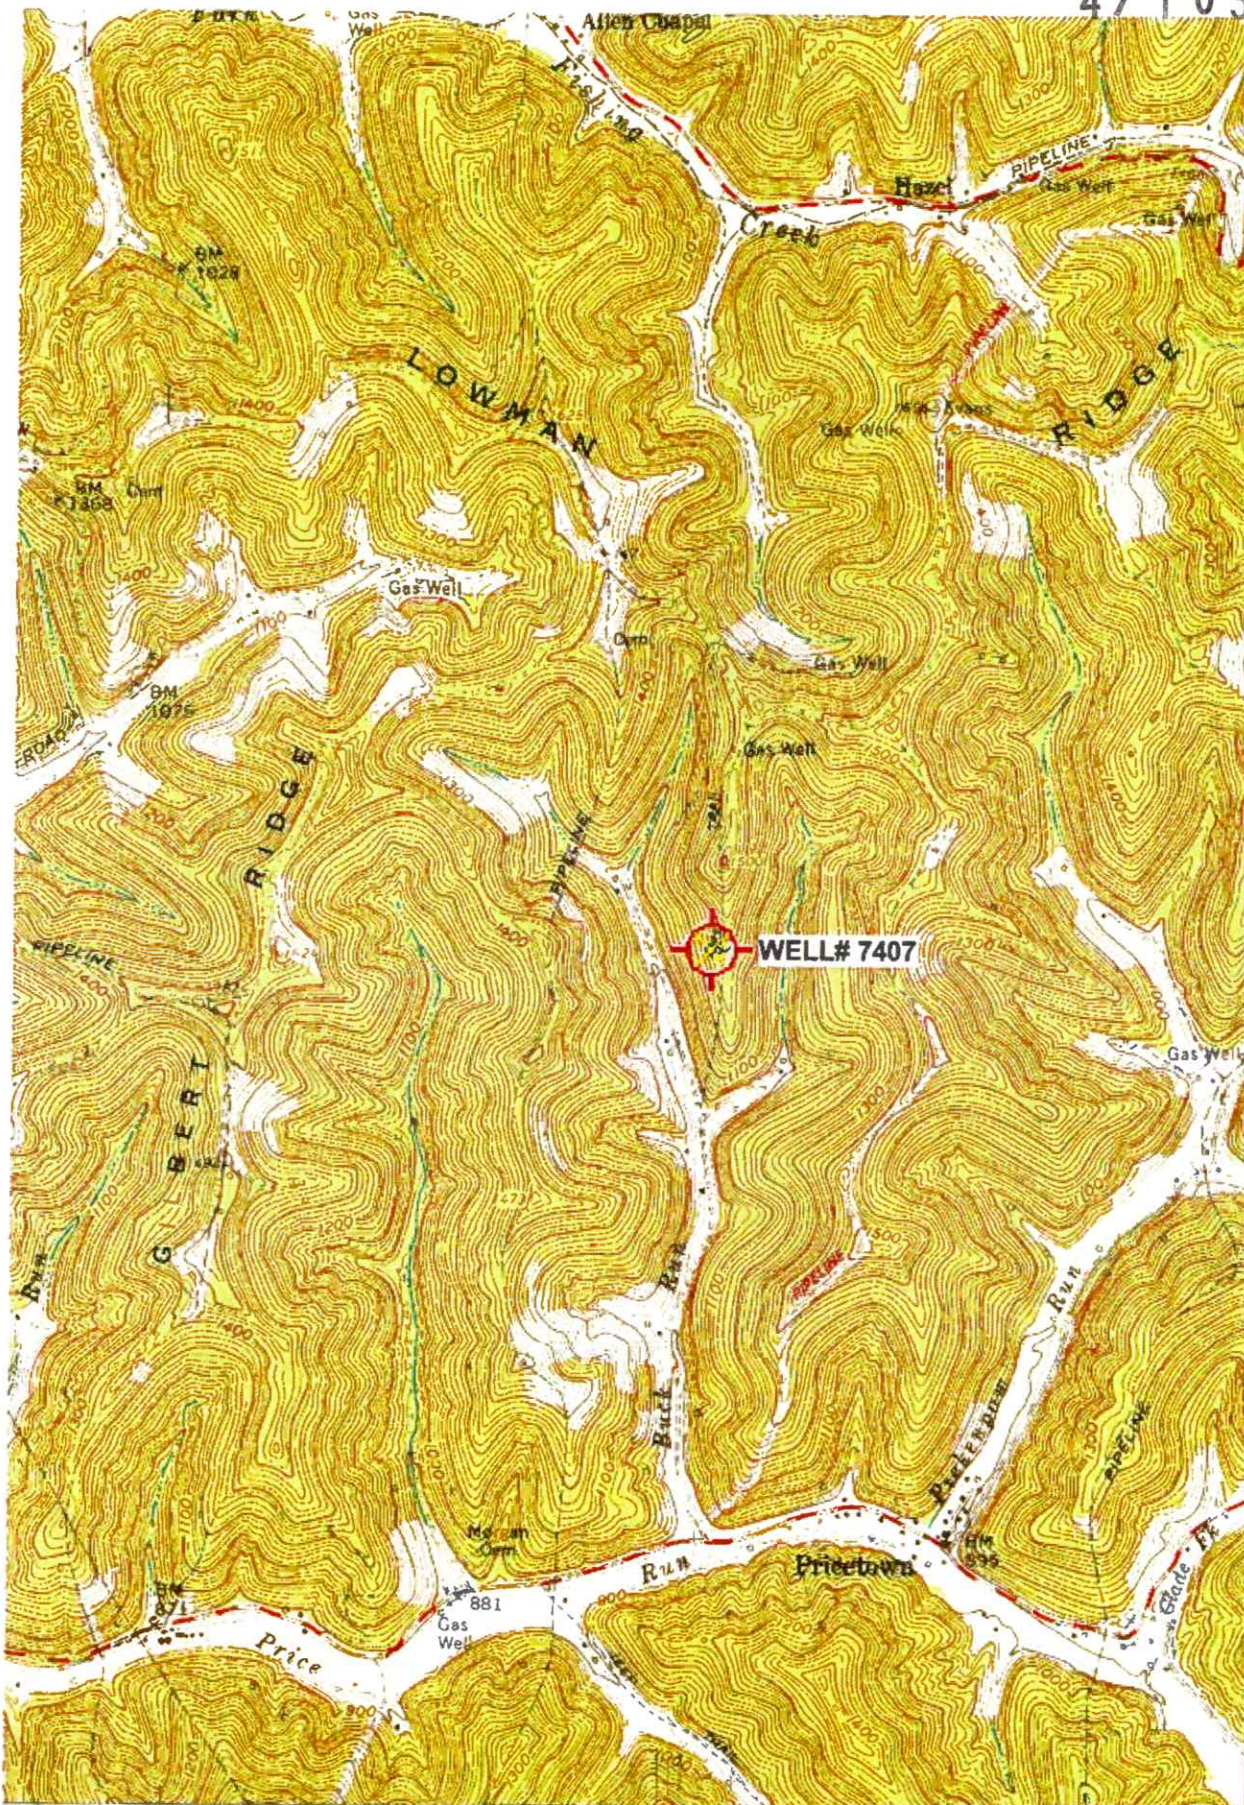

4278
4277
32'30"
4276
4275
4274

RECEIVED
Office of Oil and Gas
JUN 23 2025
WV Department of
Environmental Protection

4273

39 32'30" 540 541 80°30' 39°30'

1 MILE
500 FT

ROAD CLASSIFICATION

Heavy-duty

Light-duty

Unimproved dirt

'Big Run; WV Scale: 1" = 0.379Mi 610Mt 2,000Ft, 1 Mi = 2.640", 1 cm = 240Mm-m-duly

07/11/2025

(WALLACE)
4962 N.W.

47 1 0 3 0 3 7 4 3

WW-7
8-30-06

West Virginia Department of Environmental Protection
Office of Oil and Gas

WELL LOCATION FORM: GPS

API: 47-103-72312 WELL NO.: 7407
 FARM NAME: ENSMINGER 5
 RESPONSIBLE PARTY NAME: WEST VIRGINIA LAND RESOURCES INC.
 COUNTY: WETZEL DISTRICT: GRANT
 QUADRANGLE: BIG RUN WV
 SURFACE OWNER: JOAN GROTTENDICK
 ROYALTY OWNER: _____
 UTM GPS NORTHING: 4,375,198 m
 UTM GPS EASTING: 541,198 m GPS ELEVATION: 385 m

The Responsible Party named above has chosen to submit GPS coordinates in lieu of preparing a new well location plat for a plugging permit or assigned API number on the above well. The Office of Oil and Gas will not accept GPS coordinates that do not meet the following requirements:

1. Datum: NAD 1983, Zone: 17 North, Coordinate Units: meters, Altitude: height above mean sea level (MSL) – meters.
2. Accuracy to Datum – 3.05 meters
3. Data Collection Method:

Survey grade GPS x : Post Processed Differential X

Real-Time Differential _____

Mapping Grade GPS _____ : Post Processed Differential _____

Real-Time Differential _____

4. Letter size copy of the topography map showing the well location.

I the undersigned, hereby certify this data is correct to the best of my knowledge and belief and shows all the information required by law and the regulations issued and prescribed by the Office of Oil and Gas.

Signature

PS 2002

Title

MAY 29, 2025

Date

RECEIVED
Office of Oil and Gas

JUN 23 2025

WV Department of
Environmental Protection

07/11/2025