


4710303800

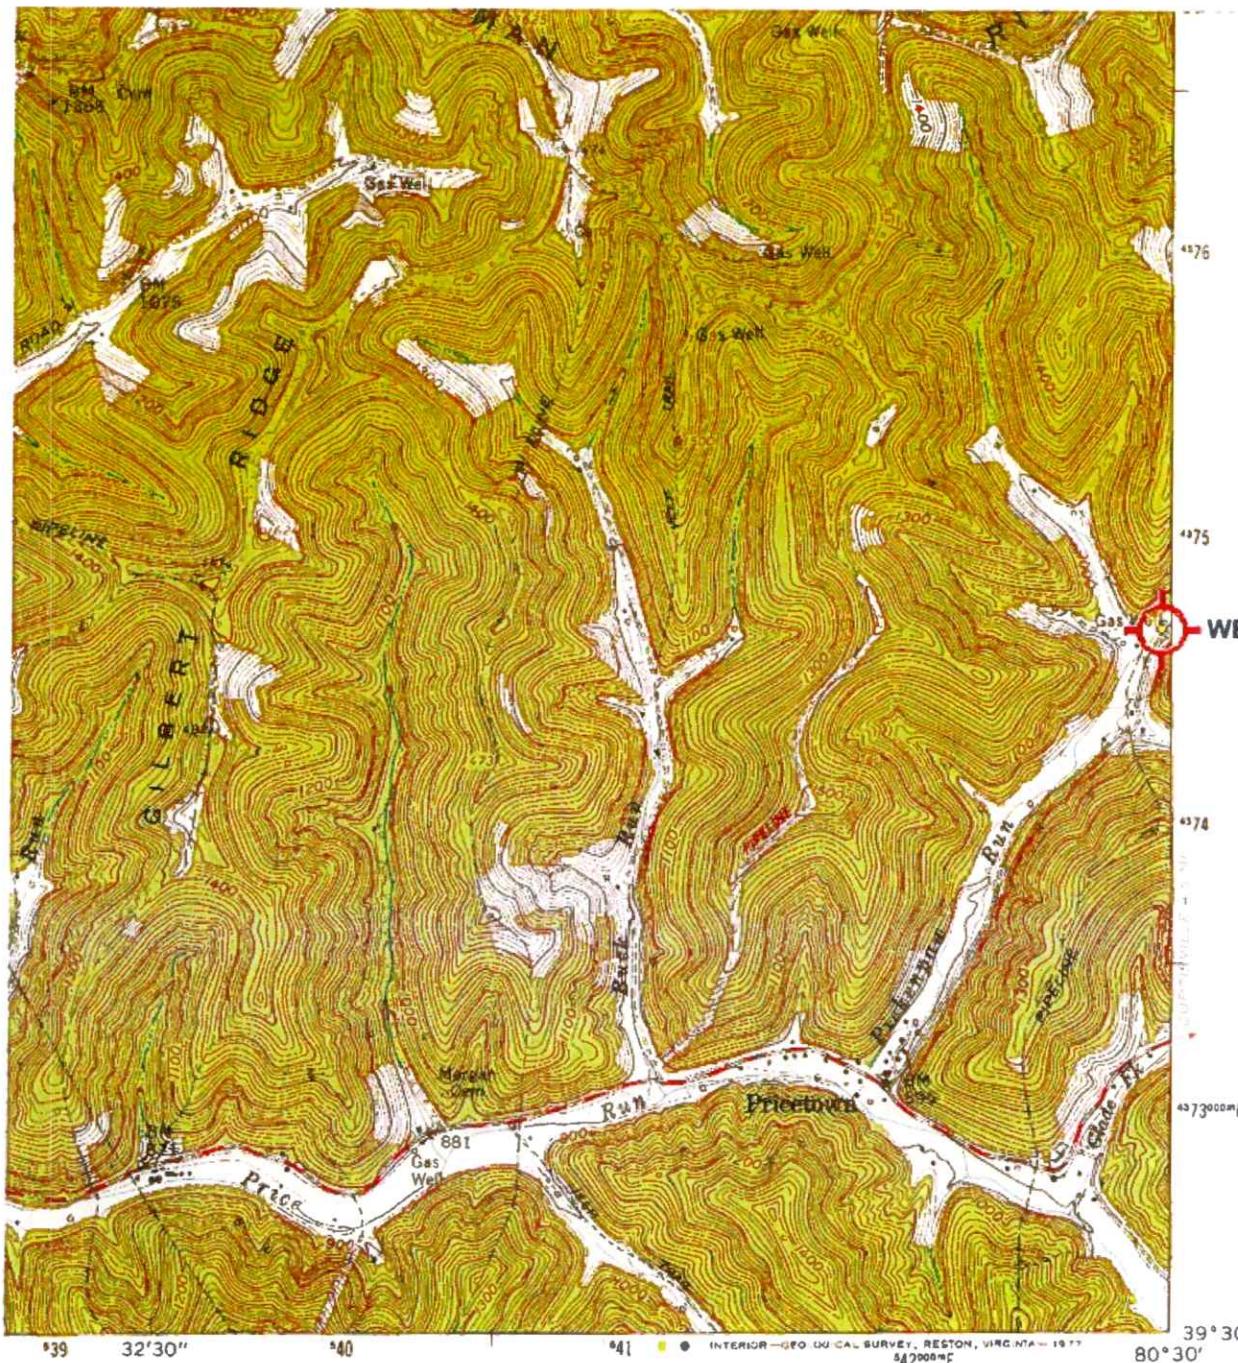

1 MILE  
3 FEET

ER



QUADRANGLE LOCATION

EST

Revisions shown in purple compiled in cooperation with  
State of West Virginia agencies from aerial photographs  
taken 1976. This information not field checked.

ROAD CLASSIFICATION

Heavy-duty

— (solid red) Light-duty

Medium-duty

— (solid black) Unimproved dirt

— (dashed black)

State Route

BIG RUN, W. VA.

SF/4 LITTLETON 15' QUADRANGLE  
N3930—W8030/7.5

1960

PHOTOREVISED 1976

AMS 4863 II SE—SERIES V854

RECEIVED  
Office of Oil and Gas


DEC 19 2025

'Big Run; WV' Scale: 1" = 0.379Mi 610Mt 2,000Ft, 1 Mi = 2.640", 1 cm = 240Mt

WV Department of  
Environmental Protection

01/23/2026


4710303800

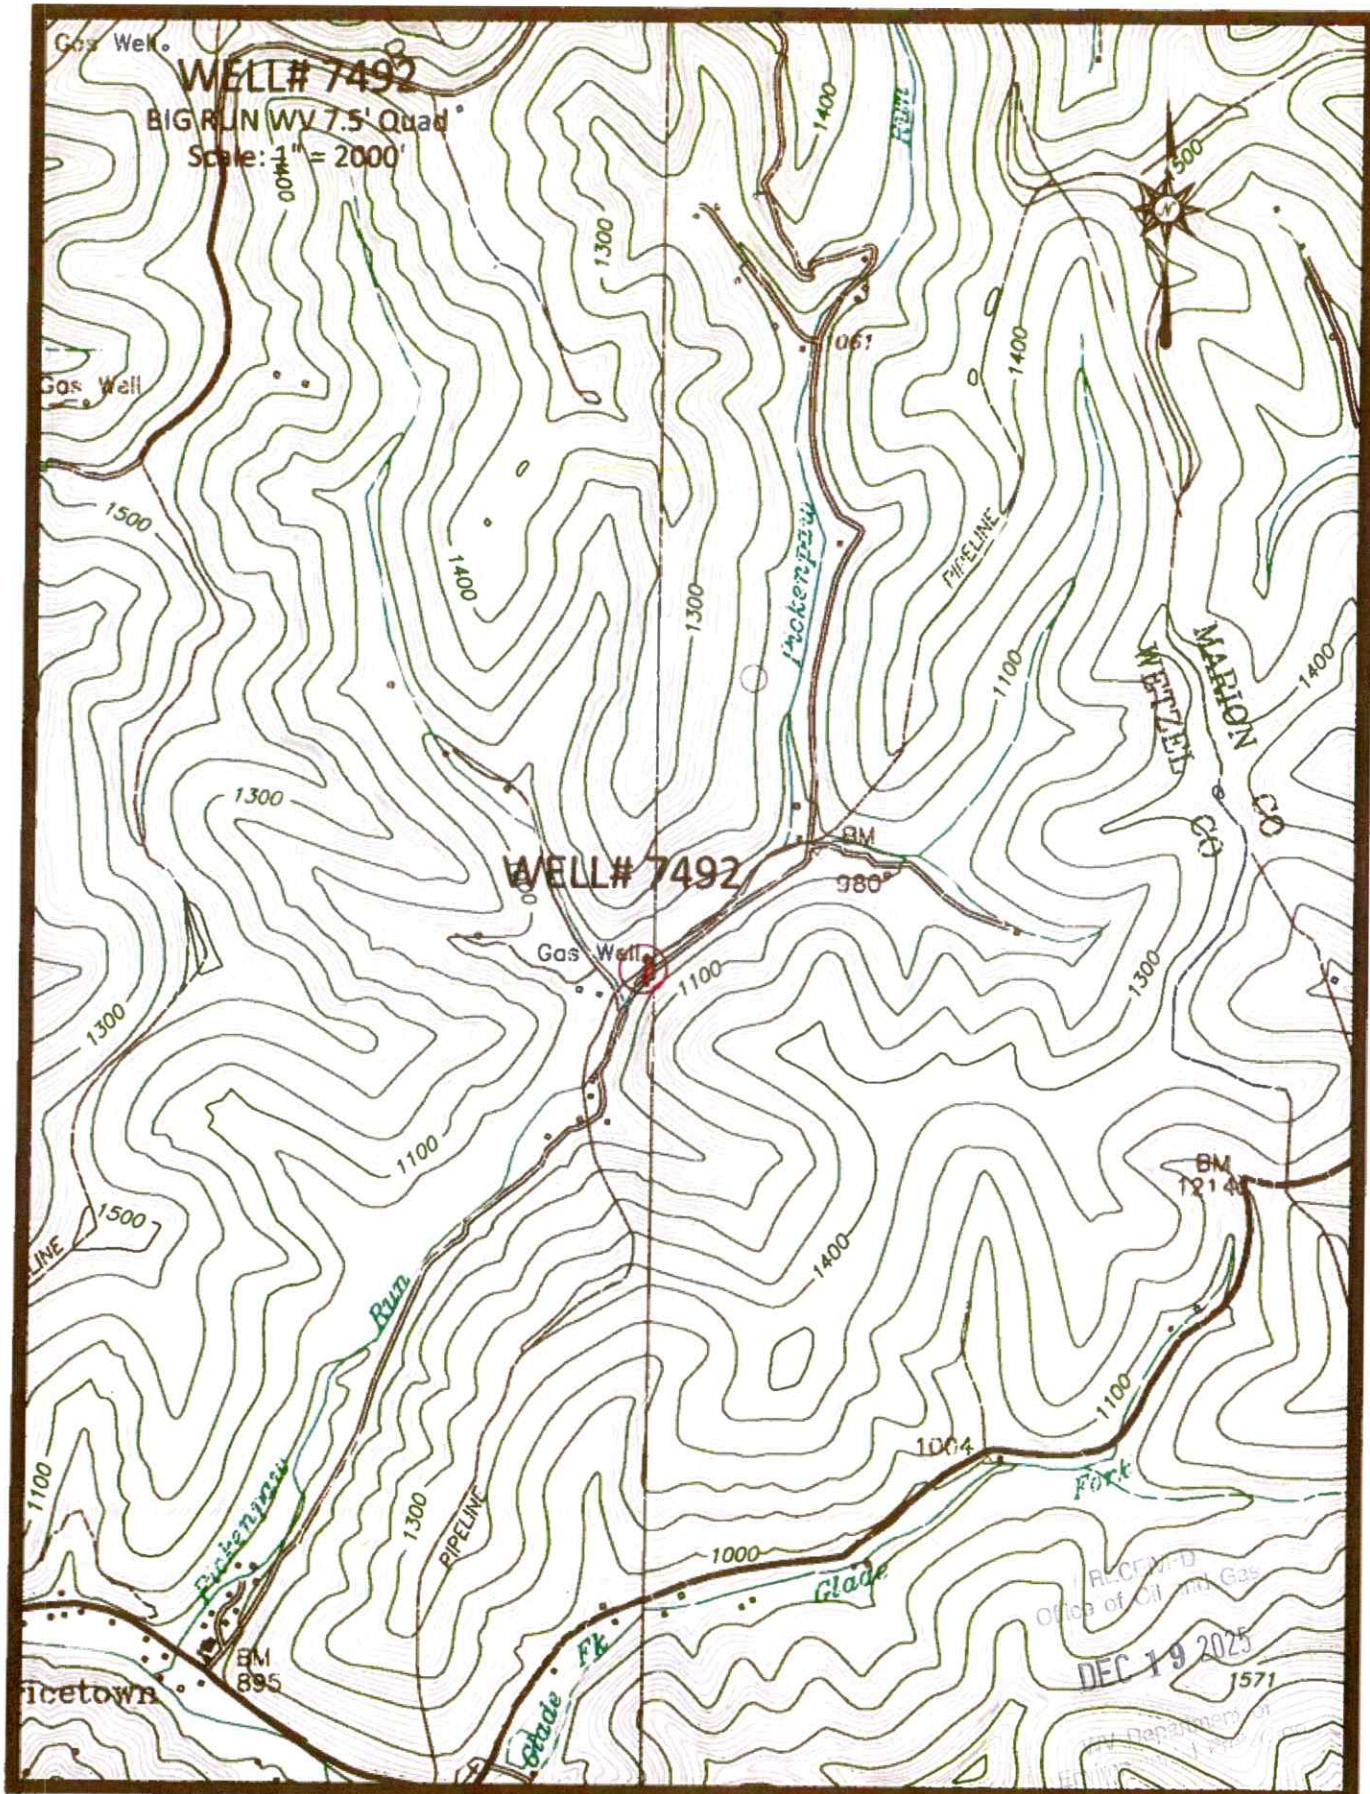

Access Road

01/23/2026

4710303800

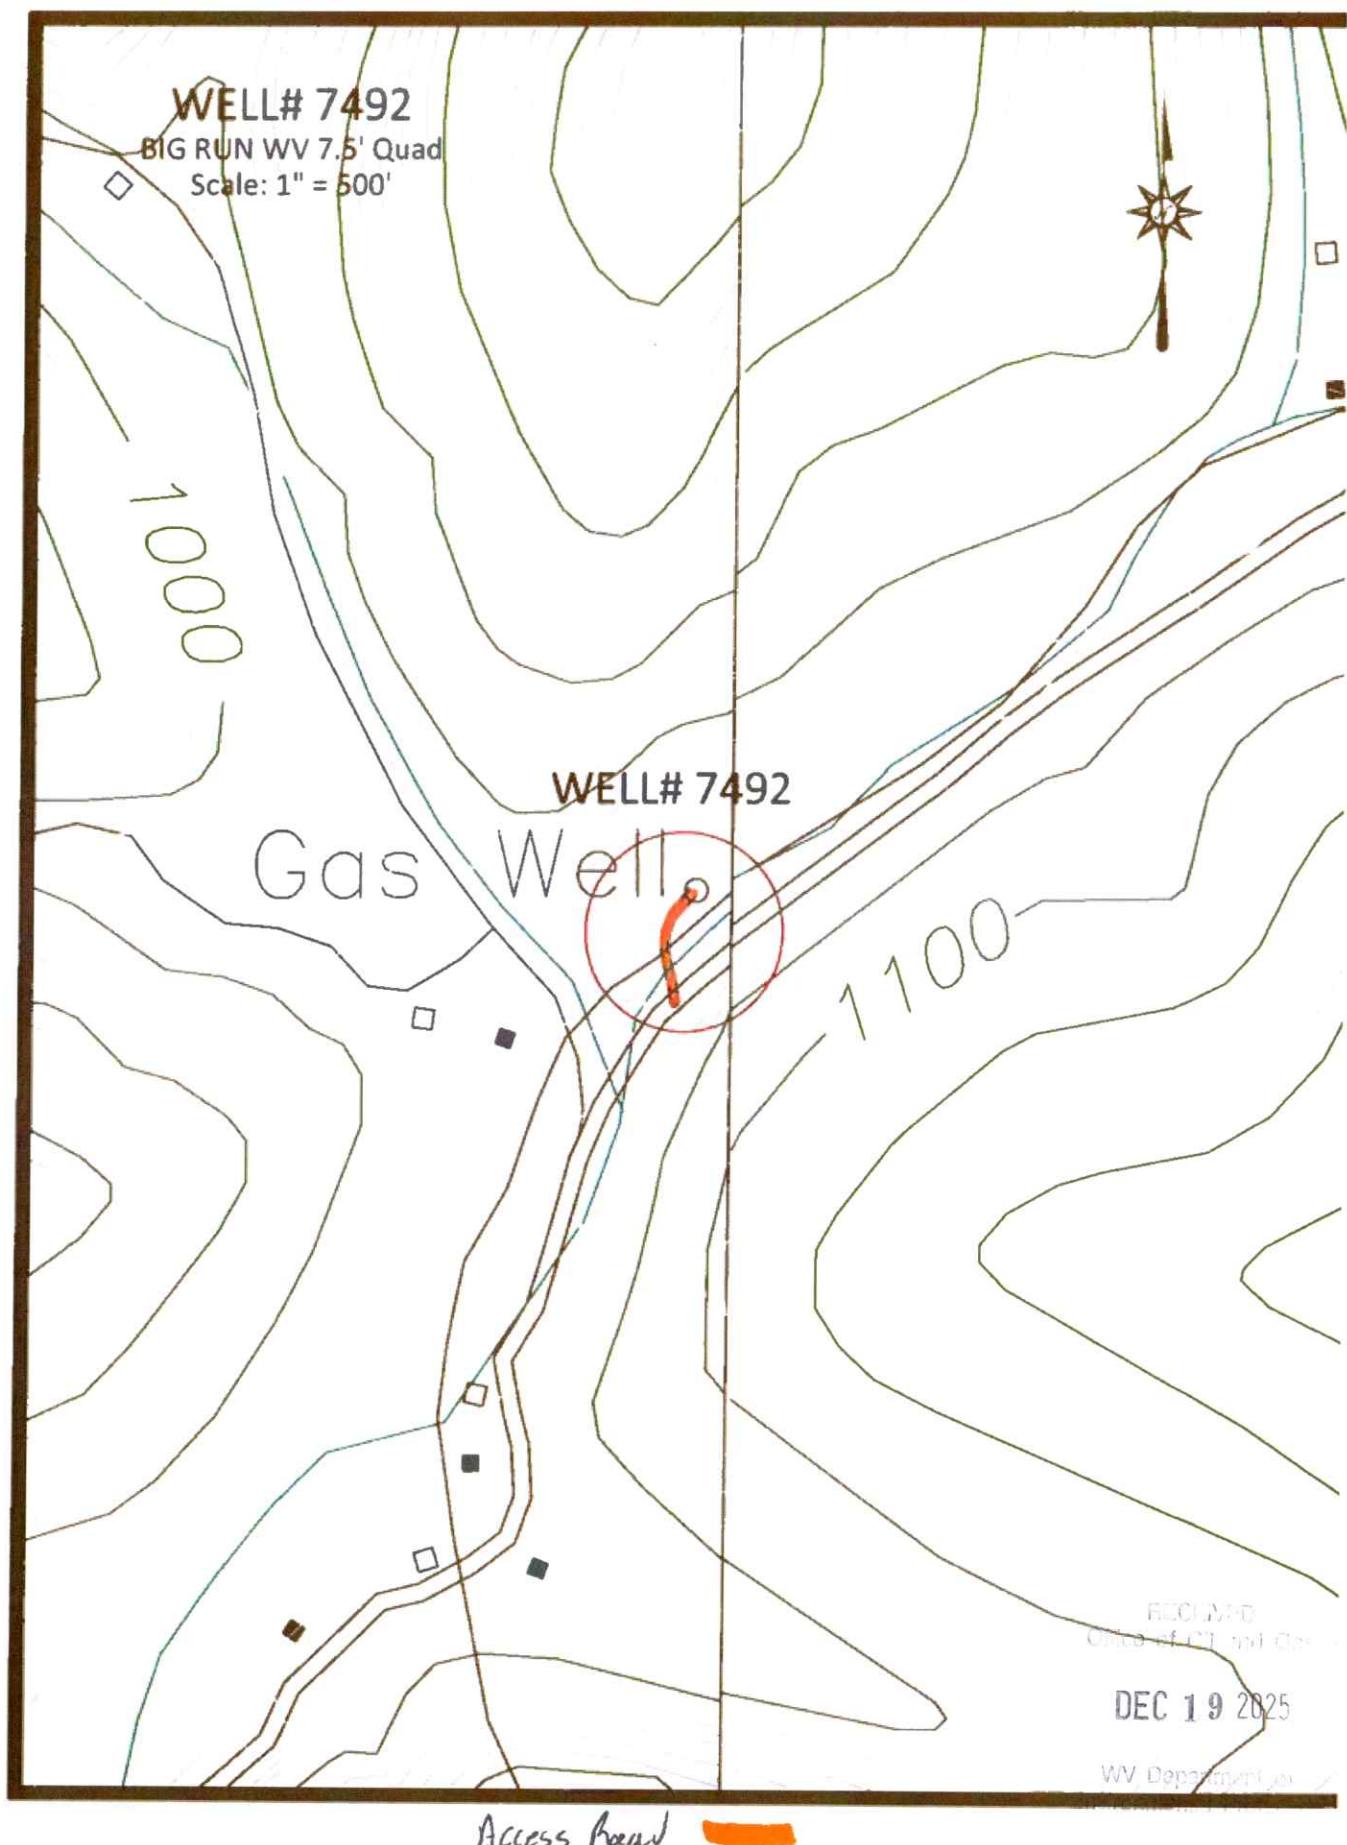

4710303800

WW-7  
8-30-06



West Virginia Department of Environmental Protection  
Office of Oil and Gas  
**WELL LOCATION FORM: GPS**

API: 47-103-30138 WELL NO.: 7492

FARM NAME: JD SNODGRASS #1

RESPONSIBLE PARTY NAME: WEST VIRGINIA LAND RESOURCES INC.

COUNTY: WETZEL DISTRICT: GRANT

QUADRANGLE: BIG RUN WV

SURFACE OWNER: JANET HILLBERRY

ROYALTY OWNER: \_\_\_\_\_

UTM GPS NORTHING: 4,374,846 m

UTM GPS EASTING: 542,960 m GPS ELEVATION: 290 m

The Responsible Party named above has chosen to submit GPS coordinates in lieu of preparing a new well location plat for a plugging permit or assigned API number on the above well. The Office of Oil and Gas will not accept GPS coordinates that do not meet the following requirements:

1. Datum: NAD 1983, Zone: 17 North, Coordinate Units: meters, Altitude: height above mean sea level (MSL) – meters.

2. Accuracy to Datum – 3.05 meters

3. Data Collection Method:

Survey grade GPS x: Post Processed Differential   X  

Real-Time Differential \_\_\_\_\_

Mapping Grade GPS \_\_\_\_\_: Post Processed Differential \_\_\_\_\_

Real-Time Differential \_\_\_\_\_

RECEIVED  
Office of Oil and Gas

DEC 19 2025

WV Department of  
Environmental Protection

4. Letter size copy of the topography map showing the well location.

I the undersigned, hereby certify this data is correct to the best of my knowledge and belief and shows all the information required by law and the regulations issued and prescribed by the Office of Oil and Gas.

Signature

PS 2002

Title

DECEMBER 2, 2025

Date

01/23/2026