

Well# 7390


BIG RUN WV 7.5' Quad

Scale: 1" = 500'

500



Well# 7390

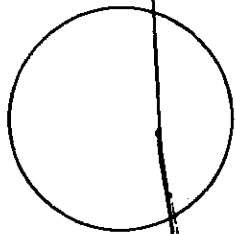

00

RECEIVED
JAN 23 2026
WV Department of Environmental Protection

1300

03/06/2026

Well# 7390

BIG RUN WY 7.5' Quad
Scale: 1" = 2000'

Gas Well

Gas Well

Well #7390



TRAIL

DEEP

Run

PIPELINE

Run

RECEIVED
Office of Oil and Gas
JAN 23 2023
WV Department of
Environmental Protection

03/06/2026

Arrows Road

303814



476

4730000M

539

40

41

10




B

SF/4

ELL

with
nh.

AMS 4

03/06/2026



West Virginia Department of Environmental Protection
Office of Oil and Gas

WELL LOCATION FORM: GPS


FARM NAME: JW NORRIS #3

RESPONSIBLE PARTY NAME: WEST VIRGINIA LAND RESOURCES INC.

COUNTY: WETZEL DISTRICT: GRANT

QUADRANGLE: BIG RUN WV

SURFACE OWNER: TALL TIMBER INC

ROYALTY OWNER: _____

UTM GPS NORTHING: 4,375,092 m

UTM GPS EASTING: 541,654 m GPS ELEVATION: 401 m

The Responsible Party named above has chosen to submit GPS coordinates in lieu of preparing a new well location plat for a plugging permit or assigned API number on the above well. The Office of Oil and Gas will not accept GPS coordinates that do not meet the following requirements:

1. Datum: NAD 1983, Zone: 17 North, Coordinate Units: meters, Altitude: height above mean sea level (MSL) _____ meters.
2. Accuracy to Datum - 3.05 meters
3. Data Collection Method:

Survey grade GPS : Post Processed Differential _____


Real-Time Differential _____

Mapping Grade GPS _____ : Post Processed Differential _____

Real-Time Differential _____

4. Letter size copy of the topography map showing the well location.

I the undersigned, hereby certify this data is correct to the best of my knowledge and belief and shows all the information required by law and the regulations issued and prescribed by the Office of Oil and Gas.

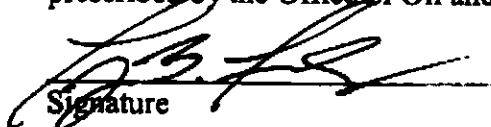
Signature

PS 2002
Title

JANUARY 2, 2026
Date

Office of Oil and Gas

JAN 23 2026

WV Department of Environmental Protection