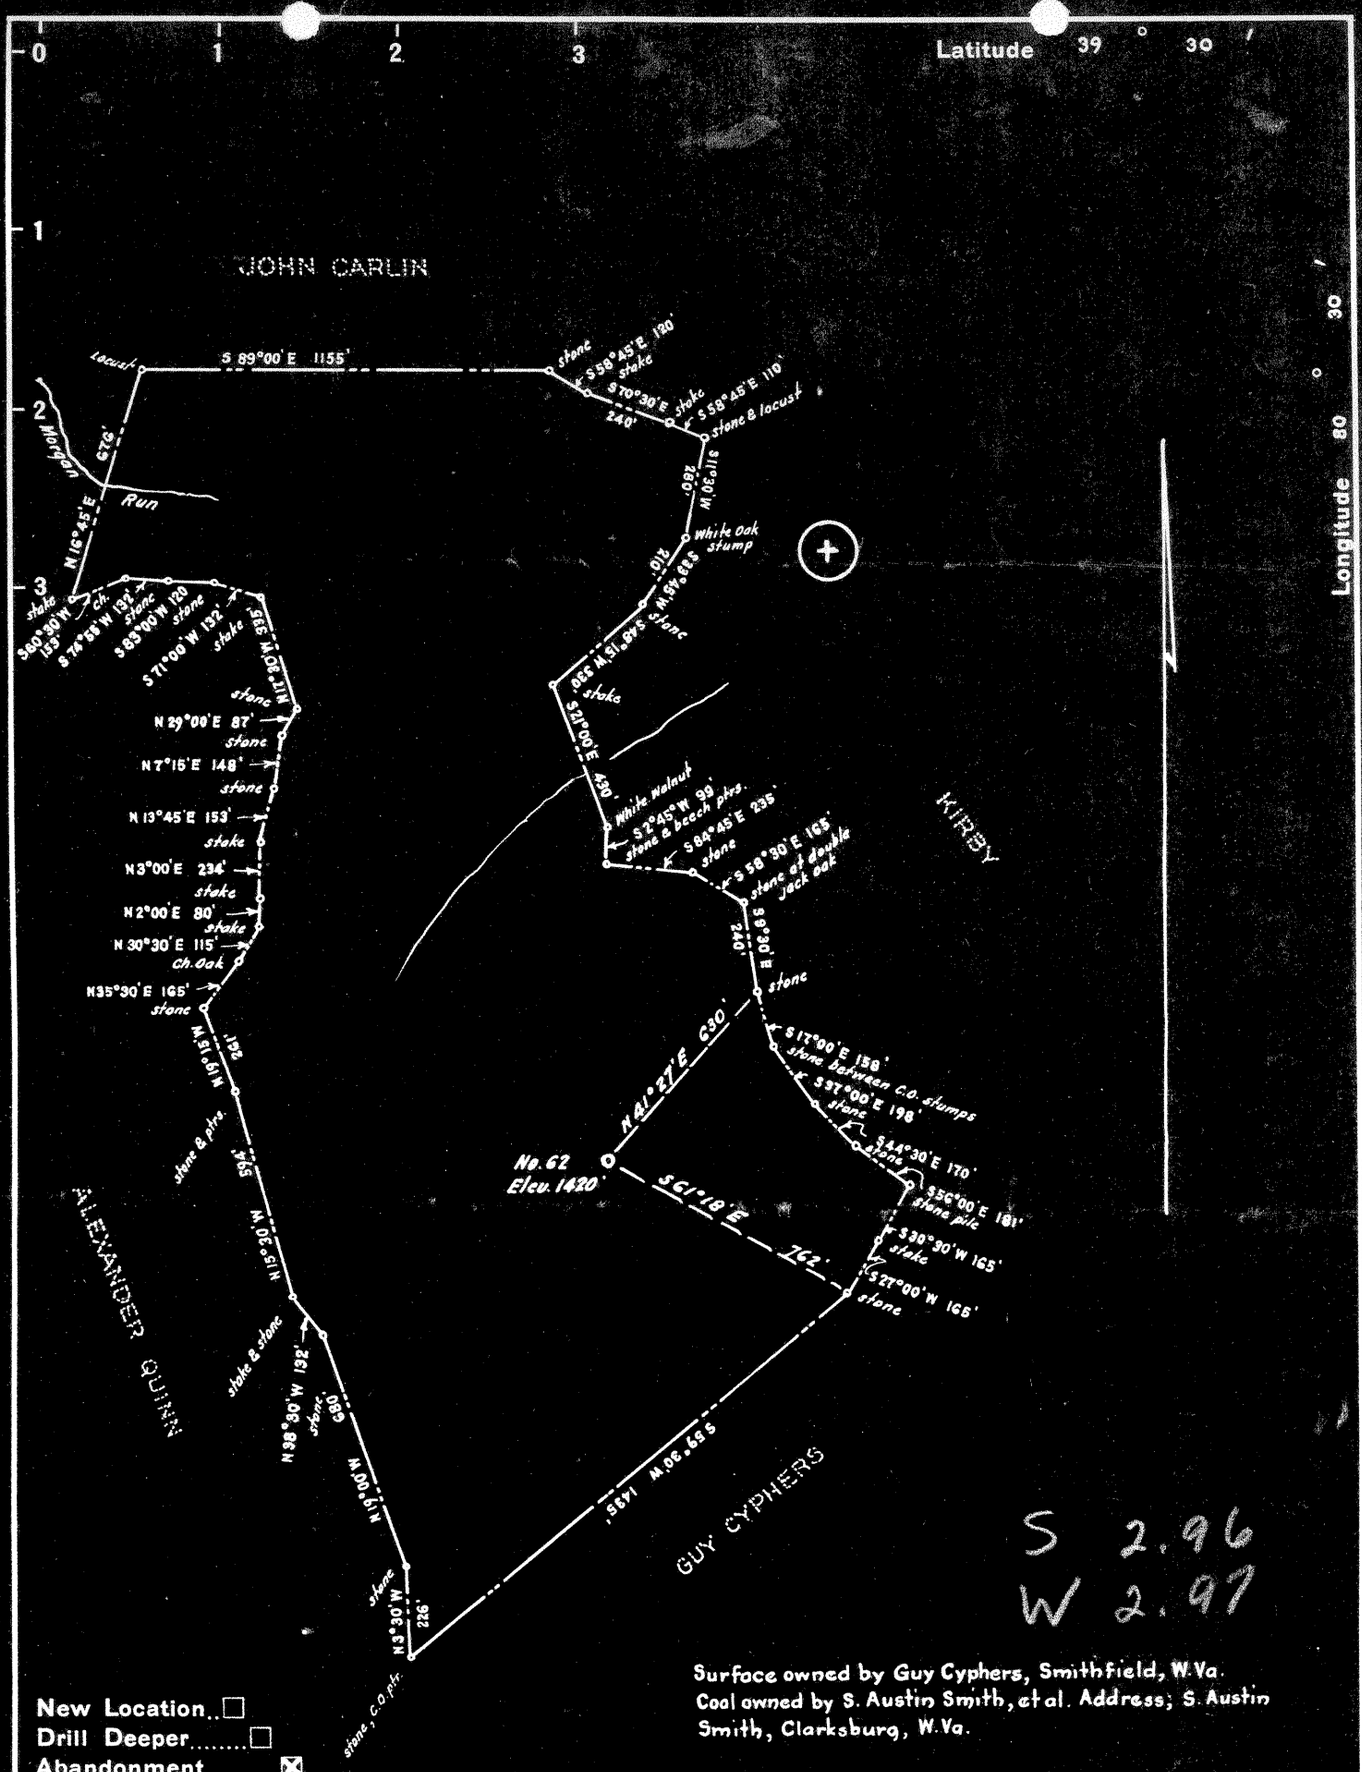

Surface owned by Guy Cyphers, Smithfield, W.Va.
Coal owned by S. Austin Smith, et al. Address; S. Austin Smith, Clarksburg, W.Va.

New Location..☐
Drill Deeper.....☐
Abandonment.....☒

South Penn Map N-49 N-1 E-4

Company RICHBURG SUPPLY CO.
Address Richburg, New York.
Farm B. Wells & Co.
Tract _____ Acres 3800 Lease No. _____
Well (Farm) No. Sixty-two Serial No. _____
Elevation (Spirit Level) 1420
Quadrangle Centerpoint NE
County Wetzel District Grant
Engineer [signature]
Engineer's Registration No. 1227
File No. _____ Drawing No. _____
Date April, 1941 Scale 1" = 500'

STATE OF WEST VIRGINIA
DEPARTMENT OF MINES
OIL AND GAS DIVISION
CHARLESTON

WELL LOCATION MAP

FILE NO. Wet-842-A

+ Denotes location of well on United States Topographic Maps, scale 1 to 62,500, latitude and longitude lines being represented by border lines as shown.

— Denotes one inch spaces on border line of original tracing.

"IMPERIAL" TRACING CLOTH
K & E CO., N. Y.