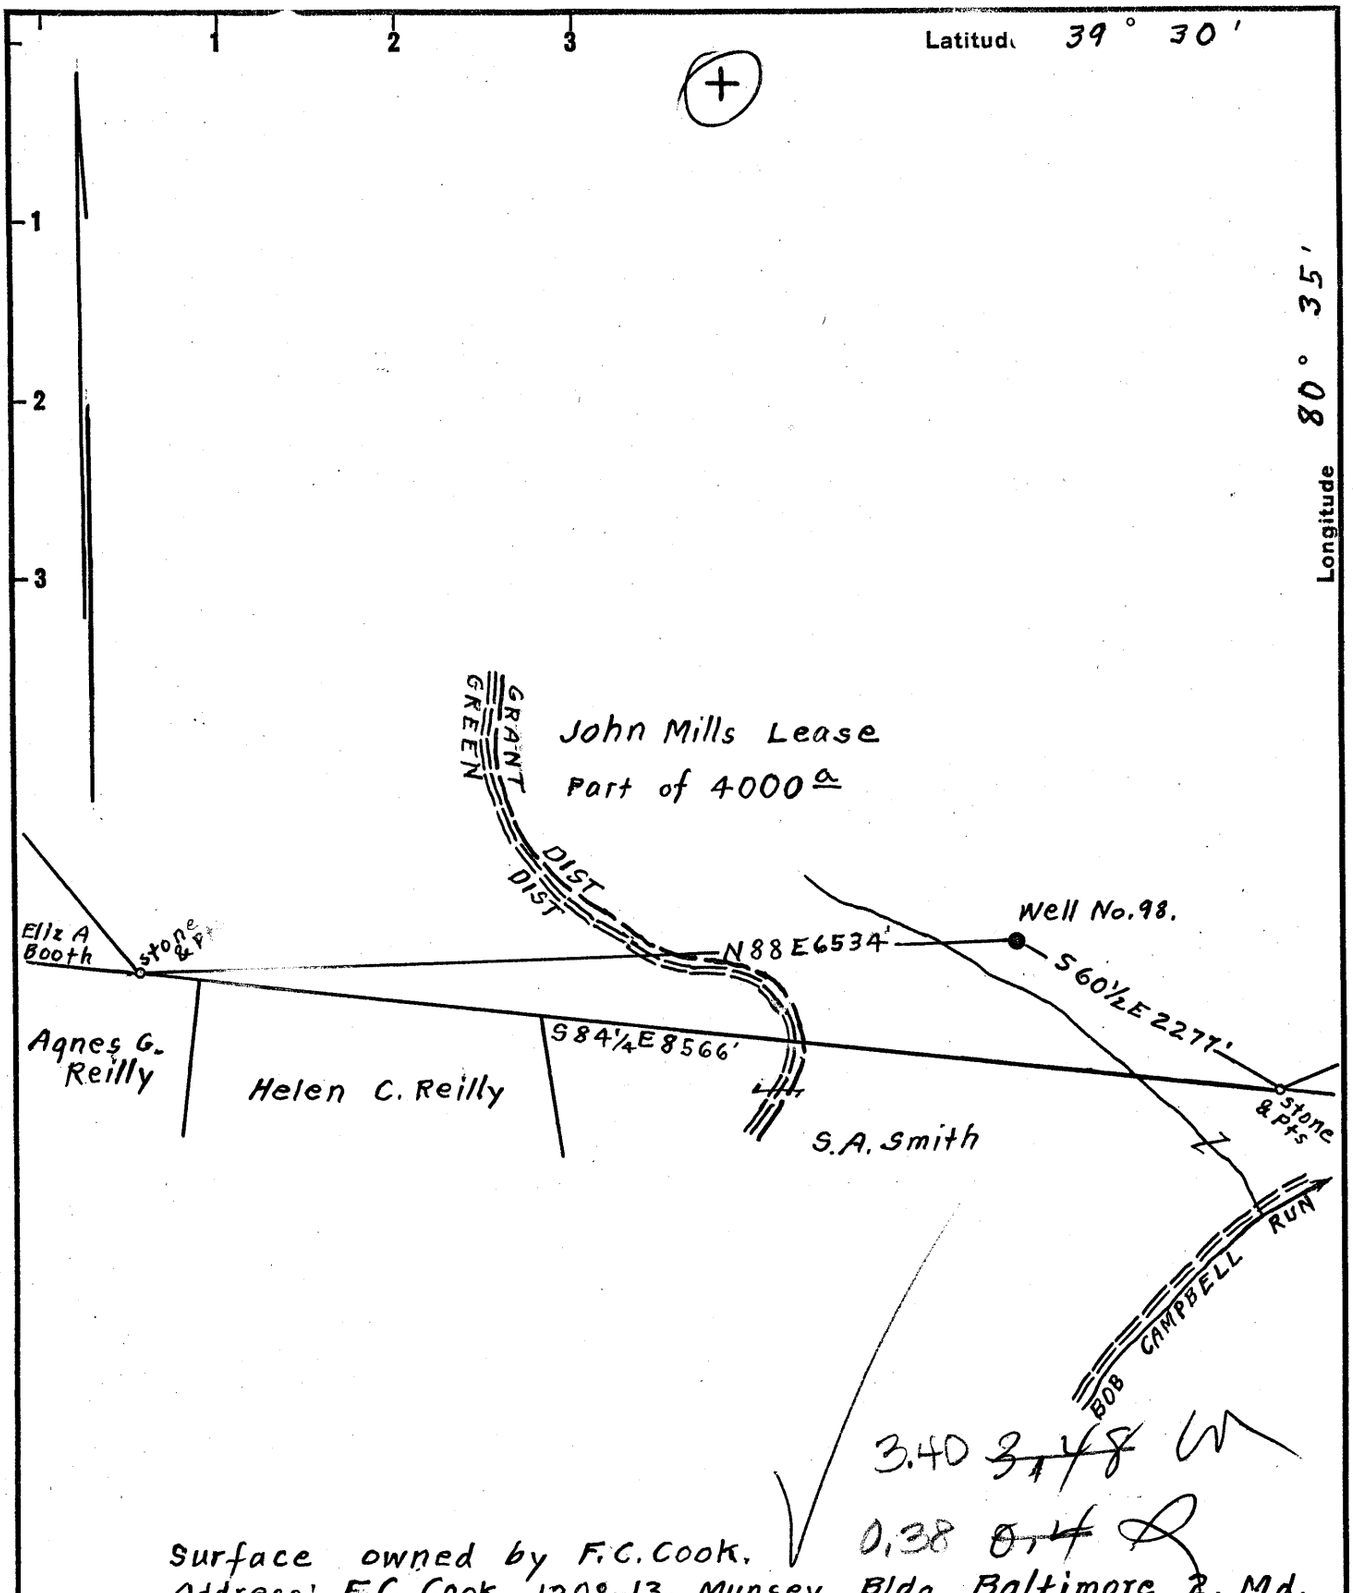

Surface owned by F.C. Cook.
Address: F.C. Cook, 1208-13, Munsey Bldg. Baltimore 2, Md.
Coal owned by Benjamin G. Reeder et al.
Address: Mr. Benjamin G. Reeder, 170. Chancery Row, Morgantown W.Va.

New Location ☐
Drill Deeper ☐
Abandonment ☒ On 800' Map N58, Sqs. N4 W2.

DEC 24 1957

Company William Moses
Address Salem, W. Va.
Farm John Mills
Tract _____ Acres Part of 4000 Lease No. _____
Well (Farm) No. 98 Serial No. _____
Elevation (Spirit Level) Ground 1168 NC
Quadrangle Centerpoint
County Wetzel District Grant
Engineer Elsworth Haines
Engineer's Registration No. 2221.
File No. _____ Drawing No. _____
Date Apr. 20th, 1957 Scale 1" = 1320 Feet

STATE OF WEST VIRGINIA
DEPARTMENT OF MINES
OIL AND GAS DIVISION
CHARLESTON

WELL LOCATION MAP

FILE NO. Wet-1079-A

+ Denotes location of well on United States Topographic Maps, scale 1 to 62,500, latitude and longitude lines being represented by border lines as shown.

— Denotes one inch spaces on border line of original tracing.

K&E 156 IMPERIAL

JOHN MILLS No. 98 — WILLIAM MOSES — WET-1079-A