

Latitude: 40°17'30" N

SURFACE HOLE 231'

Latitude: 40°20'00" N BOTTOM HOLE

1,530'

JACKSON SURVEYING INC.

2413 EAST PIKE ST. # 112
Clarksburg, WV 26302
304-623-5851

SURFACE HOLE LOCATION (SHL):
UTM (NAD83, ZONE 17, METERS):
NORTHING: 4,459,545.744
EASTING: 535,347.423

LANDING POINT LOCATION (LPL):
UTM (NAD83, ZONE 17, METERS):
NORTHING: 4,458,882.562
EASTING: 535,357.934

AZIMUTH POINT LOCATION 1 (AZL1):
UTM (NAD83, ZONE 17, METERS):
NORTHING: 4,461,722.335
EASTING: 535,283.762

AZIMUTH POINT LOCATION 2 (AZL2):
UTM (NAD83, ZONE 17, METERS):
NORTHING: 4,461,837.574
EASTING: 535,249.045

BOTTOM HOLE LOCATION (BHL):
UTM (NAD83, ZONE 17, METERS):
NORTHING: 4,463,237.630
EASTING: 534,930.654

Table with columns: LINE, BEARING, DISTANCE, DESCRIPTION, MONUMENT. Contains data for L1, L2, L3, L4.




SURFACE HOLE LOCATION (SHL):
UTM (NAD83, ZONE 17, METERS):
NORTHING: 4,459,545.949
EASTING: 535,347.549

LANDING POINT LOCATION (LPL):
UTM (NAD83, ZONE 17, METERS):
NORTHING: 4,458,894.293
EASTING: 536,356.324

AZIMUTH POINT LOCATION 1 (AZL1):
UTM (NAD83, ZONE 17, METERS):
NORTHING: 4,461,715.850
EASTING: 535,284.179

AZIMUTH POINT LOCATION 2 (AZL2):
UTM (NAD83, ZONE 17, METERS):
NORTHING: 4,461,849.417
EASTING: 535,245.198

BOTTOM HOLE LOCATION (BHL):
UTM (NAD83, ZONE 17, METERS):
NORTHING: 4,463,236.677
EASTING: 534,934.189

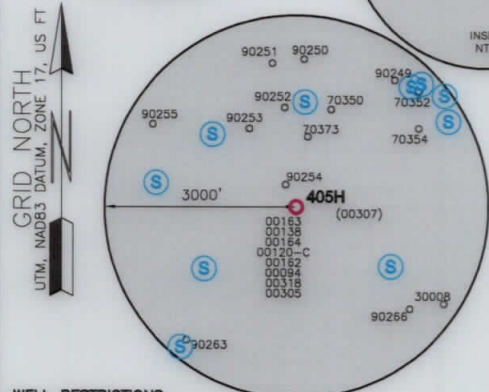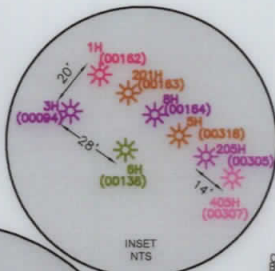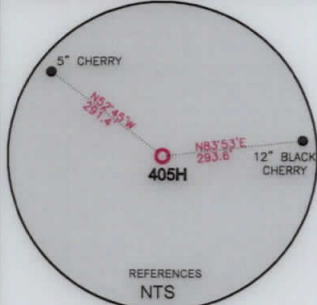

SHL 5,250'
BOTTOM HOLE 2,190'
SURFACE HOLE 2,190'
Longitude: 80°35'00" W

WELL RESTRICTIONS

- 1. NO OCCUPIED DWELLINGS > 2500 SQ. FT. WITHIN 625 FEET OF CENTER OF PAD.
2. NO AGRICULTURE BUILDINGS > 2500 SQ. FT. WITHIN 625 FEET OF CENTER OF PAD.
3. NO WATER WELLS OR DEVELOPED SPRINGS ARE WITHIN 250 FEET OF PROPOSED WELL.
4. NO PERENNIAL STREAMS, LAKES, PONDS, OR RESERVOIRS WITHIN 100 FEET OF THE LIMITS OF DISTURBANCE.
5. NO NATURALLY PRODUCING TROUT STREAM WITHIN 300 FEET OF LIMITS OF DISTURBANCE.
6. NO GROUND INTAKE OR PUBLIC WATER SUPPLY WITHIN 1000 FEET OF WELL PAD, LIMITS OF DISTURBANCE, E & S CONTROLS OR PUBLIC WATER SUPPLY.

NOTES ON SURVEY

- 1. SURFACE AND ROYALTY OWNER INFORMATION AND THEIR BOUNDARIES SHOWN HEREON WERE PLOTTED FROM DEEDS AND/OR TAX PARCEL MAPS PROVIDED BY CLIENT AND/OR FIELD LOCATIONS.
2. THIS PLAT DOES NOT REPRESENT A BOUNDARY SURVEY OF THE PARCELS SHOWN HEREON.
3. ALL INSETS ARE GRID NORTH UNLESS OTHERWISE DEPICTED.
4. I, THE UNDERSIGNED, HEREBY CERTIFY THAT THIS PLAT IS CORRECT TO THE BEST OF MY KNOWLEDGE AND BELIEF AND SHOWS ALL THE INFORMATION REQUIRED BY LAW AND REGULATIONS ISSUED AND PRESCRIBED BY THE DEPARTMENT OF ENVIRONMENTAL PROTECTION.



COMPANY: SWN Production Company, LLC

(+) DENOTES LOCATION OF WELL ON UNITED STATES TOPOGRAPHIC MAPS
WVDEP
OFFICE OF OIL & GAS
601 57TH STREET
CHARLESTON, WV 25034

MINIMUM DEGREE OF ACCURACY: 1/200
PROVEN SOURCE OF ELEVATION: SURVEY GRADE GPS (NAVD 88, US FT)


OV ROYALTY TRUST LLC BRK
OPERATOR'S WELL #: 405H
API WELL #: 47 009 00307
STATE COUNTY PERMIT

WELL TYPE: OIL WASTE DISPOSAL PRODUCTION DEEP GAS LIQUID INJECTION STORAGE SHALLOW
WATERSHED: PAINTERS RUN OF BUFFALO CREEK (HUC-10) ELEVATION: 1180.5'
DISTRICT: CROSS CREEK COUNTY: BROOKE QUADRANGLE: STUEBENVILLE EAST, WV
SURFACE OWNER: THE GENE CHARLES VALENTINE TRUST DATED 11/26/86 ACREAGE: ±494.38
OIL & GAS ROYALTY OWNER: THE GENE CHARLES VALENTINE TRUST DATED 11/26/86 ACREAGE: ±464.38
DRILL DRILL DEEPER REDRILL FRACTURE OR STIMULATE PLUG OFF OLD FORMATION PERFORATE NEW FORMATION
CONVERT PLUG & ABANDON CLEAN OUT & REPLUG OTHER CHANGE (SPECIFY) ASDRILLED
TARGET FORMATION: MARCELLUS ESTIMATED DEPTH: 3,627' IVD 23,484' TMD

WELL OPERATOR: SWN PRODUCTION COMPANY, LLC
ADDRESS: 1300 FORT PIERPONT ROAD, SUITE 200
CITY: MORGANTOWN STATE: WV ZIP CODE: 26508
DESIGNATED AGENT: BRITTANY WOODY
ADDRESS: 1300 FORT PIERPONT ROAD, SUITE 200
CITY: MORGANTOWN STATE: WV ZIP CODE: 26508

LEGEND: PROPOSED SURFACE HOLE / BOTTOM HOLE, EXISTING / PRODUCING WELLHEAD, LPL, EXISTING WATER WELL, EXISTING SPRING, SURVEYED BOUNDARY, DRILLING UNIT, LEASE BOUNDARY, ASDRILLED PATH, PROPOSED PATH, AZL, AZIMUTH POINT LOCATION
REVISIONS: DATE: 04-30-2021
DRAWN BY: N. MANO
SCALE: 1" = 3000'
DRAWING NO:
WELL LOCATION PLAT


JACKSON SURVEYING
 INC.
 2413 EAST PIKE ST. # 112
 Clarksburg, WV 26302
 304-623-5851

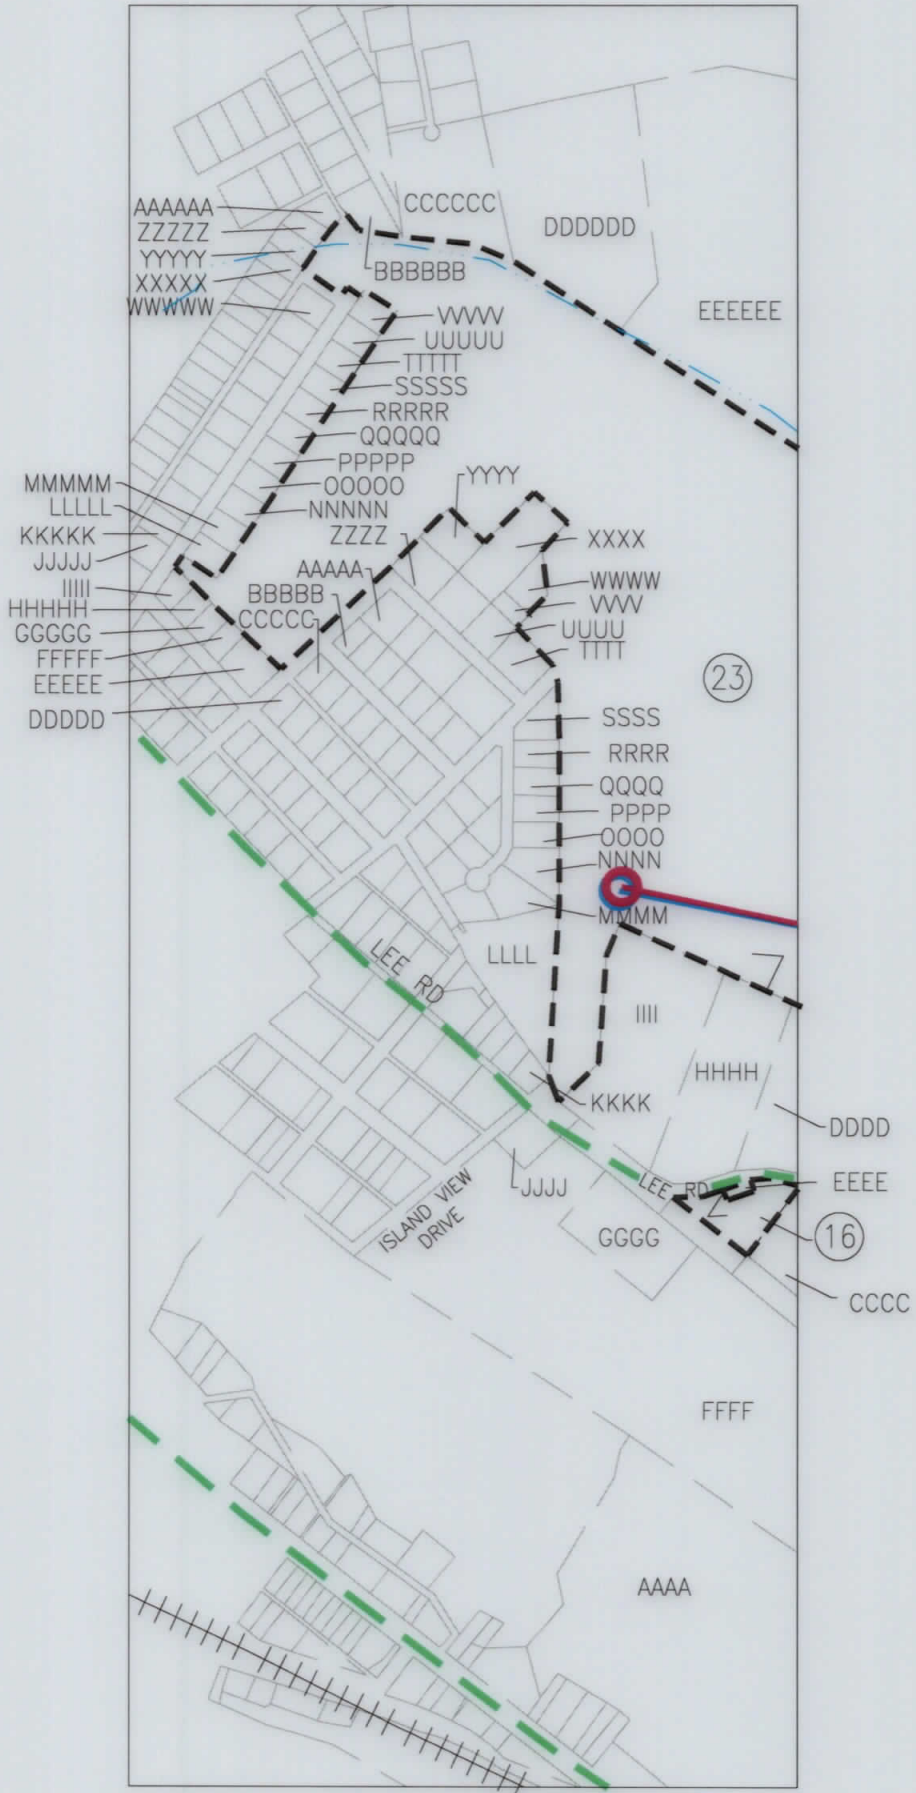

DETAIL "A"


08/27/2021

REVISIONS:	COMPANY:		
	OPERATOR'S OV ROYALTY TRUST LLC BRK	API #:	DATE: 04-30-2021
	WELL #:	47-009-00307	DRAWN BY: N. MANO
	DISTRICT:	COUNTY:	STATE:
	CROSS CREEK	BROOKE	WV
			SCALE: N/A
			DRAWING NO:
			WELL LOCATION PLAT 2

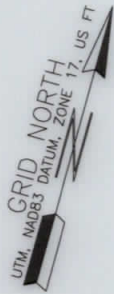

DETAIL "B"

08/27/2021



REVISIONS:	COMPANY:		
	OPERATOR'S OV ROYALTY TRUST LLC BRK	API #:	DATE: 04-30-2021
	WELL #:	47-009-00307	DRAWN BY: N. MANO
	DISTRICT:	COUNTY:	STATE:
	CROSS CREEK	BROOKE	WV
			SCALE: N/A
			DRAWING NO:
			WELL LOCATION PLAT 3

JACKSON SURVEYING
INC.
2413 EAST PIKE ST. # 112
Clarksburg, WV 26302
304-623-5851

WELL BORE TABLE FOR SURFACE / ROYALTY OWNERS		
TRACT	SURFACE OWNER (S) / ROYALTY OWNER (R)	TAX PARCEL
1	THE GENE CHARLES VALENTINE TRUST DATED 11/26/86 (S/R)	4-CC22-41
TRACT	SURFACE OWNER	TAX PARCEL
2	SCHIAPPA AND COMPANY INC. (S)	4-CC28-02
3	WILLIAM R. AFTANAS & MARGARET L. AFTANAS (S)	4-CC23-236
4	MCCOMBS FAMILY TRUST 4/3/19 (S)	4-CC23-238
5	MCCOMBS FAMILY TRUST (S)	4-CC23-239
6	JAMES W. FERGUSON (S)	4-CC23-243
7	JAMES W. LUNSFORD (S)	4-CC23-245
8	JAMES LUNSFORD (S)	04-CC23-203
9	DONNA KATHRYN HALL (S)	4-CC23-229
10	CHARLES KIRCHNER & JUDITH KIRCHNER ALLEMAN, ET AL (S)	4-CC23-230
11	FLOYD EUGENE TAYLOR & RHONDA C. TAYLOR (S)	4-CC23-5
12	FLOYD EUGENE TAYLOR & RHONDA C. TAYLOR (S)	4-CC23-6
13	FLOYD E. TAYLOR SR. & RHONDA C. TAYLOR (SURV)(S)	4-CC23-4
14	JAMES DODD, JEANNE MCGILL, & ROBIN GEORGE (S)	4-CC19-13
15	DANIEL MCGOWAN & MARJORIE G. MCGOWAN (S)	4-CC19-6
16	CAMPBELL SHELDON PALIZZI (S)	4-CC19-25
17	TRAVIS JAMES MCALEER & KAREN A. PIEHS (S)	4-CC19-26
18	RICHARD E. RYAN & CAROLYN G. RYAN (S)	4-CC19-27
19	BOARD OF EDUCATION (S)	4-CC18-33
20	NORFOLK & WESTERN RAILWAY CO. (S)	4-C19K-18
21	BOARD OF EDUCATION (S)	4-CC19-38
22	BOFFO FAMILY LIMITED PARTNERSHIP (S)	4-CC18-32
23	BOFFO FAMILY LIMITED PARTNERSHIP (S)	4-CC18-7

ADJOINING OWNERS TABLE			ADJOINING OWNERS TABLE		
TRACT	SURFACE OWNER	TAX PARCEL	TRACT	SURFACE OWNER	TAX PARCEL
A	MIKE RYNAWEC & SHIRLEY MAE RYNAWEC	03-B28A-04	AAA	JAMES DODD, ROBIN GEORGE, & JEANNE MCGILL	04-CC18-53
B	ROBERT R. FONNER & MICHELLE FONNER	04-CC28-01	BBB	JAMES DODD, ROBIN GEORGE, & JEANNE MCGILL	04-CC18-52
C	JOHN W. & NANCY TRAUBERT	04-CC23-234	CCC	JAMES D. BUCHWACH	04-CC18-50
D	PAUL LISH & PATRICIA ANN LISH	04-CC22-50	DDD	JAMES D. BUCHWACH	04-CC18-51
E	OV ROYALTY TRUST LLC	04-CC22-49	EEE	JAMES D. BUCHWACH	04-CC18-43
F	RONALD CONAWAY, DONALD CONAWAY & PATRICIA CONAWAY	04-CC22-47	FFF	JOHN P. HOSLER & GERALDINE HOSLER	04-CC18-42
G	SAMUEL J. & MELANIE A. DONINI	04-CC22-45	GGG	JASON CARBASHO	04-CC18-54
H	LOUIS M. & TINA L. MCGOWAN	04-CC22-44	HHH	MONONGAHELA POWER CO.	04-CC19-12
I	TINA L. MCGOWAN	04-CC22-43	III	BOARD OF EDUCATION	04-CC19-11
J	MICHAEL E. FRIEND	04-CC22-42	JJJ	PHYLLIS MARKER	04-CC18-41
K	JOHN C. BOBER III & JENNIFER R. BOBER	07-W22L-18	KKK	JEAN SHIRLEY DOUBLES	04-CC18-44
L	UNKNOWN	07-W22L-17	LLL	ROBIN L. HIMMERLICK (LE ELLA MAE HAYMAN)	04-CC18-45
M	RICHARD L. FRYER	07-W22L-11	MMM	GARY HENTHORN	04-CC18-46
N	CHRISTINE L. ICE	07-W22L-8	NNN	ROBIN L. HIMMERLICK (LE ELLA MAE HAYMAN)	04-CC18-47
O	CHRISTINE L. ICE	07-W22L-9	OOO	JAMES DODD, ROBIN GEORGE, & JEANNE MCGILL	04-CC18-48
P	CHRISTINE L. ICE	07-W22L-10	PPP	JAMES DODD, ROBIN GEORGE, & JEANNE MCGILL	04-CC18-49
Q	LARRY N. CLEMONS & SANDRA K. CLEMONS	07-W22L-4	QQQ	THOMAS M. BOYD, RICHARD A. BOYD, DAVID S. BOYD, TRUSTEES IN TRUST OF THOMAS J. BOYD	04-CC18-57
R	UNKNOWN	07-W22L-5	RRR	BOARD OF EDUCATION	04-CC18-34
S	WILLIAM RIGGS	04-C22G-82	SSS	BOARD OF EDUCATION	04-CC18-35
T	ROBERT J. ZAMPINI	04-C22G-81	TTT	BOARD OF EDUCATION	04-CC18-37
U	ROBERT J. ZAMPINI	04-C22G-80	UUU	NORFOLK & WESTERN RAILWAY CO.	04-C19K-18
V	T.H. CALDWELL HEIRS	04-C22G-79	VVV	BOARD OF EDUCATION	04-CC18-31
W	JACKIE RAY COLLEY, ROBERTA G. COLLEY	04-C22G-64	WWW	NORFOLK & WESTERN RAILWAY CO.	04-CC18-28
X	JACKIE COLLEY, ROBERTA G. COLLEY	04-C22G-63	XXX	PITTSBURGH & WVA RAILWAY CO.	04-CC18-27
Y	FRANKLIN FRAGALE	07-W22G-7	YYY	PITTSBURGH & WVA RAILWAY CO.	04-CC18-21
Z	JOHN WHITE, ROBERT WHITE, SHARON FREY, LE KATHRYN WHITE, RALPH WHITE, JEFFERY WHITE	07-W22G-5	ZZZ	BELLAIRE HARBOR SERVICES LLC (LE REBECCA JOHNSON)	04-CC18-20
AA	JOHN WHITE, ROBERT WHITE, SHARON FREY, LE KATHRYN WHITE, RALPH WHITE, JEFFERY WHITE	04-C22G-8	AAAA	ILONA POGGI	04-CC18-14
BB	DAVID R. ROTHWELL & WYNONNA ROTHWELL	04-C22G-19	BBBB	BOFFO FAMILY LIMITED PARTNERSHIP	04-CC18-5
CC	DAVID ROGER ROTHWELL, C/O JOHN BASSETT	04-C22G-20	CCCC	JAC-FRED WV LLC A NORTH CAROLINA LLC	04-CC18-6
DD	JUDITH L. FOWLER	04-C22G-31	DDDD	LG - OHI FOLLANSBEE, LLC	04-CC18-9
EE	VIRGINIA PRICE	04-C22G-33	EEEE	LG - OHI FOLLANSBEE, LLC	04-CC18-8
FF	GEORGE ENNIS	04-C22G-44	FFFF	BISHOP OF CATHOLIC DIOCESE WHEELING/CHARLESTON	04-CC18-2
GG	GEORGE F. ENNIS	04-C22G-45	GGGG	CITY OF FOLLANSBEE	04-CC18-4
HH	EARL W. MILLER JR.	04-C22G-46	HHHH	LG - OHI FOLLANSBEE, LLC	04-CC18-10
II	MARK KOSCEVIC	04-C22G-32	IIII	JAC-FRED WV LLC A NORTH CAROLINA LLC	04-CC18-11
JJ	TERRY L. SMITH & LORA J. SMITH	04-C22C-122	JJJJ	COLUMBIA GAS	04-CC18-3
KK	FRANK CARUSO & LISA C. CARUSO	04-C22G-60	KKKK	KENT ORBAN	04-CC18-12
LL	CHARLES R. BOGGS	04-C22G-57	LLLL	BURL R. WILLIAMS JR.	04-C14S-218
MM	CHARLES ISINGHOOD SR.	04-CC22-32	MMMM	MICHAEL EICHNER & LINDA S. EICHNER	04-C14S-74
NN	JIMMIE D. GEORGE & ROBIN J. GEORGE	04-CC22-31	NNNN	MICHAEL EICHNER & LINDA S. EICHNER	04-C14S-75
OO	DALE E. ADAMS & MARY K. ADAMS	04-CC22-30	OOOO	CARL FREDERICK BOFFO	04-C14S-76
PP	STEVEN P. DIPASQUALE & MARCY DIPASQUALE	04-CC22-26	PPPP	TERRY L. FRANKENFIELD & CHERYL L. FRANKENFIELD	04-C14S-77
QQ	DONALD C. TAYLOR JR. & JOAN WILLIAMS ET AL	04-CC22-20	QQQQ	STEPHEN PRITCHARD & BARBARA PRITCHARD	04-C14S-78
RR	ERIN R. SNODGRASS	04-CC22-21	RRRR	DAVID W. BARNHART & PAMELA A. BARNHART	04-C14S-79
SS	RON MICHAUX ET AL (LC JASON & DEANNA GALLOWAY)	04-CC22-22	SSSS	RAYMOND H. MCCOY JR. & CYNTHIA S. MCCOY	04-C14S-80
TT	CAROLYN F. FREEMAN	04-CC22-25	TTTT	RICHARD C. DEARTH & STACEY A. DEARTH	04-C14S-81.1
UU	CAROLYN F. FREEMAN & LAWRENCE FREEMAN	04-CC23-232	UUUU	BRIAN BEATTY	04-C14S-81.2
VV	DORIS J. KIRCHNER	04-CC23-231	VVVV	BRIAN L. BEATTY	04-C14S-219
WW	SHAWN CALDWELL	04-CC23-3	WWWW	BRIAN L. BEATTY	04-C14S-226
XX	JAMES HARWELL DODD JR.	04-CC23-1	XXXX	CHRISTOPHER O. RAY & KAREN L. RAY	04-C14S-225
YY	JAMES HARWELL DODD & LYNN I. DODD	04-CC22-24	YYYY	MARK BARBETTA & DAWN BARBETTA	04-C14S-222
ZZ	DONNA MARIE PRICE	04-CC22-23	ZZZZ	MARK BARBETTA & DAWN BARBETTA	04-C14S-81.4

08/27/2021



REVISIONS:	COMPANY:	 	
	OPERATOR'S OV ROYALTY TRUST LLC BRK	API #:	DATE: 04-30-2021
	WELL #:	47-009-00307	DRAWN BY: N. MANO
	DISTRICT:	COUNTY:	SCALE: N/A
	CROSS CREEK	BROOKE	DRAWING NO:
		STATE:	WV
			WELL LOCATION PLAT 4

**JACKSON SURVEYING
INC.**

2413 EAST PIKE ST. # 112
Clarksburg, WV 26302
304-623-5851

ADJOINING OWNERS TABLE			ADJOINING OWNERS TABLE		
TRACT	SURFACE OWNER	TAX PARCEL	TRACT	SURFACE OWNER	TAX PARCEL
AAAA	MICHAEL P. ROSKANDICH & KELLY J. ROKSANDICH	04-C14S-81.3	DDDDDD	KENNETH J. ULRICH & MICHAELYN ULRICH	04-CC19-41
BBBB	GARY L. WILLIAMS & SHARON J. WILLIAMS	04-C14S-84	EEEEEE	KENNETH J. ULRICH & MICHAELYN ULRICH	04-CC19-40
CCCC	AARON BURCH	04-C14S-97	FFFFFF	GEORGE PAULL PFISTER III	04-CC19-39
DDDD	BONNIE S. SHAWN	04-C14S-98	GGGGGG	BROOKE COUNTY COMMISSION	04-CC19-193
EEEE	CARL FREDERICK BOFFO	04-C14S-128	HHHHHH	BOARD OF EDUCATION	04-CC19-38.1
FFFF	JAC-FRED WV LLC A NORTH CAROLINA LLC	04-C14S-129	IIIIII	JAMES BURNS, RANDY COLLINS	04-CC19-14
GGGG	JAC-FRED WV LLC A NORTH CAROLINA LLC	04-C14S-130	JJJJJJ	CLARENCE T. BLACK & TAMMY L. BLACK	04-CC19-36
HHHH	JAC-FRED WV LLC A NORTH CAROLINA LLC	04-C14S-131	KKKKKK	JEFFERY SCOTT YOUNG, MELANIE DAWN MAXWELL	04-CC19-35
IIII	LAURA M. FRIEND	04-C14S-132	LLLLLL	RANDY & LINDA LOUISE KOWALCZYK	04-CC19-34
JJJJ	ERNEST C. FRIEND, JR. & ROSALIND FRIEND	04-C14S-153	MMMMMM	RANDY & LINDA LOUISE KOWALCZYK	04-CC19-33
KKKK	JAMES R. BINGIEL SR.	04-C14S-152	NNNNNN	RANDY & LINDA LOUISE KOWALCZYK	04-CC19-32
LLLL	RAY L. ADAMS & LISA M. ADAMS	04-C14S-133	OOOOOO	TERRY R. JOHNSON & BETH ANN JOHNSON	04-CC19-28
MMMM	RONALD C. PENROD & JUDITH A. PENROD	04-C14S-134	PPPPPP	RANDY LEE KOWALCZYK & LINDA LOUISE KOWALCZYK	04-CC19-29
NNNN	CHAS & AURORA LOPEZ	04-C14S-135	QQQQQQ	CAMPBELL SHELDON PALIZZI	04-CC19-24
OOOO	SHIRLEY M. KIRTLEY	04-C14S-136	RRRRRR	CAMPBELL SHELDON PALIZZI	04-CC19-23
PPPP	MEGAN E. PINTUS	04-C14S-137	SSSSSS	FRANKLIN M. AFTANAS JR. & DEBRA D. AFTANAS	04-CC19-22
QQQQ	TIFFANY WILLIAMS	04-C14S-138	TTTTTT	FRANKLIN M. AFTANAS JR. & DEBRA D. AFTANAS	04-CC19-20
RRRR	BRIAN L. SMITH & DAWN E. SMITH	04-C14S-139	UUUUUU	MARTIN J. BARTZ JR.	04-CC19-18
SSSS	JOHN M. KUZMA & PATRICIA A. KUZMA	04-C14S-140	VVVVVV	DENNIS K. YOST DBA KEITH YOST EXCAVATING	04-CC19-5
TTTT	ELMER SANDRETH JR. & REBECCA SANDRETH	04-C14S-141	WWWWWW	ROGER L. JONES & JULIA ANN JONES	04-CC19-2
UUUU	THOMAS E. BOREMAN & SHARON BOREMAN	04-C14S-142	XXXXXXXX	CHARLES A. HOGGARD	04-CC19-7
VVVV	THOMAS E. BOREMAN & SHARON BOREMAN	04-C14S-223	YYYYYY	FRANK E. SMITH & DORTHA JEAN SMITH, JEFF E. SMITH ET AL	04-CC19-9
WWWW	GARY W. POWELL	04-C14S-143	ZZZZZZ	FRANK E. SMITH & DORTHA JEAN SMITH, JEFF E. SMITH ET AL	04-CC19-10
XXXX	HAROLD WAUGH & SHIRLEY WAUGH	04-C14S-174	AAAAAAA	FRANK E. SMITH & DORTHA JEAN SMITH, JEFF E. SMITH ET AL	04-CC19-8
YYYY	HAROLD WAUGH & SHIRLEY WAUGH	04-C14S-175	BBBBBBB	DANIEL E. MCGOWAN & MARJORIE G. MCGOWAN	04-CC23-12
ZZZZ	HAROLD WAUGH & SHIRLEY WAUGH	04-C14S-176	CCCCCCC	DONALD R. HALL & BEVERLY J. HALL	04-CC23-9
AAAAA	CITY OF FOLLANSBEE	04-C14S-177	DDDDDDD	DONALD R. HALL & BEVERLY J. HALL	04-CC23-8
BBBBB	TERESA CIONINI	04-C15N-58	EEEEEEE	DONALD R. HALL & BEVERLY J. HALL	04-CC23-7
CCCCC	NORMA B. TRAUBERT, ET AL	04-C15N-77	FFFFFFF	ROBERT EVAN MOZINGO, HERBERT MOZINGO, JEFFERY MOZINGO, CHRISTINE STEIN	04-CC23-11
DDDDD	SHERI A. STIFT	04-C15N-87	GGGGGGG	HENRY CUNNINGHAM	04-CC23-225
EEEEE	DEAN RICHARDSON & SHARON RICHARDSON	04-C19A-10	HHHHHHH	KIM E. & ARCHIE L. DOLL	04-CC23-226
FFFFFF	ANGELA FORD	04-C19A-106	IIIIIIII	ROD E. PATTISON & CYNTHIA A. PATTISON	04-CC23-227
GGGGG	WILLIAM D. SECRIST JR.	04-C19A-116.1	JJJJJJJ	RANDALL P. DOLL & KIMBERLY JO DOLL	04-CC23-204
HHHHH	RICK SNYDER & ESTHER SNYDER	04-C19A-117	KKKKKKK	LARRY J. GRAY & BARBARA S. GRAY	04-CC23-228
IIIII	VERA HUNT BOFFO	04-C19A-137	LLLLLLL	ARTHUR J. FRIEND (LE NORMA JEAN FRIEND)	04-CC23-202
JJJJJ	JADE M. WEEKS & CHRISTOPHER D. WEEKS	04-C19A-138	MMMMMMM	HUBERT S. RIGGS & WANDA JO RIGGS	04-CC23-201
KKKKK	BARBARA GEARY	04-C19A-146	NNNNNNN	WILLIAM M. DURBIN	04-CC23-172
LLLLL	JAMES H. JONES JR., KEVI JONES, DIANNA L. CORDER JONES	04-C19E-4	OOOOOOO	KEITH M. MOORE & CHRISTOL A. MOORE	04-CC23-171
MMMMM	CHRISTINE A. BEARD ROSNOVICH & GEORGE B. ROSNOVICH	04-C19E-5	PPPPPPP	JAMES LUNFORD	4-CC23-51.17
NNNNN	DARRELL HENLINE & DONNA HENLINE	04-C19E-6	QQQQQQQ	MICHAEL P. SICURELLA	04-CC23-249
OOOOO	REBECCA S. BELL, THOMAS C. BELL	04-C19E-7	RRRRRRR	GARY W. BYERS & KIMBERLY JO BYERS	04-CC23-244
PPPPP	REBECCA S. BELL, THOMAS C. BELL	04-C19E-9	SSSSSSS	JOYCE S. WILSON	04-CC23-242
QQQQQ	DONALD P. MCABEE, DENA D. MCABEE	04-C19E-10	TTTTTTT	LOIS ELLEN DAUGHERTY	04-CC23-241
RRRRR	JEFFERY LOUIS FODOR & DREMA DAWN FODOR	04-C19E-12	UUUUUUU	JAMES W. FERGUSON	04-CC23-240
SSSSS	JOSHUA A. HOOKER, JOSEPH C. HOOKER, LE BETH HOOKER	04-C19E-14	VVVVVVV	GERALD NARIGON II & PENNIE A. NARIGON	03-B23P-05
TTTTT	RALPH W. ROWLAND & WILDA K. ROWLAND	04-C19E-17	WWWWWWW	BETTY LOU HARRIS	03-B23P-04
UUUUU	VIRGINIA L. HADDON	04-C19E-19	XXXXXXXX	JAMES L. STOCK & JOYCE RENEE STOCK	03-B23P-03
VVVVV	DONALD K. NORCROSS, LAURA R. NORCROSS BARNES	04-C19E-24	YYYYYYY	NAZARENE CHURCH	04-CC23-237
WWWWW	JACKIE L. FRITZ & KEVIN M. FRITZ	04-C19E-27	ZZZZZZZ	ROBERT C. NELSON & JANET NELSON	03-B23P-02
XXXXX	ROBERT & BRIANA M. HINKLE (JTWS)	04-C19E-29.1	AAAAAAA	GEORGE W. SHEPARD JR. & MARGARET SHEPHERD	03-B23P-01
YYYYY	CHARLES PAUL ULRICH	04-CC19-88	BBBBBBB	BRENDA KERR	03-B28A-41
ZZZZZ	MARY ANN COX	04-CC19-48	CCCCCCC	WILLIAM R. AFTANAS & MARGARET AFTANAS	04-CC28-05
AAAAA	JOHN R. CARE & DORIS JUNE CARE	04-CC19-46	DDDDDDD	WILLIAM R. AFTANAS & MARGARET AFTANAS	04-CC28-03
BBBBB	CHARLES M. ULRICH	04-CC19-43			
CCCCC	CHARLES M. ULRICH	04-CC19-42			

08/27/2021

REVISIONS:	COMPANY:	 	
		OPERATOR'S OV ROYALTY TRUST LLC BRK	API #:
		WELL #: 405H	47-009-00307
	DISTRICT: CROSS CREEK	COUNTY: BROOKE	STATE: WV
			DATE: 04-30-2021
			DRAWN BY: N. MANO
			SCALE: N/A
			DRAWING NO:
			WELL LOCATION PLAT 5