

State of West Virginia
Department of Environmental Protection - Office of Oil and Gas
Well Operator's Report of Well Work

RECEIVED
Office Of Oil and Gas

FEB 18 2025

WV Department of
Environmental Protection

API 47 - 009 - 00341 County Brook District Cross Creek
Quad Steubenville East Pad Name State of WV DNR C BRK Pad Field/Pool Name Panhandle Field - Wet
Farm name State of WV DNR C BRK Well Number 206H
Operator (as registered with the OOG) SWN Production Company LLC
Address PO Box 12359 City Spring State TX Zip 77391

As Drilled location NAD 83/UTM Attach an as-drilled plat, profile view, and deviation survey
Top hole Northing 4,461,410.696 Easting 539,285.741
Landing Point of Curve Northing 4,461,215.894 Easting 538,902.028
Bottom Hole Northing 4,454,069.491 Easting 541,701.734

Elevation (ft) 989 GL Type of Well ☒ New ☐ Existing Type of Report ☐ Interim ☒ Final
Permit Type ☐ Deviated ☒ Horizontal ☐ Horizontal 6A ☐ Vertical Depth Type ☐ Deep ☒ Shallow
Type of Operation ☐ Convert ☐ Deepen ☒ Drill ☐ Plug Back ☐ Redrilling ☐ Rework ☒ Stimulate
Well Type ☐ Brine Disposal ☐ CBM ☒ Gas ☐ Oil ☐ Secondary Recovery ☐ Solution Mining ☐ Storage ☐ Other _____
Type of Completion ☒ Single ☐ Multiple Fluids Produced ☐ Brine ☒ Gas ☐ NGL ☐ Oil ☐ Other _____
Drilled with ☐ Cable ☒ Rotary

Drilling Media Surface hole ☒ Air ☐ Mud ☐ Fresh Water Intermediate hole ☒ Air ☐ Mud ☐ Fresh Water ☐ Brine
Production hole ☒ Air ☒ Mud ☐ Fresh Water ☐ Brine
Mud Type(s) and Additive(s)
SOBM

Date permit issued 2024-5-13 Date drilling commenced 2024-06-22 Date drilling ceased 2024-07-08
Date completion activities began 2024-10-10 Date completion activities ceased 2024-12-24
Verbal plugging (Y/N) N Date permission granted N/A Granted by N/A

Please note: Operator is required to submit a plugging application within 5 days of verbal permission to plug

APPROVED

Freshwater depth(s) ft 370 Open mine(s) (Y/N) depths N
Salt water depth(s) ft 574 Void(s) encountered (Y/N) depths N
Coal depth(s) ft 548 Cavern(s) encountered (Y/N) depths N
Is coal being mined in area (Y/N) N

Reviewed by:

Shirley Gower
07/25/2025
6/23/2025

API 47-009 - 00341 Farm name State of WV DNR C BRK Well number 206H

CASING STRINGS	Hole Size	Casing Size	Depth	New or Used	Grade wt/ft	Basket Depth(s)	Did cement circulate (Y/ N) * Provide details below*
Conductor	20.000	20.000	136		J-55/94.00		Y
Surface	17.500	13.375	437		J-55/54.50		Y
Coal							
Intermediate 1	12.250	9.625	2015		J-55/36.00		Y
Intermediate 2							
Intermediate 3							
Production	8.500	5.500	31341		P-110/20.00		Y
Tubing							
Packer type and depth set							

Comment Details _____

CEMENT DATA	Class/Type of Cement	Number of Sacks	Slurry wt (ppg)	Yield (ft ³ /sks)	Volume (ft ³)	Cement Top (MD)	WOC (hrs)
Conductor	Class A	Grout to Surface				Surface	24
Surface	Class A	449	15.6	1.19	65	Surface	8
Coal							
Intermediate 1	Class A	814	15.6	1.18	120	Surface	8
Intermediate 2							
Intermediate 3							
Production	Class A	6333	14.5	1.26	1311	Surface	24
Tubing							

Drillers TD (ft) 31365 Loggers TD (ft) 31365
Deepest formation penetrated Marcellus Plug back to (ft) 31255
Plug back procedure N/A

RECEIVED
Office Of Oil and Gas

FEB 18 2025

Kick off depth (ft) 5123

WV Department of
Environmental Protection

Check all wireline logs run ☒ caliper ☒ density ☒ deviated/directional ☐ induction
☒ neutron ☒ resistivity ☒ gamma ray ☒ temperature ☐ sonic

Well cored ☐ Yes ☒ No Conventional Sidewall Were cuttings collected ☐ Yes ☒ No

DESCRIBE THE CENTRALIZER PLACEMENT USED FOR EACH CASING STRING _____

SURFACE: CENTRALIZERS - EVERY THIRD JOINT OF CASING

INTERMEDIATE: CENTRALIZERS - EVERY THIRD JOINT OF CASING

PRODUCTION: CENTRALIZERS - EVERY THIRD JOINT FROM SURFACE TO TOP OF CURVE, THEN EVERY JOINT UNTIL TD

WAS WELL COMPLETED AS SHOT HOLE ☐ Yes ☒ No DETAILS _____

WAS WELL COMPLETED OPEN HOLE? ☐ Yes ☒ No DETAILS _____

WERE TRACERS USED ☐ Yes ☒ No TYPE OF TRACER(S) USED _____

07/25/2025

API 47- 009 - 00341 Farm name State of WV DNR C BRK Well number 206H

PERFORATION RECORD

[illegible]

Please insert additional pages as applicable.

RECEIVED
Office Of Oil and Gas

FEB 18 2025

STIMULATION INFORMATION PER STAGE

Complete a separate record for each stimulation stage.

WV Department of
Environmental Protection

[illegible]

Please insert additional pages as applicable.

07/25/2025

Stage No.	Perforation Date	Perforated from MD ft.	Perforated to MD ft.	Formation(s)
1	2024-10-02	31255	31158	
2	2024-10-10	31124	30946	
3	2024-10-11	30913	30735	
4	2024-10-12	30701	30523	
5	2024-10-13	30490	30312	
6	2024-10-13	30279	30101	
7	2024-10-14	30068	29890	
8	2024-10-14	29856	29678	
9	2024-10-15	29645	29467	
10	2024-10-15	29434	29256	
11	2024-10-15	29222	29044	
12	2024-10-16	29011	28833	
13	2024-10-16	28800	28622	
14	2024-10-17	28589	28411	
15	2024-10-17	28377	28199	
16	2024-10-17	28166	27988	
17	2024-10-18	27955	27777	
18	2024-10-18	27743	27565	
19	2024-10-19	27532	27354	
20	2024-10-20	27321	27143	
21	2024-10-19	27110	26932	
22	2024-10-20	26898	26720	
23	2024-10-20	26687	26509	
24	2024-10-20	26476	26298	
25	2024-10-21	26264	26086	
26	2024-10-21	26053	25875	
27	2024-10-21	25842	25664	
28	2024-10-22	25631	25453	
29	2024-10-22	25419	25241	
30	2024-10-22	25208	25030	
31	2024-10-23	24997	24819	
32	2024-10-23	24785	24607	
33	2024-10-23	24574	24396	
34	2024-10-24	24363	24185	
35	2024-10-24	24152	23974	
36	2024-10-24	23940	23762	
37	2024-10-25	23729	23551	
38	2024-10-26	23518	23340	
39	2024-10-26	23306	23128	
40	2024-10-26	23095	22917	
41	2024-10-27	22884	22706	
42	2024-10-27	22673	22495	
43	2024-10-27	22461	22283	
44	2024-10-28	22250	22072	
45	2024-10-28	22039	21861	
46	2024-10-29	21827	21649	

RECEIVED
Office Of Oil and Gas
FEB 18 2025
WV Department of
Environmental Protection

07/25/2025

47 2024-10-29	21616	21438
48 2024-10-29	21405	21227
49 2024-10-29	21194	21016
50 2024-10-30	20982	20804
51 2024-10-30	20771	20593
52 2024-10-30	20560	20382
53 2024-10-31	20348	20170
54 2024-10-31	20137	19959
55 2024-10-31	19926	19748
56 2024-10-31	19715	19537
57 2024-11-01	19503	19325
58 2024-11-01	19292	19114
59 2024-11-01	19081	18903
60 2024-11-02	18869	18691
61 2024-11-02	18658	18480
62 2024-11-02	18447	18269
63 2024-11-03	18236	18058
64 2024-11-03	18024	17846
65 2024-11-03	17813	17635
66 2024-11-04	17602	17424
67 2024-11-04	17390	17212
68 2024-11-04	17179	17001
69 2024-11-05	16968	16790
70 2024-11-05	16757	16579
71 2024-11-05	16545	16367
72 2024-11-06	16334	16156
73 2024-11-06	16123	15945
74 2024-11-06	15911	15733
75 2024-11-07	15700	15522
76 2024-11-07	15489	15311
77 2024-11-07	15278	15100
78 2024-11-08	15066	14888
79 2024-11-08	14855	14677
80 2024-11-08	14644	14466
81 2024-11-08	14432	14254
82 2024-11-09	14221	14043
83 2024-11-09	14010	13832
84 2024-11-09	13799	13621
85 2024-11-10	13587	13409
86 2024-11-10	13376	13198
87 2024-11-10	13165	12987
88 2024-11-11	12953	12775
89 2024-11-11	12742	12564
90 2024-11-11	12531	12353
91 2024-11-12	12320	12142
92 2024-11-12	12108	11930
93 2024-11-12	11897	11719

RECEIVED
Office Of Oil and Gas

FEB 18 2025

WV Department of
Environmental Protection

07/25/2025

94 2024-11-12	11686	11508
95 2024-11-13	11474	11296
96 2024-11-13	11263	11085
97 2024-11-13	11052	10874
98 2024-11-13	10841	10663
99 2024-11-14	10629	10451
100 2024-11-14	10418	10240
101 2024-11-14	10207	10029
102 2024-11-14	9995	9817
103 2024-11-14	9784	9606
104 2024-11-15	9573	9395
105 2024-11-15	9362	9184
106 2024-11-15	9150	8972
107 2024-11-15	8939	8761
108 2024-11-16	8728	8550
109 2024-11-16	8516	8338
110 2024-11-16	8305	8127
111 2024-11-16	8094	7916
112 2024-11-16	7883	7705
113 2024-11-17	7671	7493
114 2024-11-17	7460	7282
115 2024-11-17	7249	7071
116 2024-11-17	7037	6859
117 2024-11-17	6826	6648
118 2024-11-18	6615	6437
119 2024-11-18	6404	6226
120 2024-11-18	6192	6014

RECEIVED
Office Of Oil and Gas

FEB 18 2025

WV Department of
Environmental Protection

07/25/2025

FEB 18 2025

STATE OF WV DNR C 206H

ATTACHMENT 2

WV Department of
Environmental Protection

STIM REPORT

STAGE NUM	Stim Date	Ave Pump Rate (BPM)	Ave Treatment	Max Breakdown	ISIP (PSI)	Amount of Proppant (lbs)	Amount of water bbls	Amount of nitrogen/othe
1	10/10/2024	54.4	9,113	6,175	3,896	37,088	8,861	0
2	10/10/2024	74.3	8,490	5,273	3,801	378,590	13,755	0
3	10/12/2024	78.6	9,508	6,679	4,585	357,220	10,309	0
4	10/12/2024	73.6	9,004	6,578	4,460	352,280	10,659	0
5	10/13/2024	72.8	9,378	6,097	4,322	351,660	10,126	0
6	10/14/2024	80.3	9,612	7,031	4,586	289,290	9,190	0
7	10/14/2024	82.1	9,556	7,040	4,196	348,550	10,351	0
8	10/15/2024	74.3	9,402	6,580	4,677	352,940	9,610	0
9	10/15/2024	75.8	9,689	6,941	5,000	348,470	9,533	0
10	10/15/2024	71.3	9,271	6,972	4,744	347,850	8,808	0
11	10/16/2024	78.1	9,669	7,022	4,898	356,600	9,060	0
12	10/16/2024	88.8	9,625	6,725	4,798	350,260	9,701	0
13	10/16/2024	82.5	9,313	6,412	4,300	357,560	8,702	0
14	10/17/2024	83.3	9,590	6,313	4,435	347,100	9,345	0
15	10/17/2024	84.5	9,603	6,237	4,862	351,840	8,952	0
16	10/17/2024	76.2	9,084	6,128	4,601	356,880	8,627	0
17	10/18/2024	82.6	9,573	6,551	4,798	349,380	8,649	0
18	10/18/2024	85	9,401	6,600	4,620	357,440	8,418	0
19	10/19/2024	84	9,287	6,494	4,986	354,720	8,458	0
20	10/19/2024	85.8	9,356	5,720	4,565	353,700	8,456	0
21	10/20/2024	83.5	9,402	6,444	4,736	375,350	8,367	0
22	10/20/2024	85.8	9,591	6,190	4,598	373,620	8,721	0
23	10/20/2024	84.5	9,430	6,200	4,410	379,650	8,563	0
24	10/21/2024	81.8	9,085	6,346	4,511	376,920	8,410	0
25	10/21/2024	79	8,572	5,952	4,715	371,220	8,321	0
26	10/21/2024	85.7	9,136	6,254	4,512	380,940	8,695	0
27	10/22/2024	78.4	8,494	6,207	4,601	371,200	8,258	0
28	10/22/2024	77.6	8,547	6,370	4,689	378,840	8,563	0
29	10/22/2024	91.5	9,522	6,390	4,165	379,320	8,568	0
30	10/22/2024	87.6	9,404	5,874	4,677	378,900	8,321	0
31	10/23/2024	93.5	9,392	5,745	5,100	373,720	8,495	0
32	10/23/2024	91.4	9,749	6,289	4,521	380,560	8,849	0
33	10/24/2024	96.1	9,364	6,188	5,443	377,920	8,198	0
34	10/24/2024	82.8	9,298	2,821	5,102	380,590	8,385	0
35	10/24/2024	92.4	9,594	6,241	4,412	385,470	8,344	0
36	10/25/2024	88.1	9,492	6,013	5,135	378,700	8,427	0
37	10/25/2024	94.5	9,426	6,212	4,421	383,750	8,909	0
38	10/26/2024	87.2	9,254	6,390	5,136	374,690	8,346	0
39	10/26/2024	72.2	7,340	5,726	5,293	379,590	10,450	0
40	10/26/2024	82.9	8,264	5,943	4,462	382,510	8,313	0
41	10/27/2024	90.8	9,417	5,850	5,324	377,180	8,093	0
42	10/27/2024	88.9	8,683	6,047	4,469	365,720	8,145	0
43	10/27/2024	92.4	8,611	5,841	4,585	378,610	8,180	0
44	10/28/2024	86.8	9,371	6,110	5,039	373,440	7,831	0
45	10/28/2024	95.1	9,386	6,042	4,461	380,420	8,072	0
46	10/29/2024	88.8	8,187	5,912	5,242	377,520	8,133	0
47	10/29/2024	94.5	9,609	6,039	5,067	376,750	8,031	0
48	10/29/2024	97.9	9,384	5,973	4,412	372,080	7,991	0
49	10/30/2024	93	8,939	6,159	4,621	373,440	7,987	0
50	10/30/2024	87.6	8,807	6,431	4,934	378,910	8,004	0
51	10/30/2024	91.8	8,978	5,999	4,561	377,630	8,147	0
52	10/30/2024	98.1	9,299	5,830	4,511	380,310	8,112	0
53	10/31/2024	95.1	8,873	5,613	5,029	373,690	8,086	0

FEB 18 2025

STATE OF WV DNR C 206H

ATTACHMENT 2

STIM REPORT

WV Department of
Environmental Protection

STAGE NUM	Stim Date	Ave Pump Rate (BPM)	Ave Treatment	Max Breakdown	ISIP (PSI)	Amount of Proppant (lbs)	Amount of water bbls	Amount of nitrogen/othe
54	10/31/2024	84.2	9,296	6,171	4,815	350,600	7,653	0
55	10/31/2024	98.7	9,076	5,739	4,681	355,500	7,664	0
56	11/1/2024	89.6	8,594	5,689	5,024	354,580	7,548	0
57	11/1/2024	99.2	9,132	5,920	5,333	380,100	8,009	0
58	11/1/2024	97.5	9,055	6,178	4,482	371,760	7,804	0
59	11/2/2024	81.9	7,360	5,578	4,673	374,230	7,955	0
60	11/2/2024	95.5	8,875	5,217	5,449	375,140	8,052	0
61	11/2/2024	97.6	8,871	5,841	4,298	372,420	7,933	0
62	11/3/2024	96.1	8,578	6,275	4,721	381,840	8,233	0
63	11/3/2024	94.4	8,504	6,056	4,810	380,860	7,918	0
64	11/3/2024	96	8,523	6,013	4,912	376,540	7,930	0
65	11/4/2024	96.1	8,378	5,571	5,124	386,840	8,205	0
66	11/4/2024	94.6	8,929	6,152	5,020	383,230	7,953	0
67	11/4/2024	97.6	8,692	5,798	4,667	378,230	7,951	0
68	11/5/2024	96	8,612	5,837	4,512	378,720	7,992	0
69	11/5/2024	96.3	8,616	6,105	5,483	374,020	8,191	0
70	11/5/2024	92.5	8,397	6,053	5,201	378,760	8,249	0
71	11/6/2024	85.2	8,078	5,642	4,677	379,300	9,972	0
72	11/6/2024	94	8,354	5,661	4,463	372,100	8,582	0
73	11/6/2024	94.5	8,111	5,720	4,469	373,598	8,394	0
74	11/7/2024	95.7	8,297	5,769	4,354	374,120	8,401	0
75	11/7/2024	88.3	7,751	5,614	4,347	356,840	8,005	0
76	11/7/2024	95.8	8,240	5,326	4,414	347,320	7,842	0
77	11/7/2024	96.6	8,321	5,821	5,100	354,720	8,023	0
78	11/8/2024	94.9	8,103	6,123	4,412	349,340	7,828	0
79	11/8/2024	90.3	7,677	5,757	4,337	347,240	7,895	0
80	11/8/2024	98.8	8,132	5,410	5,317	354,870	7,957	0
81	11/8/2024	93.5	7,938	6,020	4,450	356,080	7,907	0
82	11/9/2024	91.3	7,831	5,701	4,367	356,740	7,733	0
83	11/9/2024	95.4	7,969	5,424	4,287	354,100	7,805	0
85	11/10/2024	90.6	7,413	5,558	5,083	379,000	8,067	0
86	11/10/2024	94.8	7,849	5,687	7,684	376,070	7,908	0
87	11/10/2024	94.7	7,752	5,651	4,700	371,110	8,002	0
88	11/11/2024	95.3	7,567	5,408	4,196	372,660	7,901	0
89	11/11/2024	96.9	7,811	5,595	4,560	372,010	8,116	0
90	11/11/2024	93.1	7,393	5,766	4,413	374,150	7,986	0
91	11/12/2024	97.7	7,627	5,504	4,276	372,530	8,223	0
92	11/12/2024	92.1	7,308	5,733	4,250	346,830	7,571	0
93	11/12/2024	95.8	7,475	5,736	3,898	348,340	7,416	0
94	11/13/2024	95.8	7,388	5,471	4,369	352,280	7,512	0
95	11/13/2024	96.7	7,669	5,726	4,891	351,940	7,625	0
96	11/13/2024	96.5	7,247	5,311	4,632	349,930	7,543	0
97	11/13/2024	96.3	7,510	5,406	4,414	348,300	7,427	0
98	11/14/2024	95.5	7,347	5,856	4,596	354,990	7,507	0
99	11/14/2024	96	7,105	5,463	4,312	373,060	7,739	0
100	11/14/2024	97.7	7,288	5,469	4,355	372,150	7,871	0
101	11/14/2024	79.8	6,005	5,198	4,727	371,440	8,395	0
102	11/14/2024	96.4	7,182	5,434	4,519	372,990	7,671	0
103	11/15/2024	92.5	7,293	5,678	4,598	374,790	8,075	0
104	11/15/2024	91.5	6,584	5,449	4,425	365,820	7,505	0
105	11/15/2024	96	7,151	5,322	4,415	372,580	7,733	0
106	11/15/2024	96.2	6,987	5,850	4,598	367,250	7,902	0
107	11/15/2024	98	7,073	5,661	4,427	369,430	7,615	0

STATE OF WV DNR C 206H

ATTACHMENT 2

STIM REPORT

STAGE NUM	Stim Date	Ave Pump Rate (BPM)	Ave Treatment	Max Breakdown	ISIP (PSI)	Amount of Proppant (lbs)	Amount of water bbls	Amount of nitrogen/othe
108	11/16/2024	85.8	6,107	5,559	4,270	373,340	8,712	0
109	11/16/2024	97.3	6,831	5,360	4,211	370,910	7,790	0
110	11/16/2024	96.9	6,796	6,087	4,256	375,980	7,673	0
111	11/16/2024	95	6,658	5,627	4,091	363,620	9,848	0
112	11/17/2024	96.7	6,530	5,342	4,318	371,430	7,890	0
113	11/17/2024	96.8	6,576	5,724	4,354	370,560	7,594	0
114	11/17/2024	95	6,407	5,260	4,420	350,360	7,382	0
115	11/17/2024	92.3	6,188	4,950	4,325	369,830	7,728	0
116	11/17/2024	96.5	6,476	5,053	4,581	377,260	7,675	0
117	11/18/2024	97	6,246	4,780	4,458	374,480	7,839	0
118	11/18/2024	91.8	6,034	4,986	4,257	374,060	7,607	0
119	11/18/2024	92.6	6,145	4,526	4,255	370,500	7,241	0
120	11/18/2024	90	5,897	4,525	4,253	373,220	7,311	0

RECEIVED
Office Of Oil and Gas
FEB 18 2025
WV Department of
Environmental Protection

API 47- 009 - 00341 Farm name State of WV DNR C BRK Well number 206H

PRODUCING FORMATION(S)

DEPTHS

Marcellus 5564 TVD 5935 MD

RECEIVED
Office Of Oil and Gas
FEB 18 2025
WV Department of
Environmental Protection

Please insert additional pages as applicable.

GAS TEST ☐ Build up ☐ Drawdown ☐ Open Flow OIL TEST ☐ Flow ☐ Pump

SHUT-IN PRESSURE Surface 1017 psi Bottom Hole 3,514 psi DURATION OF TEST 24 hrs

OPEN FLOW Gas 13,791 mcfpd Oil 1,763 bpd NGL _____ bpd Water 1,984 bpd GAS MEASURED BY ☐ Estimated ☒ Orifice ☐ Pilot

LITHOLOGY/ FORMATION	TOP DEPTH IN FT NAME TVD	BOTTOM DEPTH IN FT TVD	TOP DEPTH IN FT MD	BOTTOM DEPTH IN FT MD	DESCRIBE ROCK TYPE AND RECORD QUANTITY AND TYPE OF FLUID (FRESHWATER, BRINE, OIL, GAS, H ₂ S, ETC)
	0		0		
	SEE ATTACHMENT 3				

Please insert additional pages as applicable.


Drilling Contractor SWN Drilling Company
Address PO Box 12395 City Spring State TX Zip 77391-2359

Logging Company Baker Hughes
Address 9110 Grogans Mill Road City The Woodlands State TX Zip 77380

Cementing Company Schlumberger
Address 110 Schlumberger Drive City Sugar Land State TX Zip 77478

Stimulating Company SWN Drilling Company
Address PO Box 12395 City Spring State TX Zip 77391

Please insert additional pages as applicable.

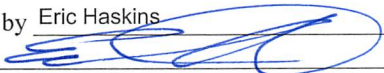Completed by Eric Haskins Telephone 570 290-8837
Signature  Title Regulatory Manager Date 2/11/2025

Submittal of Hydraulic Fracturing Chemical Disclosure Information Attach copy of FRACFOCUS Registry

07/25/2025

Hydraulic Fracturing Fluid Product Component Information Disclosure

Job Start Date:	10/10/2024
Job End Date:	11/18/2024
State:	West Virginia
County:	Brooke
API Number:	47-009-00341-00-00
Operator Name:	Southwestern Energy
Well Name and Number:	STATE OF WV DNR C BRK 206H
Latitude:	40.302278
Longitude:	-80.537717
Datum:	NAD83
Federal Well:	NO
Indian Well:	NO
True Vertical Depth:	5943
Total Base Water Volume (gal)*:	41421948
Total Base Non Water Volume:	162583.6



Water Source	Percent
Surface Water, < 1000TDS	86.25%
Produced Water	13.75%

RECEIVED
Office Of Oil and Gas
FEB 18 2025
WV Department of
Environmental Protection

Hydraulic Fracturing Fluid Composition:

Trade Name	Supplier	Purpose	Ingredients	Chemical Abstract Service Number (CAS #)	Maximum Ingredient Concentration in Additive (% by mass)**	Maximum Ingredient Concentration in HF Fluid (% by mass)**	Comments
Base Water	Operator	Base Fluid					
CX 810	SWN Well Services	Friction Reducer					
FERRIPLEX 80	SWN Well Services	Iron Control Agent					
FSTI-CI-02	SWN Well Services	Corrosion Inhibitor					
Hydrochloric Acid	SWN Well Services	Solvent					
PLEXAID 655NM	SWN Well Services	Scale Inhibitor					
PLEXSLICK 930	SWN Well Services	Friction Reducer					

07/25/2025

Sand	SWN Well Services	Proppant	RECEIVED Office Of Oil and Gas				
TOLCIDE 4FRAC	SWN Well Services	Biocide	FEB 18 2025 WV Department of Environmental Protection				
Items above are Trade Names. Items below are the individual ingredients.							
			Water	7732-18-5	100.00000	88.71254	
			Crystalline Silica, Quartz	14808-60-7	100.00000	11.11366	
			HYDROCHLORIC ACID	7647-01-0	37.00000	0.10063	
			Copolymer of 2-propenamide	Proprietary	60.00000	0.03201	
			Isoalkanes	64742-47-8	30.00000	0.02197	
			Phosphonium, tetrakis(hydroxymethyl)-, sulfate (2:1)	55566-30-8	50.00000	0.00484	
			Ethoxylated Tridecanol	Proprietary	2.50000	0.00366	
			Surfactant	Proprietary	3.00000	0.00288	
			Hydrotreated light distillate	64742-47-8	30.00000	0.00271	
			Quaternary ammonium compounds, benzyl-C12-16- alkyldimethyl, chlorides	68424-85-1	10.00000	0.00097	
			Oleic Acid Diethanolamide	93-83-4	5.00000	0.00068	
			Sodium erythorbate	6381-77-7	98.00000	0.00057	
			Ethanol	64-17-5	1.50000	0.00048	
			Diethylenetriamine penta (methylene phosphonic acid)	15827-60-8	10.00000	0.00046	
			Ethylene glycol	107-21-1	40.00000	0.00042	
			Cinnamaldehyde	104-55-2	19.00000	0.00020	
			1-Octanol	111-87-5	19.00000	0.00020	
			1-Decanol	112-30-1	19.00000	0.00020	
			N,N-Dimethylformamide	68-12-2	19.00000	0.00020	
			Triethyl phosphate	78-40-0	19.00000	0.00020	
			Poly(oxy-1,2-ethanediyl), .alpha.- (nonylphenyl)-.omega.- hydroxy-	9016-45-9	19.00000	0.00020	
			2-Butoxyethanol	111-76-2	10.00000	0.00010	
			Isopropyl alcohol	67-63-0	10.00000	0.00010	
			Tar bases, quinoline derivatives, benzyl chloride- quaternized	72480-70-7	10.00000	0.00010	

* Total Water Volume sources may include various types of water including fresh water, produced water, and recycled water

** Information is based on the maximum potential for concentration and thus the total may be over 100%

07/25/2025

Note: For Field Development Products (products that begin with FDP), MSDS level only information has been provided.
Ingredient information for chemicals subject to 29 CFR 1910.1200(i) and Appendix D are obtained from suppliers Material Safety Data Sheets (MSDS)

RECEIVED
Office Of Oil and Gas

FEB 18 2025

WV Department of
Environmental Protection

07/25/2025

Latitude: 40°20'00"

SURFACE HOLE 10515'

JACKSON SURVEYING
INC.

2413 EAST PIKE ST. # 112
Clarksburg, WV 26302
304-623-5851

Latitude: 40°15'00" BOTTOM HOLE

2,727'

BOTTOM HOLE 5091'

SURFACE HOLE 11313'

Longitude: 80°30'00"

BOTTOM HOLE 5091'

SURFACE HOLE 11313'


Longitude: 80°30'00"

SURFACE HOLE LOCATION (SHL):
UTM (NAD83, ZONE 17, METERS):
NORTHING: 4,461,410.588
EASTING: 539,285.828
LANDING POINT (LPL):
UTM (NAD83, ZONE 17, METERS):
NORTHING: 4,461,207.847
EASTING: 538,900.645
BOTTOM HOLE LOCATION (BHL):
UTM (NAD83, ZONE 17, METERS):
NORTHING: 4,454,069.099
EASTING: 541,692.604



LINE	BEARING	DISTANCE	DESCRIPTION	MONUMENT
L1	N 35°46'46" W	1029.72'	SHL TO LANDMARK	2" IRON PIPE FOUND
L2	N 66°32'19" W	1310.56'	SHL TO LANDMARK	STONE FOUND
L5	S 27°42'32" E	94.99'	AZL2 TO AZL3	
L7	S 15°50'21" E	286.00'	AZL4 TO AZL5	
L9	S 20°55'07" E	94.00'	AZL7 TO AZL8	
LINE	BEARING	DISTANCE	CURVE LENGTH	DESCRIPTION
L3	S 63°05'04" W	1411.84'	1975.37'	SHL TO LP
L4	S 25°05'52" E	476.62'	476.97'	AZL1 TO AZL2
L6	S 21°32'34" E	761.94'	763.94'	AZL3 TO AZL4
L8	S 18°07'41" E	366.07'	366.28'	AZL5 TO AZL6



GRID NORTH
UTM, NAD83 DATUM, ZONE 17, US FT

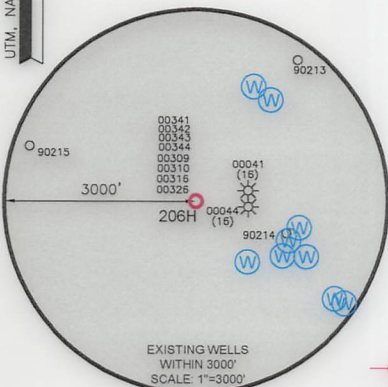

SURFACE HOLE LOCATION (SHL):
UTM (NAD83, ZONE 17, METERS):
NORTHING: 4,461,410.696
EASTING: 539,285.741
LANDING POINT (LPL):
UTM (NAD83, ZONE 17, METERS):
NORTHING: 4,461,215.894
EASTING: 538,902.028
BOTTOM HOLE LOCATION (BHL):
UTM (NAD83, ZONE 17, METERS):
NORTHING: 4,454,069.491
EASTING: 541,701.734

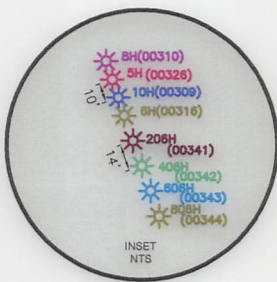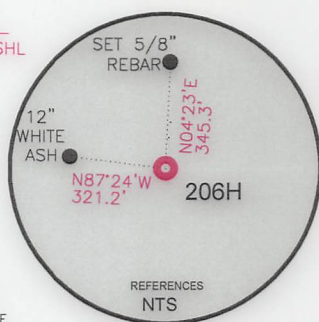

WELL RESTRICTIONS

1. NO OCCUPIED DWELLINGS > 2500 SQ FT. WITHIN 625 FEET OF CENTER OF PAD.
2. NO AGRICULTURE BUILDINGS > 2500 SQ FT. WITHIN 625 FEET OF CENTER OF PAD.
3. NO WATER WELLS OR DEVELOPED SPRINGS ARE WITHIN 250 FEET OF PROPOSED WELL.
4. NO PERENNIAL STREAMS, LAKES, PONDS, OR RESERVOIRS WITHIN 100 FEET OF THE LIMITS OF DISTURBANCE.
5. NO NATURALLY PRODUCING TROUT STREAM WITHIN 300 FEET OF LIMITS OF DISTURBANCE.
6. NO GROUND INTAKE OR PUBLIC WATER SUPPLY WITHIN 1000 FEET OF WELL PAD, LIMITS OF DISTURBANCE, E & S CONTROLS OR PUBLIC WATER SUPPLY.


NOTES ON SURVEY

1. SURFACE AND ROYALTY OWNER INFORMATION AND THEIR BOUNDARIES SHOWN HEREON WERE PLOTTED FROM DEEDS AND/OR TAX PARCEL MAPS PROVIDED BY CLIENT AND/OR FIELD LOCATIONS.
2. THIS PLAT DOES NOT REPRESENT A BOUNDARY SURVEY OF THE PARCELS SHOWN HEREON.
4. ALL INSETS ARE GRID NORTH UNLESS OTHERWISE DEPICTED.

I, THE UNDERSIGNED, HEREBY CERTIFY THAT THIS PLAT IS CORRECT TO THE BEST OF MY KNOWLEDGE AND BELIEF AND SHOWS ALL THE INFORMATION REQUIRED BY LAW AND REGULATIONS ISSUED AND PRESCRIBED BY THE DEPARTMENT OF ENVIRONMENTAL PROTECTION.

P.S. 708

David L Jackson

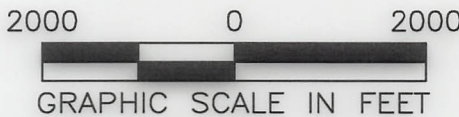

COMPANY: **SWN** **SWN** ^R/_A ⁺/_V ⁺/₊
Production Company, LLC Production Company™



(+) DENOTES LOCATION OF WELL ON UNITED STATES TOPOGRAPHIC MAPS
WVDEP
OFFICE OF OIL & GAS
601 57TH STREET
CHARLESTON, WV 25034

MINIMUM DEGREE OF ACCURACY: 1/200
PROVEN SURVEY SOURCE OF GRADE GPS ELEVATION: (NAVD 88, US FT)

STATE OF WV DNR C BRK
OPERATOR'S WELL #: 206H
API WELL #: 47 009 00341
STATE COUNTY PERMIT

WELL TYPE: OIL ☐ WASTE DISPOSAL ☐ PRODUCTION ☒ DEEP ☐ GAS ☒ LIQUID INJECTION ☐ STORAGE ☐ SHALLOW ☒
WATERSHED: NORTH FORK CROSS CREEK - CROSS CREEK (HUC-10) ELEVATION: 989.0'
DISTRICT: CROSS CREEK COUNTY: BROOKE QUADRANGLE: STEUBENVILLE EAST, WV
SURFACE OWNER: STATE OF WEST VIRGINIA, BUREAU OF COMMERCE, DIVISION OF NATURAL RESOURCES, PUBLIC LAND CORPORATION ACREAGE: ±83.858
OIL & GAS ROYALTY OWNER: STATE OF WEST VIRGINIA, BUREAU OF COMMERCE, DIVISION OF NATURAL RESOURCES, PUBLIC LAND CORPORATION ACREAGE: ±83.858
DRILL ☐ DRILL DEEPER ☐ REDRILL ☐ FRACTURE OR STIMULATE ☐ PLUG OFF OLD FORMATION ☐ PERFORATE NEW FORMATION ☐
CONVERT ☐ PLUG & ABANDON ☐ CLEAN OUT & REPLUG ☐ OTHER CHANGE ☐ (SPECIFY) ASDRILLED 07/25/2025
TARGET FORMATION: MARCELLUS ESTIMATED DEPTH: 5,945' TMD

WELL OPERATOR: SWN PRODUCTION COMPANY, LLC DESIGNATED AGENT: BRITTANY WOODY
ADDRESS: 1300 FORT PIERPONT ROAD, SUITE 200 ADDRESS: 1300 FORT PIERPONT ROAD, SUITE 200
CITY: MORGANTOWN STATE: WV ZIP CODE: 26508 CITY: MORGANTOWN STATE: WV ZIP CODE: 26508

LEGEND:	REVISIONS:	DATE:
PROPOSED SURFACE HOLE / BOTTOM HOLE	DRILLING UNIT	10-02-2024
EXISTING / PRODUCING WELLHEAD	LEASE BOUNDARY	DRAWN BY: J. COCKERHAM
LPL: LANDING POINT LOCATION	ASDRILLED PATH	SCALE: 1" = 3000'
EXISTING WATER WELL	PROPOSED PATH	DRAWING NO:
EXISTING SPRING		WELL LOCATION PLAT






NOTES ON SURVEY	
1. SURFACE AND ROYALTY OWNER INFORMATION AND THEIR	
BOUNDARIES SHOWN HEREON WERE PLOTTED FROM DEEDS AND/OR	
TAX PARCEL MAPS PROVIDED BY CLIENT AND/OR FIELD LOCATION	
2. THIS PLAT DOES NOT REPRESENT A BOUNDARY SURVEY OF THE	
PARCELS SHOWN HEREON.	
3. ALL INSETS ARE GRID NORTH UNLESS OTHERWISE DEPICTED.	
4. THE UNDERSIGNED, HEREBY CERTIFY THAT THIS PLAT IS	
CORRECT TO THE BEST OF MY KNOWLEDGE AND BELIEF AND SHOWS	
ALL THE INFORMATION REQUIRED BY LAW AND REGULATIONS ISSUED	
AND PRESCRIBED BY THE DEPARTMENT OF ENVIRONMENTAL PROTECTION.	
1. NO OCCUPIED DWELLINGS > 2500 FT. WITHIN 625 FEET OF	
CENTER OF PAD.	
2. NO AGRICULTURE BUILDINGS > 2500 FT. WITHIN 625 FEET OF	
CENTER OF PAD.	
3. NO WATER WELLS OR DEVELOPED SPRINGS ARE WITHIN 250 FEET	
OF PROPOSED WELL.	
4. NO PERENNIAL STREAMS, LAKES, PONDS, OR RESERVOIRS WITHIN	
100 FEET OF THE LIMITS OF DISTURBANCE.	
5. NO NATURALLY PRODUCING TROUT STREAM WITHIN 300 FEET OF	
LIMITS OF DISTURBANCE.	
6. NO GROUND INTAKE OR PUBLIC WATER SUPPLY WITHIN 1000 FEET	
OF WELL PAD. LIMITS OF DISTURBANCE, E & S CONTROLS OR	
PUBLIC WATER SUPPLY.	

WELL RESTRICTIONS	
1. NO OCCUPIED DWELLINGS > 2500 FT. WITHIN 625 FEET OF	
CENTER OF PAD.	
2. NO AGRICULTURE BUILDINGS > 2500 FT. WITHIN 625 FEET OF	
CENTER OF PAD.	
3. NO WATER WELLS OR DEVELOPED SPRINGS ARE WITHIN 250 FEET	
OF PROPOSED WELL.	
4. NO PERENNIAL STREAMS, LAKES, PONDS, OR RESERVOIRS WITHIN	
100 FEET OF THE LIMITS OF DISTURBANCE.	
5. NO NATURALLY PRODUCING TROUT STREAM WITHIN 300 FEET OF	
LIMITS OF DISTURBANCE.	
6. NO GROUND INTAKE OR PUBLIC WATER SUPPLY WITHIN 1000 FEET	
OF WELL PAD. LIMITS OF DISTURBANCE, E & S CONTROLS OR	
PUBLIC WATER SUPPLY.	



JACKSON SURVEYING
INC.
2413 EAST PIKE ST. # 112
Clarksburg, WV 26302
304-623-5851

GRID NORTH
UTM, NAD83 DATUM, ZONE 17, US FT



I, THE UNDERSIGNED, HEREBY CERTIFY THAT THIS PLAT IS
CORRECT TO THE BEST OF MY KNOWLEDGE AND BELIEF AND SHOWS
ALL THE INFORMATION REQUIRED BY LAW AND REGULATIONS ISSUED
AND PRESCRIBED BY THE DEPARTMENT OF ENVIRONMENTAL PROTECTION.

P.S. 708 *David Jackson*



REVISIONS:

COMPANY:

SWN
Production Company, LLC

SWN
Production Company™
B-C-V+®

OPERATOR'S STATE OF WV DNR C BRK		API:	DATE: 10-02-2024	
WELL #:		206H	DRAWN BY: COCKERHAM	
DISTRICT:		CROSS CREEK	SCALE: N/A	
COUNTY:		BROOKE	DRAWING NO:	
STATE:		WV	WELL LOCATION PLAT 2	

JACKSON SURVEYING
INC.





I, THE UNDERSIGNED, HEREBY CERTIFY THAT THIS PLAT IS
CORRECT TO THE BEST OF MY KNOWLEDGE AND BELIEF AND SHOWS
ALL THE INFORMATION REQUIRED BY LAW AND REGULATIONS ISSUED
AND PRESCRIBED BY THE DEPARTMENT OF ENVIRONMENTAL PROTECTION.

David Jackson

07/25/2025

REVISIONS:		COMPANY:	
DATE: 10-03-2024		DATE: 10-03-2024	
DRAWN BY: COCKERHAM		DRAWN BY: COCKERHAM	
SCALE: N/A		SCALE: N/A	
DRAWING NO:		DRAWING NO:	
WELL LOCATION PLAT 2		WELL LOCATION PLAT 2	
WELL #:		WELL #:	
OPERATOR'S STATE OF WV DNR C BRK		OPERATOR'S STATE OF WV DNR C BRK	
APL: 47-009-00341		APL: 47-009-00341	
STATE: WV		STATE: WV	
COUNTY: BROOKE		COUNTY: BROOKE	
DISTRICT: CROSS CREEK		DISTRICT: CROSS CREEK	

JACKSON SURVEYING
INC.
2413 EAST PIKE ST. # 112
Clarksburg, WV 26302
304-623-5851

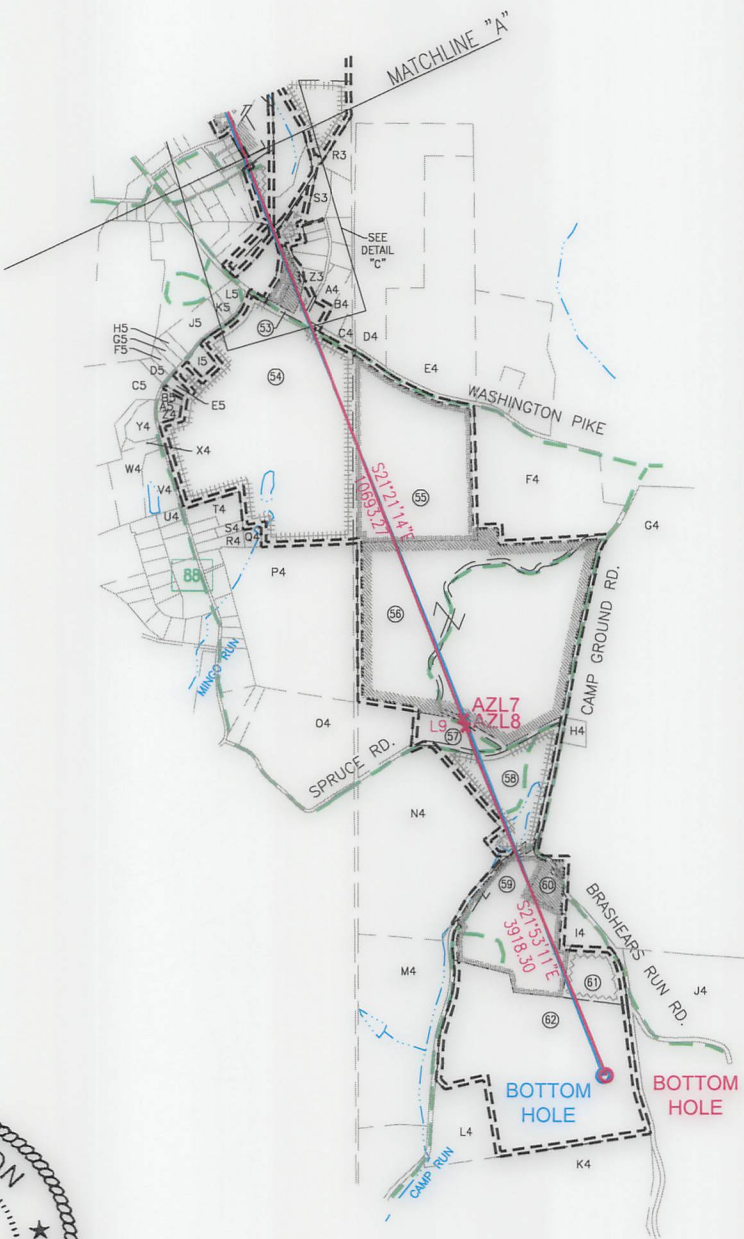

I, THE UNDERSIGNED, HEREBY CERTIFY THAT THIS PLAT IS
CORRECT TO THE BEST OF MY KNOWLEDGE AND BELIEF AND SHOWS
ALL THE INFORMATION REQUIRED BY LAW AND REGULATIONS ISSUED
AND PRESCRIBED BY THE DEPARTMENT OF ENVIRONMENTAL PROTECTION.


P.S. 708

David L Jackson

07/25/2025

REVISIONS:		COMPANY:		DATE: 10-02-2024	
		SWN		DRAWN BY: COCKERHAM	
		Production Company, LLC		SCALE: N/A	
		OPERATOR'S STATE OF WV DNR C BRK		DRAWING NO:	
		WELL #: 206H		WELL LOCATION PLAT 3	
		DISTRICT: CROSS CREEK			
		COUNTY: BROOKE			
		STATE: WV			
		API: 47-009-00341			

GRID NORTH
MTU, 183400, 17. 25 FT

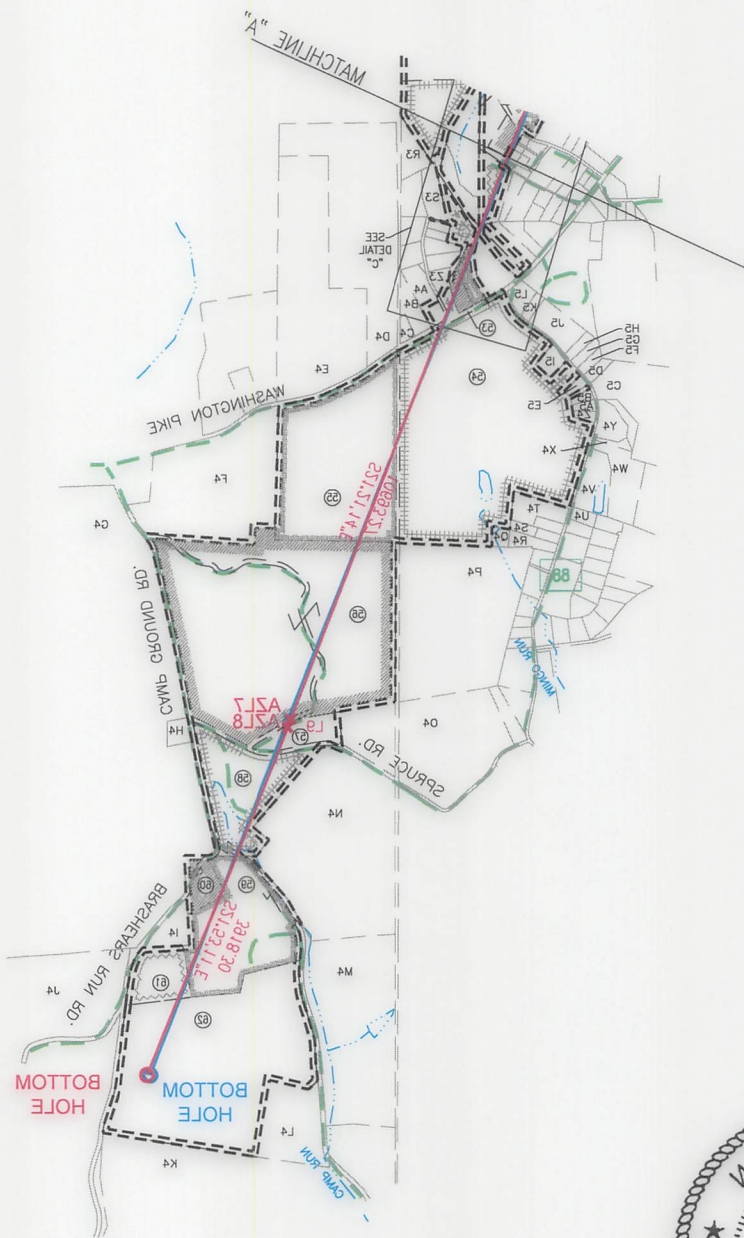

David L. Jordan

COMPANY:	REVISIONS:
OPERATOR:	
WELL #:	
DISTRICT:	
CROSS CR	

Production Company **SW2** $\frac{R_s}{A} \rightarrow V^{\frac{R_s}{A}} +$

DISTRICT:	CROSS CREEK	COUNTY:	BROOKE	STATE:	WV
WELL #:	206H	API: 47-008-00341			
OPERATOR'S: STATE OF WV DIR C BRK					
DATE: 10-02-2024					
DRAWING NO: 3					
WELL LOCATION PLAT 3					
SCALE: N/A					
DRAWN BY: COCKEYHAM					


TUESDAY FEBRUARY 11 2025 08:18AM
Z:\2025 BACKUPS\1-10-25 DL\2N\STATE OF WA DIR C BRK\WELL PLATS\WELL PLAT\206H\FINAL\WA DIR C 10-03-24\WA DIR C 206H WELL PLAT 10-03-24.DWG

JACKSON SURVEYING
INC.
2413 EAST PIKE ST. # 112
Clarksburg, WV 26302
304-623-5851


DETAIL "A"



DETAIL "B"

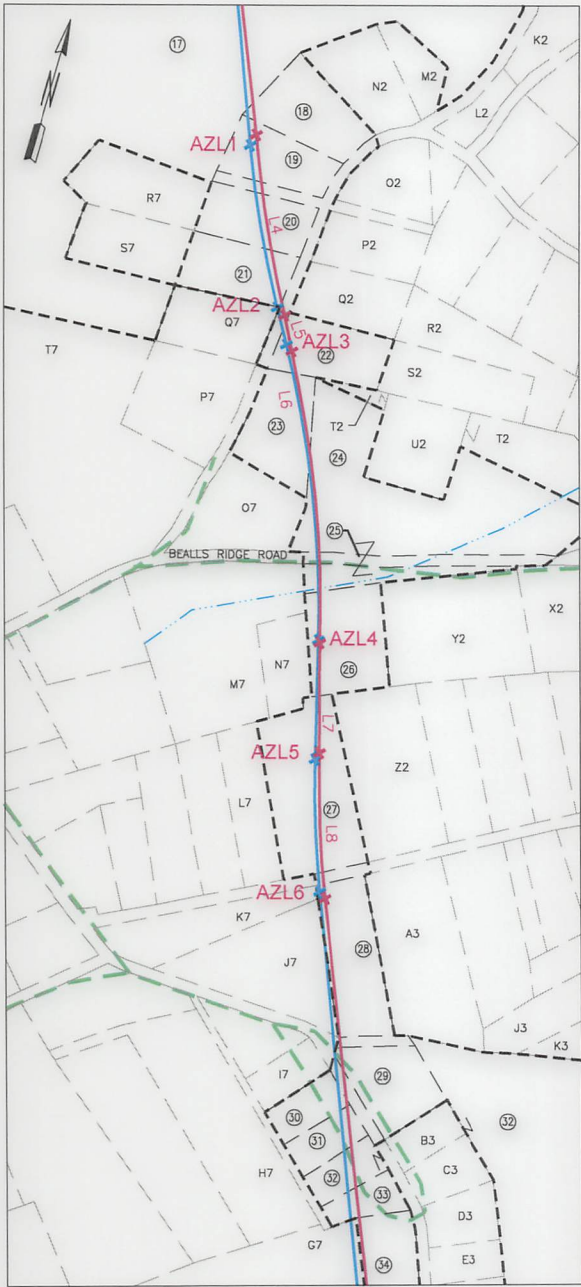

DETAIL "C"

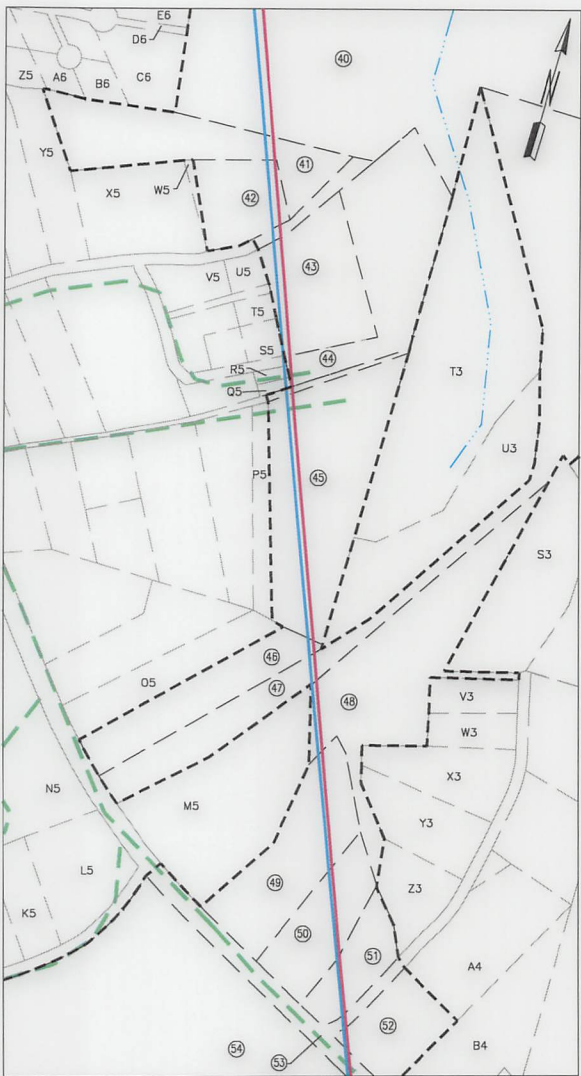

DETAIL "D"



I, THE UNDERSIGNED, HEREBY CERTIFY THAT THIS PLAT IS
CORRECT TO THE BEST OF MY KNOWLEDGE AND BELIEF AND SHOWS
ALL THE INFORMATION REQUIRED BY LAW AND REGULATIONS ISSUED
AND PRESCRIBED BY THE DEPARTMENT OF ENVIRONMENTAL PROTECTION.

P.S. 708

David L Jackson

07/25/2025

REVISIONS:

COMPANY:

SWN

Production Company, LLC

SWN

Production Company™

OPERATOR'S STATE OF WV DNR C BRK

WELL #: 206H

DISTRICT:
CROSS CREEK

COUNTY:
BROOKE

API:
47-009-00341

STATE:
WV

DATE: 10-02-2024


DRAWN BY: COCKERHAM

SCALE: N/A

DRAWING NO:

WELL LOCATION PLAT 4

DETAIL "B"

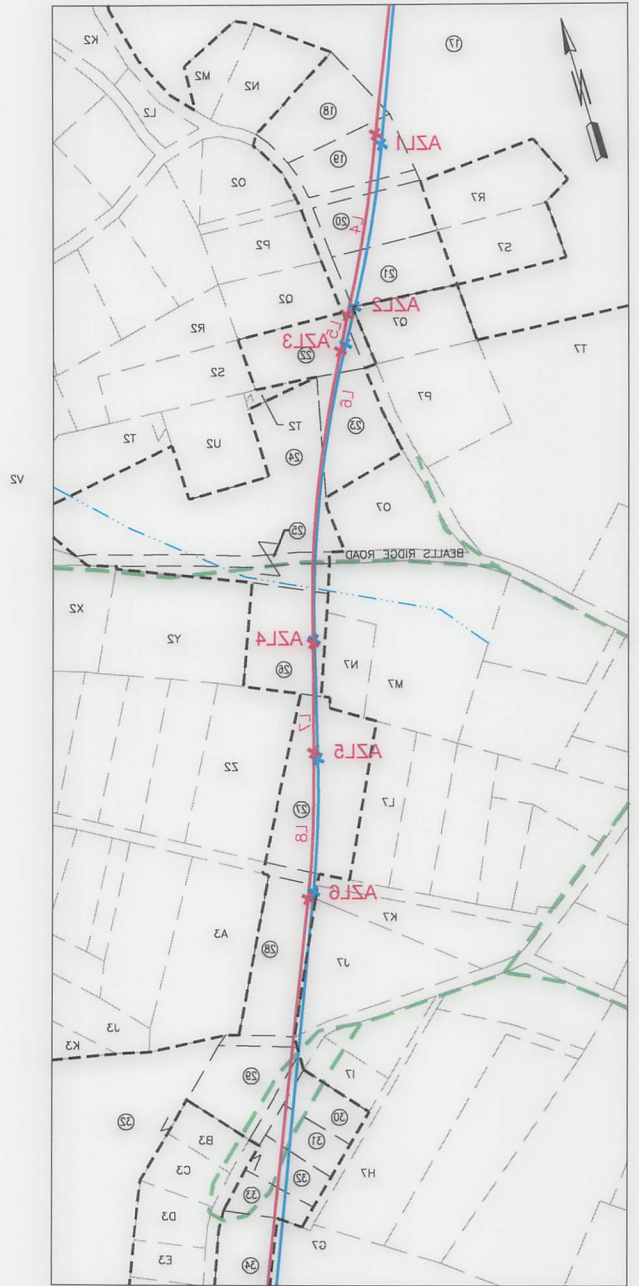

David L. Jackson

07/25/2025

SWN
Production Company, LLC

$$V = \frac{R_2}{A} + V_0$$

DRAWING NO: _____
WELL LOCATION PLAT A

TUESDAY FEBRUARY 11 2025 08:19AM
Z:\2025 BACKUPS\1-10-25 D1\2WN\STATE OF WA DIR C BRK\WELL PLATS\WELL PLAT\208H\FINAL\WA DIR C 10-03-24\WA DIR C 208H WELL PLAT 10-03-24.DWG

JACKSON SURVEYING
INC.
2413 EAST PIKE ST. # 112
Clarksburg, WV 26302
304-623-5851

	WELL BORE TRACTS	
TRACT	SURFACE OWNER (S) / ROYALTY OWNER (R)	TAX PARCEL
1	WEST VIRGINIA ST OF BUREAU OF COMM DIV OF NAT RES PB LD CORP (S/R)	4-CC20-06
TRACT	SURFACE OWNER (S)	TAX PARCEL
2	WEST VIRGINIA ST OF BUREAU OF COMM DIV OF NAT RES PB LD CORP (S)	4-CC19-169
3	GALIANO LINDY L (S)	4-CC19-170
4	NORFOLK & WESTERN RAILWAY CO (S)	4-C19K-18
5	WEST VIRGINIA ST OF BUREAU OF COMM DIV OF NAT RES PB LC CORP (S)	4-CC23-325
6	CROSS RAYMOND S DENNIS P & BUTLER KATHRYN R (S)	4-CC24-13
7	WALLACE RICHARD L & TRACEY (S)	4-CC24-14
8	LYNCH THERESA ANN(LE-CHARLES & ELLEN THORNE (S)	4-CC24-16
9	COLLINS RANDY L JR & AMY R (SURVIVORSHIP (S)	4-CC24-17
10	PEHANICH DIANA LYNN TOD MICHELLE ALLMAN (S)	4-CC24-15
11	TAYLOR BUDDY JR (S)	4-CC24-46
12	THOMPSON RANDALL L (S)	4-CC24-45
13	FILLINGER JOHN O (S)	4-CC24-44
14	WHITE ROGER DALE (S)	4-CC24-32
15	MCCLOUD PAULETTE (S)	4-CC24-33
16	BRADLEY GEORGE L (S)	4-CC24-55
17	JOHNS LESLIE J & MELLISA J (JTWS) (S)	4-CC24-99
18	BRADY RALPH A & KIM (SURV) (S)	4-CC24-90
19	FERGUSON BRIAN L & NANCY J (SURV) (TOD) (S)	4-CC24-89
20	HUFFNER JAMES E & PATRICIA (S)	4-CC24-88
21	CECCHINI CHRISTOPHER (S)	4-CC24-86
22	FERGUSON TODD & LISA (SURV) (S)	4-CC24-120
23	CECCHINI CHRISTOPHER L (S)	4-CC24-124
24	BARCHIESI GEORGE A & PAMELA J (SURV) (S)	4-CC24-125
25	STATE OF WEST VIRGINIA DEPARTMENT OF TRANSPORTATION, DIVISION OF HIGHWAYS (S)	BUCKEY HILL ROAD
26	HURLEY VALERIE E & ROBERT L BERGMAN (S)	4-CC29-25
27	MCCANN ROBERT H & CANDACE A(SURV) (S)	4-CC29-35
28	FERDA WILLIAM M & CYNTHIA A (S)	4-CC29-44
29	CLEM ROGER L & MILDRED O JTWS (TUD) (S)	4-CC29-63
30	RINEY DOUGLAS G & BLANCA A (SURV) (S)	4-CC29-50
31	RINEY DOUGLAS G & BLANCA A (SURV) (S)	4-CC29-51
32	CYPHERT DEBRA-1/2;FAIR MATTHEW 1/4;BRUFFY SUSAN-1/4 (S)	4-CC29-57
33	CYPHERT DEBRA R (S)	4-CC29-57.2
34	KRAFT JEREMIAH ET AL (S)	4-CC29-52
35	MUSCEDERE EMILIO A & JUDITH A (S)	4-CC29-53
36	CAMPBELL ERIC W (S)	4-CC29-117
37	YOUNG ROBERT L (S)	4-CC29-132
38	AUBER ARTHUR D & GERALDINE A (S)	4-CC29-139
39	AUBER ARTHUR D & GERALDINE A (SURV) (S)	4-CC29-142
40	FRESHWATER ROBERT LEE (S)	4-CC29-134
41	CLAMPITT NORMAN C & JEANETTA K (SURV) (S)	4-CC29-190
42	CLAMPITT NORMAN C & JEANETTA K (SURV) (S)	4-CC29-191
43	PACKER JAMI DANIELLE (S)	4-CC29-192.1
44	PACKER JAMI (S)	4-CC29-192
45	PLATTER MARVIN E JR & KATHY A (SURV) (S)	4-CC29-212
46	KLAGES KEITH C (S)	4-CC29-217
47	STEWART RUTH ANN 1/2; JACKSON MADELON DAWN 1/2 TOD (S)	4-CC29-194
48	MINOR LISA (S)	4-CC29-194.1
49	RUDLAND JOHN (S)	4-CC29-220
50	LYLE MONICA T (S)	4-CC29-221
51	RASZ MICHAEL RAYMOND (S)	4-CC29-221.1
52	MINOR LISA M (S)	4-CC29-233
53	WEST VIRGINIA DEPARTMENT OF TRANSPORTATION,	STATE ROUTE 27 A/K/A
54	HIGHLAND SPRINGS GOLF COURSE LLC (S)	3-B29-18
55	HIGHLAND SPRINGS GOLF COURSE (S)	370-007-06
56	BROWNLEE LAND VENT LP (S)	370-007-05
57	CUNNINGHAM PAUL A (S)	370-007-04
58	BELLVIEW CAMP MEETING ASSO DAVID STONER (TREASURER) (S)	370-007-03
59	BROWNLEE LAND VENT (S)	370-011-07
60	SENG RONALD BERNARD & JOANNE ALICE (S)	370-011-06
61	RUSH GARY (S)	370-011-08
62	TAYLOR 2016 REVOC TRUST KENNETH LEE & ANN MARIE TRUSTEES (S)	370-011-02

07/25/2025

REVISIONS:	COMPANY:				SWN Production Company, LLC SWN Production Company™	
	OPERATOR'S		STATE OF WV DNR C BRK		API:	DATE: 10-02-2024
	WELL #:		206H		47-009-00341	DRAWN BY: COCKERHAM
	DISTRICT:		COUNTY:		STATE:	SCALE: N/A
	CROSS CREEK		BROOKE		WV	DRAWING NO:
						WELL LOCATION PLAT 5



07/25/2025

JACKSON SURVEYING
INC.
2413 EAST PIKE ST. # 112
Clarksburg, WV 26302
304-623-5851

ADJOINING OWNERS TABLE		
TRACT	SURFACE OWNER	TAX PARCEL
A	BREEN SUSAN D & DENNIS M	4-CC20-22
B	COLLIERS SPORTSMAN CLUB	4-CC20-21
C	ROUSE WILLIAM MORGAN & DORIS J	4-CC20-20
D	BLACK LINDY L	4-CC20-7
E	GALIANO LINDY L &	4-CC20-19.1
F	CARTER EDWARD L & DEBORAH C JTWS	4-CC20-18
G	CARTER EDWARD L	4-CC20-17
H	GALIANO ERIC T	4-CC20-16
I	GALIANO ERIC T	4-CC20-14
J	GALIANO ERIC T	4-CC20-19
K	MCCONNELL KEVIN	4-CC20-11
L	MCCONNELL BARBARA J	4-CC20-10
M	PRONCHIK SUSAN KAY	4-CC20-8
N	BERNARDINI JUDITH ANN	4-CC20-9
O	BERNARDINI MICHAEL LEE & JULIE LYNN (SURV)	4-CC20-44
P	NORFOLK & WESTERN RAILWAY CO	4-C24B-29
Q	NICKOLES 3 LLC	4-CC20-33
R	WEST VIRGINIA ST OF BUREAU OF COMM DIV OF NAT RES PB LD CORP	4-CC24-3
S	CORK BRANDON & LORETTA SANCHEZ	4-CC24-8
T	VAUGHN MARK E & LISA A (SURV)	4-CC24-9
U	MIHLBAUER DAVID A & TERI L	4-CC24-10
V	PETTRY OTTIS T	4-CC24-12
W	FILLINGER JOHN O	4-CC24-43
X	MCCLOUD JIM R & MARTHA SURV	4-CC24-42
Y	MCCLOUD JIM R & MARTHA SURV	4-CC24-41
Z	MCCLOUD JIM R & MARTHA SURV	4-CC24-40
A2	SMITH WICKIE L	4-CC24-39
B2	HUNTER WILLIAM R & GLORIA J	4-CC24-38
C2	CRAWFORD BERNARD E (TOD) & WILMA L	4-CC24-37
D2	CRAWFORD BERNARD E (TOD) & WILMA A	4-CC24-36
E2	SHINGLE EVA & RAYMOND	4-CC24-35
F2	SHINGLE EVA RAYMOND	4-CC24-34
G2	OBER MICHAEL	4-CC24-7
H2	SMITH DEAN	4-CC24-98
I2	MCFADDEN MICHAEL K & SHARON (SURV)	4-CC24-93
J2	CIPRIANI MICHAEL J	4-CC24-142
K2	CIPRIANI MICHAEL J	4-CC24-141
L2	EARNEST JACK & LESLIE M (SURV)	4-CC24-138
M2	FARRELL KEVIN M & HEIDI J (SURV)	4-CC24-92
N2	FARRELL KEVIN M & HEIDI J (SURV)	4-CC24-91
O2	MARKS EDWARD ROBERT III & TONI JO (SURV)	4-CC24-117
P2	SICURELLA PAUL J & LEA M (SURV)	4-CC24-118
Q2	BOOTH JERRY M & DEBRA D (SURV)	4-CC24-119
R2	BOOTH JERRY MARTIN & DEBRA DEAN (JTWS)	4-CC24-99.9
S2	FERGUSON TODD P & LISA (SURV)	4-CC24-99.1
T2	BARCHIESI GEORGE A & PAMELA J (SURV)	4-CC24-122
U2	RUSH JAMES H & JANE A (SURV)	4-CC24-121
V2	JOHNS LESLIE J & MELLISA J (JTWS)	4-CC24-99
W2	JONES PATRICK	4-CC24-129.1
X2	MITCHELL JESSE ETAL (LE-EUGENE JR & MARGARET MITCHELL)	4-CC24-126
Y2	HARTER MELISSA K & CHRISTOPHER J	4-CC29-26
Z2	SHERNISKY THOMAS J	4-CC29-36
A3	HICKS RONALD LEE & DEBRA V	4-CC29-43
B3	KUSICH GARY & PATRICIA ELAINE	4-CC29-62
C3	KUSICH GARY & PATRICIA ELAINE	4-CC29-61
D3	FERDA BRIAN T & VI-EVA (SURV)	4-CC29-60
E3	FERDA BRIAN T & VI-EVA (SURV)	4-CC29-59
F3	FERDA BRIAN T & VI-EVA (SURV)	4-CC29-58
G3	MUSCEDERE EMILIO A & JUDITH A	4-CC29-54
H3	LYLE JOHN H JR & MARY CATHERINE	4-CC29-55
I3	LYLE JOHN H JR & MARY C (SURV)	4-CC29-56
J3	NEWTON ROBERT R JR	4-CC29-41.1
K3	PAPSON NATALIE J	4-CC29-41
L3	HONE MARK A & LAUREN M (SURV)	4-CC29-39.2
M3	MITCHELL ARLEY R & NANCY E (SURV)	4-CC29-39.11
N3	MCCLAINE DAVID H & KAREN (SURV)	4-CC29-39.7
O3	CATTARUZZA ELLEN M	4-CC29-39
P3	BROWNLEE LAND VENTURES	370-001-15
Q3	STATE LINE REAL EST LLC	370-04-01
R3	SMITH NEALE & JOAN W (SURV)	4-CC29-194.2
S3	CHAMBERS JASON & CHAROLETTE (JTWS)	4-CC29-27
T3	STEWART RUTH ANN 1/2; JACKSON MADELON DAWN 1/2 TOD	4-CC29-193
U3	STEWART RUTH ANN 1/2; JACKSON MADELON DAWN 1/2 TOD	4-CC29-213
V3	LEMASTERS HARVEY C & ADA L	4-CC29-226
W3	LEMASTERS HARVEY C & ADA L	4-CC29-225
X3	MARSHALL HAROLD L JR & LINDA K (SURV)	4-CC29-224
Y3	MARSHALL HAROLD L JR & LINDA K (SURV)	4-CC29-223
Z3	PRAGER KEN J & PAULA L (JTWS)	4-CC29-222
A4	MINOR LISA M 2/3 & MARK MINOR 1/3	4-CC29-232
B4	L & M RENTALS LLC	4-CC29-234
C4	MILLS DARREN P	4-CC29-235
D4	SMITH NICOLE R & NEALE	370-07-1.2
E4	DEPETRO JOSEPH J III	370-07-01
F4	BRIGGS ROBERT G & NANCY L	370-07-02
G4	DEPETRO JOSEPH J III	370-11-09
H4	JACOBS LISA J & TERRY G	370-11-9.1
I4	DEPETRO JOSEPH J III	370-11-9.2
J4	CUNNINGHAM PAUL A	370-12-02

ADJOINING OWNERS TABLE		
TRACT	SURFACE OWNER	TAX PARCEL
K4	BROWNLEE ANDREA GEORGETTI	370-12-01
L4	BROWNLEE LAND VENT LP	370-11-01
M4	MULLINS JOHN JR	370-11-3.1
N4	BROWNLEE LAND VENT LP	370-11-04
O4	APPALACHIA MIDSTREAM SERVICES LLC	3-B34-66
P4	BROWNLEE LAND VENTURES LP	3-B34-78
Q4	HIGHLAND SPRINGS GOLF COURSE LLC	3-B34-80
R4	FELTON DANIEL KEVIN	3-B34-79
S4	ANKRUM ERIN C. (ETAL)	3-B34-82
T4	MITCHELL MELANIE	3-B34-84
U4	HUNT WILLIAM CURTIS & SUSAN L (SURV) (TOD) SCOTT KRISTEN E	3-B34-7
V4	PAULL CHRISTOPHER J & MARY ELLEN (SURV)	3-B34-4
W4	PAULL CHRISTOPHER J & MARY E (SURVIVORSHIP)	3-B34-3
X4	PAULL CHRISTOPHER J & MARY E	3-B29-15.2
Y4	DIAMOND JANA L	3-B29-15.1
Z4	HONE MARK A & LAUREN M JTWS	3-B29-19
A5	HONE MARK A & LAUREN M JTWS	3-B29-20
B5	HONE MARK A & LAUREN M JTWS	3-B29-21
C5	SANFORD HARRY E; NEELY CHATMAN L (SURV)	3-B29-16
D5	CHIVERS NORMA E; CHIVERS ALAN J. ETAL	3-B29-12
E5	MALINKY KEITH & KIM	3-B29-22
F5	CHIVERS NORMA E; TOD CHIVERS ALAN J. ETAL	3-B29-11
G5	SONDA HAROLD S & SHIRLEY J	3-B29-10
H5	SONDA HAROLD S & SHIRLEY	3-B29-9
I5	SKYWATCHER LINDA TOD; SKYWATCHER DANIEL (ETAL)	3-B29-23
J5	SHIDOCK HOWARD & ARLENE	3-B29-8
K5	HIGHLAND SPRINGS GOLF COURSE LLC	3-B29-7
L5	HIGHLAND SPRINGS GOLF COURSE LLC	3-B29-6
M5	CONNOLLY BRIAN & TAMMY	4-CC29-219
N5	ROBERSON CHARLES M & DOROTHY	3-B29-5
O5	RYAN TIMOTHY A & SONDR A M	4-CC29-216
P5	JACKSON DOUGLAS HOWARD	4-CC29-212.1
Q5	PLATTER MARVIN E JR & KATHY A (SURV)	4-CC29-192.2
R5	HIMMELRICK NATHAN S	4-CC29-192.3
S5	HIMMELRICK NATHAN S	4-CC29-198
T5	HIMMELRICK NATHAN S	4-CC29-195
U5	CLAMPITT NORMAN C & JEANETTA K (SURV)	4-CC29-197
V5	KOWCHECK MARK & THERESA (SURV)	4-CC29-195.1
W5	CLAMPITT NORMAN C & JEANETTA K	4-CC29-189.1
X5	HUNTER ELEANORE M	4-CC29-189
Y5	CALVERT HAROLD	4-CC29-188
Z5	WILEY DEAN A & PALMER HELENA M (SURV)	4-CC29-174
A6	FRESHWATER MELISSA J	4-CC29-171
B6	FRESHWATER MELISSA J	4-CC29-169
C6	FRESHWATER ROBERT LEE	4-CC29-168
D6	MAIN DRIVE CIVIC ASSOC INC	4-CC29-155.1
E6	MAIN DRIVE CIVIC ASSOC INC	4-CC29-167
F6	FRESHWATER ROBERT LEE	4-CC29-166
G6	FRESHWATER ROBERT LEE	4-CC29-165
H6	FRESHWATER ROBERT LEE	4-CC29-164
I6	HAGLER CHARLES	4-CC29-162
J6	BLANKENSHIP PHILLIP E	4-CC29-153
K6	ODKAN HEATHER LEE	4-CC29-152.1
L6	REID JANIS BARNA	4-CC29-149
M6	BILLIARD PAUL;TIMOTHY;WALES KIM LE-CAROL BILLIARD	4-CC29-148
N6	FILKINS RANDY	4-CC29-147
O6	MAYNARD COREY L	4-CC29-146
P6	BONAR JAMES L & MARY JEAN (SURV)	4-CC29-144
Q6	MACFAWN IAN & NANCY (JTWS)	4-CC29-143
R6	AUBER ARTHUR D & GERALDINE	4-CC29-141
S6	AUBER ARTHUR D & GERALDINE	4-CC29-140
T6	AUBER ARTHUR & GERALDINE A	4-CC29-138
U6	OHLER LORI ANN & RICKI (SURV)	4-CC29-137
V6	PAULL JOHN	4-CC29-136
W6	HARTZER JAMES N & EVANS HARTZER CAROLE G (SURV)	4-CC29-135
X6	FLUHARTY JERRY & MARY	4-CC29-133
Y6	GEORGETTI ANDREW	4-CC29-131
Z6	GEORGETTI ANDREW	4-CC29-130
A7	GEORGETTI ANDREW	4-CC29-129
B7	ANDREWS DONALD W & JERI L (SURV)	4-CC29-128
C7	ANDREWS DONALD & JERI	4-CC29-127
D7	DISERIO PAUL RAYMOND & KATHY A	4-CC29-126
E7	CAMPBELL ERIC WILLIAM	4-CC29-119
F7	GAGICH DIANA KIM	4-CC29-117.1
G7	KRAFT JEREMIAH ET AL	4-CC29-111
H7	CYPHERT DEBRA-1/2;FAIR MATTHEW 1/4;BRUFFY SUSAN-1/4	4-CC29-57
I7	HUNTER CLARA MAE NKA JACKSON CLARA TUD	4-CC29-49
J7	EATON JAMES W	4-CC29-45
K7	JOZWICK RICHARD A & KAREN A	4-CC29-46
L7	KEENER JEROLD M & CYNTHIA L	4-CC29-33
M7	CLEM MICHAEL G	4-CC29-23
N7	HURLEY VALERIE E & ROBERT L BERGMAN	4-CC29-24
O7	ROHR ANITRA	4-CC24-124.1
P7	FERGUSON DREW	4-CC24-84.1
Q7	BOLEN MICHAEL SCOTT	4-CC24-85
R7	HUFFNER JAMES E & PATRICIA A (SURV)	4-CC24-99.6
S7	CECCHINI CHRISTOPHER L	4-CC24-87
T7	HEFFNER TERRI	4-CC24-84
U7	MALONEY CHARLES WAYNE & NANCY L (JTWS) (TOD)	4-CC29-17
V7	STEVENS JOHN & LUNDA	4-CC24-56

07/25/2025

REVISIONS:	COMPANY:			
	OPERATOR'S	STATE OF WV DNR C BRK	API:	DATE: 10-02-2024
	WELL #:	206H	47-009-00341	DRAWN BY: COCKERHAM
	DISTRICT:	CROSS CREEK	COUNTY:	SCALE: N/A
			STATE:	DRAWING NO:
			WV	WELL LOCATION PLAT 6

07/25/2025

REVISIONS:		COMPANY:	
		Production Company, LLC	
		Production Company, LLC	
		DATE: 10-02-2024	
		DRAWN BY: COCKERHAM	
		SCALE: N/A	
		DRAWING NO:	
		WELL LOCATION PLAT 6	
DISTRICT:		COUNTY:	
CROSS CREEK		BROOKE	
WELL #:		206H	
OPERATOR:		STATE OF WV DIR C BRK	
API:		47-009-00341	
DATE: 10-02-2024		DRAWN BY: COCKERHAM	

10/25/2025 08:13AM
TUESDAY FEBRUARY 11 2025 08:13AM
J:\2025 BACKUPS\1-02-25 D\1\SWN\STATE OF WV DIR C BRK\WELL PLATS\WELL PLAT\206H\FINAL\WV DIR C 10-02-24\WV DIR C 206H WELL PLAT 10-02-24.DWG

TRACT	SURFACE OWNER	TAX PARCEL
A	BREEN SUSAN D & DENNIS M	4-CC20-22
B	COLLIERS SPORTSMAN CLUB	4-CC20-21
C	ROUSE WILLIAM MORGAN & DORIS J	4-CC20-20
D	BLACK LINDY J	4-CC20-7
E	GALLIANO LINDY J &	4-CC20-19.1
F	CARTER EDWARD J & DEBORAH C 1TW2	4-CC20-18
G	CARTER EDWARD J	4-CC20-17
H	GALLIANO ERIC T	4-CC20-16
I	GALLIANO ERIC T	4-CC20-14
J	GALLIANO ERIC T	4-CC20-19
K	MCCONNELL KEVIN	4-CC20-11
L	MCCONNELL BARBARA J	4-CC20-10
M	PROCHNIK SUZAN KAY	4-CC20-8
N	BERNARDINI JUDITH ANN	4-CC20-9
O	BERNARDINI MICHAEL E & JULIE YUIN (SURV)	4-CC20-44
P	NORFOLK & WESTERN RAILWAY CO	4-CC20-29
Q	NICKOLE S LLC	4-CC20-33
R	WEST VIRGINIA ST OF BUREAU OF COMM DIV OF NAT RES P8 LD CORP	4-CC24-3
S	COOK BRANDON & LORETTA SANCHEZ	4-CC24-8
T	VAUGHN MARK E & LISA A (SURV)	4-CC24-9
U	MINHBAUER DAVID A & TERI J	4-CC24-10
V	PETTY TOITTO J	4-CC24-12
W	FILLINGER JOHN O	4-CC24-43
X	MCCLOUD JIM R & MARTHA SURV	4-CC24-42
Y	MCCLOUD JIM R & MARTHA SURV	4-CC24-41
Z	MCCLOUD JIM R & MARTHA SURV	4-CC24-40
A1	SMITH MICHELLE J	4-CC24-39
B1	HUNTER WILLIAM R & GLORIA J	4-CC24-38
C1	CRAWFORD BERNARD E (TOD) & WILLIAM J	4-CC24-37
D1	CRAWFORD BERNARD E (TOD) & WILLIAM A	4-CC24-36
E1	SHINGLE EVA & RAYMOND	4-CC24-32
F1	SHINGLE EVA RAYMOND	4-CC24-34
G1	OBER MICHAEL	4-CC24-7
H1	SMITH DEAN	4-CC24-88
I1	MCFADDEN MICHAEL K & SHARON (SURV)	4-CC24-93
J1	CIRIAMI MICHAEL J	4-CC24-142
K1	CIRIAMI MICHAEL J	4-CC24-141
L1	ERNEST JACK & LESLIE M (SURV)	4-CC24-138
M1	FARRELL KEVIN M & M & HEIDI L (SURV)	4-CC24-92
N1	FARRELL KEVIN M & M & HEIDI L (SURV)	4-CC24-91
O1	MARRS EDWARD ROBERT III & TONILO (SURV)	4-CC24-117
P1	SICURELLA PAUL J & LISA M (SURV)	4-CC24-118
Q1	BOOTH JERRY M & DEBRA D (SURV)	4-CC24-119
R1	BOOTH JERRY MARTIN & DEBRA DEAN 1TW2	4-CC24-99.9
S1	FERGUSON TODD P & LISA A (SURV)	4-CC24-99.1
T1	BARCHEZZI GEORGE A & PAMELA J (SURV)	4-CC24-122
U1	RUSH JAMES H & ALAN A (SURV)	4-CC24-121
V1	JOHNS LESLIE J & MELLISA J 1TW2	4-CC24-99
W1	JOHNS PATRICK	4-CC24-129.1
X1	MITCHELL JESSE ETAL (LE-EUGENE JR & MARGARET MITCHELL)	4-CC24-126
Y1	HARTER MELISSA K & CHRISTOPHER J	4-CC24-26
Z1	SHERINIKY THOMAS J	4-CC24-36
A2	HICKS RONALD LEE & DEBRA V	4-CC24-43
B2	KUSICH GARY & PATRICIA ELAINE	4-CC24-62
C2	KUSICH GARY & PATRICIA ELAINE	4-CC24-61
D2	FREDA BRIAN T & V-L-EVA (SURV)	4-CC24-80
E2	FREDA BRIAN T & V-L-EVA (SURV)	4-CC24-29
F2	FREDA BRIAN T & V-L-EVA (SURV)	4-CC24-28
G2	MUSCEDERE EMILIO A & JUDITH A	4-CC24-24
H2	LYLE JOHN H JR & MARY CATHERINE	4-CC24-22
I2	LYLE JOHN H JR & MARY C (SURV)	4-CC24-26
J2	NEWTON ROBERT R JR	4-CC24-41.1
K2	PARSON NATHANIEL	4-CC24-41
L2	HONE MARK & LAUREN M M M (SURV)	4-CC24-39.2
M2	MITCHELL ARLEY R & NAHCOE (SURV)	4-CC24-39.11
N2	MCCAIN DAVID H & KAREN (SURV)	4-CC24-39.7
O2	CATTARATTA ALLEN M	4-CC24-39
P2	BROWNLEE LAND VENTURES	370-001-12
Q2	STATE LINE REAL EST LLC	370-04-01
R2	SMITH NEALE E & JOAN W (SURV)	4-CC24-194.2
S2	CHAMBERS JASON & CHARLOTTE 1TW2	4-CC24-27
T2	STEWART RUTH ANN 1/2; JACKSON MADEON DAWN 1/2 TOD	4-CC24-193
U2	STEWART RUTH ANN 1/2; JACKSON MADEON DAWN 1/2 TOD	4-CC24-213
V2	LEMASTERS HARVEY C & ADA J	4-CC24-226
W2	LEMASTERS HARVEY C & ADA J	4-CC24-222
X2	MARSHALL HAROLD L JR & LINDA K (SURV)	4-CC24-224
Y2	MARSHALL HAROLD L JR & LINDA K (SURV)	4-CC24-223
Z2	PRAGER KEN J & PAUL J 1TW2	4-CC24-222
A4	MINOR LISA M 2/3 & MARK MINOR 1/3	4-CC24-232
B4	J & M REALTYS LLC	4-CC24-234
C4	MILLER DARRIN P	4-CC24-232
D4	SMITH NICOLE R & NEALE	370-07-12
E4	DEFEETRO JOSEPH III	370-07-01
F4	BRIEGGS ROBERT G & NAHCOE J	370-07-02
G4	DEFEETRO JOSEPH III	370-11-09
H4	JACOBS LISA J & TERRY G	370-11-9.1
I4	DEFEETRO JOSEPH III	370-11-9.2
J4	CUNNINGHAM MANUEL A	370-12-02

304-623-8881
Clarkspurd, WV 26302
25413 EAST PIKE ST. # 112
INC.
JACKSON SURVEYING

TRACT	SURFACE OWNER	TAX PARCEL
K4	BROWNLEE ANDREA GEORGETTI	370-12-01
L4	BROWNLEE LAND VENT LP	370-11-01
M4	MULLINS JOHN JR	370-11-3.1
N4	BROWNLEE LAND VENT LP	370-11-04
O4	APPALACHIA MIDDLESTREAM SERVICES LLC	3-834-66
P4	BROWNLEE LAND VENTURES LP	3-834-78
Q4	HIGHLAND SPRINGS GOLF COURSE LLC	3-834-80
R4	FELTON DANIEL KEVIN	3-834-79
S4	ANKRUM ERIN C (ETAL)	3-834-82
T4	MITCHELL MELANIE	3-834-84
U4	HUNT WILLIAM CURTIS & SUSAN L (SURV) (TOD) SCOTT KRISTEN E	3-834-7
V4	PAUL CHRISTOPHER J & MARY ELLEN (SURV)	3-834-4
W4	PAUL CHRISTOPHER J & MARY E (SURV)(VOWERSHIP)	3-834-3
X4	PAUL CHRISTOPHER J & MARY E	3-834-12.2
Y4	DIAMOND JANA J	3-834-12.1
Z4	HONE MARK A & LAUREN M 1TW2	3-834-19
A2	HONE MARK A & LAUREN M 1TW2	3-834-20
B2	HONE MARK A & LAUREN M 1TW2	3-834-21
C2	SAINFORD HARRY E; NEELY CHATMAN J (SURV)	3-834-16
D2	CHIVERS NORMAN E; CHIVERS ALAN J. ETAL	3-834-12
E2	MALINKY KEITH & KIM	3-834-22
F2	CHIVERS NORMAN E; TOD CHIVERS ALAN J. ETAL	3-834-11
G2	SONDA HAROLD S & SHIRLEY J	3-834-10
H2	SONDA HAROLD S & SHIRLEY	3-834-9
I2	SKYWATCER LINDA A; TOD; SKYWATCER DANIEL (ETAL)	3-834-23
J2	SHIDOCK HOWARD & ARLINE	3-834-8
K2	HIGHLAND SPRINGS GOLF COURSE LLC	3-834-7
L2	HIGHLAND SPRINGS GOLF COURSE LLC	3-834-6
M2	CONNOLLY BRIAN & TAMMY	4-CC24-219
N2	ROBERSON CHARLES M & DOROTHY	3-834-2
O2	RYAN TIMOTHY A & SONDRA M	4-CC24-216
P2	JACKSON DOUGLAS HOWARD	4-CC24-212.1
Q2	PLATTER MARVIN E JR & KATHY A (SURV)	4-CC24-192.2
R2	HIMMELRICK NATHAN S	4-CC24-192.3
S2	HIMMELRICK NATHAN S	4-CC24-198
T2	HIMMELRICK NATHAN S	4-CC24-192
U2	CAMPLITT NORMAN C & LEANETTE K (SURV)	4-CC24-192
V2	KOWCHECK MARK & THERESA (SURV)	4-CC24-192.1
W2	CAMPLITT NORMAN C & LEANETTE K	4-CC24-189.1
X2	HUNTER ELEANORE M	4-CC24-189
Y2	CALVERT HAROLD	4-CC24-188
Z2	WILEY DEAN A & PALMER HELENA M (SURV)	4-CC24-174
A6	FRESHWATER MELISSA J	4-CC24-171
B6	FRESHWATER MELISSA J	4-CC24-169
C6	FRESHWATER ROBERT LEE	4-CC24-168
D6	MAIN DRIVE CIVIC ASSOC INC	4-CC24-122.1
E6	MAIN DRIVE CIVIC ASSOC INC	4-CC24-167
F6	FRESHWATER ROBERT LEE	4-CC24-166
G6	FRESHWATER ROBERT LEE	4-CC24-162
H6	FRESHWATER ROBERT LEE	4-CC24-164
I6	HAGLER CHARLES	4-CC24-162
J6	BLANKENSHIP PHILLIP E	4-CC24-123
K6	ODKAN HEATHER LEE	4-CC24-122.1
L6	REID JAVIS KIMBERLY	4-CC24-169
M6	BILLARD PAUL;TIMOTHY;WALEY KIM LE-CAROL BILLIARD	4-CC24-148
N6	FIKINS RANDY	4-CC24-147
O6	MAYNARD CORLE J	4-CC24-146
P6	BONAR JAMES J & MARY JEAN (SURV)	4-CC24-144
Q6	MACFARLAN IAN & NAHCOE 1TW2	4-CC24-143
R6	UABER ARTHUR D & GERARDINE	4-CC24-141
S6	UABER ARTHUR D & GERARDINE	4-CC24-140
T6	UABER ARTHUR & GERARDINE A	4-CC24-138
U6	ONLER LORI ANN & RICKI (SURV)	4-CC24-137
V6	PAUL JOHN	4-CC24-136
W6	HARTZER JAMES N & EVANS HARTZER CAROLE G (SURV)	4-CC24-122
X6	FUHAERTY JERRY & MARY	4-CC24-123
Y6	GEORGETTI ANDREW	4-CC24-131
Z6	GEORGETTI ANDREW	4-CC24-130
A7	GEORGETTI ANDREW	4-CC24-129
B7	ANDREWS DONALD W & JERI L (SURV)	4-CC24-128
C7	ANDREWS DONALD & JERI	4-CC24-127
D7	DISERIO PAUL RAYMOND & KATHY A	4-CC24-126
E7	CAMPBELL ERIC WILLIAM	4-CC24-119
F7	GAGICH DIANA KIM	4-CC24-117.1
G7	KRAFT JEREMIAH ET AL	4-CC24-111
H7	CYPHERT DEBRA-J;S;FAIR MATTHEW J;4;BRYNLEY SUSAN-1/4	4-CC24-22
I7	HUNTER CLARA MAE NKA JACKSON CLARA TUD	4-CC24-49
J7	EATON JAMES W	4-CC24-42
K7	JOZWICK RICHARD A & KAREN A	4-CC24-46
L7	KEENER JEROLD M & CYNTHIA J	4-CC24-33
M7	CLEM MICHAEL G	4-CC24-23
N7	HURLEY VALERIE E & ROBERT L BERGMAN	4-CC24-24
O7	ROYAL MATTHEW	4-CC24-122.1
P7	FERGUSON DREW	4-CC24-84.1
Q7	BOTEN MICHAEL SCOTT	4-CC24-82
R7	HUFFNER JAMES E & PATRICIA A (SURV)	4-CC24-99.6
S7	CECCHINI CHRISTOPHER J	4-CC24-87
T7	HEFFNER TERRY	4-CC24-84
U7	MALONEY CHARLES WAYNE & NAHCOE J 1TW2 (TOD)	4-CC24-12
V7	STEVENS JOHN & LINDA	4-CC24-26

JACKSON SURVEYING
INC.
2413 EAST PIKE ST. # 112
Clarksburg, WV 26302
304-623-5851

ADJOINING OWNERS TABLE		
TRACT	SURFACE OWNER	TAX PARCEL
W7	KLAGES KEVIN W & LINDA K SURV	4-CC24-52
X7	KLAGES KEVIN W & LINDA K SURV	4-CC24-51
Y7	GOOCH JUDITH L (ETAL)	4-CC24-49
Z7	BRADLEY GEORGE L	4-CC24-132
A8	LEMASTERS DONALD & JOYCE (SURV)	4-CC24-23
B8	FIGUEROA KAIA	4-CC24-24
C8	BURDINE CALVIN G & BOYCE HANNA M (JTWS)	4-CC24-25
D8	LAUCK MARIE	4-CC24-26
E8	MOZINGO WARREN HARRY & LINDA DIANE (SURV)	4-CC24-27
F8	COLEMAN ROBERT B & SHERRY E (SURVIVORSHIP)	4-CC24-28
G8	TAYLOR BUDDY L JR & PATRICIA L (SURV)	4-CC24-29
H8	ADAMS JASON R	4-CC24-30
I8	WHITE ROGER DALE	4-CC24-31
J8	TAYLOR JENNIFER	4-CC24-47
K8	HUNTER ROBERT JR	4-CC24-48
L8	COLLINS RANDY L JR & AMY R (SURVIVORSHIP)	4-CC24-18
M8	JOHNS ALBERT;GARY;GREGORY;MOORE TAMMY	4-CC23-326
N8	BAIRD WILLIAM C & CYNTHIA L (SURV)	4-CC24-5
O8	CZESZTYICKI JOSEPH P & TOM METZ	4-CC24-6
P8	THOMPSON DEBRA J	4-CC23-320
Q8	BARONIO CURTIS R & DONNA J	4-CC23-321
R8	COOK FAMILY REVOCABLE TRUST 4/20/17, MALSON SUSAN A	4-CC23-322
S8	MENEELY BOBBIE JO; MINICH RANDALL	4-CC23-324
T8	CARBASHO THOMAS & CALDWELL TINA	4-CC23-323
U8	POWER ADRIAN ELIZABETH & EMIL JAMES LOPPE (JTWS)	4-CC19-185
V8	MOORE CHARLES D & CECELIA FAY (JTWS)	4-CC19-180
W8	EDGELL ROSA MARIE	4-CC19-176
X8	EVANGELINOS CONSTANTINE & TOULA (SURV)	4-CC19-171
Y8	D'AGOSTINO PETER	4-CC19-188
Z8	NICKOLES GREGORY; RANDY;JEFFRE (LE-DANNY & GRACE NICKOLES)	4-CC19-160
A9	BAKER DAVID	4-CC19-164
B9	EMMERTH DOUGLAS P & PAMELA L JTWS	4-CC19-165
C9	STATE OF WEST VIRGINIA BUREAU OF COMMERCE DIV OF NAT RESOURC	4-CC19-168
D9	LANGEVIN GRETCHEN MOORE WESBANCO BANK INC	4-CC20-5
E9	MILLER JOHN ERNEST, JESSE ANDREW (SURV)	4-CC20-4

07/25/2025

REVISIONS:	COMPANY:	SWN Production Company, LLC SWN Production Company™		
	OPERATOR'S	STATE OF WV DNR C BRK	API:	DATE: 10-02-2024
	WELL #:	206H	47-009-00341	DRAWN BY: COCKERHAM
	DISTRICT:	CROSS CREEK	COUNTY:	SCALE: N/A
			STATE:	DRAWING NO:
			WV	WELL LOCATION PLAT 7






JACKSON SURVEYING
INC.
2413 EAST PIKE ST. # 112
Clarksburg, WV 26302
304-623-5851

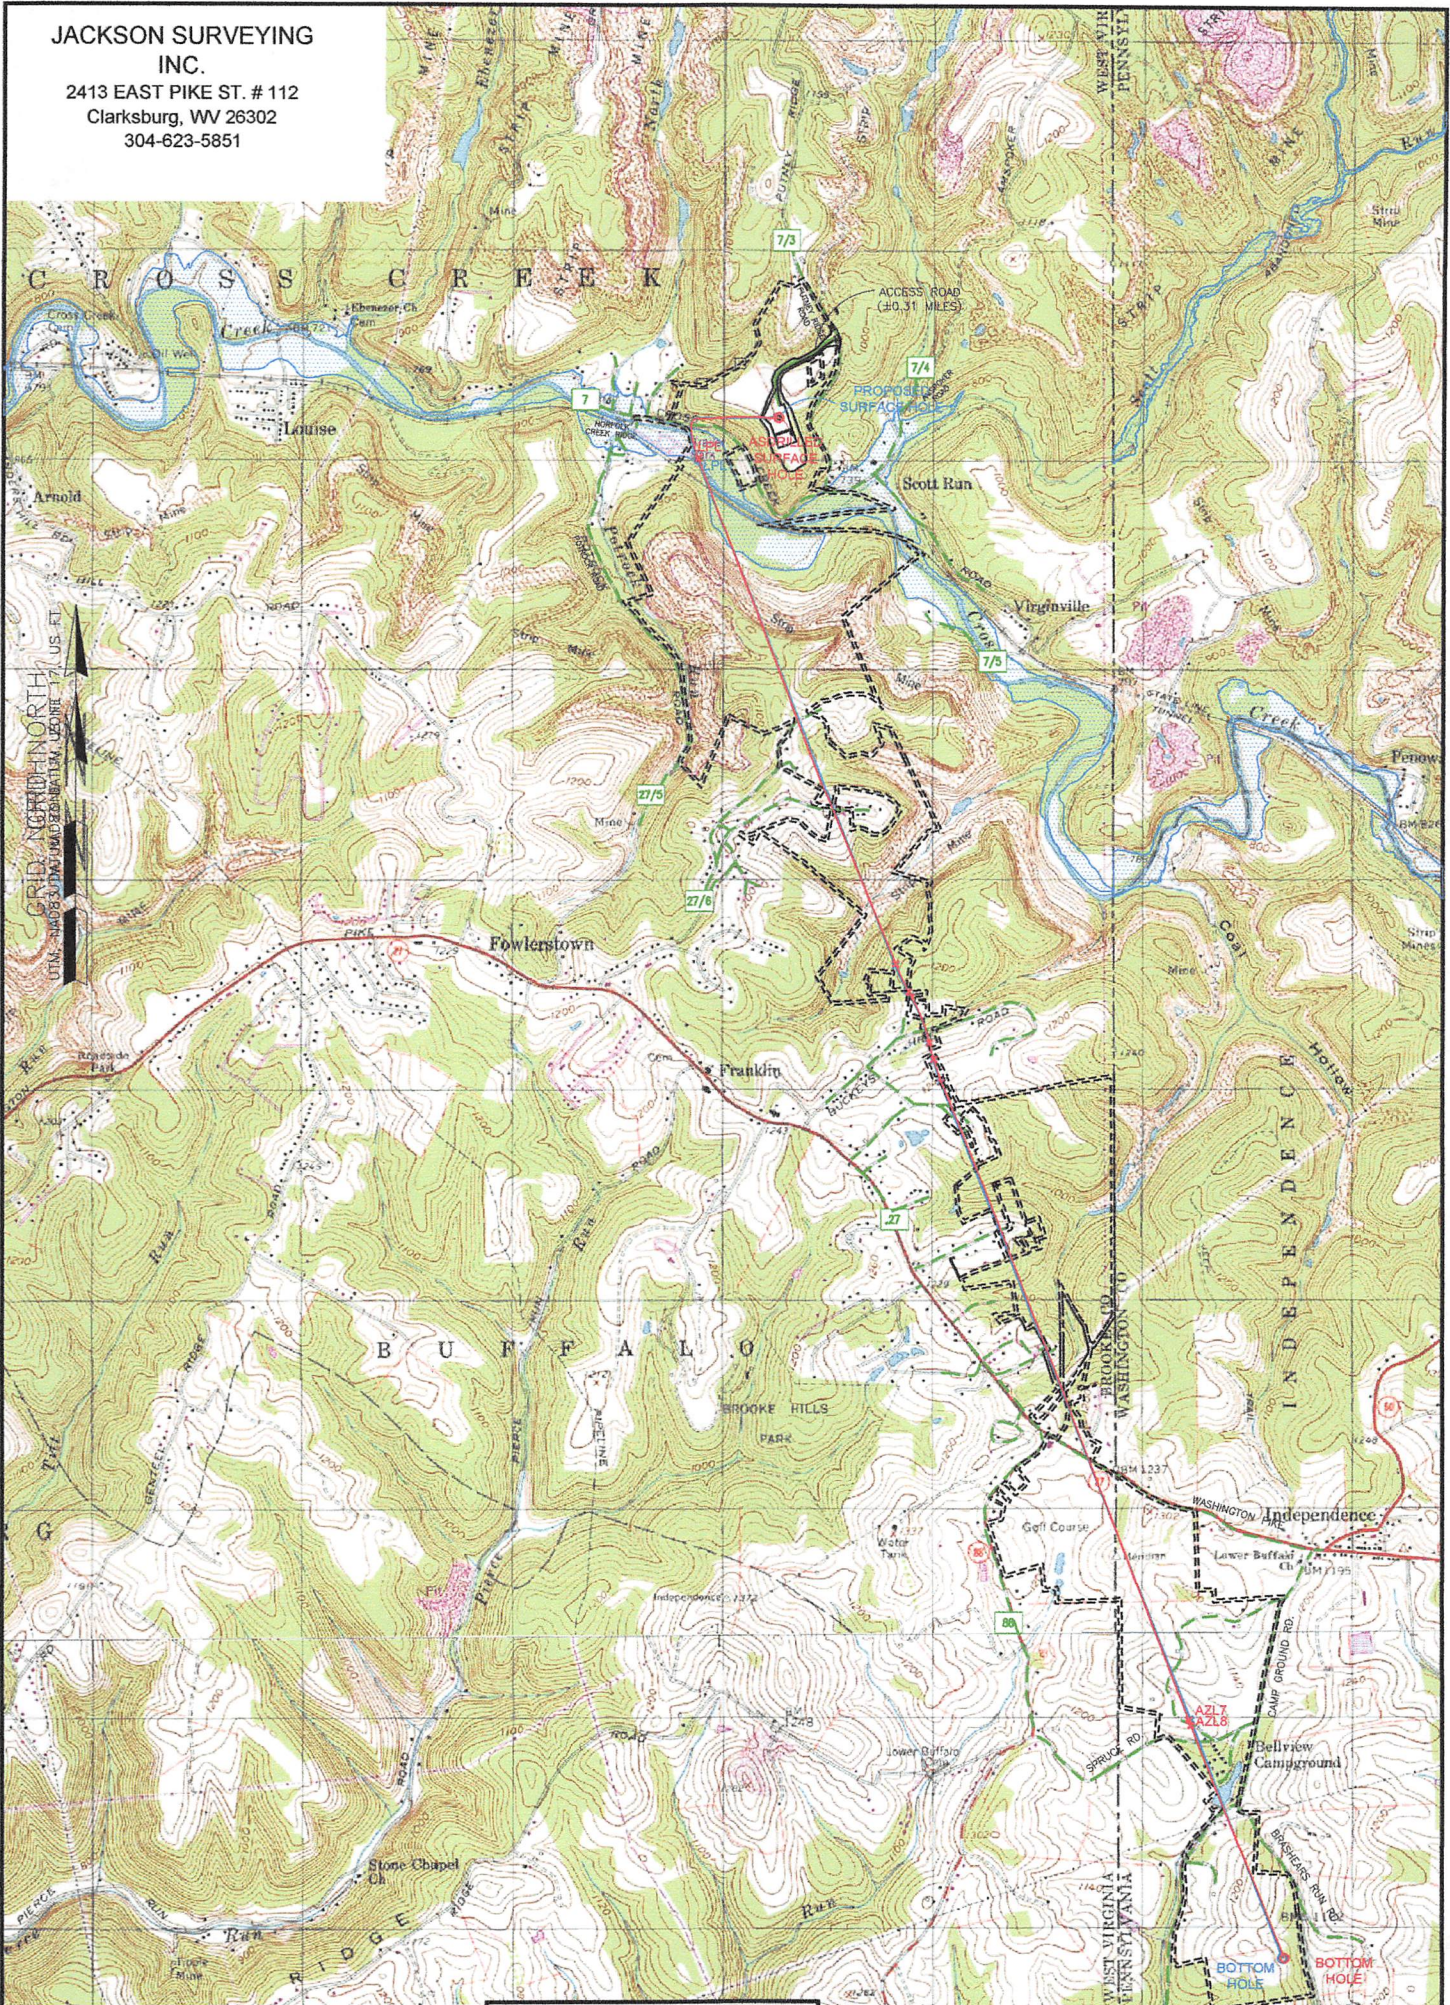

3000'

0

3000'

GRAPHIC SCALE IN FEET

SURFACE HOLE LOCATION (SHL):
GEOGRAPHIC (NAD83):
LATITUDE: 40.302280°
LONGITUDE: -80.537718°

BOTTOM HOLE LOCATION (BHL):
GEOGRAPHIC (NAD83):
LATITUDE: 40.236025°
LONGITUDE: -80.509768°

07/25/2025

07/25/2025

- NOTES ON SURVEY

1. SURFACE AND ROYALTY OWNER INFORMATION AND THEIR BOUNDARIES SHOWN HEREON WERE PLOTTED FROM DEEDS AND/OR TAX PARCEL MAPS PROVIDED BY CLIENT AND/OR FIELD LOCATIONS.

2. THIS PLAT DOES NOT REPRESENT A BOUNDARY SURVEY OF THE PARCELS SHOWN HEREON.

4. ALL INSETS ARE GRID NORTH UNLESS OTHERWISE DEPICTED.

LEGEND:

PROPOSED SURFACE HOLE / BOTTOM HOLE

EXISTING / PRODUCING WELLHEAD

LPL* LANDING POINT LOCATION

FLOOD PLAIN

PUBLIC ROAD

ACCESS ROAD TO PREV. SITE

LEASE BOUNDARY

PROPOSED PATH

ASDRILLED PATH
- | | | | |
|---|---|--------------------------|-----------------------|
| WELL OPERATOR:
SWN PRODUCTION COMPANY, LLC | WELL (FARM) NAME:
STATE OF WV DNR C BRK | WELL #
206H | API #
47-009-00341 |
| ADDRESS:
1300 FORT PIERPONT ROAD, SUITE 200 MORGANTOWN, WV 26508 | COUNTY - CODE
BROOKE - 009 | DISTRICT;
CROSS CREEK | |
| SURFACE OWNER: STATE OF WEST VIRGINIA, BUREAU OF COMMERCE, DIVISION OF NATURAL RESOURCES, PUBLIC LAND CORPORATION | USGS 7 1/2 QUADRANGLE MAP NAME
STUEBENVILLE EAST, WV | | |
- Z:\2025 BACKUPS\1-02-25 DJ\SWN\STATE OF WV DNR C BRK\WELL PLATS\WELL PLAT\206H\FINAL\WV DNR C 10-03-24\WV DNR C 206H WELL PLAT 10-03-24

TUESDAY FEBRUARY 11 2025 08:17AM

PROPERTY NUMBER 2501170058
PAD ID 3001169055