

Latitude: 40°20'00"

SURFACE HOLE 10515'

JACKSON SURVEYING
INC.

2413 EAST PIKE ST. # 112
Clarksburg, WV 26302
304-623-5851

Latitude: 40°15'00" BOTTOM HOLE

2,727'

BOTTOM HOLE 5091'

SURFACE HOLE 11313'

Longitude: 80°30'00"

BOTTOM HOLE 5091'

SURFACE HOLE 11313'


Longitude: 80°30'00"

SURFACE HOLE LOCATION (SHL):
UTM (NAD83, ZONE 17, METERS):
NORTHING: 4,461,410.588
EASTING: 539,285.828
LANDING POINT (LPL):
UTM (NAD83, ZONE 17, METERS):
NORTHING: 4,461,207.847
EASTING: 538,900.645
BOTTOM HOLE LOCATION (BHL):
UTM (NAD83, ZONE 17, METERS):
NORTHING: 4,454,069.099
EASTING: 541,692.604



LINE	BEARING	DISTANCE	DESCRIPTION	MONUMENT
L1	N 35°46'46" W	1029.72'	SHL TO LANDMARK	2" IRON PIPE FOUND
L2	N 66°32'19" W	1310.56'	SHL TO LANDMARK	STONE FOUND
L5	S 27°42'32" E	94.99'	AZL2 TO AZL3	
L7	S 15°50'21" E	286.00'	AZL4 TO AZL5	
L9	S 20°55'07" E	94.00'	AZL7 TO AZL8	
LINE	BEARING	DISTANCE	CURVE LENGTH	DESCRIPTION
L3	S 63°05'04" W	1411.84'	1975.37'	SHL TO LP
L4	S 25°05'52" E	476.62'	476.97'	AZL1 TO AZL2
L6	S 21°32'34" E	761.94'	763.94'	AZL3 TO AZL4
L8	S 18°07'41" E	366.07'	366.28'	AZL5 TO AZL6



GRID NORTH
UTM, NAD83 DATUM, ZONE 17, US FT

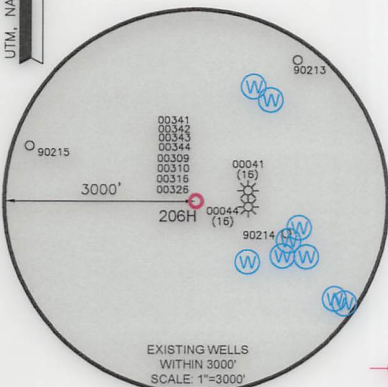

SURFACE HOLE LOCATION (SHL):
UTM (NAD83, ZONE 17, METERS):
NORTHING: 4,461,410.696
EASTING: 539,285.741
LANDING POINT (LPL):
UTM (NAD83, ZONE 17, METERS):
NORTHING: 4,461,215.894
EASTING: 538,902.028
BOTTOM HOLE LOCATION (BHL):
UTM (NAD83, ZONE 17, METERS):
NORTHING: 4,454,069.491
EASTING: 541,701.734

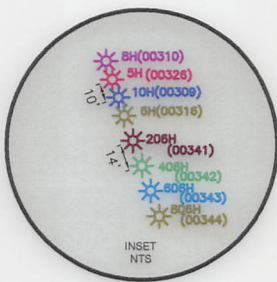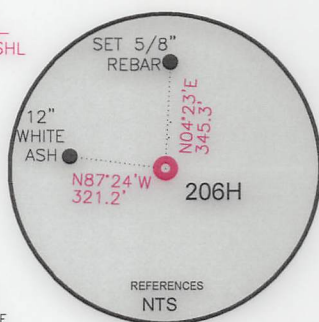

WELL RESTRICTIONS

1. NO OCCUPIED DWELLINGS > 2500 SQ FT. WITHIN 625 FEET OF CENTER OF PAD.
2. NO AGRICULTURE BUILDINGS > 2500 SQ FT. WITHIN 625 FEET OF CENTER OF PAD.
3. NO WATER WELLS OR DEVELOPED SPRINGS ARE WITHIN 250 FEET OF PROPOSED WELL.
4. NO PERENNIAL STREAMS, LAKES, PONDS, OR RESERVOIRS WITHIN 100 FEET OF THE LIMITS OF DISTURBANCE.
5. NO NATURALLY PRODUCING TROUT STREAM WITHIN 300 FEET OF LIMITS OF DISTURBANCE.
6. NO GROUND INTAKE OR PUBLIC WATER SUPPLY WITHIN 1000 FEET OF WELL PAD, LIMITS OF DISTURBANCE, E & S CONTROLS OR PUBLIC WATER SUPPLY.


NOTES ON SURVEY

1. SURFACE AND ROYALTY OWNER INFORMATION AND THEIR BOUNDARIES SHOWN HEREON WERE PLOTTED FROM DEEDS AND/OR TAX PARCEL MAPS PROVIDED BY CLIENT AND/OR FIELD LOCATIONS.
2. THIS PLAT DOES NOT REPRESENT A BOUNDARY SURVEY OF THE PARCELS SHOWN HEREON.
4. ALL INSETS ARE GRID NORTH UNLESS OTHERWISE DEPICTED.

I, THE UNDERSIGNED, HEREBY CERTIFY THAT THIS PLAT IS CORRECT TO THE BEST OF MY KNOWLEDGE AND BELIEF AND SHOWS ALL THE INFORMATION REQUIRED BY LAW AND REGULATIONS ISSUED AND PRESCRIBED BY THE DEPARTMENT OF ENVIRONMENTAL PROTECTION.

P.S. 708

David L Jackson

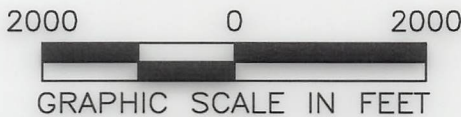

COMPANY: **SWN** **SWN** ^R/_A ^V/₊
Production Company, LLC Production Company™



(+) DENOTES LOCATION OF WELL ON UNITED STATES TOPOGRAPHIC MAPS
WVDEP
OFFICE OF OIL & GAS
601 57TH STREET
CHARLESTON, WV 25034

MINIMUM DEGREE OF ACCURACY: 1/200
PROVEN SURVEY SOURCE OF GRADE GPS ELEVATION: (NAVD 88, US FT)

STATE OF WV DNR C BRK
OPERATOR'S WELL #: 206H
API WELL #: 47 009 00341
STATE COUNTY PERMIT

WELL TYPE: OIL ☐ WASTE DISPOSAL ☐ PRODUCTION ☒ DEEP ☐ GAS ☒ LIQUID INJECTION ☐ STORAGE ☐ SHALLOW ☒
WATERSHED: NORTH FORK CROSS CREEK - CROSS CREEK (HUC-10) ELEVATION: 989.0'
DISTRICT: CROSS CREEK COUNTY: BROOKE QUADRANGLE: STEUBENVILLE EAST, WV
SURFACE OWNER: STATE OF WEST VIRGINIA, BUREAU OF COMMERCE, DIVISION OF NATURAL RESOURCES, PUBLIC LAND CORPORATION ACREAGE: ±83.858
OIL & GAS ROYALTY OWNER: STATE OF WEST VIRGINIA, BUREAU OF COMMERCE, DIVISION OF NATURAL RESOURCES, PUBLIC LAND CORPORATION ACREAGE: ±83.858
DRILL ☐ DRILL DEEPER ☐ REDRILL ☐ FRACTURE OR STIMULATE ☐ PLUG OFF OLD FORMATION ☐ PERFORATE NEW FORMATION ☐
CONVERT ☐ PLUG & ABANDON ☐ CLEAN OUT & REPLUG ☐ OTHER CHANGE ☐ (SPECIFY) ASDRILLED 07/25/2025
TARGET FORMATION: MARCELLUS ESTIMATED DEPTH: 5,945' TMD

WELL OPERATOR: SWN PRODUCTION COMPANY, LLC DESIGNATED AGENT: BRITTANY WOODY
ADDRESS: 1300 FORT PIERPONT ROAD, SUITE 200 ADDRESS: 1300 FORT PIERPONT ROAD, SUITE 200
CITY: MORGANTOWN STATE: WV ZIP CODE: 26508 CITY: MORGANTOWN STATE: WV ZIP CODE: 26508

LEGEND:	REVISIONS:	DATE:
PROPOSED SURFACE HOLE / BOTTOM HOLE		10-02-2024
EXISTING / PRODUCING WELLHEAD		
LPL: LANDING POINT LOCATION		
EXISTING WATER WELL		
EXISTING SPRING		
SURVEYED BOUNDARY		
DRILLING UNIT		
LEASE BOUNDARY		
ASDRILLED PATH		
PROPOSED PATH		

WELL LOCATION PLAT	DRAWING NO.	SCALE: 1" = 3000'	DRAWN BY: J. COCKEYHAM






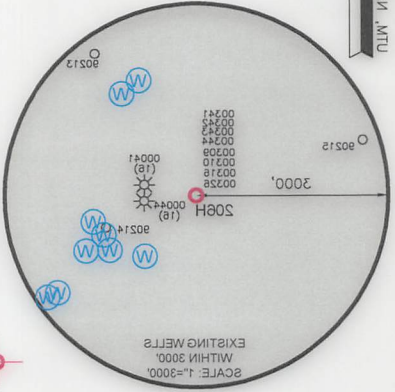



JACKSON SURVEYING INC.	
2413 EAST PIKE ST. # 115	
Clarksburg, WV 26305	
304-653-8884	


JACKSON SURVEYING
INC.
2413 EAST PIKE ST. # 112
Clarksburg, WV 26302
304-623-5851

GRID NORTH
UTM, NAD83 DATUM, ZONE 17, US FT



I, THE UNDERSIGNED, HEREBY CERTIFY THAT THIS PLAT IS
CORRECT TO THE BEST OF MY KNOWLEDGE AND BELIEF AND SHOWS
ALL THE INFORMATION REQUIRED BY LAW AND REGULATIONS ISSUED
AND PRESCRIBED BY THE DEPARTMENT OF ENVIRONMENTAL PROTECTION.

P.S. 708

David L Jackson

07/25/2025

REVISIONS:	COMPANY:	DATE: 10-02-2024	
	SWN Production Company, LLC	API: 47-009-00341	DRAWN BY: COCKERHAM
			SCALE: N/A
	OPERATOR'S STATE OF WV DNR C BRK	STATE: WV	DRAWING NO:
	WELL #: 206H		WELL LOCATION PLAT 2
	DISTRICT: CROSS CREEK	COUNTY: BROOKE	






I, THE UNDERSIGNED, HEREBY CERTIFY THAT THIS PLAT IS
CORRECT TO THE BEST OF MY KNOWLEDGE AND BELIEF AND SHOWS
ALL THE INFORMATION REQUIRED BY LAW AND REGULATIONS ISSUED
AND PRESCRIBED BY THE DEPARTMENT OF ENVIRONMENTAL PROTECTION.

David Jackson

07/25/2025

REVISIONS:			
COMPANY:			
DISTRICT: CROSS CREEK			
COUNTY: BROOKE			
STATE: WV			
WELL #: 47-009-00341			
OPERATOR'S STATE OF WV DNR C BRK			
DATE: 10-03-2024			
DRAWN BY: COCKERHAM			
SCALE: N/A			
DRAWING NO:			
WELL LOCATION PLAT 2			

JACKSON SURVEYING
INC.
2413 EAST PIKE ST. # 112
Clarksburg, WV 26302
304-623-5851

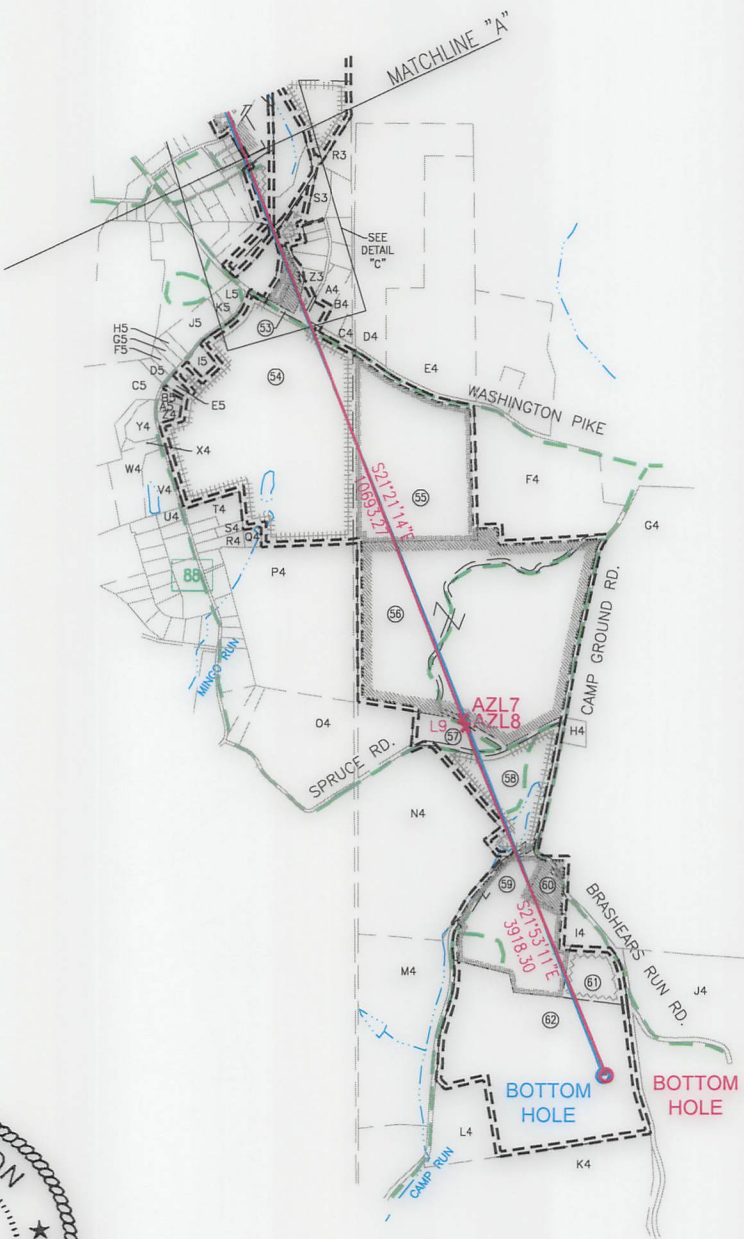

I, THE UNDERSIGNED, HEREBY CERTIFY THAT THIS PLAT IS
CORRECT TO THE BEST OF MY KNOWLEDGE AND BELIEF AND SHOWS
ALL THE INFORMATION REQUIRED BY LAW AND REGULATIONS ISSUED
AND PRESCRIBED BY THE DEPARTMENT OF ENVIRONMENTAL PROTECTION.

P.S. 708

David L Jackson

07/25/2025

REVISIONS:		COMPANY:		DATE: 10-02-2024	
		Swn Production Company, LLC		DRAWN BY: COCKERHAM	
		Swn Production Company™		SCALE: N/A	
		OPERATOR'S STATE OF WV DNR C BRK		DRAWING NO:	
		WELL #: 206H		WELL LOCATION PLAT 3	
		DISTRICT: CROSS CREEK			
		COUNTY: BROOKE			
		STATE: WV			
		API: 47-009-00341			

WELL LOCATION PLAT 3		DRAWING NO: N/A		SCALE: N/A		DRAWN BY: COCKERHAM		DATE: 10-03-2024	
CROSS CREEK		BROOKE		STATE: WV		APL: 47-000-00341		OPERATOR'S STATE OF WV DIR C BRK	
DISTRICT:		COUNTY:		SOGH		WELL #:		SOGH	
COMPANY:		Production Company, LLC							
REVISIONS:		Production Company, LLC							

07/25/2025 David Jackson

I, THE UNDERSIGNED, HEREBY CERTIFY THAT THIS PLAT IS CORRECT TO THE BEST OF MY KNOWLEDGE AND BELIEF AND SHOWS ALL THE INFORMATION REQUIRED BY LAW AND REGULATIONS ISSUED AND PRESCRIBED BY THE DEPARTMENT OF ENVIRONMENTAL PROTECTION.




JACKSON SURVEYING
INC.
5413 EAST PIKE ST. # 112
Clarksburg, WV 26302
304-853-2821

JACKSON SURVEYING
INC.
2413 EAST PIKE ST. # 112
Clarksburg, WV 26302
304-623-5851


DETAIL "A"



DETAIL "B"

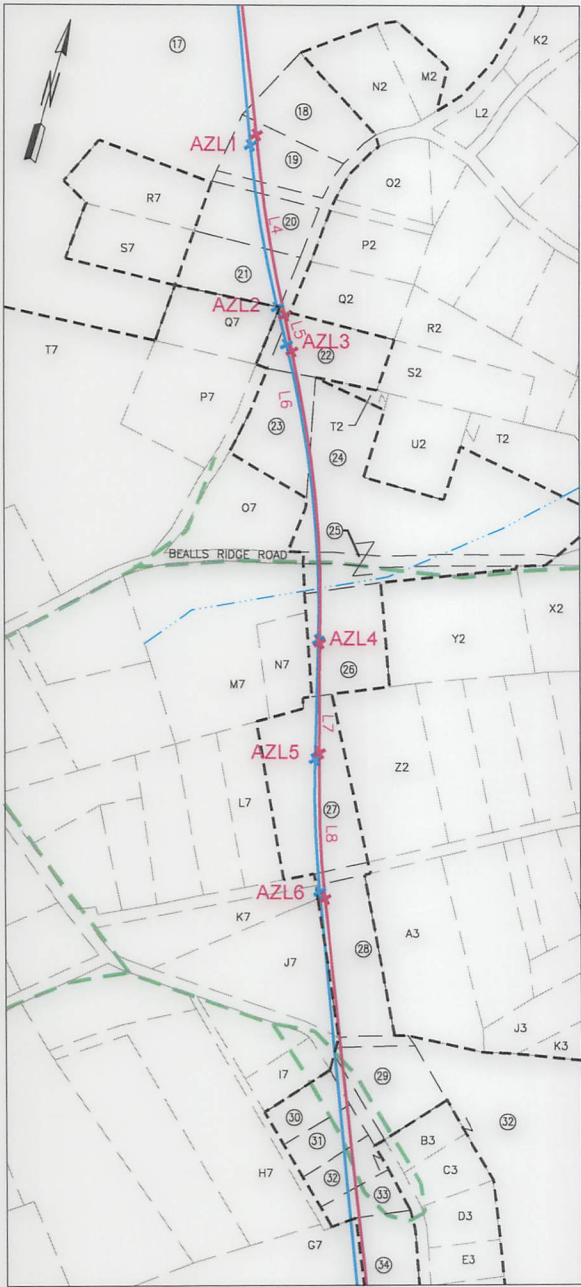

DETAIL "C"

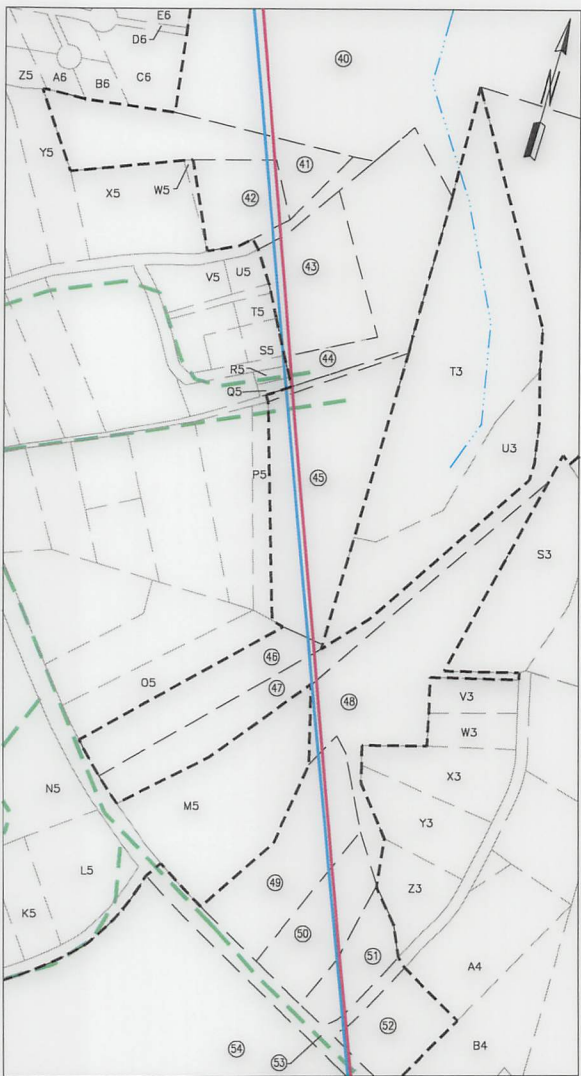

DETAIL "D"



I, THE UNDERSIGNED, HEREBY CERTIFY THAT THIS PLAT IS
CORRECT TO THE BEST OF MY KNOWLEDGE AND BELIEF AND SHOWS
ALL THE INFORMATION REQUIRED BY LAW AND REGULATIONS ISSUED
AND PRESCRIBED BY THE DEPARTMENT OF ENVIRONMENTAL PROTECTION.

P.S. 708

David L Jackson

07/25/2025

REVISIONS:

COMPANY:

SWN

Production Company, LLC

SWN

Production Company™

OPERATOR'S STATE OF WV DNR C BRK

WELL #: 206H

DISTRICT:
CROSS CREEK

COUNTY:
BROOKE

API:
47-009-00341

STATE:
WV

DATE: 10-02-2024

DRAWN BY: COCKERHAM

SCALE: N/A

DRAWING NO:

WELL LOCATION PLAT 4

JACKSON SURVEYING
INC.
2413 EAST PIKE ST. # 112
Clarksburg, WV 26302
304-623-5851

	WELL BORE TRACTS	
TRACT	SURFACE OWNER (S) / ROYALTY OWNER (R)	TAX PARCEL
1	WEST VIRGINIA ST OF BUREAU OF COMM DIV OF NAT RES PB LD CORP (S/R)	4-CC20-06
TRACT	SURFACE OWNER (S)	TAX PARCEL
2	WEST VIRGINIA ST OF BUREAU OF COMM DIV OF NAT RES PB LD CORP (S)	4-CC19-169
3	GALIANO LINDY L (S)	4-CC19-170
4	NORFOLK & WESTERN RAILWAY CO (S)	4-C19K-18
5	WEST VIRGINIA ST OF BUREAU OF COMM DIV OF NAT RES PB LC CORP (S)	4-CC23-325
6	CROSS RAYMOND S DENNIS P & BUTLER KATHRYN R (S)	4-CC24-13
7	WALLACE RICHARD L & TRACEY (S)	4-CC24-14
8	LYNCH THERESA ANN(LE-CHARLES & ELLEN THORNE (S)	4-CC24-16
9	COLLINS RANDY L JR & AMY R (SURVIVORSHIP (S)	4-CC24-17
10	PEHANICH DIANA LYNN TOD MICHELLE ALLMAN (S)	4-CC24-15
11	TAYLOR BUDDY JR (S)	4-CC24-46
12	THOMPSON RANDALL L (S)	4-CC24-45
13	FILLINGER JOHN O (S)	4-CC24-44
14	WHITE ROGER DALE (S)	4-CC24-32
15	MCCLOUD PAULETTE (S)	4-CC24-33
16	BRADLEY GEORGE L (S)	4-CC24-55
17	JOHNS LESLIE J & MELLISA J (JTWS) (S)	4-CC24-99
18	BRADY RALPH A & KIM (SURV) (S)	4-CC24-90
19	FERGUSON BRIAN L & NANCY J (SURV) (TOD) (S)	4-CC24-89
20	HUFFNER JAMES E & PATRICIA (S)	4-CC24-88
21	CECCHINI CHRISTOPHER (S)	4-CC24-86
22	FERGUSON TODD & LISA (SURV) (S)	4-CC24-120
23	CECCHINI CHRISTOPHER L (S)	4-CC24-124
24	BARCHIESI GEORGE A & PAMELA J (SURV) (S)	4-CC24-125
25	STATE OF WEST VIRGINIA DEPARTMENT OF TRANSPORTATION, DIVISION OF HIGHWAYS (S)	BUCKEY HILL ROAD
26	HURLEY VALERIE E & ROBERT L BERGMAN (S)	4-CC29-25
27	MCCANN ROBERT H & CANDACE A(SURV) (S)	4-CC29-35
28	FERDA WILLIAM M & CYNTHIA A (S)	4-CC29-44
29	CLEM ROGER L & MILDRED O JTWS (TUD) (S)	4-CC29-63
30	RINEY DOUGLAS G & BLANCA A (SURV) (S)	4-CC29-50
31	RINEY DOUGLAS G & BLANCA A (SURV) (S)	4-CC29-51
32	CYPHERT DEBRA-1/2;FAIR MATTHEW 1/4;BRUFFY SUSAN-1/4 (S)	4-CC29-57
33	CYPHERT DEBRA R (S)	4-CC29-57.2
34	KRAFT JEREMIAH ET AL (S)	4-CC29-52
35	MUSCEDERE EMILIO A & JUDITH A (S)	4-CC29-53
36	CAMPBELL ERIC W (S)	4-CC29-117
37	YOUNG ROBERT L (S)	4-CC29-132
38	AUBER ARTHUR D & GERALDINE A (S)	4-CC29-139
39	AUBER ARTHUR D & GERALDINE A (SURV) (S)	4-CC29-142
40	FRESHWATER ROBERT LEE (S)	4-CC29-134
41	CLAMPITT NORMAN C & JEANETTA K (SURV) (S)	4-CC29-190
42	CLAMPITT NORMAN C & JEANETTA K (SURV) (S)	4-CC29-191
43	PACKER JAMI DANIELLE (S)	4-CC29-192.1
44	PACKER JAMI (S)	4-CC29-192
45	PLATTER MARVIN E JR & KATHY A (SURV) (S)	4-CC29-212
46	KLAGES KEITH C (S)	4-CC29-217
47	STEWART RUTH ANN 1/2; JACKSON MADELON DAWN 1/2 TOD (S)	4-CC29-194
48	MINOR LISA (S)	4-CC29-194.1
49	RUDLAND JOHN (S)	4-CC29-220
50	LYLE MONICA T (S)	4-CC29-221
51	RASZ MICHAEL RAYMOND (S)	4-CC29-221.1
52	MINOR LISA M (S)	4-CC29-233
53	WEST VIRGINIA DEPARTMENT OF TRANSPORTATION,	STATE ROUTE 27 A/K/A
54	HIGHLAND SPRINGS GOLF COURSE LLC (S)	3-B29-18
55	HIGHLAND SPRINGS GOLF COURSE (S)	370-007-06
56	BROWNLEE LAND VENT LP (S)	370-007-05
57	CUNNINGHAM PAUL A (S)	370-007-04
58	BELLVIEW CAMP MEETING ASSO DAVID STONER (TREASURER) (S)	370-007-03
59	BROWNLEE LAND VENT (S)	370-011-07
60	SENG RONALD BERNARD & JOANNE ALICE (S)	370-011-06
61	RUSH GARY (S)	370-011-08
62	TAYLOR 2016 REVOC TRUST KENNETH LEE & ANN MARIE TRUSTEES (S)	370-011-02

07/25/2025

REVISIONS:	COMPANY:		SWN Production Company, LLC SWN Production Company™ R²_A → V⁺ ®	
OPERATOR'S		STATE OF WV DNR C BRK	API:	DATE: 10-02-2024
WELL #:		206H	47-009-00341	DRAWN BY: COCKERHAM
DISTRICT:		CROSS CREEK	COUNTY:	SCALE: N/A
		BROOKE	STATE:	DRAWING NO:
			WV	WELL LOCATION PLAT 5



07/25/2025

JACKSON SURVEYING
INC.
2413 EAST PIKE ST. # 112
Clarksburg, WV 26302
304-623-5851

ADJOINING OWNERS TABLE		
TRACT	SURFACE OWNER	TAX PARCEL
A	BREEN SUSAN D & DENNIS M	4-CC20-22
B	COLLIERS SPORTSMAN CLUB	4-CC20-21
C	ROUSE WILLIAM MORGAN & DORIS J	4-CC20-20
D	BLACK LINDY L	4-CC20-7
E	GALIANO LINDY L &	4-CC20-19.1
F	CARTER EDWARD L & DEBORAH C JTWS	4-CC20-18
G	CARTER EDWARD L	4-CC20-17
H	GALIANO ERIC T	4-CC20-16
I	GALIANO ERIC T	4-CC20-14
J	GALIANO ERIC T	4-CC20-19
K	MCCONNELL KEVIN	4-CC20-11
L	MCCONNELL BARBARA J	4-CC20-10
M	PRONCHIK SUSAN KAY	4-CC20-8
N	BERNARDINI JUDITH ANN	4-CC20-9
O	BERNARDINI MICHAEL LEE & JULIE LYNN (SURV)	4-CC20-44
P	NORFOLK & WESTERN RAILWAY CO	4-C24B-29
Q	NICKOLES 3 LLC	4-CC20-33
R	WEST VIRGINIA ST OF BUREAU OF COMM DIV OF NAT RES PB LD CORP	4-CC24-3
S	CORK BRANDON & LORETTA SANCHEZ	4-CC24-8
T	VAUGHN MARK E & LISA A (SURV)	4-CC24-9
U	MIHLBAUER DAVID A & TERI L	4-CC24-10
V	PETTRY OTTIS T	4-CC24-12
W	FILLINGER JOHN O	4-CC24-43
X	MCCLOUD JIM R & MARTHA SURV	4-CC24-42
Y	MCCLOUD JIM R & MARTHA SURV	4-CC24-41
Z	MCCLOUD JIM R & MARTHA SURV	4-CC24-40
A2	SMITH WICKIE L	4-CC24-39
B2	HUNTER WILLIAM R & GLORIA J	4-CC24-38
C2	CRAWFORD BERNARD E (TOD) & WILMA L	4-CC24-37
D2	CRAWFORD BERNARD E (TOD) & WILMA A	4-CC24-36
E2	SHINGLE EVA & RAYMOND	4-CC24-35
F2	SHINGLE EVA RAYMOND	4-CC24-34
G2	OBER MICHAEL	4-CC24-7
H2	SMITH DEAN	4-CC24-98
I2	MCFADDEN MICHAEL K & SHARON (SURV)	4-CC24-93
J2	CIPRIANI MICHAEL J	4-CC24-142
K2	CIPRIANI MICHAEL J	4-CC24-141
L2	EARNEST JACK & LESLIE M (SURV)	4-CC24-138
M2	FARRELL KEVIN M & HEIDI J (SURV)	4-CC24-92
N2	FARRELL KEVIN M & HEIDI J (SURV)	4-CC24-91
O2	MARKS EDWARD ROBERT III & TONI JO (SURV)	4-CC24-117
P2	SICURELLA PAUL J & LEA M (SURV)	4-CC24-118
Q2	BOOTH JERRY M & DEBRA D (SURV)	4-CC24-119
R2	BOOTH JERRY MARTIN & DEBRA DEAN (JTWS)	4-CC24-99.9
S2	FERGUSON TODD P & LISA (SURV)	4-CC24-99.1
T2	BARCHIESI GEORGE A & PAMELA J (SURV)	4-CC24-122
U2	RUSH JAMES H & JANE A (SURV)	4-CC24-121
V2	JOHNS LESLIE J & MELLISA J (JTWS)	4-CC24-99
W2	JONES PATRICK	4-CC24-129.1
X2	MITCHELL JESSE ETAL (LE-EUGENE JR & MARGARET MITCHELL)	4-CC24-126
Y2	HARTER MELISSA K & CHRISTOPHER J	4-CC29-26
Z2	SHERNISKY THOMAS J	4-CC29-36
A3	HICKS RONALD LEE & DEBRA V	4-CC29-43
B3	KUSICH GARY & PATRICIA ELAINE	4-CC29-62
C3	KUSICH GARY & PATRICIA ELAINE	4-CC29-61
D3	FERDA BRIAN T & VI-EVA (SURV)	4-CC29-60
E3	FERDA BRIAN T & VI-EVA (SURV)	4-CC29-59
F3	FERDA BRIAN T & VI-EVA (SURV)	4-CC29-58
G3	MUSCEDERE EMILIO A & JUDITH A	4-CC29-54
H3	LYLE JOHN H JR & MARY CATHERINE	4-CC29-55
I3	LYLE JOHN H JR & MARY C (SURV)	4-CC29-56
J3	NEWTON ROBERT R JR	4-CC29-41.1
K3	PAPSON NATALIE J	4-CC29-41
L3	HONE MARK A & LAUREN M (SURV)	4-CC29-39.2
M3	MITCHELL ARLEY R & NANCY E (SURV)	4-CC29-39.11
N3	MCCLAIN DAVID H & KAREN (SURV)	4-CC29-39.7
O3	CATTARUZZA ELLEN M	4-CC29-39
P3	BROWNLEE LAND VENTURES	370-001-15
Q3	STATE LINE REAL EST LLC	370-04-01
R3	SMITH NEALE & JOAN W (SURV)	4-CC29-194.2
S3	CHAMBERS JASON & CHAROLETTE (JTWS)	4-CC29-27
T3	STEWART RUTH ANN 1/2; JACKSON MADELON DAWN 1/2 TOD	4-CC29-193
U3	STEWART RUTH ANN 1/2; JACKSON MADELON DAWN 1/2 TOD	4-CC29-213
V3	LEMASTERS HARVEY C & ADA L	4-CC29-226
W3	LEMASTERS HARVEY C & ADA L	4-CC29-225
X3	MARSHALL HAROLD L JR & LINDA K (SURV)	4-CC29-224
Y3	MARSHALL HAROLD L JR & LINDA K (SURV)	4-CC29-223
Z3	PRAGER KEN J & PAULA L (JTWS)	4-CC29-222
A4	MINOR LISA M 2/3 & MARK MINOR 1/3	4-CC29-232
B4	L & M RENTALS LLC	4-CC29-234
C4	MILLS DARREN P	4-CC29-235
D4	SMITH NICOLE R & NEALE	370-07-1.2
E4	DEPETRO JOSEPH J III	370-07-01
F4	BRIGGS ROBERT G & NANCY L	370-07-02
G4	DEPETRO JOSEPH J III	370-11-09
H4	JACOBS LISA J & TERRY G	370-11-9.1
I4	DEPETRO JOSEPH J III	370-11-9.2
J4	CUNNINGHAM PAUL A	370-12-02

ADJOINING OWNERS TABLE		
TRACT	SURFACE OWNER	TAX PARCEL
K4	BROWNLEE ANDREA GEORGETTI	370-12-01
L4	BROWNLEE LAND VENT LP	370-11-01
M4	MULLINS JOHN JR	370-11-3.1
N4	BROWNLEE LAND VENT LP	370-11-04
O4	APPALACHIA MIDSTREAM SERVICES LLC	3-B34-66
P4	BROWNLEE LAND VENTURES LP	3-B34-78
Q4	HIGHLAND SPRINGS GOLF COURSE LLC	3-B34-80
R4	FELTON DANIEL KEVIN	3-B34-79
S4	ANKRUM ERIN C. (ETAL)	3-B34-82
T4	MITCHELL MELANIE	3-B34-84
U4	HUNT WILLIAM CURTIS & SUSAN L (SURV) (TOD) SCOTT KRISTEN E	3-B34-7
V4	PAULL CHRISTOPHER J & MARY ELLEN (SURV)	3-B34-4
W4	PAULL CHRISTOPHER J & MARY E (SURVIVORSHIP)	3-B34-3
X4	PAULL CHRISTOPHER J & MARY E	3-B29-15.2
Y4	DIAMOND JANA L	3-B29-15.1
Z4	HONE MARK A & LAUREN M JTWS	3-B29-19
A5	HONE MARK A & LAUREN M JTWS	3-B29-20
B5	HONE MARK A & LAUREN M JTWS	3-B29-21
C5	SANFORD HARRY E; NEELY CHATMAN L (SURV)	3-B29-16
D5	CHIVERS NORMA E; CHIVERS ALAN J. ETAL	3-B29-12
E5	MALUNKY KEITH & KIM	3-B29-22
F5	CHIVERS NORMA E; TOD CHIVERS ALAN J. ETAL	3-B29-11
G5	SONDA HAROLD S & SHIRLEY J	3-B29-10
H5	SONDA HAROLD S & SHIRLEY	3-B29-9
I5	SKYWATCHER LINDA TOD; SKYWATCHER DANIEL (ETAL)	3-B29-23
J5	SHIDOCK HOWARD & ARLENE	3-B29-8
K5	HIGHLAND SPRINGS GOLF COURSE LLC	3-B29-7
L5	HIGHLAND SPRINGS GOLF COURSE LLC	3-B29-6
M5	CONNOLLY BRIAN & TAMMY	4-CC29-219
N5	ROBERSON CHARLES M & DOROTHY	3-B29-5
O5	RYAN TIMOTHY A & SONDR A M	4-CC29-216
P5	JACKSON DOUGLAS HOWARD	4-CC29-212.1
Q5	PLATTER MARVIN E JR & KATHY A (SURV)	4-CC29-192.2
R5	HIMMELRICK NATHAN S	4-CC29-192.3
S5	HIMMELRICK NATHAN S	4-CC29-198
T5	HIMMELRICK NATHAN S	4-CC29-195
U5	CLAMPITT NORMAN C & JEANETTA K (SURV)	4-CC29-197
V5	KOWCHECK MARK & THERESA (SURV)	4-CC29-195.1
W5	CLAMPITT NORMAN C & JEANETTA K	4-CC29-189.1
X5	HUNTER ELEANORE M	4-CC29-189
Y5	CALVERT HAROLD	4-CC29-188
Z5	WILEY DEAN A & PALMER HELENA M (SURV)	4-CC29-174
A6	FRESHWATER MELISSA J	4-CC29-171
B6	FRESHWATER MELISSA J	4-CC29-169
C6	FRESHWATER ROBERT LEE	4-CC29-168
D6	MAIN DRIVE CIVIC ASSOC INC	4-CC29-155.1
E6	MAIN DRIVE CIVIC ASSOC INC	4-CC29-167
F6	FRESHWATER ROBERT LEE	4-CC29-166
G6	FRESHWATER ROBERT LEE	4-CC29-165
H6	FRESHWATER ROBERT LEE	4-CC29-164
I6	HAGLER CHARLES	4-CC29-162
J6	BLANKENSHIP PHILLIP E	4-CC29-153
K6	ODKAN HEATHER LEE	4-CC29-152.1
L6	REID JANIS BARNA	4-CC29-149
M6	BILLIARD PAUL;TIMOTHY;WALES KIM LE-CAROL BILLIARD	4-CC29-148
N6	FILKINS RANDY	4-CC29-147
O6	MAYNARD COREY L	4-CC29-146
P6	BONAR JAMES L & MARY JEAN (SURV)	4-CC29-144
Q6	MACFAWN IAN & NANCY (JTWS)	4-CC29-143
R6	AUBER ARTHUR D & GERALDINE	4-CC29-141
S6	AUBER ARTHUR D & GERALDINE	4-CC29-140
T6	AUBER ARTHUR & GERALDINE A	4-CC29-138
U6	OHLER LORI ANN & RICKI (SURV)	4-CC29-137
V6	PAULL JOHN	4-CC29-136
W6	HARTZER JAMES N & EVANS HARTZER CAROLE G (SURV)	4-CC29-135
X6	FLUHARTY JERRY & MARY	4-CC29-133
Y6	GEORGETTI ANDREW	4-CC29-131
Z6	GEORGETTI ANDREW	4-CC29-130
A7	GEORGETTI ANDREW	4-CC29-129
B7	ANDREWS DONALD W & JERI L (SURV)	4-CC29-128
C7	ANDREWS DONALD & JERI	4-CC29-127
D7	DISERIO PAUL RAYMOND & KATHY A	4-CC29-126
E7	CAMPBELL ERIC WILLIAM	4-CC29-119
F7	GAGICH DIANA KIM	4-CC29-117.1
G7	KRAFT JEREMIAH ET AL	4-CC29-111
H7	CYPHERT DEBRA-1/2;FAIR MATTHEW 1/4;BRUFFY SUSAN-1/4	4-CC29-57
I7	HUNTER CLARA MAE NKA JACKSON CLARA TUD	4-CC29-49
J7	EATON JAMES W	4-CC29-45
K7	JOZWICK RICHARD A & KAREN A	4-CC29-46
L7	KEENER JEROLD M & CYNTHIA L	4-CC29-33
M7	CLEM MICHAEL G	4-CC29-23
N7	HURLEY VALERIE E & ROBERT L BERGMAN	4-CC29-24
O7	ROHR ANITRA	4-CC24-124.1
P7	FERGUSON DREW	4-CC24-84.1
Q7	BOLEN MICHAEL SCOTT	4-CC24-85
R7	HUFFNER JAMES E & PATRICIA A (SURV)	4-CC24-99.6
S7	CECCHINI CHRISTOPHER L	4-CC24-87
T7	HEFFNER TERRI	4-CC24-84
U7	MALONEY CHARLES WAYNE & NANCY L (JTWS) (TOD)	4-CC29-17
V7	STEVENS JOHN & LUNDA	4-CC24-56

07/25/2025

REVISIONS:	COMPANY:			
	SWN Production Company, LLC SWN Production Company™			
	OPERATOR'S	STATE OF WV DNR C BRK	API:	DATE: 10-02-2024
	WELL #:	206H	47-009-00341	DRAWN BY: COCKERHAM
	DISTRICT:	CROSS CREEK	COUNTY:	SCALE: N/A
			STATE:	DRAWING NO:
			WV	WELL LOCATION PLAT 6

07/25/2025

REVISIONS:		COMPANY:	
		Production Company, LLC	
		Production Company, LLC	
		DATE: 10-02-2024	
		DRAWN BY: COCKERHAM	
		SCALE: N/A	
		DRAWING NO:	
		WELL LOCATION PLAT 6	
DISTRICT:		COUNTY:	
CROSS CREEK		BROOKE	
WELL #:		206H	
OPERATOR:		STATE OF WV DNR C BRK	
API:		47-009-00341	
DATE:		10-02-2024	

10-02-2025 BACKUP/10-02-25 07:25:08:19AM
TUESDAY FEBRUARY 11 2025 08:19AM

TRACT	SURFACE OWNER	TAX PARCEL

304-623-8881
Clarkspurd, WV 26302
25413 EAST PIKE ST. # 112
INC.
JACKSON SURVEYING


JACKSON SURVEYING
INC.
2413 EAST PIKE ST. # 112
Clarksburg, WV 26302
304-623-5851

ADJOINING OWNERS TABLE		
TRACT	SURFACE OWNER	TAX PARCEL
W7	KLAGES KEVIN W & LINDA K SURV	4-CC24-52
X7	KLAGES KEVIN W & LINDA K SURV	4-CC24-51
Y7	GOOCH JUDITH L (ETAL)	4-CC24-49
Z7	BRADLEY GEORGE L	4-CC24-132
A8	LEMASTERS DONALD & JOYCE (SURV)	4-CC24-23
B8	FIGUEROA KAIA	4-CC24-24
C8	BURDINE CALVIN G & BOYCE HANNA M (JTWS)	4-CC24-25
D8	LAUCK MARIE	4-CC24-26
E8	MOZINGO WARREN HARRY & LINDA DIANE (SURV)	4-CC24-27
F8	COLEMAN ROBERT B & SHERRY E (SURVIVORSHIP)	4-CC24-28
G8	TAYLOR BUDDY L JR & PATRICIA L (SURV)	4-CC24-29
H8	ADAMS JASON R	4-CC24-30
I8	WHITE ROGER DALE	4-CC24-31
J8	TAYLOR JENNIFER	4-CC24-47
K8	HUNTER ROBERT JR	4-CC24-48
L8	COLLINS RANDY L JR & AMY R (SURVIVORSHIP)	4-CC24-18
M8	JOHNS ALBERT;GARY;GREGORY;MOORE TAMMY	4-CC23-326
N8	BAIRD WILLIAM C & CYNTHIA L (SURV)	4-CC24-5
O8	CZESZTYICKI JOSEPH P & TOM METZ	4-CC24-6
P8	THOMPSON DEBRA J	4-CC23-320
Q8	BARONIO CURTIS R & DONNA J	4-CC23-321
R8	COOK FAMILY REVOCABLE TRUST 4/20/17, MALSON SUSAN A	4-CC23-322
S8	MENEELY BOBBIE JO; MINICH RANDALL	4-CC23-324
T8	CARBASHO THOMAS & CALDWELL TINA	4-CC23-323
U8	POWER ADRIAN ELIZABETH & EMIL JAMES LOPPE (JTWS)	4-CC19-185
V8	MOORE CHARLES D & CECELIA FAY (JTWS)	4-CC19-180
W8	EDGELL ROSA MARIE	4-CC19-176
X8	EVANGELINOS CONSTANTINE & TOULA (SURV)	4-CC19-171
Y8	D'AGOSTINO PETER	4-CC19-188
Z8	NICKOLES GREGORY; RANDY;JEFFRE (LE-DANNY & GRACE NICKOLES)	4-CC19-160
A9	BAKER DAVID	4-CC19-164
B9	EMMERTH DOUGLAS P & PAMELA L JTWS	4-CC19-165
C9	STATE OF WEST VIRGINIA BUREAU OF COMMERCE DIV OF NAT RESOURC	4-CC19-168
D9	LANGEVIN GRETCHEN MOORE WESBANCO BANK INC	4-CC20-5
E9	MILLER JOHN ERNEST, JESSE ANDREW (SURV)	4-CC20-4

07/25/2025

REVISIONS:	COMPANY:	SWN Production Company, LLC SWN Production Company™		
	OPERATOR'S	STATE OF WV DNR C BRK	API:	DATE: 10-02-2024
	WELL #:	206H	47-009-00341	DRAWN BY: COCKERHAM
	DISTRICT:	CROSS CREEK	COUNTY:	SCALE: N/A
			STATE:	DRAWING NO:
			WV	WELL LOCATION PLAT 7




