

LEGEND:	
	PROPOSED SURFACE HOLE \ BOTTOM HOLE
	EXISTING \ PRODUCING WELLHEAD
	LANDING POINT LOCATION
	EXISTING WATER WELL
	EXISTING SPRING
	SURVEYED BOUNDARY
	DRILLING UNIT
	LEASE BOUNDARY
	ASDRILLED PATH
	PROPOSED PATH
REVISIONS:	
DATE: 08-23-2024	
DRAWN BY: N. MANO	
SCALE: 1" = 2000'	
DRAWING NO:	
WELL LOCATION PLAT	


CITY: MORGANTOWN	STATE: WV	ZIP CODE: 26508
ADDRESS: 1300 FORT PIERPOINT ROAD, SUITE 200		
WELL OPERATOR: SWN PRODUCTION COMPANY, LLC		
DESIGNATED AGENT: BRITANNY WOODY		

TARGET FORMATION: MARCELLUS	
CONVERT: 07/25/2025	
CLEAN OUT & REPLUG ☐ OTHER CHANGE ☐ (SPECIFY) ASDRILLED	
PLUG OFF OLD FORMATION ☐ PERFORATE NEW FORMATION ☐	

OIL & GAS ROYALTY OWNER: NATURAL RESOURCES, PUBLIC LAND CORPORATION	
SURFACE OWNER: NATURAL RESOURCES, PUBLIC LAND CORPORATION	
DISTRICT: CROSS CREEK	
COUNTY: BROOKS	
WATERSHED: NORTH FORK CROSS CREEK - CROSS CREEK (HUC-10)	
WELL TYPE: OIL ☐ WASTE DISPOSAL ☐ PRODUCTION ☒ DEEP ☐ GAS ☒ LIQUID INJECTION ☐ STORAGE ☐ SHALLOW ☒	

ELEVATION: (NAVD 88, US FT)	
SOURCE OF GRADE GPS	
PROVEN SURVEY	
ACCURACY: 1/500	
DEGREE OF	
MINIMUM	
OPERATOR'S WELL #:	
STATE: COUNTY: PERMIT:	
47 009 00342	
STATE OF WV DNR C BRK	

COMPANY:	
SWN	
Production Company, LLC	
Production Company	

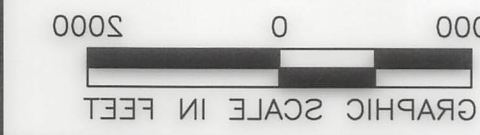


NOTES ON SURVEY

1. SURFACE AND ROYALTY OWNER INFORMATION AND THEIR BOUNDARIES SHOWN HEREON WERE PLOTTED FROM DEEDS AND/OR TAX PARCEL MAPS PROVIDED BY CLIENT AND/OR FIELD LOCATIONS.
2. THIS PLAT DOES NOT REPRESENT A BOUNDARY SURVEY OF THE PARCELS SHOWN HEREON.
3. ALL INSETS ARE GRID NORTH UNLESS OTHERWISE DEPICTED.
4. THE UNDERSIGNED, HEREBY CERTIFY THAT THIS PLAT IS CORRECT TO THE BEST OF MY KNOWLEDGE AND BELIEF AND SHOWS ALL THE INFORMATION REQUIRED BY LAW AND REGULATIONS ISSUED AND PRESCRIBED BY THE DEPARTMENT OF ENVIRONMENTAL PROTECTION.

David Jackson

WELL RESTRICTIONS

1. NO OCCUPIED DWELLINGS > 2500 FT. WITHIN 625 FEET OF CENTER OF PAD.
2. NO AGRICULTURE BUILDINGS > 2500 FT. WITHIN 625 FEET OF CENTER OF PAD.
3. NO WATER WELLS OR DEVELOPED SPRINGS ARE WITHIN 250 FEET OF PROPOSED WELL.
4. NO PERENNIAL STREAMS, LAKES, PONDS, OR RESERVOIRS WITHIN 100 FEET OF THE LIMITS OF DISTURBANCE.
5. NO NATURALLY PRODUCING TROUT STREAM WITHIN 300 FEET OF LIMITS OF DISTURBANCE.
6. NO GROUND INTAKE OR PUBLIC WATER SUPPLY WITHIN 1000 FEET OF WELL PAD LIMITS OF DISTURBANCE, E & S CONTROLS OR PUBLIC WATER SUPPLY.

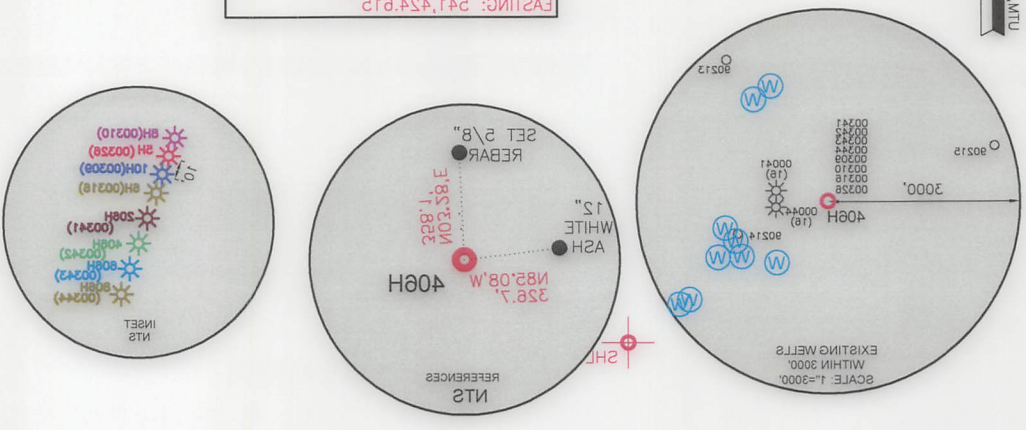

SURFACE HOLE LOCATION (SHL):			
UTM (NAD83, ZONE 17, METERS):	EASTING: 230,587.183	NORTHING: 4,481,408.881	
LANDING POINT (LPL):			
UTM (NAD83, ZONE 17, METERS):	EASTING: 238,725.938	NORTHING: 4,481,120.935	
BOTTOM HOLE LOCATION (BHL):			
UTM (NAD83, ZONE 17, METERS):	EASTING: 241,424.815	NORTHING: 4,424,024.252	



LINE	BEARING	DISTANCE	DESCRIPTION	MONUMENT
L1	N 35.34°01' W	104.317'	SHL TO LANDMARK	2" IRON PIPE FOUND
L2	N 88.05°42' W	1320.17'	SHL TO LANDMARK	STONE FOUND
L4	S 20.10°18' E	89.98'	ASLT TO ASLT	
LINE	BEARING	DISTANCE	CURVE LENGTH	DESCRIPTION
L3	S 83.40°43' W	2024.34'	227.88'	SHL TO LP

BOTTOM HOLE LOCATION (BHL):			
UTM (NAD83, ZONE 17, METERS):	EASTING: 241,418.828	NORTHING: 4,424,024.252	
LANDING POINT (LPL):			
UTM (NAD83, ZONE 17, METERS):	EASTING: 238,719.478	NORTHING: 4,481,130.925	
SURFACE HOLE LOCATION (SHL):			
UTM (NAD83, ZONE 17, METERS):	EASTING: 230,587.224	NORTHING: 4,481,408.881	

JACKSON SURVEYING
INC.
2413 EAST PIKE ST. # 115
Clarksburg, WV 26305
304-853-8851

Latitude: 40°20'00" - SURFACE HOLE 10,211'
Latitude: 40°12'00" - BOTTOM HOLE 2,138'
Latitude: 40°20'00" - SURFACE HOLE 11,359'

JACKSON SURVEYING
INC.
2413 EAST PIKE ST. # 112
Clarksburg, WV 26302
304-623-5851



I, THE UNDERSIGNED, HEREBY CERTIFY THAT THIS PLAT IS
CORRECT TO THE BEST OF MY KNOWLEDGE AND BELIEF AND SHOWS
ALL THE INFORMATION REQUIRED BY LAW AND REGULATIONS ISSUED
AND PRESCRIBED BY THE DEPARTMENT OF ENVIRONMENTAL PROTECTION.

P.S. 708

David L Jackson



07/25/2025

REVISIONS:		COMPANY:		DATE: 08-29-2024	
		SWN		DRAWN BY: N. MANO	
		Production Company, LLC		SCALE: N/A	
		OPERATOR'S STATE OF WV DNR C BRK		DRAWING NO:	
		WELL #: 406H		WELL LOCATION PLAT 2	
		DISTRICT: CROSS CREEK			
		COUNTY: BROOKE			
		STATE: WV			
		API: 47-009-00342			



AND PRESCRIBED BY THE DEPARTMENT OF ENVIRONMENTAL PROTECTION
 AT THE INFORMATION REQUIRED BY LAW AND REGULATIONS ISSUED
 CORRECT TO THE BEST OF MY KNOWLEDGE AND BELIEF AND SHOWS
 I, THE UNDERSIGNED, HEREBY CERTIFY THAT THIS PLAN IS



07/25/2025

JACKSON SURVEYING
INC.
2413 EAST PIKE ST. # 112
Clarksburg, WV 26302
304-623-5851



I, THE UNDERSIGNED, HEREBY CERTIFY THAT THIS PLAT IS
CORRECT TO THE BEST OF MY KNOWLEDGE AND BELIEF AND SHOWS
ALL THE INFORMATION REQUIRED BY LAW AND REGULATIONS ISSUED
AND PRESCRIBED BY THE DEPARTMENT OF ENVIRONMENTAL PROTECTION.

P.S. 708

David L Jackson



07/25/2025

REVISIONS:		COMPANY:		DATE: 08-29-2024	
		SWN		DRAWN BY: N. MANO	
		Production Company, LLC		SCALE: N/A	
		OPERATOR'S STATE OF WV DNR C BRK		DRAWING NO:	
		WELL #: 406H		WELL LOCATION PLAT 3	
		DISTRICT: CROSS CREEK			
		COUNTY: BROOKE			
		STATE: WV			

JACKSON SURVEYING
INC.
3043 EAST PIKE ST. # 115
Clarkspurg, WV 26305
304-853-8851




I, THE UNDERSIGNED, HEREBY CERTIFY THAT THIS PLAT IS
CORRECT TO THE BEST OF MY KNOWLEDGE AND BELIEF AND SHOWS
ALL THE INFORMATION REQUIRED BY LAW AND REGULATIONS ISSUED
AND PRESCRIBED BY THE DEPARTMENT OF ENVIRONMENTAL PROTECTION.

David Jackson 07/25/2025


REVISIONS:		COMPANY:	
		Production Company, LLC	
		Production Company, LLC	
		DATE: 08-25-2024	
		DRAWN BY: N. MANO	
		SCALE: N/A	
		DRAWING NO:	
		WELL LOCATION PLAT 3	
DISTRICT: CROSS CREEK		COUNTY: BROOKE	STATE: WV
WELL #: 408H		APL: 47-009-00345	
OPERATOR'S: STATE OF WV DNR C BRK		DATE: 08-25-2024	

JACKSON SURVEYING
INC.
2413 EAST PIKE ST. # 112
Clarksburg, WV 26302
304-623-5851

DETAIL "B"

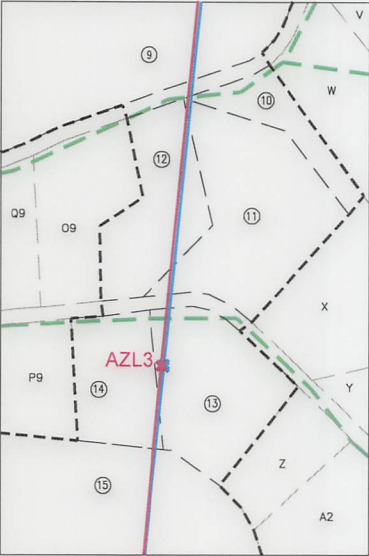


DETAIL "A"

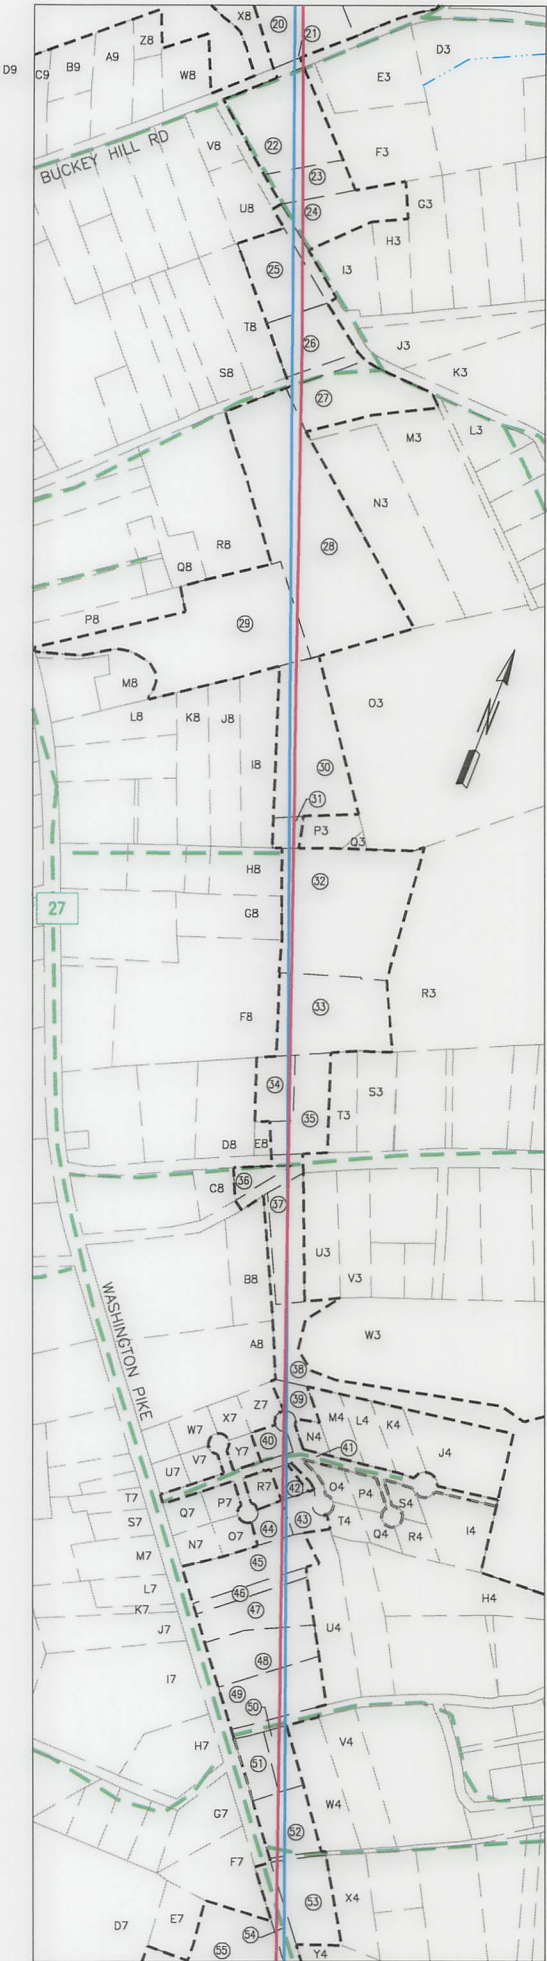


JACKSON SURVEYING
INC.
2413 EAST PIKE ST. # 115
Clarkspurt, WV 26305
304-653-2821

DETAIL "B"

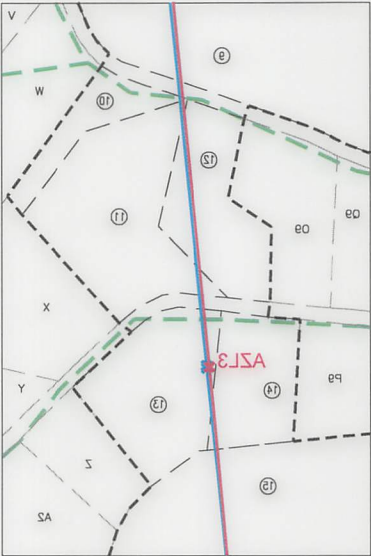

DETAIL "A"

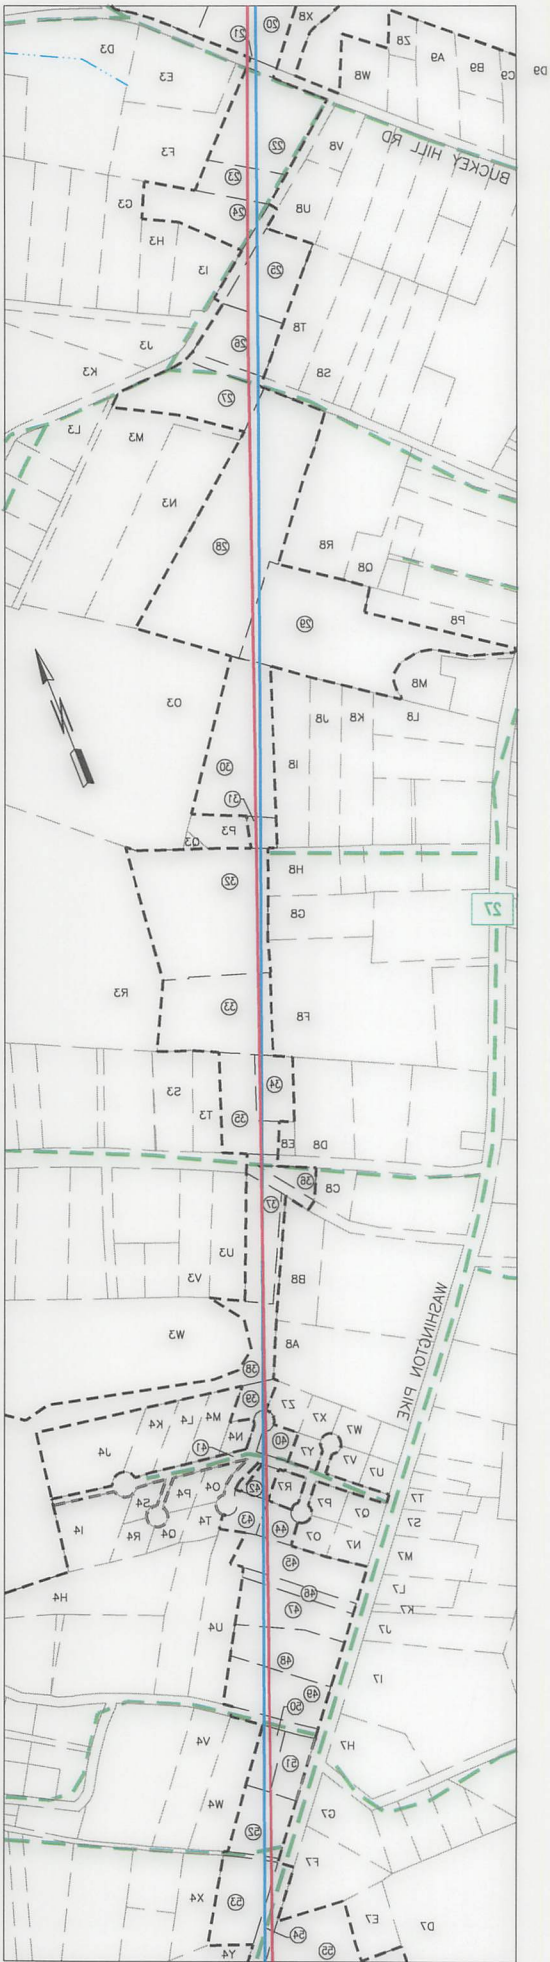

I, THE UNDERSIGNED, HEREBY CERTIFY THAT THIS PLAT IS
CORRECT TO THE BEST OF MY KNOWLEDGE AND BELIEF AND SHOWS
ALL THE INFORMATION REQUIRED BY LAW AND REGULATIONS ISSUED
AND PRESCRIBED BY THE DEPARTMENT OF ENVIRONMENTAL PROTECTION.

David Jackson 07/25/2025

REVISIONS:		COMPANY:	
		Production Company, LLC	
		Production Company, LLC	
		DATE: 08-20-2024	
		DRAWN BY: N. MAND	
		SCALE: N/A	
		DRAWING NO:	
		WELL LOCATION PLAT 4	
DISTRICT: CROSS CREEK		COUNTY: BROOKE	STATE: WV
WELL #: 408H		API: 47-009-00345	
OPERATOR'S: STATE OF WV DNR C BRK		DATE: 08-20-2024	

JACKSON SURVEYING
INC.
2413 EAST PIKE ST. # 112
Clarksburg, WV 26302
304-623-5851

WELL BORE TRACTS		
TRACT	SURFACE OWNER (S) / ROYALTY OWNER (R)	TAX PARCEL
1	WEST VIRGINIA ST OF BUREAU OF COMM DIV OF NAT RES PB LD CORP (S/R)	4-CC20-6
TRACT	SURFACE OWNER (S)	TAX PARCEL
2	WEST VIRGINIA ST OF BUREAU OF COMM DIV OF NAT RES PB LD CORP (S)	4-CC19-169
3	GALIANO LINDY L (S)	4-CC19-170
4	EVANGELINOS CONSTANTINE & TOULA (SURV) (S)	4-CC19-171
5	NORFOLK & WESTERN RAILWAY CO (S)	4-C19K-18
6	STEWART IRR TR 10/1/14 CARLON & BETTY TRUS (S)	4-CC19-172
7	EDGELL ROSA MARIE (S)	4-CC19-176
8	WEST VIRGINIA ST OF BUREAU OF COMM DIV OF NAT RES PB LC CORP (S)	4-CC23-325
9	JOHNS ALBERT; GARY; GREGORY; MOORE TAMMY (S)	4-CC23-326
10	COLLINS RANDY L JR & AMY R (SURVIVORSHIP) (S)	4-CC24-18
11	LICHT JANICE (S)	4-CC24-19
12	JOHNSON KATHY L (S)	4-CC24-19.1
13	COLEMAN ROBERT B & SHERRY E (SURVIVORSHIP) (S)	4-CC24-28
14	MOZINGO WARREN HARRY & LINDA DIANE (SURV) (S)	4-CC24-27
15	BRADLEY GEORGE L (S)	4-CC24-55
16	STEVENS JOHN & LINDA (S)	4-CC24-56
17	MALONEY CHARLES WAYNE & NANCY L (JTWS) (TOD) (S)	4-CC29-17
18	JOHNS LESLIE J & MELLISA J (JTWS) (S)	4-CC24-99
19	HEFFNER TERRI (S)	4-CC24-84
20	HART ERIC; JEFFREY; KRISTOPHER (LE-KENNETH & SANDRA HART) (S)	4-CC29-19
21	WEST VIRGINIA DEPARTMENT OF TRANSPORTION DIVISION OF HIGHWAYS (S)	BUCKEY HILL ROAD
22	SKAGGS PAUL E III (S)	4-CC29-20
23	WOOD HAROLD B; RUNYAN KELLY J (SURV) (S)	4-CC29-27
24	WOOD HAROLD B; RUNYAN KELLY J (SURV) (S)	4-CC29-28
25	ELLIOTT BERNARD JR. LE (S)	4-CC29-65
26	STIMPSON LARRY J & SUSAN K (SURV) (S)	4-CC29-64
27	MCKEE ROBERT M (S)	4-CC29-90
28	WALES MARK A & KIMBERLY A (SURV) (S)	4-CC29-92
29	RIGGS RONALD (S)	4-CC29-100
30	GAGICH JONATHAN & JESSICA L (S)	4-CC29-109.2
31	GAGICH DIANA KIM (S)	4-CC29-109
32	GAGICH DIANA KIM (S)	4-CC29-117.1
33	CAMPBELL ERIC WILLIAM (S)	4-CC29-119
34	DESERIO PAUL R & DESERIO KATHY A (JTWS) (S)	4-CC29-124
35	DISERIO PAUL R (S)	4-CC29-123
36	REID JANIS BARNA (S)	4-CC29-149
37	BILLIARD PAUL;TIMOTHY;WALES KIM LE-CAROL BILLIARD (S)	4-CC29-148
38	FRESHWATER ROBERT LEE (S)	4-CC29-134
39	HAGLER CHARLES (S)	4-CC29-162
40	MARSHALL NATHAN D & REARDON SHANNON (JTWS) (S)	4-CC29-160
41	MAIN DRIVE CIVIC ASSOC INC (S)	4-CC29-155.1
42	ZUMPETTA JOHN L & KAREN R (SURV) (S)	4-CC29-176
43	OLIVEIRA PAUL R & KAREN SUE (SURV) (S)	4-CC29-175
44	THOMA MATTHEW E & TRACI L (S)	4-CC29-178
45	WELCH HATTIE J (S)	4-CC29-183
46	WELCH HATTIE J (S)	4-CC29-184
47	WALES KIMBERLY A & MARK ALLEN (SURVIVOR) (S)	4-CC29-185
48	BILLIARD PAUL T (S)	4-CC29-186.1
49	BILLIARD PAUL T (S)	4-CC29-186
50	HULL ROBERT D (S)	4-CC29-204
51	VOJVODICH MARK D; MELISSA ANN (S)	4-CC29-205
52	LOUNDER ROBERT W & VALARIE J (SURVIVORSHIP) (S)	4-CC29-206
53	HELSEL WILLIAM A (S)	4-CC29-207
54	WEST VIRGINIA DEPARTMENT OF TRANSPORTION DIVISION OF HIGHWAYS (S)	WASHINGTON PIKE A/K/A STATE ROUTE 27
55	ROBERSON CHARLES M & DOROTHY (S)	3-B29-5
56	HIGHLAND SPRINGS GOLF COURSE LLC (S)	3-B29-7
57	SHIDOCK ARLENE R (S)	3-B29-8
58	WEST VIRGINIA DEPARTMENT OF TRANSPORTION DIVISION OF HIGHWAYS (S)	BEALLS RIDGE ROAD
59	HIGHLAND SPRINGS GOLF COURSE LLC (S)	3-B29-18
60	BROWNLEE LAND VENTURES LP (S)	3-B34-78
61	BROWNLEE LAND VENT LP (S)	370-007-5
62	BROWNLEE LAND VENT (S)	370-011-4
63	BROWNLEE LAND VENT (S)	370-011-7
64	TAYLOR 2016 REVOC TRUST KENNETH LEE & ANN MARIE TRUSTEES (S)	370-011-2

07/25/2025

REVISIONS:	COMPANY:		SWN Production Company, LLC SWN Production Company™	
	OPERATOR'S STATE OF WV DNR C BRK		API:	DATE: 08-29-2024
	WELL #: 406H		47-009-00342	DRAWN BY: N. MANO
	DISTRICT: CROSS CREEK	COUNTY: BROOKE	STATE: WV	SCALE: N/A
			DRAWING NO: WELL LOCATION PLAT 5	



07/25/2025

JACKSON SURVEYING
INC.
2413 EAST PIKE ST. # 112
Clarksburg, WV 26302
304-623-5851

ADJOINING OWNERS TABLE		
TRACT	SURFACE OWNER	TAX PARCEL
A	GALIANO LINDY L &	4-CC20-19.1
B	CARTER EDWARD L & DEBORAH C JTWS	4-CC20-18
C	CARTER EDWARD L	4-CC20-17
D	GALIANO ERIC T	4-CC20-16
E	GALIANO ERIC T	4-CC20-14
F	GALIANO ERIC T	4-CC20-19
G	MCCONNELL KEVIN	4-CC20-11
H	MCCONNELL BARBARA J	4-CC20-10
I	PRONCHIK SUSAN KAY	4-CC20-8
J	BERNARDINI JUDITH ANN	4-CC20-9
K	BERNARDINI MICHAEL LEE & JULIE LYNN	4-CC20-44
L	NORFOLK & WESTERN RAILWAY CO	4-C24B-29
M	NICKOLES 3 LLC	4-CC20-33
N	WEST VIRGINIA ST OF BUREAU OF COMM DIV OF NAT RES PB LD CORP	4-CC24-3
O	CORK BRANDON & LORETTA SANCHEZ	4-CC24-8
P	VAUGHN MARK E & USA A (SURV)	4-CC24-9
Q	MIHLBAUER DAVID A & TERI L	4-CC24-10
R	PETTRY OTTIS T	4-CC24-12
S	CROSS RAYMOND S DENNIS P & BUTLER KATHRYN R	4-CC24-13
T	CZESZYCKI JOSEPH P & TOM METZ	4-CC24-6
U	BAIRD WILLIAM C & CYNTHIA L (SURV)	4-CC24-5
V	LYNCH THERESA ANN (LE-CHARLES & ELLEN THORNE	4-CC24-16
W	COLLINS RANDY L JR & AMY R (SURVIVORSHIP	4-CC24-17
X	HUNTER ROBERT JR	4-CC24-48
Y	TAYLOR JENNIFER	4-CC24-47
Z	TAYLOR BUDDY L JR & PATRICIA L (SURV)	4-CC24-29
A2	ADAMS JASON R	4-CC24-30
B2	WHITE ROGER DALE	4-CC24-31
C2	WHITE ROGER DALE	4-CC24-32
D2	MCCLOUD PAULETTE	4-CC24-33
E2	SHINGLE EVA RAYMOND	4-CC24-34
F2	SHINGLE EVA & RAYMOND	4-CC24-35
G2	CRAWFORD BERNARD E (TOD) & WILMA A	4-CC24-36
H2	CRAWFORD BERNARD E (TOD) & WILMA L	4-CC24-37
I2	HUNTER WILLIAM R & GLORIA J	4-CC24-38
J2	SMITH VICKIE L	4-CC24-39
K2	PEHANICH DIANA LYNN TOD MICHELLE ALLMAN	4-CC24-15
L2	CROSS RAYMOND S DENNIS P & BUTLER KATHRYN R	4-CC24-13
M2	OBER MICHAEL	4-CC24-7
N2	SMITH DEAN	4-CC24-98
O2	MCFADDEN MICHAEL K & SHARON (SURV)	4-CC24-93
P2	CIPRIANI MICHAEL J	4-CC24-142
Q2	CIPRIANI MICHAEL J	4-CC24-141
R2	EARNEST JACK & LESLIE M (SURV)	4-CC24-138
S2	FARRELL KEVIN M & HEIDI J (SURV)	4-CC24-92
T2	FARRELL KEVIN M & HEIDI J (SURV)	4-CC24-91
U2	BRADY RALPH A & KIM (SURV)	4-CC24-90
V2	FERGUSON BRIAN L & NANCY J (SURV) (TOD)	4-CC24-89
W2	HUFFNER JAMES E & PATRICIA	4-CC24-88
X2	HUFFNER JAMES E & PATRICIA A (SURV)	4-CC24-99.6
Y2	CECCHINI CHRISTOPHER L	4-CC24-87
Z2	CECCHINI CHRISTOPHER	4-CC24-86
A3	BOLEN MICHAEL SCOTT	4-CC24-85
B3	FERGUSON DREW	4-CC24-84.1
C3	ROHR ANITRA	4-CC24-124.1
D3	CLEM MICHAEL G	4-CC29-23
E3	HART KRISTOPHER B & CHRISTY L (SURV)	4-CC29-22
F3	HART KRISTOPHER BRIAN	4-CC29-21
G3	SPENCER MICHAEL L & LORI L (SURV)	4-CC29-31
H3	LOUGHRIE WILLIAM & DIANE (SURV)	4-CC29-30
I3	CIPOLETTI RYAN	4-CC29-29
J3	JOZWICK RICHARD A & KAREN A	4-CC29-46
K3	EATON JAMES W	4-CC29-45
L3	HUNTER CLARA MAE NKA JACKSON CLARA TUD	4-CC29-48
M3	CYPHERT DEBRA-1/2;FAIR MATTHEW 1/4;BRUFFY SUSAN-1/4	4-CC29-57
N3	WALES MARK A & KIMBERLY A (SURV)	4-CC29-91
O3	KRAFT JEREMIAH ET AL	4-CC29-111
P3	GAGICH JONATHAN	4-CC29-109.1
Q3	KRAFT CHARLES L & JANNA	4-CC29-110
R3	CAMPBELL ERIC W	4-CC29-117
S3	DISERIO PAUL RAYMOND & KATHY A	4-CC29-126
T3	DISERIO PAUL R	4-CC29-125
U3	FILKINS RANDY	4-CC29-147
V3	MAYNARD COREY L	4-CC29-146
W3	AUBER ARTHUR D & GERALDINE A (SURV)	4-CC29-142
X3	AUBER ARTHUR & GERALDINE A	4-CC29-138
Y3	OHLER LORI ANN & RICKI (SURV)	4-CC29-137
Z3	PAULL JOHN	4-CC29-136
A4	HARTZER JAMES N & EVANS HARTZER CAROLE G (SURV)	4-CC29-135
B4	FLUHARTY JERRY & MARY	4-CC29-133
C4	CYPHERT DEBRA-1/2;FAIR MATTHEW1/4; BRUFFY SUSAN-1/4	4-CC29-57
D4	STATE UINE REAL EST LLC	370-07-01
E4	STEWART RUTH ANN 1/2 JACKSON MADELON DAWN 1/2 TOD	4-CC29-194
F4	STEWART RUTH ANN 1/2 JACKSON MADELON DAWN 1/2 TOD	4-CC29-193
G4	PACKER JAMI	4-CC29-192
H4	CLAMPITT NORMAN C & JEANETTA K (SURV)	4-CC29-190
I4	FRESHWATER ROBERT LEE	4-CC29-168
J4	MAIN DRIVE CIVIC ASSOC INC	4-CC29-167

ADJOINING OWNERS TABLE		
TRACT	SURFACE OWNER	TAX PARCEL
K4	FRESHWATER ROBERT LEE	4-CC29-166
L4	FRESHWATER ROBERT LEE	4-CC29-165
M4	FRESHWATER ROBERT LEE	4-CC29-164
N4	HENLINE MICHELLE J	4-CC29-163
O4	FRESHWATER MELISSA J	4-CC29-173
P4	FRESHWATER MELISSA J	4-CC29-172
Q4	FRESHWATER MELISSA J	4-CC29-171
R4	FRESHWATER MELISSA J	4-CC29-169
S4	CLAMPITT NORMAN C & JEANETTA K	4-CC29-170
T4	WILEY DEAN A & PALMER HELENA M (SURV)	4-CC29-174
U4	MILLER CARL M & JOYCE A (SURV)	4-CC29-187
V4	ELLIOT JUSTIN R	4-CC29-202
W4	ELLIOT JUSTIN R	4-CC29-203
X4	HELSEL WILLIAM & FRANCES (SURV)	4-CC29-208
Y4	FLETCHER RICHARD T JR; PLATT JOEI L	4-CC29-214
Z4	TAYLOR CHARLES C JR & MICHELE L (JTWS)	4-CC29-215
A5	RYAN TIMOTHY A & SONDR A M	4-CC29-216
B5	KLAGES KEITH C	4-CC29-217
C5	HIGHLAND SPRINGS GOLF COURSE LLC	3-B29-6
D5	CONNOLLY BRIAN & TAMMY	4-CC29-219
E5	RUDLAND JOHN	4-CC29-220
F5	LYLE MONICA T	4-CC29-221
G5	RASZ MICHAEL RAYMOND	4-CC29-221.1
H5	MINOR LISA M	4-CC29-233
I5	L & M RENTALS LLC	4-CC29-234
J5	MILLS DARREN P	4-CC29-235
K5	SMITH RYAN M & BROOKE N	370-07-1.1
L5	HIGHLAND SPRINGS GOLF COURSE	370-07-06
M5	BRIGGS ROBERT G & NANCY L	370-07-02
N5	DEPETRO JOSEPH J III	370-11-09
O5	JACOBS LISA J & TERRY G	370-11-9.1
P5	BELLVIEW CAMP MEETING ASSO DAVID STONER (TREASURER)	370-07-3
Q5	CUNNINGHAM PAULA	370-07-4
R5	SENG RONALD BERNARD & JOANNE ALICE	370-11-06
S5	DEPETRO JOSEPH J III	370-11-9.2
T5	RUSH GARY	370-11-8
U5	CUNNINGHAM PAUL A	370-12-02
V5	BROWNLEE ANDREA GEORGETTI	370-12-01
W5	BROWNLEE LAND VENT LP	370-11-1
X5	MULLINS JOHN JR	370-11-3.1
Y5	HENSLE L LOUIS W JR & MARGARET	3-B34-57
Z5	APPALACHIA MIDSTREAM SERVICES LLC	3-B34-66
A6	SHEERAN MARY L & CRAFT CUCARESE BEVERLY	3-B34-67
B6	WINTERS SHIRLEY (TOD) WINTERS ROBERT G (ETAL)	3-B34-68
C6	SONDA RICHARD L & SONDA HAROLD	3-B34-69
D6	HANNAHS FREDERICK L	3-B34-70
E6	HANNAHS FREDERICK L	3-B34-71
F6	HANNAHS FREDERICK L	3-B34-72
G6	THOMAS CHAD K & HANNAH R JTWS	3-B34-73
H6	THOMAS CHAD K & HANNAH R JTWS	3-B34-74
I6	THOMAS CHAD K & HANNAH R JTWS	3-B34-75
J6	KOSCEVIC MICHAEL T & SHERYL A (SURV)	3-B34-76
K6	FELTON DANIEL KEVIN	3-B34-79
L6	HIGHLAND SPRINGS GOLF COURSE LLC	3-B34-80
M6	ANKRUM ERIN C. (ETAL)	3-B34-82
N6	MITCHELL MELANIE	3-B34-84
O6	HUNT WILLIAM CURTIS & SUSAN L (SURV) (TOD) SCOTT KRISTEN E	3-B34-7
P6	PAULL CHRISTOPHER J & MARY ELLEN (SURV)	3-B34-4
Q6	PAULL CHRISTOPHER J & MARY E (SURVIVORSHIP)	3-B34-3
R6	PAULL CHRISTOPHER J & MARY ELLEN (SURV)	3-B29-15.2
S6	DIAMOND JANA L	3-B29-15.1
T6	HONE MARK A & LAUREN M JTWS	3-B29-19
U6	HONE MARK A & LAUREN M JTWS	3-B29-20
V6	HONE MARK A & LAUREN M JTWS	3-B29-21
W6	SANFORD HARRY E; NEELY CHATMAN L (SURV)	3-B29-16
X6	CHIVERS NORMA E CHIVERS ALAN J. ETAL	3-B29-12
Y6	MALUNKY KEITH & KIM	3-B29-22
Z6	CHIVERS NORMA E TOD CHIVERS ALAN J ETAL	3-B29-11
A7	SONDA HAROLD S & SHIRLEY J	3-B29-10
B7	SONDA HAROLD S & SHIRLEY	3-B29-9
C7	SKYWATCHER LINDA TOD SKYWATCHER DANIEL (ETAL)	3-B29-23
D7	JONES ZACHARY & MICHELE	3-B29-13
E7	FALBO PENNY	3-B29K-23
F7	FALBO PENNY	3-B29K-22
G7	CECCHINI MELANIE A	3-B29K-21
H7	BATES MELANIE	3-B29K-12
I7	BROWNLEE LAND VENTURES LP	3-B29K-11
J7	SMITH RONALD E & NANCY L (SURV)	3-B29K-10
K7	STROPE AARON H & BETH A (SURV)	3-B29K-9
L7	STROPE AARON H & BETH A (SURV)	3-B29K-8
M7	WALL ROBERT L	3-B29K-7
N7	FRESHWATER ROBERT LEE	4-CC29-182
O7	SCHERICH EARL L JR & MARTHA A (SURV)	4-CC29-179
P7	EVERHART LARRY E & DEBORAH A	4-CC29-180
Q7	ZUMPETTA JOHN L & KAREN R (SURV)	4-CC29-177
R7	FRESHWATER ROBERT LEE	4-CC-29-181
S7	GEORGETTI ANDREA M	3-B29K-5
T7	BROWNLEE LAND VENTURES LLC	3-B29K-4
U7	FRESHWATER ROBERT LEE	4-CC29-155
V7	RAY CLARISSA ANN	4-CC29-156

07/25/2025

REVISIONS:	COMPANY:		SWN Production Company, LLC SWN Production Company™	
	OPERATOR'S STATE OF WV DNR C BRK		API:	DATE: 08-29-2024
	WELL #: 406H		47-009-00342	DRAWN BY: N. MANO
	DISTRICT:	COUNTY:	STATE:	SCALE: N/A
	CROSS CREEK	BROOKE	WV	DRAWING NO:
				WELL LOCATION PLAT 6

JACKSON SURVEYING
INC.
2413 EAST PIKE ST. # 112
Clarksburg, WV 26302
304-623-5851

ADJOINING OWNERS TABLE		
TRACT	SURFACE OWNER	TAX PARCEL
W7	TAYLOR CHARLES B SR & TONDA L (SURVIVORSHIP)	4-CC29-157
X7	HAVELKA SANDRA K	4-CC29-158
Y7	BLUNDON A LEE & STEPHANIE J (SURV)	4-CC29-159
Z7	REITTER PAUL & JENNIFER	4-CC29-161
A8	BLANKENSHIP PHILLIP E	4-CC29-153
B8	ODKAN HEATHER LEE	4-CC29-152.1
C8	CUNNINGHAM MARIANNE KATHLEEN	4-CC29-150
D8	CASINELLI JAMES MICHAEL	4-CC29-122
E8	DISERIO PAUL R & KATHY A (JTWS)	4-CC29-125.1
F8	CAMPBELL ERIC WILLIAM	4-CC29-119.1
G8	LANGLEY JOSEPH L & KATHLY JO (SURV)	4-CC29-116
H8	LANGLEY JOSEPH L & KATHY JO (SURV)	4-CC29-115
I8	DEWITT STANLEY WILLIAM & KATELYNN ELLEN DAWN JTWS	4-CC29-107
J8	WALDEN JEFF	4-CC29-106
K8	HOFFMAN CHARLES	4-CC29-105
L8	MASON CAROLYN CHRISTINE	4-CC29-101
M8	RUGGIERI MICHAEL J	4-CC29-100.2
N8	RADICK RONALD R & CHRISTINE (SURV)	3-B29E-3
O8	DAYTON-WHITLATCH AMITY LAEL	3-B29E-2
P8	RIGGS RONALD	4-CC29-99
Q8	BALLATO CHRISTOPHER & RUTH (SURV)	4-CC29-95
R8	DONLEY KAREN J	4-CC29-95.1
S8	MCKEE URSON JASHU	4-CC29-87
T8	MCKEE URSON JASHU	4-CC29-88
U8	ELLIOTT BERNARD JR LE ELLIOTT BERNARD & LELA	4-CC29-66
V8	WOOD DAVID LACY	4-CC29-67
W8	HENTHORN CHRIS A & VALERIE JUNE (SURV)	4-CC29-18
X8	SOBOTA WOODROW RYAN ASHLEY R (JTWS)	4-CC29-17.1
Y8	MALONEY CHARLES W & NANCY L (JTWS) (TOD)	4-CC29-16
Z8	MCCONNAUGHY COLIN J HONE MORGAN (JTWS)	4-CC29-15
A9	PHILLIPS MARK A	4-CC29-13
B9	MALONEY CHARLES WAYNE & NANCY L (SURV) (TOD)	4-CC29-12
C9	WOOD CHRISTOPHER & MISTY M (JTWS)	4-CC29-10
D9	WOOD CHRISTOPHER D & MISTY M (SURV)	4-CC29-6
E9	VISYAK PATRICIA M	4-CC24-83
F9	HAMRICK HAROLD DEWAYNE	4-CC24-57
G9	COOKE DOUGLAS B	4-CC24-54.1
H9	KLAGES KEVIN W & LINDA K SURV	4-CC24-52
I9	KLAGES KEVIN W & LINDA K SURV	4-CC24-51
J9	GOOCH JUDITH L (ETAL)	4-CC24-49
K9	BRADLEY GEORGE L	4-CC24-132
L9	LEMASTERS DONALD & JOYCE (SURV)	4-CC24-23
M9	FIGUEROA KAIA	4-CC24-24
N9	BURDINE CALVIN G & BOYCE HANNA M (JTWS)	4-CC24-25
O9	LAUCK MARIE	4-CC24-26
P9	KISNER EUGENE WILFRED & CYNTHIA KAY	4-CC24-20
Q9	HUNTER DIXIE DARE (TOD) HUNTER ROBERT ANDREW	4-CC24-21
R9	MOORE FAMILY REV LIVING TRUST TRUS- RICHARD & TAMMY MOORE	4-CC24-4
S9	GEORGETTI RANDY V & TAMMY S (SURV)	4-CC24-22
T9	GOOCH JUDITH L	4-CC23-370
U9	SULLIVAN ARTHUR E JR	4-CC23-368
V9	SILVER CHARLES;HALSTEAD DONNA LIVINGOOD SHERRY (1/3)	4-CC23-327
W9	THOMPSON DEBRA J	4-CC23-320
X9	BARONIO CURTIS R & DONNA J	4-CC23-321
Y9	COOK FAMILY REVOCABLE TRUST 4/20/17, MALSON SUSAN A	4-CC23-322
Z9	MENEELY BOBBIE JO; MINICH RANDALL	4-CC23-324
A10	CARBASHO THOMAS & CALDWELL TINA	4-CC23-323
B10	POWER ADRIAN ELIZABETH & EMIL JAMES LOPPE (JTWS)	4-CC19-185
C10	MOORE CHARLES D & CECELIA FAY (JTWS)	4-CC19-180
D10	KASPER PAUL & MITCHELL JENNIFER (JTWS)	4-CC19-174
E10	WILSON NORMA	4-CC19-175
F10	THOMAS FLORENCE M	4-CC19-173
G10	BLACK CLARENCE T JR & TAMMY L	4-CC19-186
H10	NOGA CODIE L & KATRINA MILLER	4-CC19-187
I10	D'AGOSTINO PETER	4-CC19-188
J10	NICKOLES GREGORY; RANDY;JEFFRE (LE-DANNY & GRACE NICKOLES)	4-CC19-160
K10	BAKER DAVID	4-CC19-164
L10	EMMERTH DOUGLAS P & PAMELA L JTWS	4-CC19-165
M10	STATE OF WEST VIRGINIA BUREAU OF COMMERCE DIV OF NAT RESOURC	4-CC19-168
N10	LANGEVIN GRETCHEN MOORE WESBANCO BANK INC	4-CC20-5
O10	MILLER JOHN ERNEST, JESSE ANDREW (SURV)	4-CC20-4
P10	BREEN SUSAN D & DENNIS M	4-CC20-22
Q10	COLLIERS SPORTSMAN CLUB	4-CC20-21
R10	ROUSE WILLIAM MORGAN & DORIS J	4-CC20-20
S10	BLACK LINDY L	4-CC20-7

07/25/2025


REVISIONS:	COMPANY:			
	SWN Production Company, LLC		SWN Production Company™	
	OPERATOR'S STATE OF WV DNR C BRK		API:	DATE: 08-29-2024
	WELL #: 406H		47-009-00342	DRAWN BY: N. MANO
	DISTRICT: CROSS CREEK	COUNTY: BROOKE	STATE: WV	SCALE: N/A
	DRAWING NO: WELL LOCATION PLAT 7			

TRACT	SURFACE OWNER	TAX PARCEL


07/25/2025

REVISIONS:		COMPANY:			
		OPERATOR, STATE OF WV DNR C BRK		API: 47-000-00345	
		WELL #:		DATE: 08-28-2024	
		DISTRICT: CROSS CREEK		DRAWN BY: N. MANO	
		COUNTY: BROOKE		SCALE: N/A	
		STATE: WV		DRAWING NO:	
				WELL LOCATION PLAT 7	

JACKSON SURVEYING
INC.
2413 EAST PIKE ST. # 112
Clarksburg, WV 26302
304-623-5851

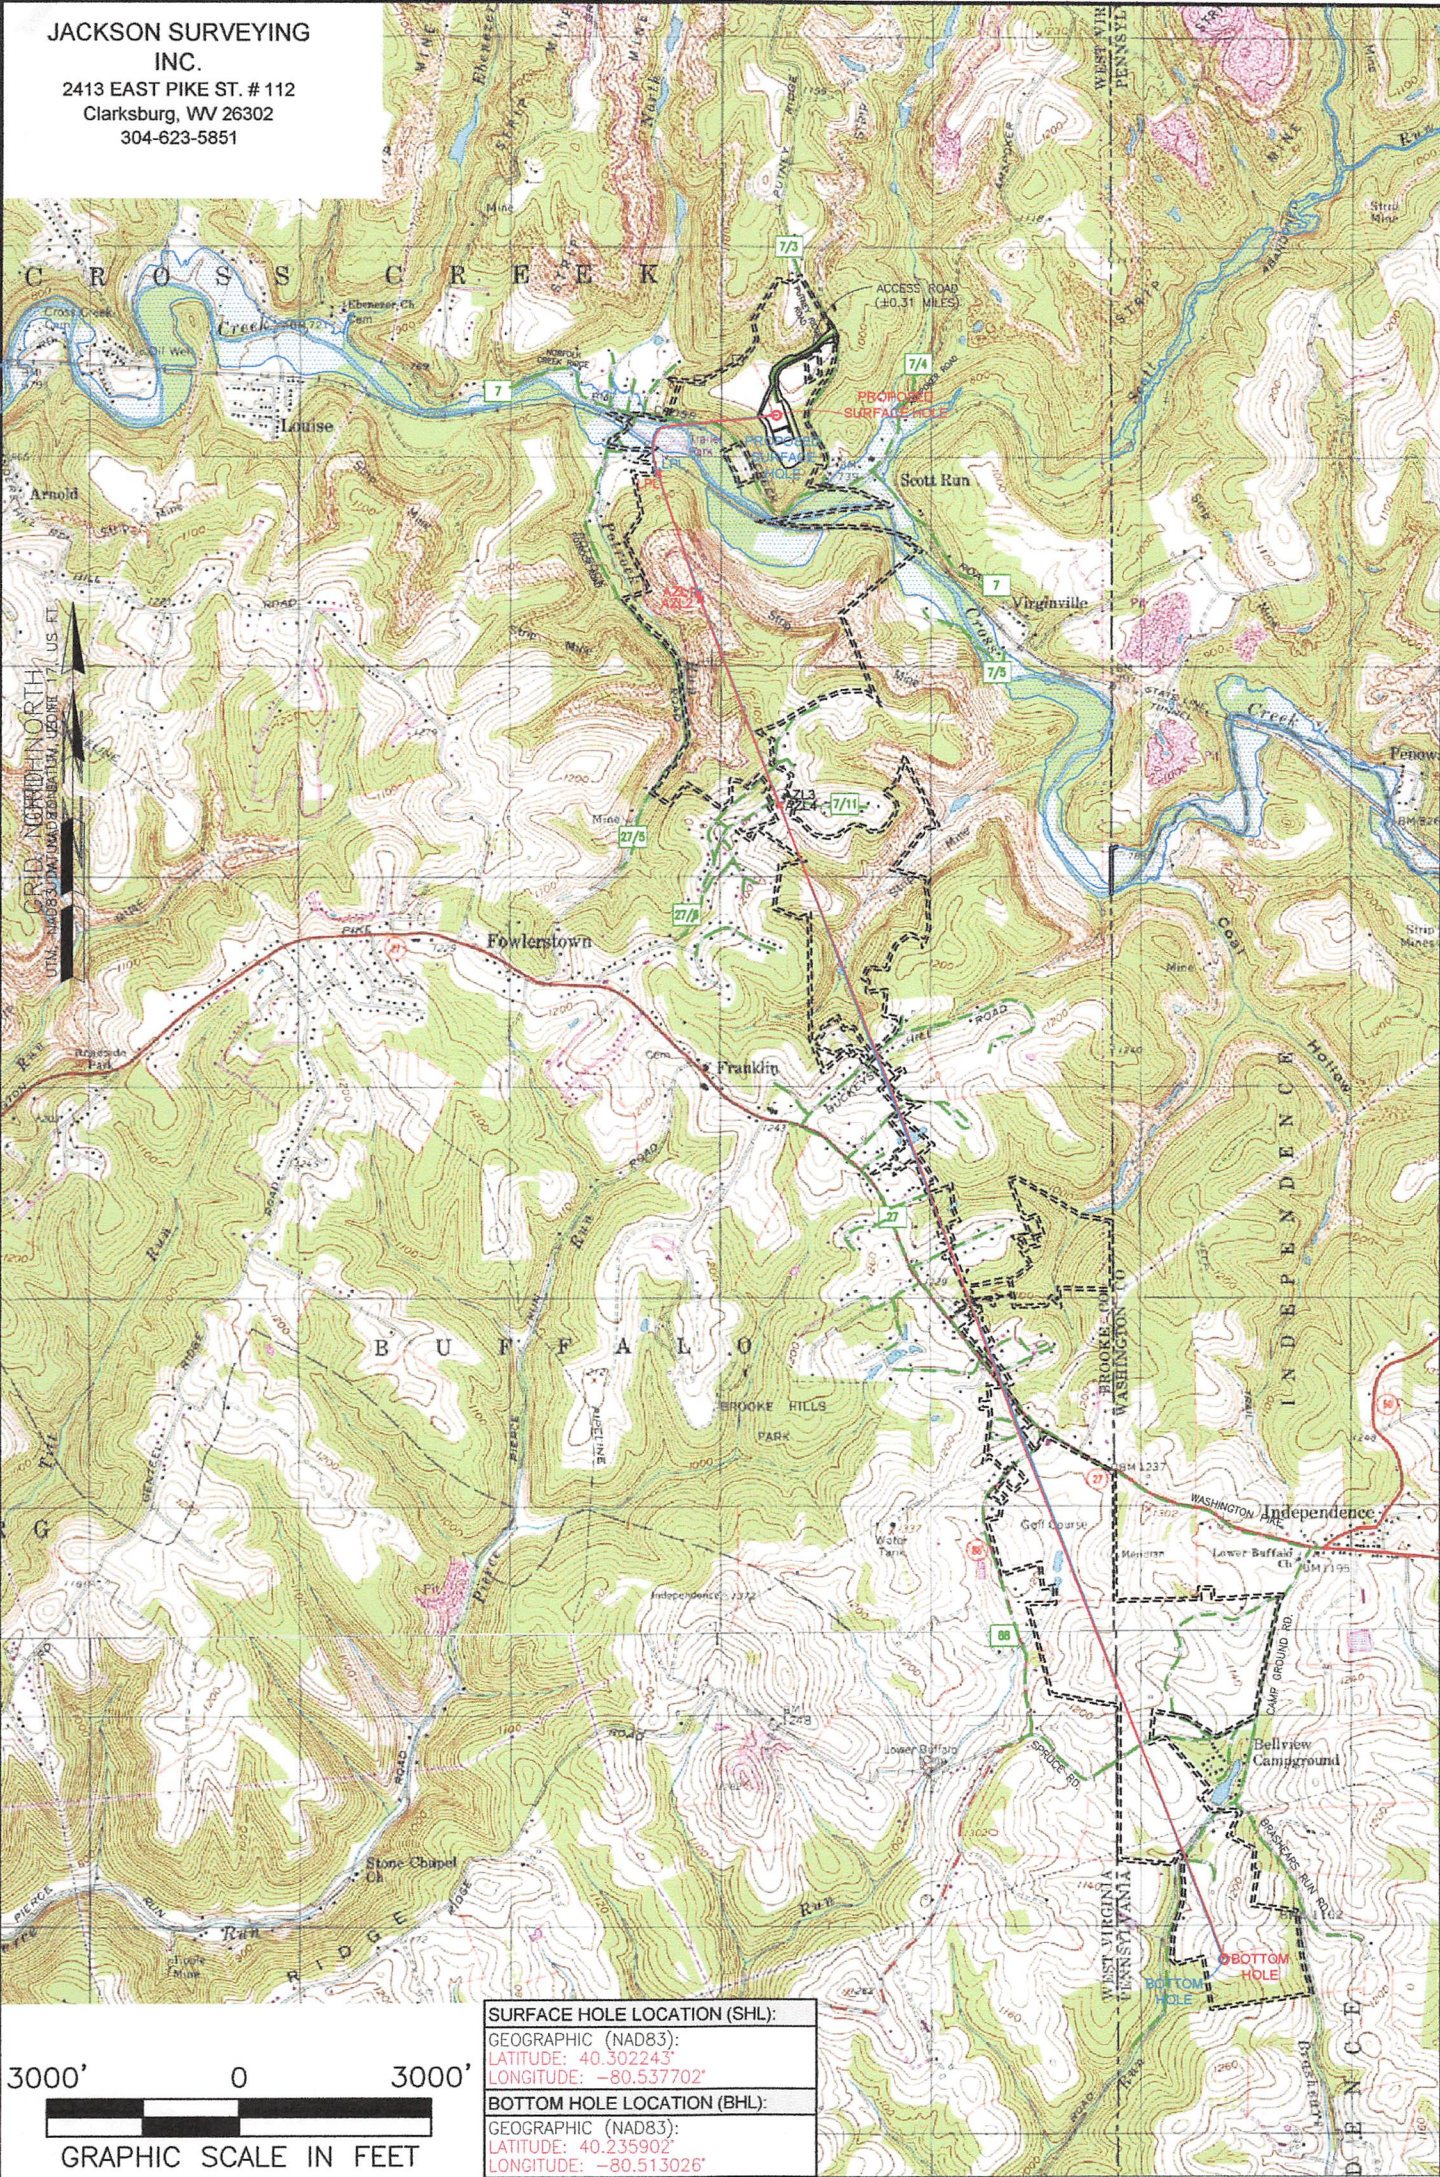

SURFACE HOLE LOCATION (SHL):
GEOGRAPHIC (NAD83):
LATITUDE: 40.302243°
LONGITUDE: -80.537702°
BOTTOM HOLE LOCATION (BHL):
GEOGRAPHIC (NAD83):
LATITUDE: 40.235902°
LONGITUDE: -80.513026°

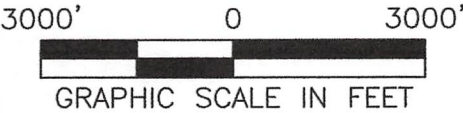

NOTES ON SURVEY

1. SURFACE AND ROYALTY OWNER INFORMATION AND THEIR BOUNDARIES SHOWN HEREON WERE PLOTTED FROM DEEDS AND/OR TAX PARCEL MAPS PROVIDED BY CLIENT AND/OR FIELD LOCATIONS.
2. THIS PLAT DOES NOT REPRESENT A BOUNDARY SURVEY OF THE PARCELS SHOWN HEREON.
3. ALL INSETS ARE GRID NORTH UNLESS OTHERWISE DEPICTED.

LEGEND:

- PROPOSED SURFACE HOLE / BOTTOM HOLE
- ⊙ EXISTING / PRODUCING WELLHEAD
- LPLX LANDING POINT LOCATION
- ⬜ FLOOD PLAIN
- PUBLIC ROAD
- ACCESS ROAD TO PREV. SITE
- == LEASE BOUNDARY
- PROPOSED PATH
- ASDRILLED PATH

WELL OPERATOR: SWN PRODUCTION COMPANY, LLC	WELL (FARM) NAME: STATE OF WV DNR C BRK	WELL # 406H	SERIAL # 47-009-00342
ADDRESS: 1300 FORT PIERPONT ROAD, SUITE 200 MORGANTOWN, WV 26508	COUNTY - CODE BROOKE - 009	DISTRICT; CROSS CREEK	
SURFACE OWNER: STATE OF WEST VIRGINIA, BUREAU OF COMMERCE, DIVISION OF NATURAL RESOURCES, PUBLIC LAND CORPORATION	USGS 7 1/2 QUADRANGLE MAP NAME STUEBENVILLE EAST, WV		