


Latitude

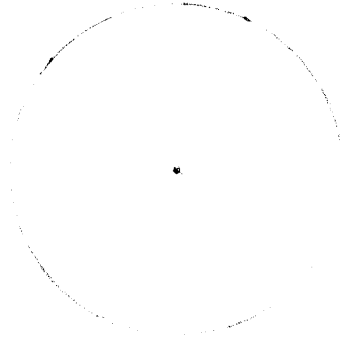

General Location.
Not Entered into
database

Longitude

Topo Location

7.5' Loc. _____ 15' Loc. _____
_____ (calc.) _____

Company Remo Oil Co

Farm Woods Hrs #13

15' Quad _____
(sec.)

7.5' Quad Tiltonville

District Buffalo

WELL LOCATION PLAT

County 009 Permit 70246

X

Buffalo District, Brooke County, W. Va.
 Reno Oil Co.
 8" casing, 125'; 6", 1010'; 5", 1328'.
 Beech Bottom pool.
 Tuled June 3, (1914?)
 Shot with 20 qts.

	Top.	Bottom.
Coal		38
Top of Berea Sand (pay, 1651')	1639 -	
Total depth		1665

(AVERAGE INTERVAL FROM PITTSBURGH COAL TO BEREA SAND IN THE
 BEECH BOTTOM POOL = 1613 FEET).....RGT