

4701700190P

WW-7  
8-30-06



West Virginia Department of Environmental Protection  
Office of Oil and Gas

**WELL LOCATION FORM: GPS**

API: 47-017-00190 WELL NO.: 2

FARM NAME: Haught Marvel

RESPONSIBLE PARTY NAME: Diversified Production LLC

COUNTY: Doddridge DISTRICT: Southwest

QUADRANGLE: Oxford

SURFACE OWNER: Harold Hinzman

ROYALTY OWNER: Diversified Production LLC

UTM GPS NORTHING: 4,335,749.0

UTM GPS EASTING: 515,447.4 GPS ELEVATION: 869'

The Responsible Party named above has chosen to submit GPS coordinates in lieu of preparing a new well location plat for a plugging permit or assigned API number on the above well. The Office of Oil and Gas will not accept GPS coordinates that do not meet the following requirements:

1. Datum: NAD 1983, Zone: 17 North, Coordinate Units: meters, Altitude: height above mean sea level (MSL) – meters.
2. Accuracy to Datum – 3.05 meters
3. Data Collection Method:

Survey grade GPS \_\_\_\_\_; Post Processed Differential \_\_\_\_\_


Real-Time Differential \_\_\_\_\_

Mapping Grade GPS X; Post Processed Differential X

Real-Time Differential \_\_\_\_\_

4. Letter size copy of the topography map showing the well location.

I the undersigned, hereby certify this data is correct to the best of my knowledge and belief and shows all the information required by law and the regulations issued and prescribed by the Office of Oil and Gas.

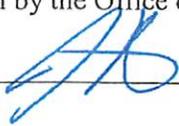Signature 

Director Production  
Title

08/12/2021  
Date

RECEIVED  
Office of Oil and Gas  
AUG 24 2021

WV Department of  
Environmental Protection  
09/24/2021





Diversified Gas & Oil Corporation  
 100 Diversified Way  
 Pikeville KY, 41051

47-017-00190

Plugging Map

**Legend**

- Well
- Access Road
- Pits
- Pad
- Public Roads

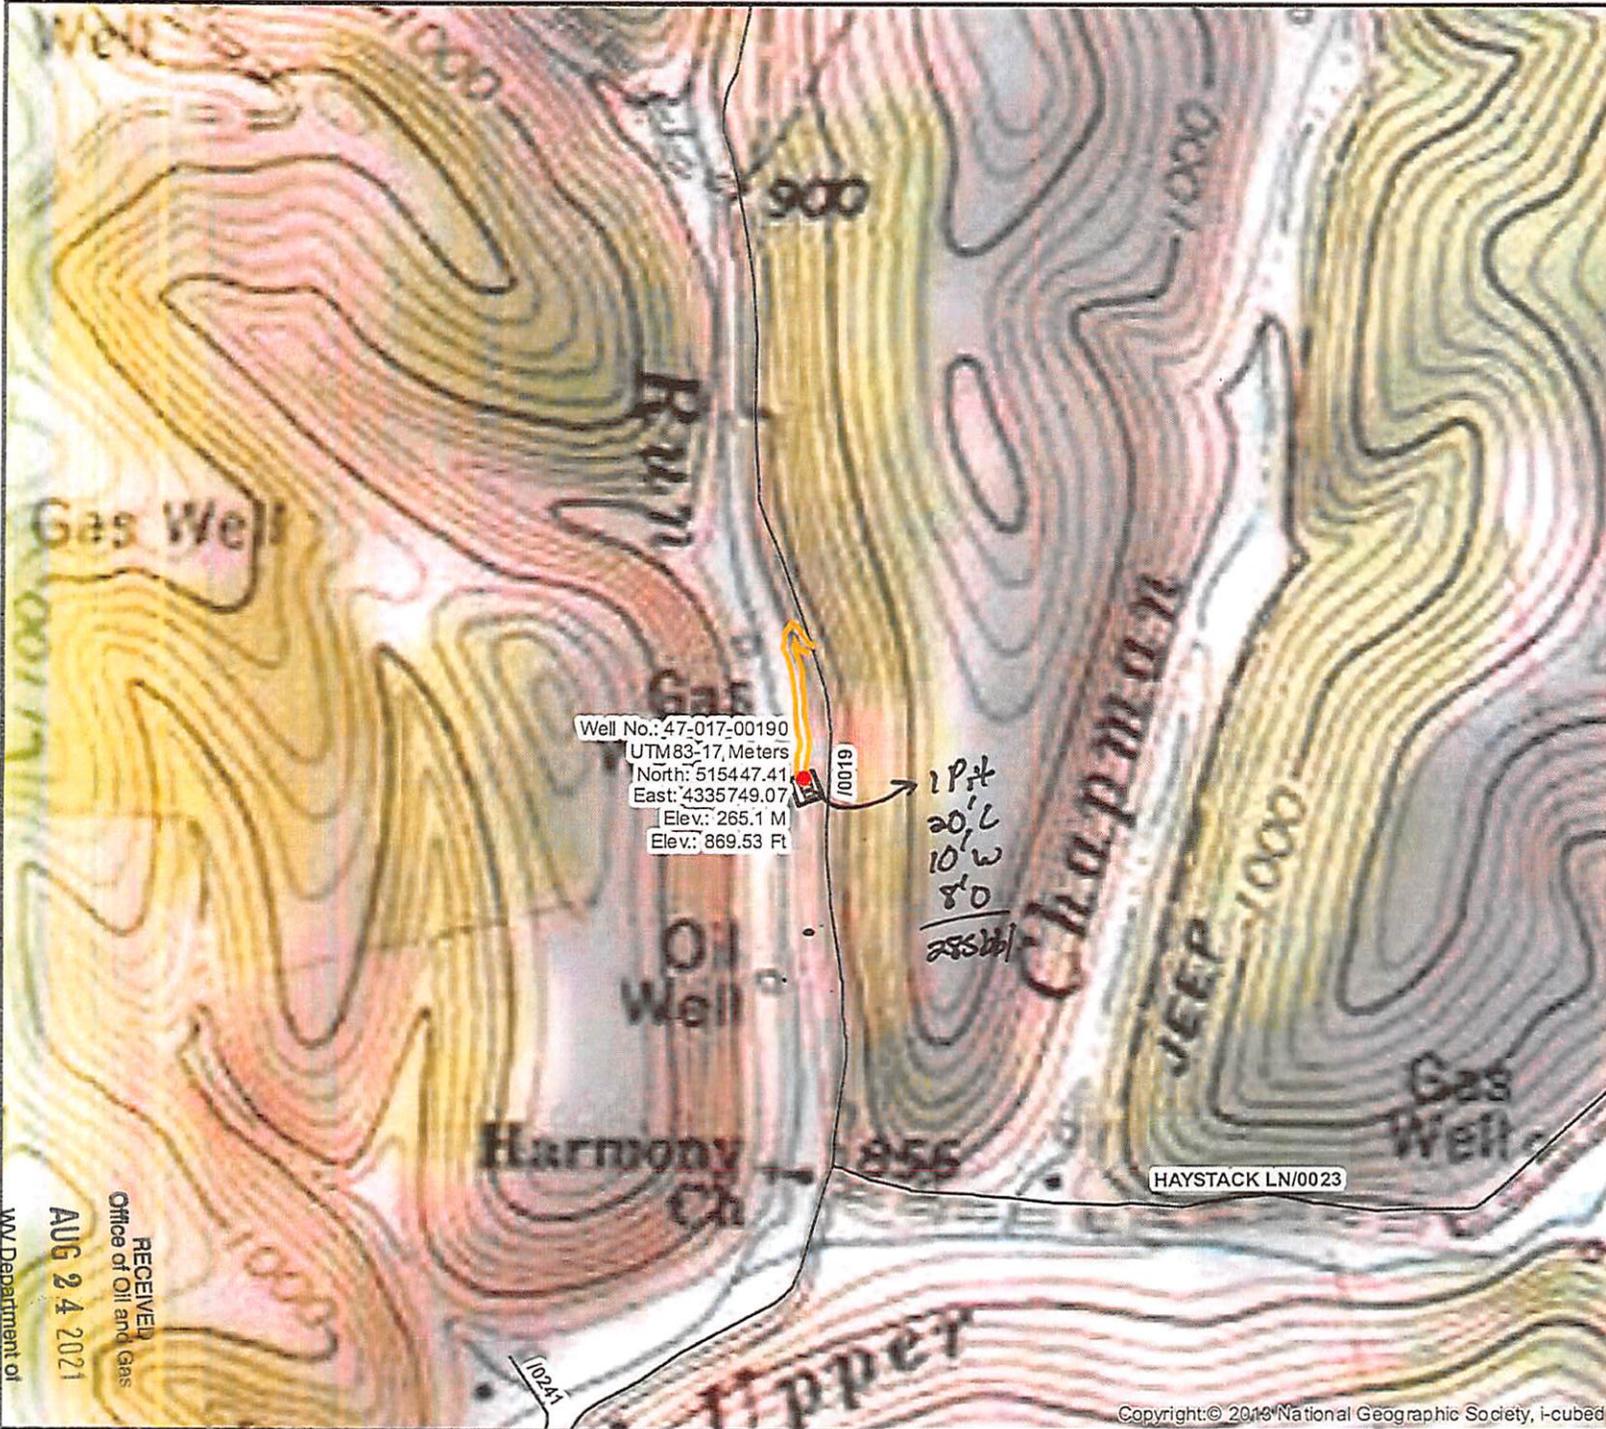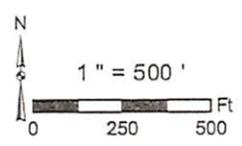

Well No.: 47-017-00190  
 UTM83-17, Meters  
 North: 515447.41  
 East: 4335749.07  
 Elev.: 265.1 M  
 Elev.: 869.53 Ft

1 Pit  
 20' L  
 10' W  
 8'0"  
 25526

HAYSTACK LN/0023

RECEIVED  
 Office of Oil and Gas  
 AUG 24 2021  
 MW Department of  
 Environmental Protection

4701700190P