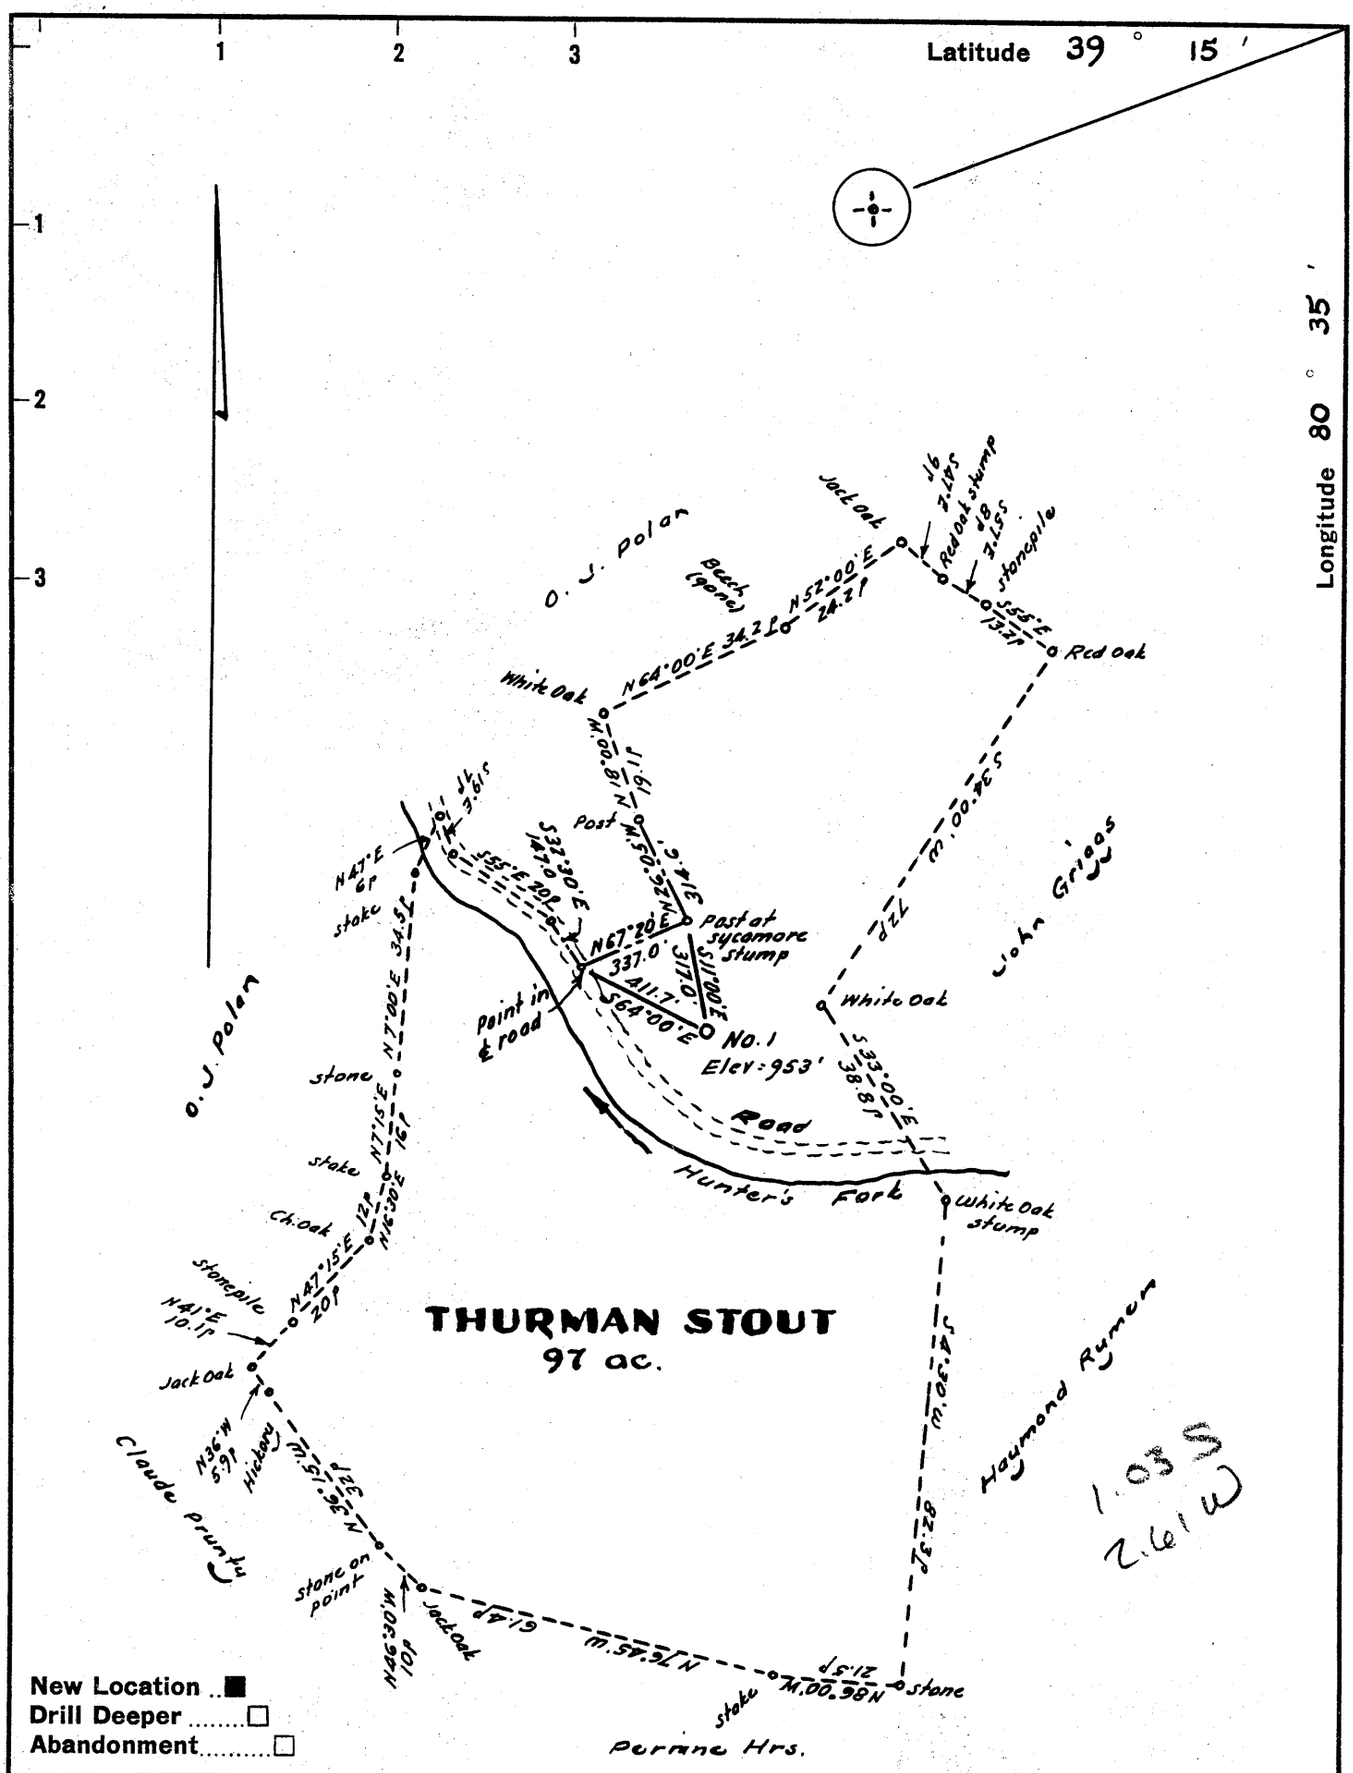

Company J. H. HOLT

Address Wells Hotel, Sistersville, W.Va.

Farm Thurman Stout

Tract _____ Acres 97.0 Lease No. _____

Well (Farm) No. One Serial No. _____

Elevation (Spirit Level) 953'

Quadrangle Vadis - NC

County Doddridge District Greenbriar

Engineer _____

Engineer's Registration No. 1227

File No. _____ Drawing No. _____

Date Dec. 1961 Scale 1": 30p

STATE OF WEST VIRGINIA
DEPARTMENT OF MINES
OIL AND GAS DIVISION
CHARLESTON

WELL LOCATION MAP

FILE NO. Dod- 690

+ Denotes location of well on United States Topographic Maps, scale 1 to 62,500, latitude and longitude lines being represented by border lines as shown.

— Denotes one inch spaces on border line of original tracing.

K&E 156 IMPERIAL TRACING CLOTH T.M. 68347