



West Virginia Department of Environmental Protection
Office of Oil and Gas
WELL LOCATION FORM: GPS

API: 47-017-06150 WELL NO.: Droppleman 1H

FARM NAME: Erwin Valley

RESPONSIBLE PARTY NAME: Antero Resources Corporation

COUNTY: Doddridge DISTRICT: New Milton

QUADRANGLE: New Milton

SURFACE OWNER: Sandra E. Erwin

ROYALTY OWNER: _____

UTM GPS NORTHING: 4333714.19 m

UTM GPS EASTING: 526335.72 m GPS ELEVATION: 1243.0 ft

The Responsible Party named above has chosen to submit GPS coordinates in lieu of preparing a new well location plat for a plugging permit or assigned API number on the above well. The Office of Oil and Gas will not accept GPS coordinates that do not meet the following requirements:

1. Datum: NAD 1983, Zone: 17 North, Coordinate Units: meters, Altitude: height above mean sea level (MSL) – meters.

2. Accuracy to Datum – 3.05 meters

3. Data Collection Method:

Survey grade GPS : Post Processed Differential _____

Real-Time Differential

Mapping Grade GPS : Post Processed Differential _____

Real-Time Differential

4. Letter size copy of the topography map showing the well location.

I the undersigned, hereby certify this data is correct to the best of my knowledge and belief and shows all the information required by law and the regulations issued and prescribed by the Office of Oil and Gas.

[Signature]
Signature


Permitting Manager
Title

9/10/29
Date

RECEIVED
Office of Oil and Gas

APR 26 2024

WV Department of
Environmental Protection

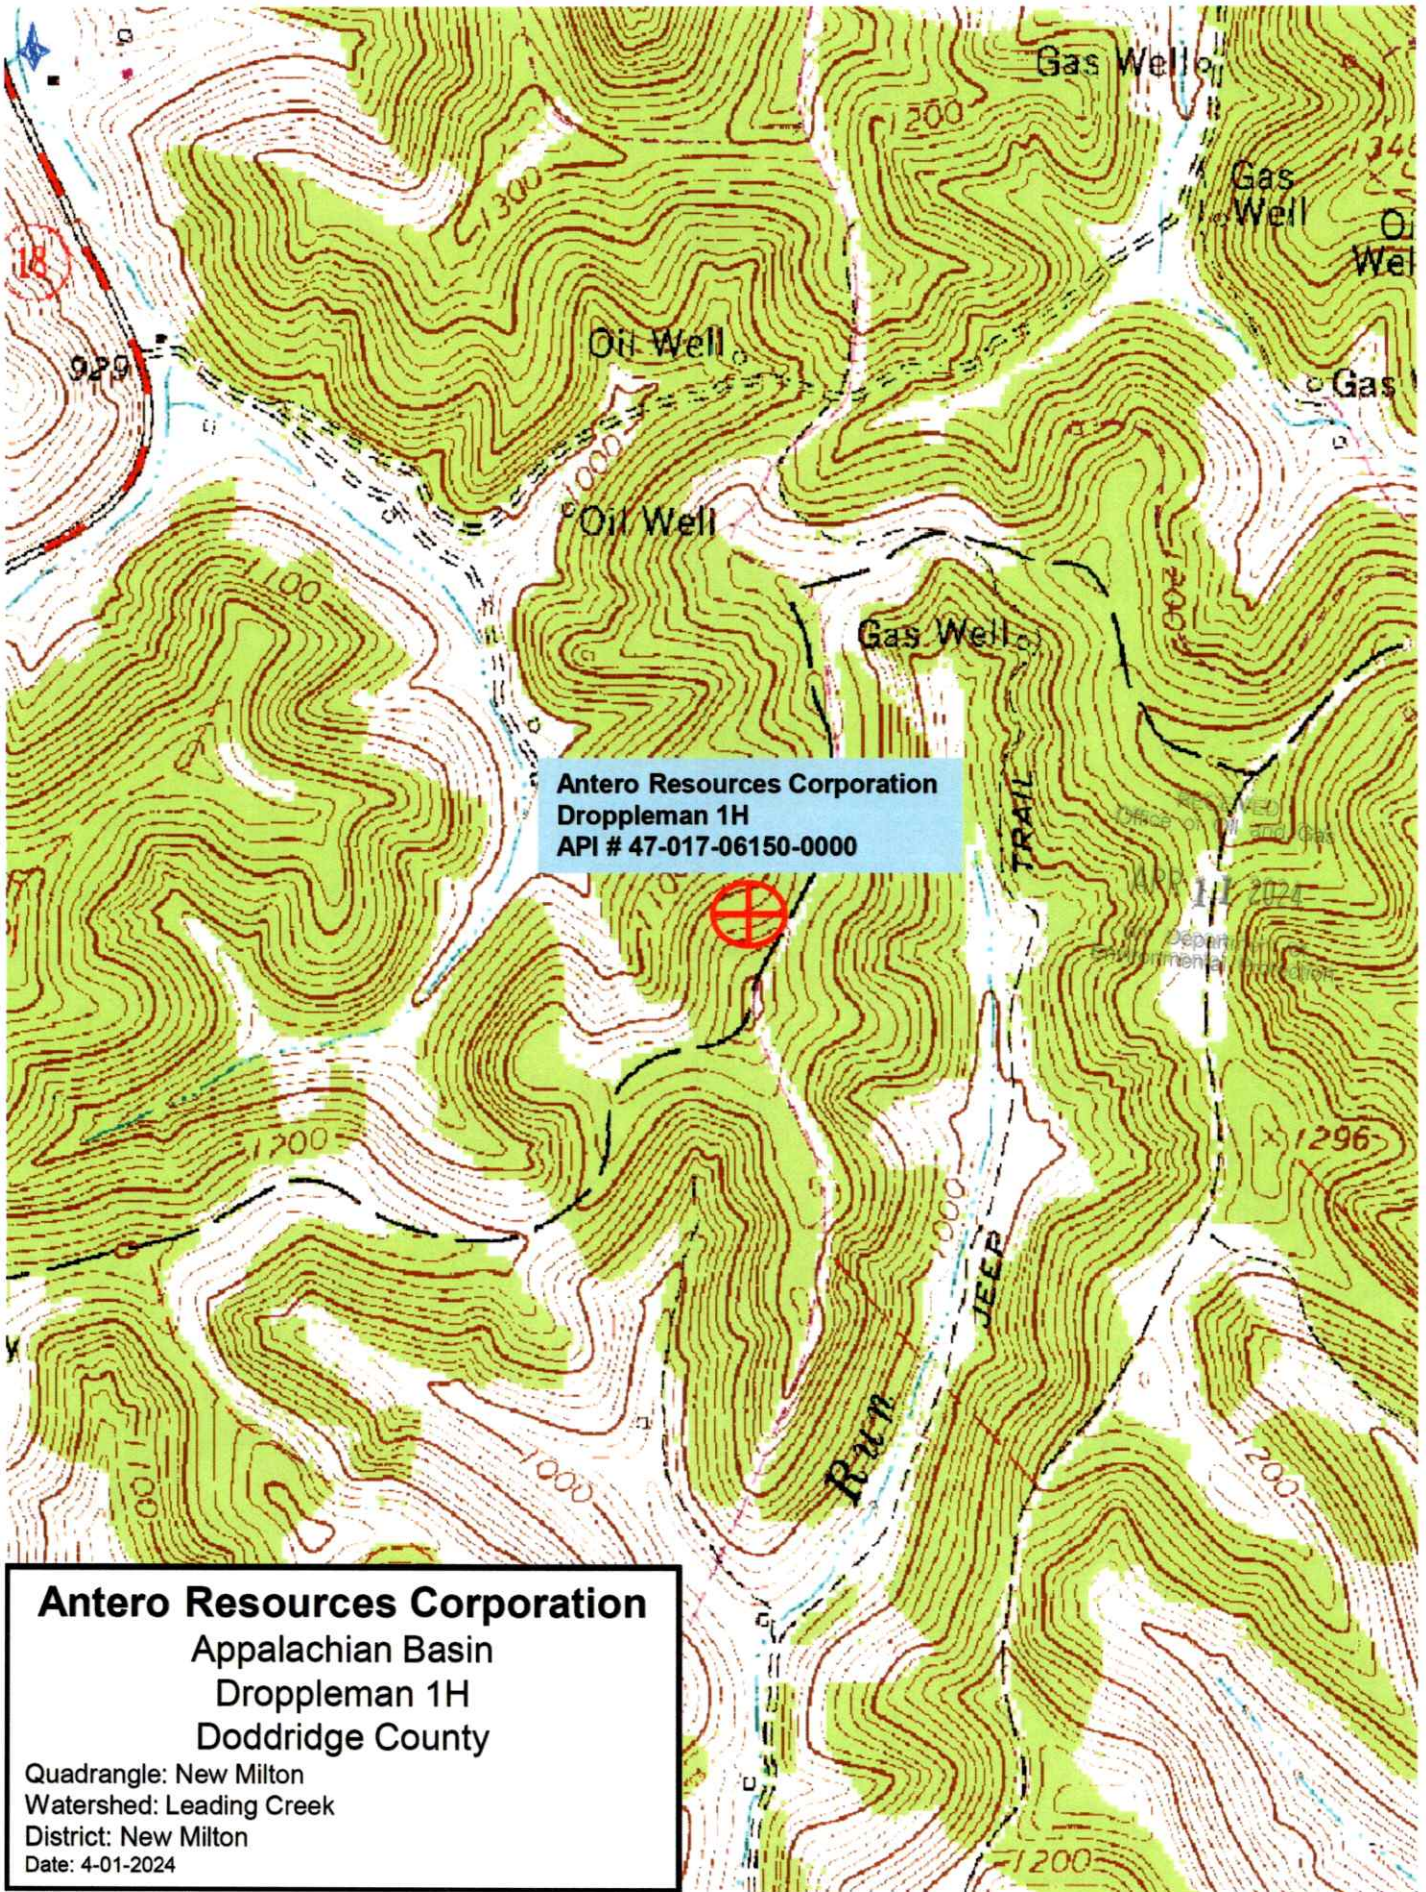

Antero Resources Corporation
Appalachian Basin
Droppleman 1H
Doddridge County

Quadrangle: New Milton
Watershed: Leading Creek
District: New Milton
Date: 4-01-2024