


SUBJECT WELL
Gribble 8517
(47-033-00079)

03/10/2023

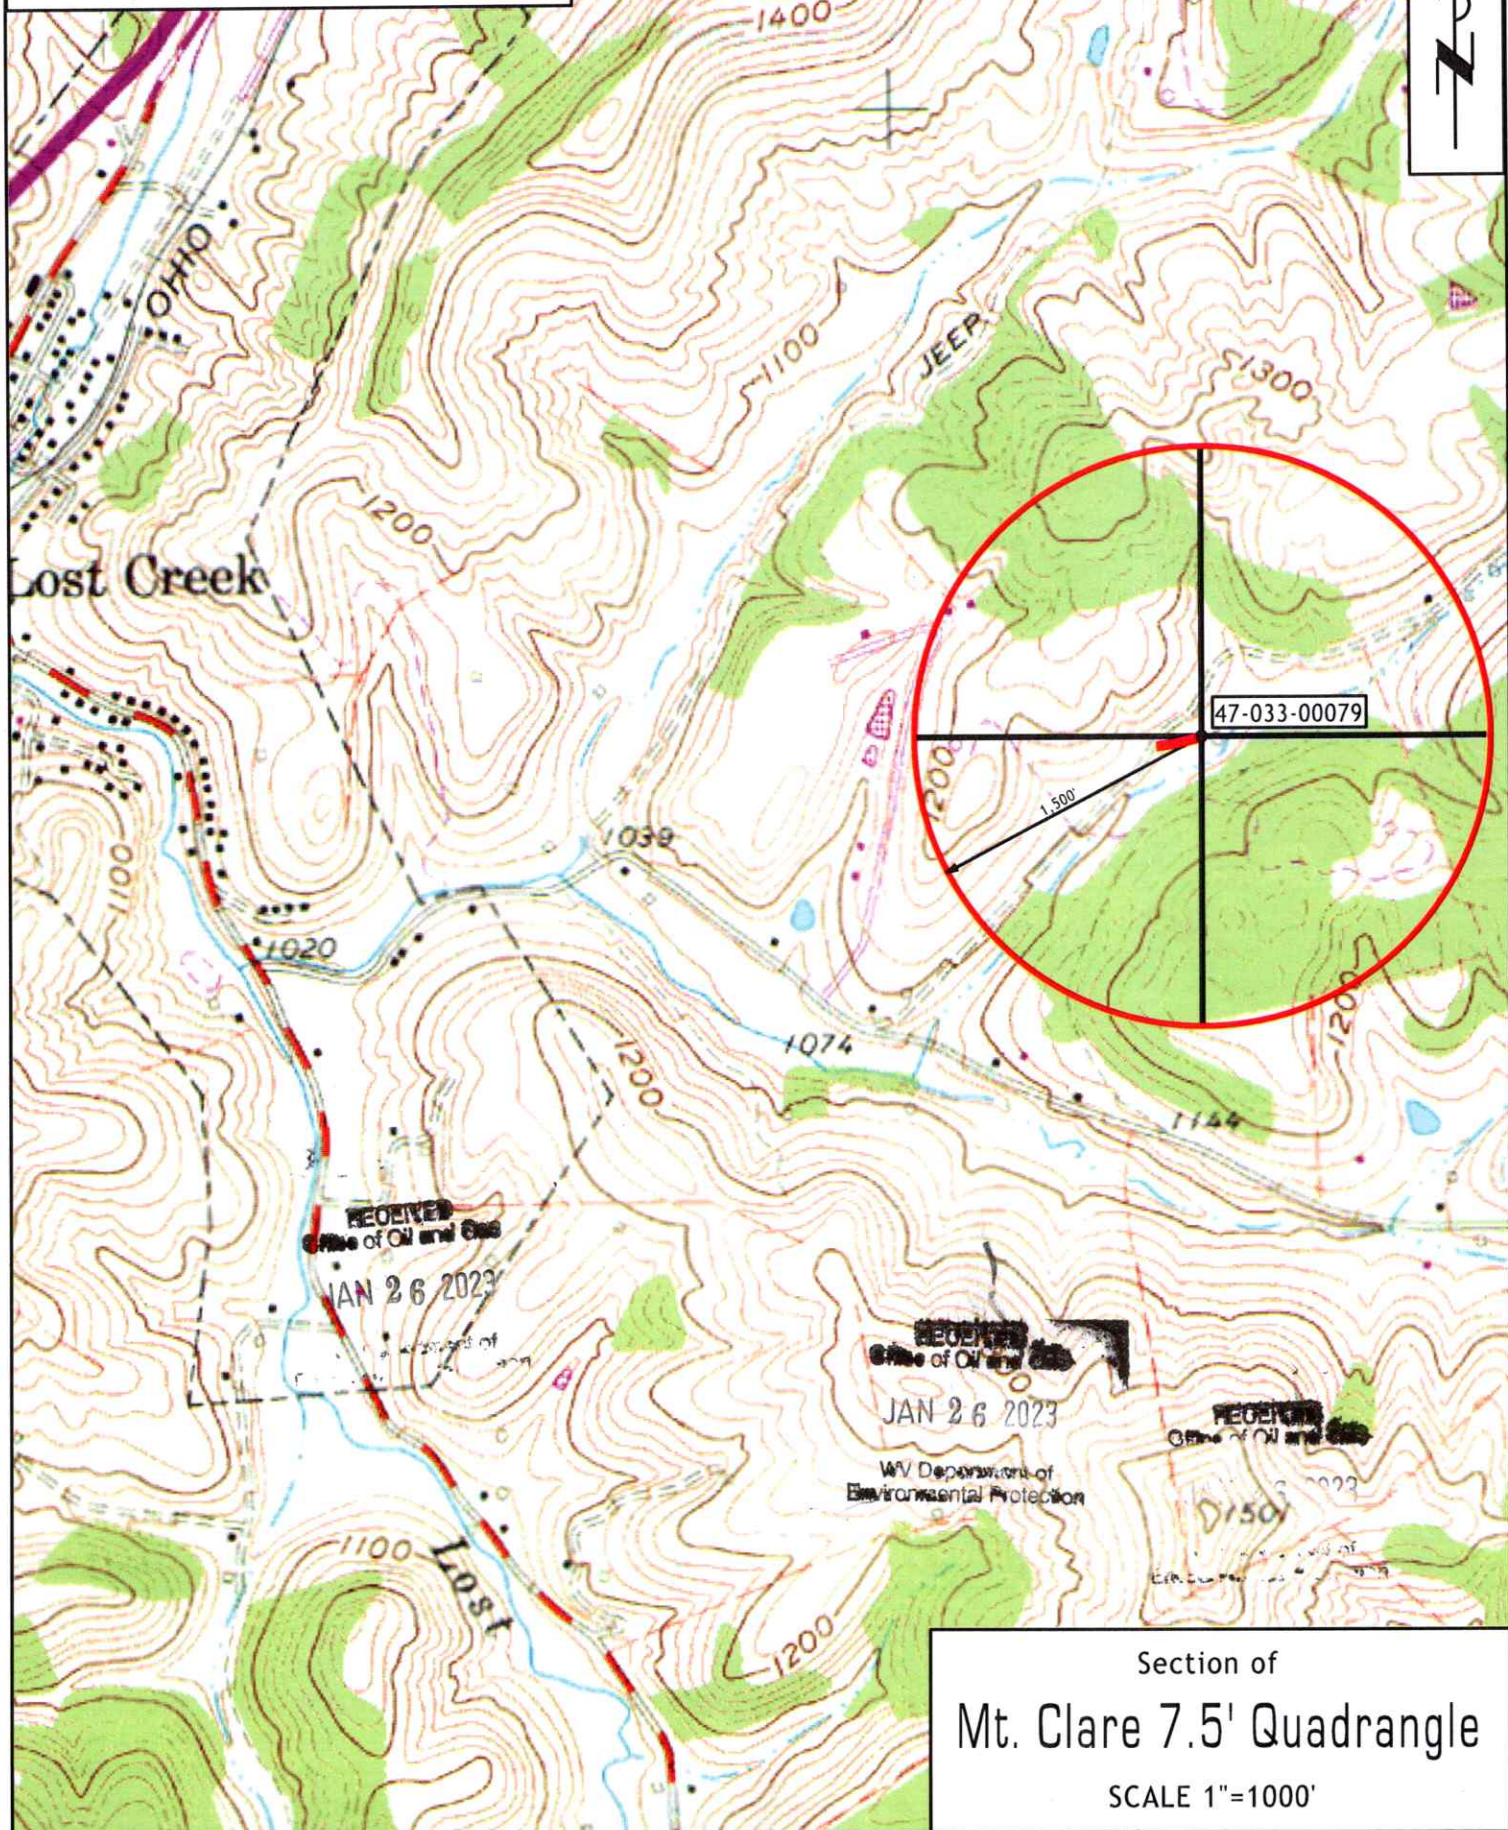

47-033-00079

RECEIVED
Office of Oil and Gas
JAN 26 2023

RECEIVED
Office of Oil and Gas
JAN 26 2023
WV Department of
Environmental Protection

RECEIVED
Office of Oil and Gas
JAN 26 2023

Section of
Mt. Clare 7.5' Quadrangle
SCALE 1"=1000'

West Virginia Department of Environmental Protection
Office of Oil & Gas

WELL LOCATION FORM: GPS

API: 47- 033 - 00079 WELL NO: 8517

FARM NAME: CS Gribble

RESPONSIBLE PARTY NAME: HG Energy, LLC

COUNTY: Harrison DISTRICT: Grant

QUADRANGLE: Mt. Clare 7.5'

SURFACE OWNER: David K. Scranage

ROYALTY OWNER: HG Energy, LLC et al.

UTM GPS NORTHING: 4,334,490

UTM GPS EASTING: 558,105 GPS ELEVATION: 339 m. (1112')

The Responsible Party named above has chosen to submit GPS coordinates in lieu of preparing a new well location plat for a plugging permit on the above well. The Office of Oil & Gas will not accept GPS coordinates that do not meet the following requirements:

1. Datum: NAD 1983, Zone:17 North, Coordinate Units: meters, Altitude: height above mean sea level (MSL) - meters.
2. Accuracy to Datum - 3.05 meters
3. Data Collection Method:

Survey Grade GPS	<input type="checkbox"/>	Post Processed Differential	<input type="checkbox"/>
		Real-Time Differential	<input type="checkbox"/>
Mapping Grade GPS	<input checked="" type="checkbox"/>	Post Processed Differential	<input checked="" type="checkbox"/>
		Real-Time Differential	<input type="checkbox"/>

RECEIVED
Office of Oil and Gas
JAN 26 2023
WV Department of
Environmental Protection

I the undersigned, hereby certify this data is correct to the best of my knowledge and belief and shows all the information required by law and the regulations issued and prescribed by the Office of Oil and Gas.

Diane C. White Diane C. White
Signature

Designated Agent
Title

December 28, 2022
Date