

47-033-00185

Well# 47-033-00185

WALLACE WV 7.5' Quad

Scale: 1" = 500'



x 1471

1518 x



Well# 47-033-00185

1300

RECEIVED
Office of Oil and Gas

OCT 28 2024

WV Department of
Environmental Protection

Mine

x 1307


Ti

11/22/2024

Well# 47-033-00185

WALLAGE WV 7.5' Quad

Scale: 1" = 2000'

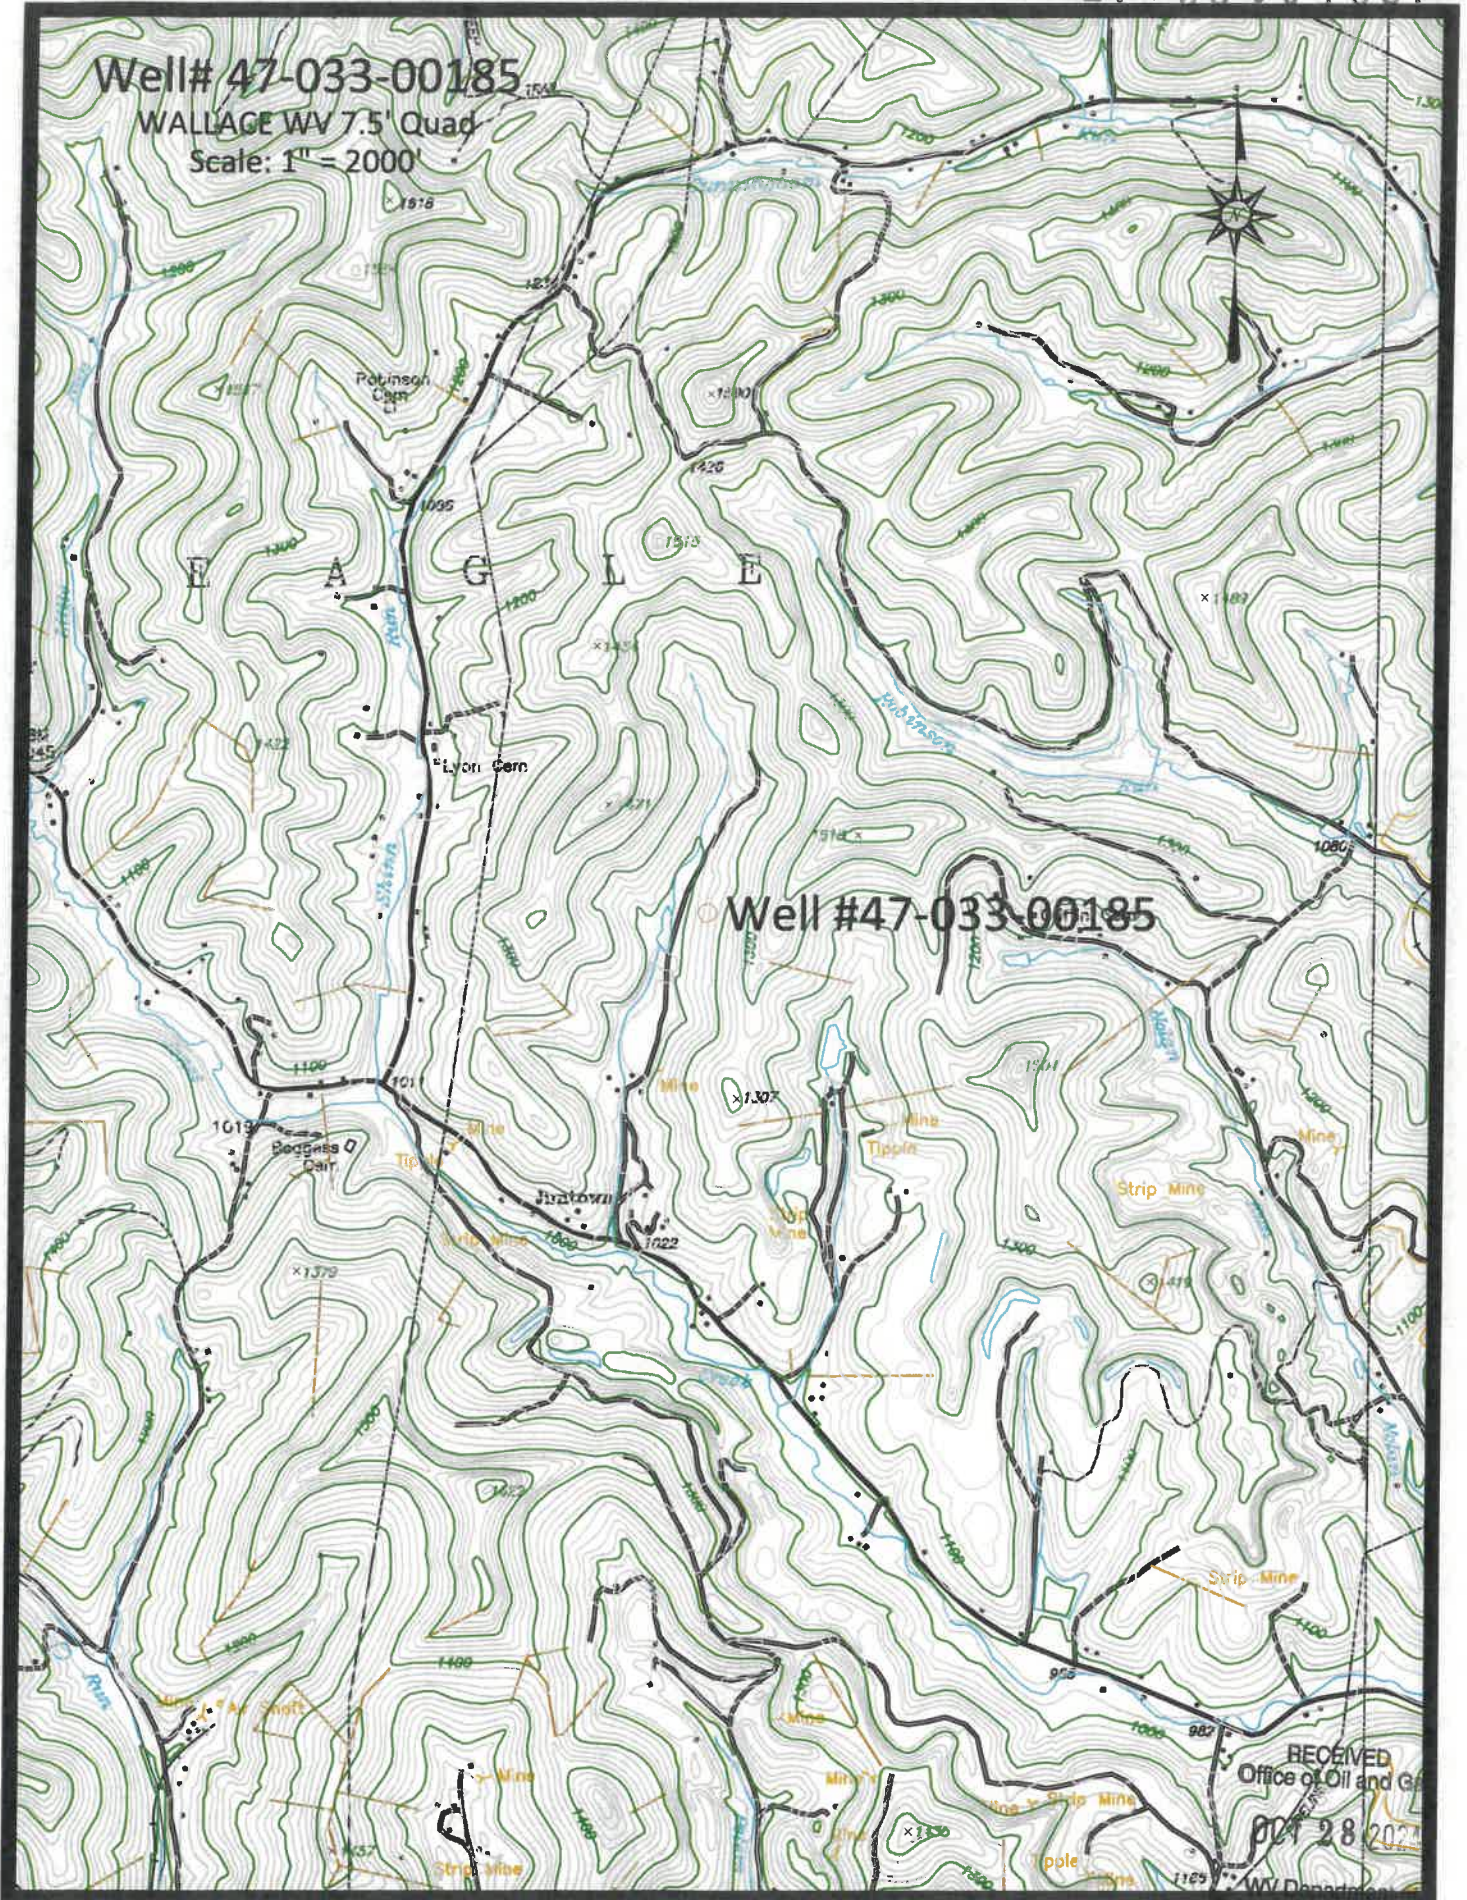

RECEIVED
Office of Oil and Gas

001 28 2024

Environmental Protection

11/22/2024

4464
33 00 185



47-033-00185

25'

4462

4461

LUMBERPORT (W. VA. 20) 1.9 MI.

4459000N

RECEIVED
Office of Oil and Gas

OCT 28 2024

WV Department of
Environmental Protection

(CLARKSBURG)
4462 N SE

LUMBERPORT 5 MI
CLARKSBURG 16 MI



ROAD CLASSIFICATION

- Heavy-duty ————
- Medium-duty ————
- Light-duty ————
- Unimproved dirt ————



State Route

11/22/2024

"Wallace; WV" Scale: 1" = 0.379Mi 610Mt 2,000Ft, 1 Mi = 2.640" , 1 cm = 240Mt



West Virginia Department of Environmental Protection
Office of Oil and Gas

WELL LOCATION FORM: GPS

API: 47-033-00185 WELL NO.: D R ROGERS 3

FARM NAME: ROGERS

RESPONSIBLE PARTY NAME: WEST VIRGINIA LAND RESOURCES INC.

COUNTY: HARRISON DISTRICT: EAGLE

QUADRANGLE: WALLACE WV

SURFACE OWNER: HARRISON COUNTY COAL

ROYALTY OWNER: _____

UTM GPS NORTHING: 4,362,309 m

UTM GPS EASTING: 551,626 m GPS ELEVATION: 357 m ^(1170')

The Responsible Party named above has chosen to submit GPS coordinates in lieu of preparing a new well location plat for a plugging permit or assigned API number on the above well. The Office of Oil and Gas will not accept GPS coordinates that do not meet the following requirements:

- Datum: NAD 1983, Zone: 17 North, Coordinate Units: meters, Altitude: height above mean sea level (MSL) – meters.
- Accuracy to Datum – 3.05 meters
- Data Collection Method:

Survey grade GPS X : Post Processed Differential X

Real-Time Differential _____

Mapping Grade GPS _____ : Post Processed Differential _____

Real-Time Differential _____

- Letter size copy of the topography map showing the well location.**

I the undersigned, hereby certify this data is correct to the best of my knowledge and belief and shows all the information required by law and the regulations issued and prescribed by the Office of Oil and Gas.

[Signature]
Signature

PS 2002
Title

OCTOBER 14, 2024
Date

RECEIVED
Office of Oil and Gas
OCT 28 2024
WV Department of
Environmental Protection