

WW-7
8-30-06



West Virginia Department of Environmental Protection
Office of Oil and Gas

WELL LOCATION FORM: GPS

API: 47-033-00290 WELL NO.: 1

FARM NAME: RL Bishop

RESPONSIBLE PARTY NAME: Antero Resources Corporation

COUNTY: Harrison DISTRICT: Elk

QUADRANGLE: Berlin

SURFACE OWNER: William R & Priscilla D Suan & Phyllis M Bishop

ROYALTY OWNER: N/A

UTM GPS NORTHING: 4328763.15 m

UTM GPS EASTING: 562762.73 m GPS ELEVATION: 340.7 m (117')

The Responsible Party named above has chosen to submit GPS coordinates in lieu of preparing a new well location plat for a plugging permit or assigned API number on the above well. The Office of Oil and Gas will not accept GPS coordinates that do not meet the following requirements:

- Datum: NAD 1983, Zone: 17 North, Coordinate Units: meters, Altitude: height above mean sea level (MSL) – meters.
- Accuracy to Datum – 3.05 meters
- Data Collection Method:

Survey grade GPS : Post Processed Differential _____
Real-Time Differential

Mapping Grade GPS : Post Processed Differential _____
Real-Time Differential

- Letter size copy of the topography map showing the well location.**


I the undersigned, hereby certify this data is correct to the best of my knowledge and belief and shows all the information required by law and the regulations issued and prescribed by the Office of Oil and Gas.

RECEIVED
Office of Oil and Gas
OCT - 4 2019

[Signature]
Signature

Permitting Agent
Title

10.2.2019
Date

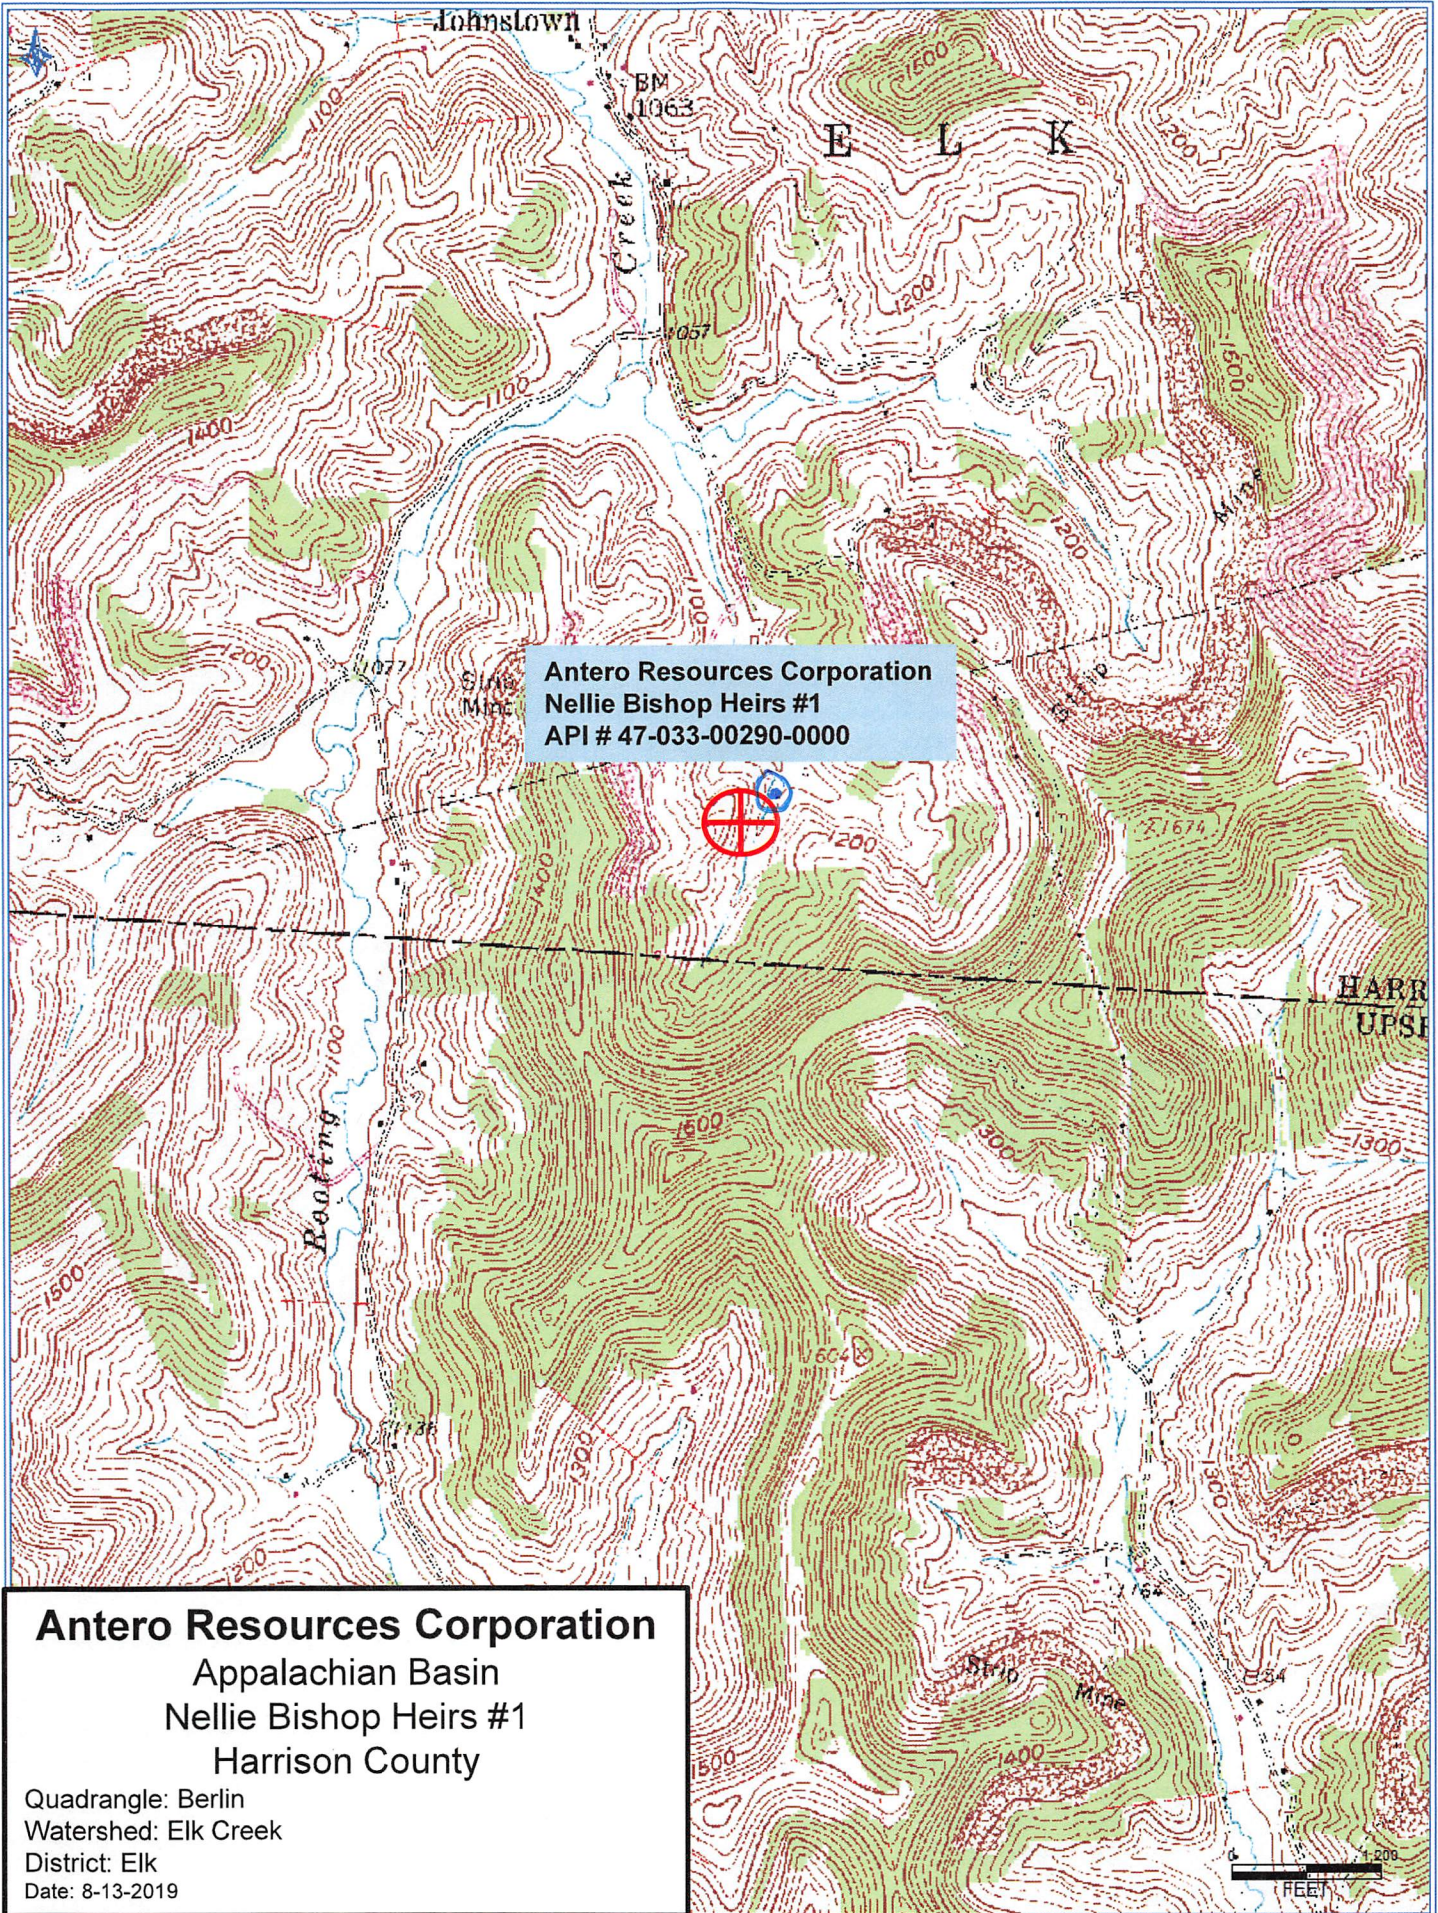

Antero Resources Corporation
Nellie Bishop Heirs #1
API # 47-033-00290-0000

Antero Resources Corporation
Appalachian Basin
Nellie Bishop Heirs #1
Harrison County

Quadrangle: Berlin
Watershed: Elk Creek
District: Elk
Date: 8-13-2019