
4703300582P

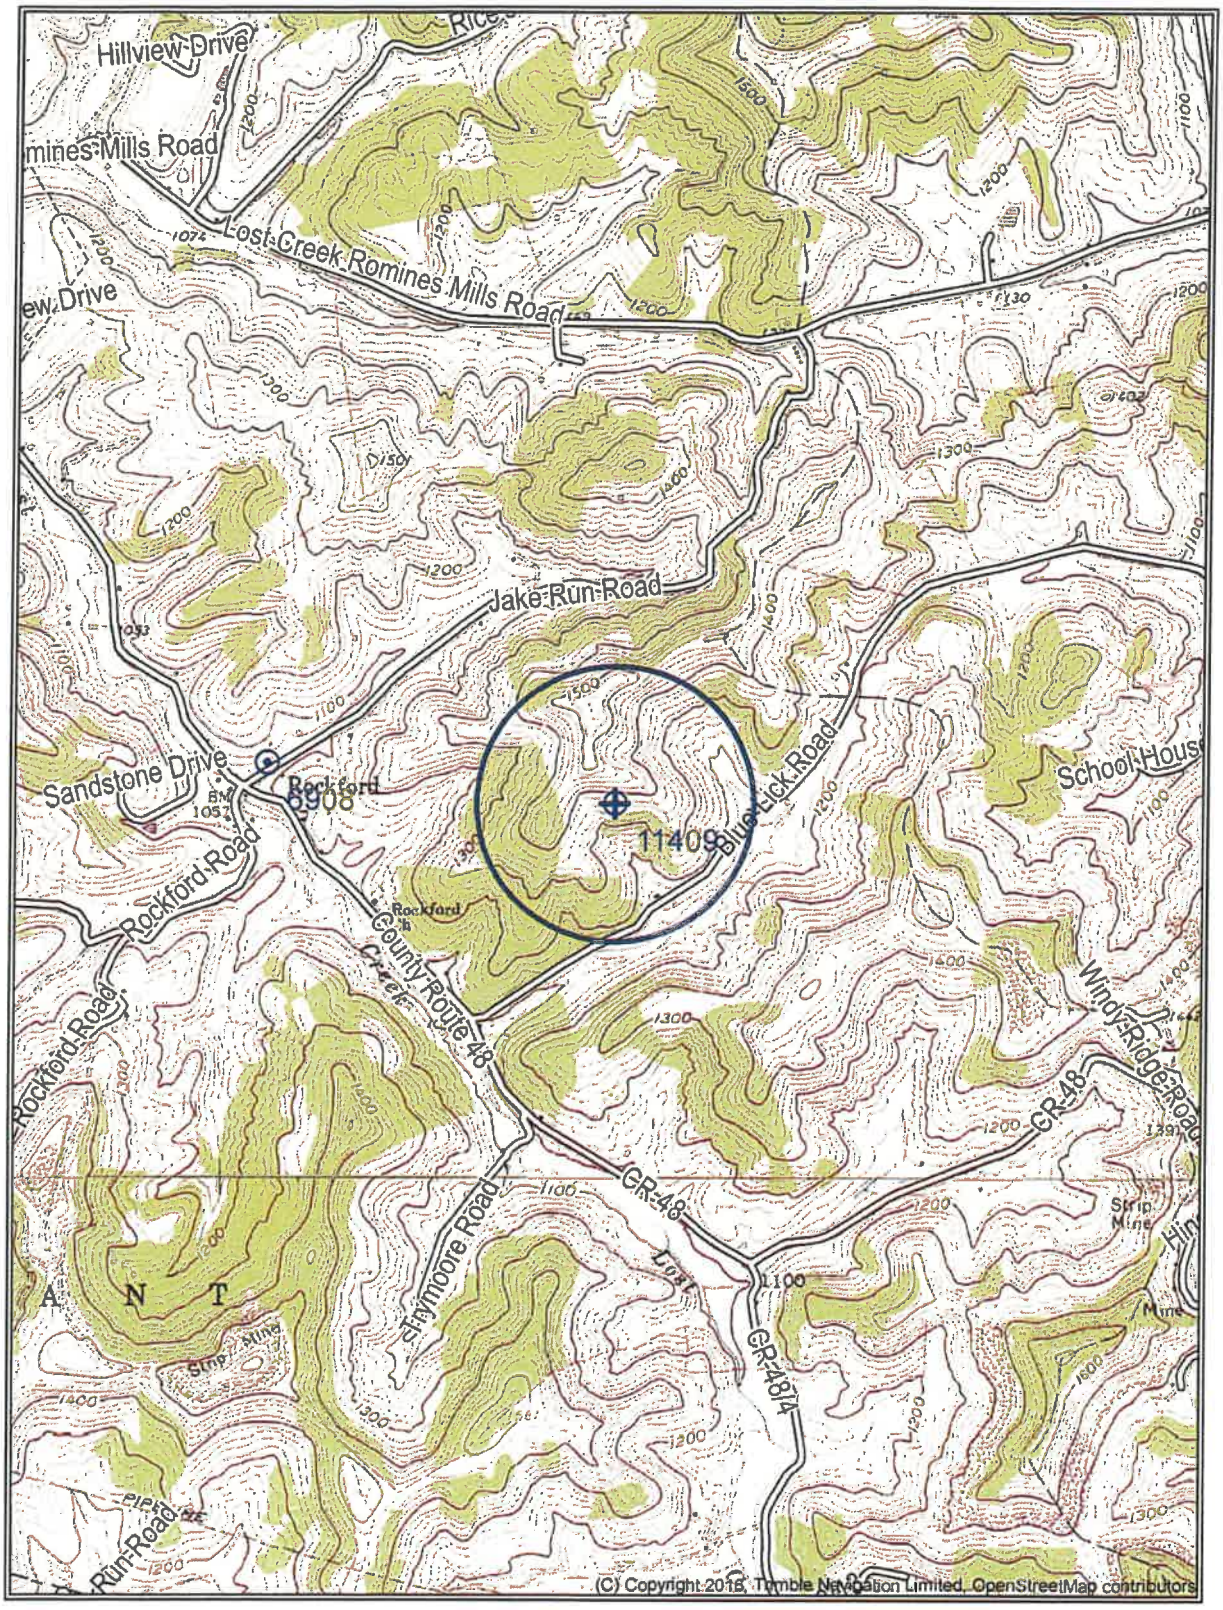

SCALE 1:24000

0 1000 2000 3000 4000 5000 6000

Feet

RECEIVED
Office Of Oil and Gas

OCT 14 2025

WV Department of
Environmental Protection

10/30/2026

47 033 00582

RECEIVED
Office Of Oil and Gas
OCT 14 2026
WV Department of
Environmental Protection

WW-7
8-30-06

West Virginia Department of Environmental Protection
Office of Oil and Gas
WELL LOCATION FORM: GPS

API: 47-033-00582 **WELL NO.:** 11409

FARM NAME: Russell D. Bishop

RESPONSIBLE PARTY NAME: Eastern Gas Transmission and Storage

COUNTY: Harrison **DISTRICT:** Grant

QUADRANGLE: Mount Clare

SURFACE OWNER: Cheryl B. Cornwell, John William Lunsford, Jr., Lucy Sgrignoli, Deborah L. Doran and John P. Bishop

ROYALTY OWNER: John W. Lunsford, etals

UTM GPS NORTHING: 4332115.87

UTM GPS EASTING: 558941.06 **GPS ELEVATION:** 417.06m / 1368'

The Responsible Party named above has chosen to submit GPS coordinates in lieu of preparing a new well location plat for a plugging permit or assigned API number on the above well. The Office of Oil and Gas will not accept GPS coordinates that do not meet the following requirements:

1. Datum: NAD 1983, Zone: 17 North, Coordinate Units: meters, Altitude: height above mean sea level (MSL) – meters.
2. Accuracy to Datum – 3.05 meters
3. Data Collection Method:

Survey grade GPS ____: Post Processed Differential _____

Real-Time Differential _____

Mapping Grade GPS X: Post Processed Differential _____

Real-Time Differential _____

4. **Letter size copy of the topography map showing the well location.**

I the undersigned, hereby certify this data is correct to the best of my knowledge and belief and shows all the information required by law and the regulations issued and prescribed by the Office of Oil and Gas.

Signature | Director - Storage Title | 9-28-2026 Date

10/30/2026