

33 00991P

WW-7  
8-30-06



West Virginia Department of Environmental Protection  
Office of Oil and Gas  
**WELL LOCATION FORM: GPS**

API: 033-00991 WELL NO.: DTI 12066

FARM NAME: HIRAM POST

RESPONSIBLE PARTY NAME: CNX GAS COMPANY LLC

COUNTY: HARRISON 33 DISTRICT: UNION 0

QUADRANGLE: WESTON 670

SURFACE OWNER: CLARENCE SPERRY

ROYALTY OWNER: FLORA G. POST, AGT.

UTM GPS NORTHING: 4343147.483 METERS

UTM GPS EASTING: 546562.432 METERS GPS ELEVATION: 349.54 METERS 146'

The Responsible Party named above has chosen to submit GPS coordinates in lieu of preparing a new well location plat for a plugging permit or assigned API number on the above well. The Office of Oil and Gas will not accept GPS coordinates that do not meet the following requirements:

1. Datum: NAD 1983, Zone: 17 North, Coordinate Units: meters, Altitude: height above mean sea level (MSL) – meters.
2. Accuracy to Datum – 3.05 meters
3. Data Collection Method:

Survey grade GPS     : Post Processed Differential     

Real-Time Differential     

Mapping Grade GPS X: Post Processed Differential     

Real-Time Differential X

4. Letter size copy of the topography map showing the well location.

I the undersigned, hereby certify this data is correct to the best of my knowledge and belief and shows all the information required by law and the regulations issued and prescribed by the Office of Oil and Gas.




*George D. Six*  
Signature

WV PROFESSIONAL SURVEYOR #2000  
Title

RECEIVED  
Office of Oil and Gas  
AUG 26 2014  
8-3-14  
WV Department of  
Environmental Protection

CNX USE: NAD27 WV NORTH SPC - N:269627.912' E:1727891.655' ELEV:1146.78'

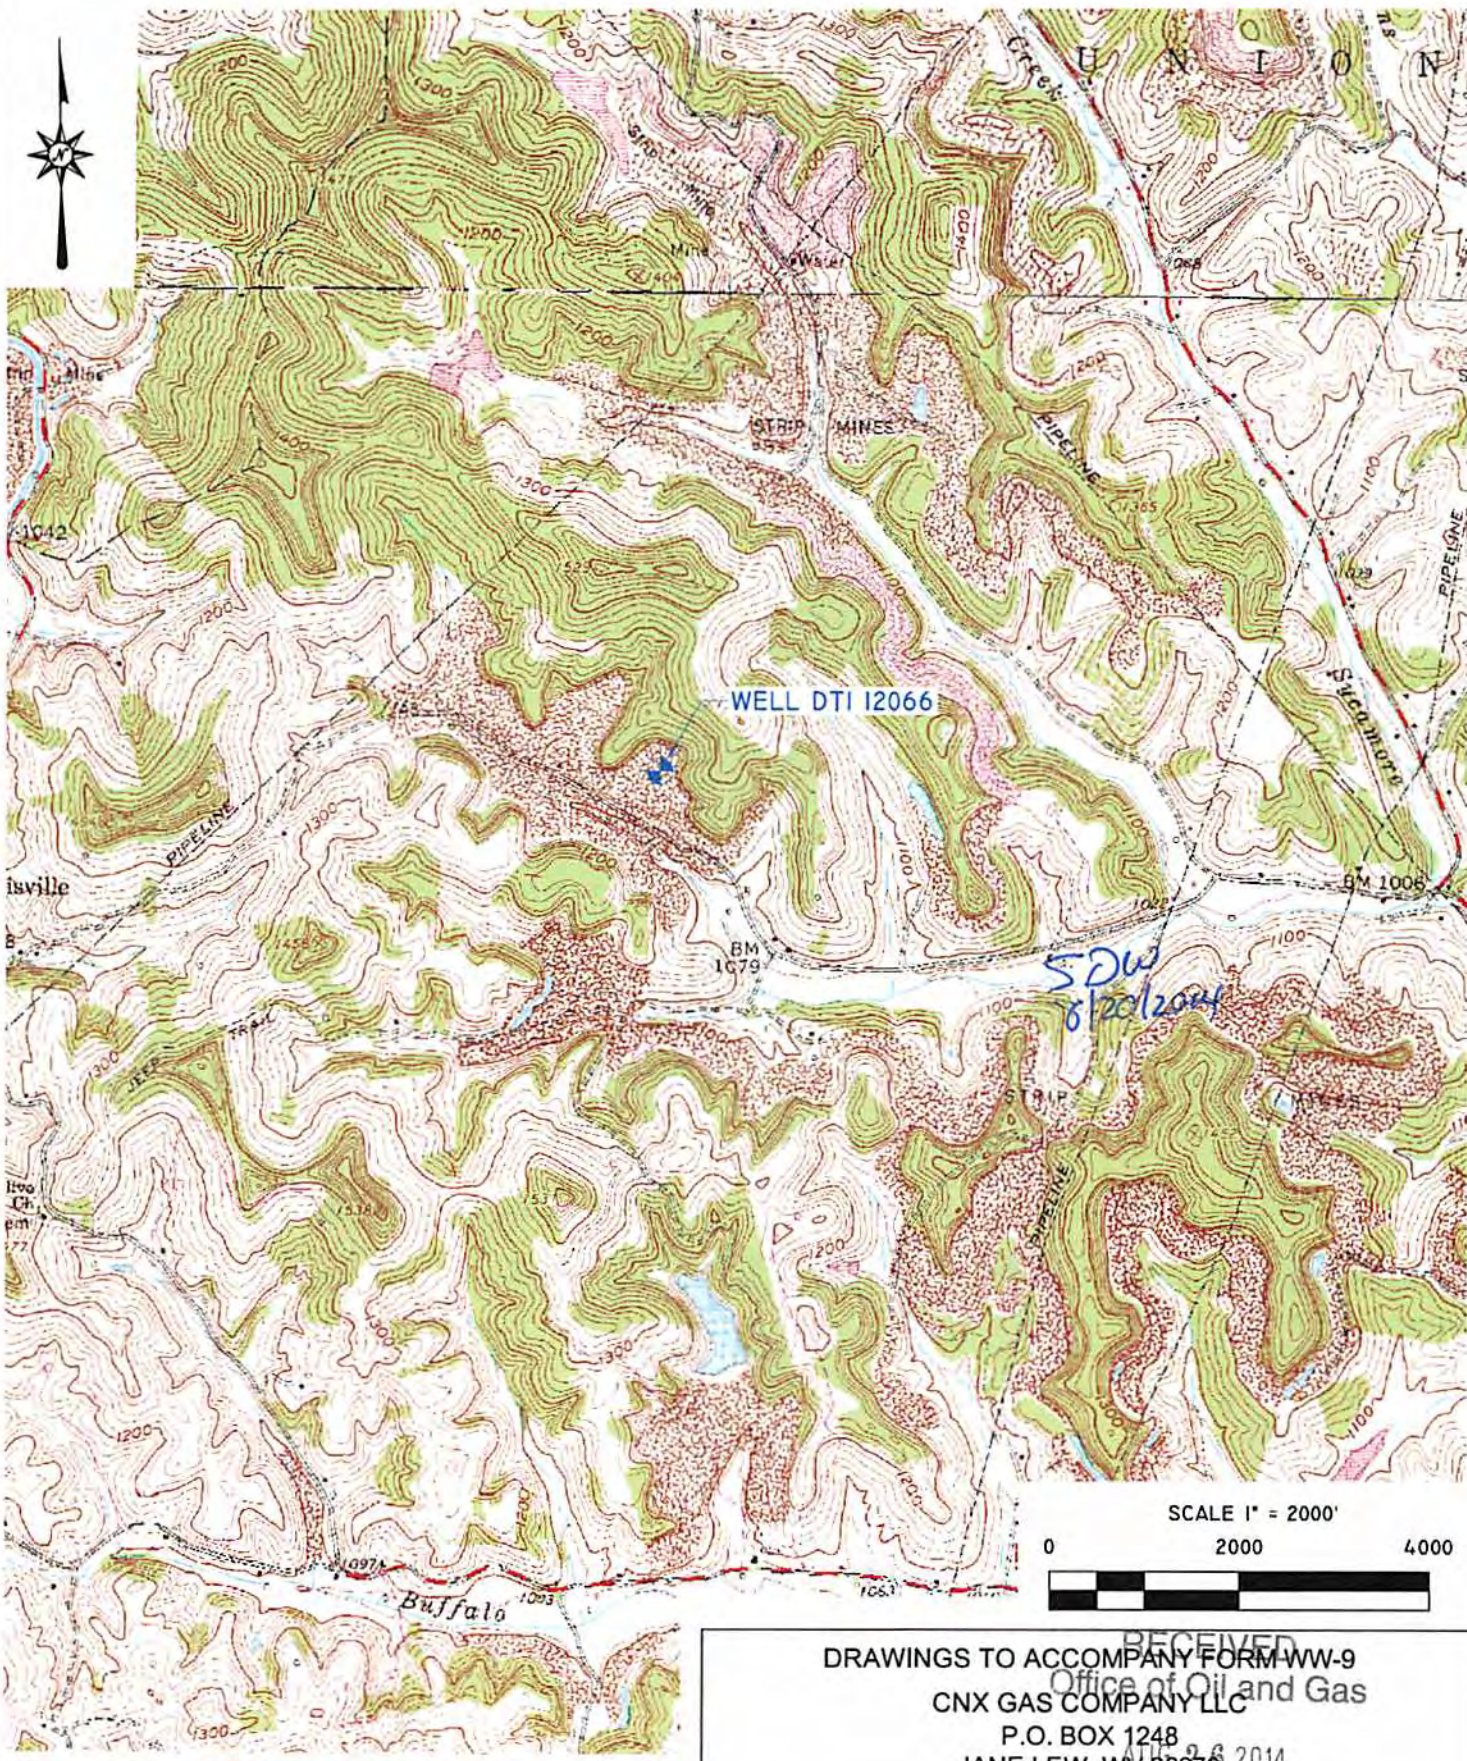

**Blue Mountain Inc.**  
 11023 MASON DIXON HIGHWAY  
 BURTON, WV 26562  
 PHONE: (304) 662-6486

RECEIVED  
 Office of Oil and Gas  
 CNX GAS COMPANY LLC  
 P.O. BOX 1248  
 JANE LEW, WV 26378 8/26/2014

WV Department of  

WATERSHED: SYCAMORE CREEK  
 DISTRICT: UNION COUNTY  
 QUADRANGLE: WESTON WELL NO.: DTI 12066  
 DATE: 08/04/14 PAGE 3 OF 3