

3301270F

WW-7  
5-02



West Virginia Department of Environmental Protection  
Office of Oil and Gas  
WELL LOCATION FORM: GPS

API: 47-033-01270 WELL NO.: 902

FARM NAME: J. D. FORTNEY 340 ACRES

RESPONSIBLE PARTY NAME: CNX GAS COMPANY LLC

COUNTY: HARRISON DISTRICT: EAGLE

QUADRANGLE: CLARKSBURG 7.5'

SURFACE OWNER: RANDALL L. PRESTON, ET. AL., P. O. BOX 79, HEPZIBAH, WV 26369

ROYALTY OWNER: BRENDA SWIGER

UTM GPS NORTHING: 4,357,812.75 METERS

UTM GPS EASTING: 557,842.98 METERS GPS ELEVATION: 328.274 METERS (1077.1')

The Responsible Party named above has chosen to submit GPS coordinates in lieu of preparing a new well location plat for a plugging permit on the above well. The Office of Oil and Gas will not accept GPS coordinates that do not meet the following requirements:

1. Datum: NAD 1983, Zone: 17 Coordinate Units: meters Altitude: Height above mean sea level (MSL) - meters

2. Accuracy to Datum - 3.05 meters

3. Data Collection Method: Survey Grade GPS  ; Post Processed Differential  Real-Time Differential   
Mapping Grade GPS  ; Post Processed Differential  Real-Time Differential

Received  
Office of Oil & Gas  
MAR 25 2015

I the undersigned hereby state this data is correct to the best of my knowledge and belief and shows all the information required by law and the regulation issued and prescribed by the Office of Oil and Gas.

Signature J. Michael Evans  
J. MICHAEL EVANS, PS

Title WV Professional Surveyor #900

Date NOVEMBER 18, 2014


Received  
Office of Oil & Gas  
MAR 11 2015



CNX USE: NAD 27 WV NORTH SPC: 902 = N317,134.53 E1,765,709.00' ELEV. = 1,077.01'




3301270P

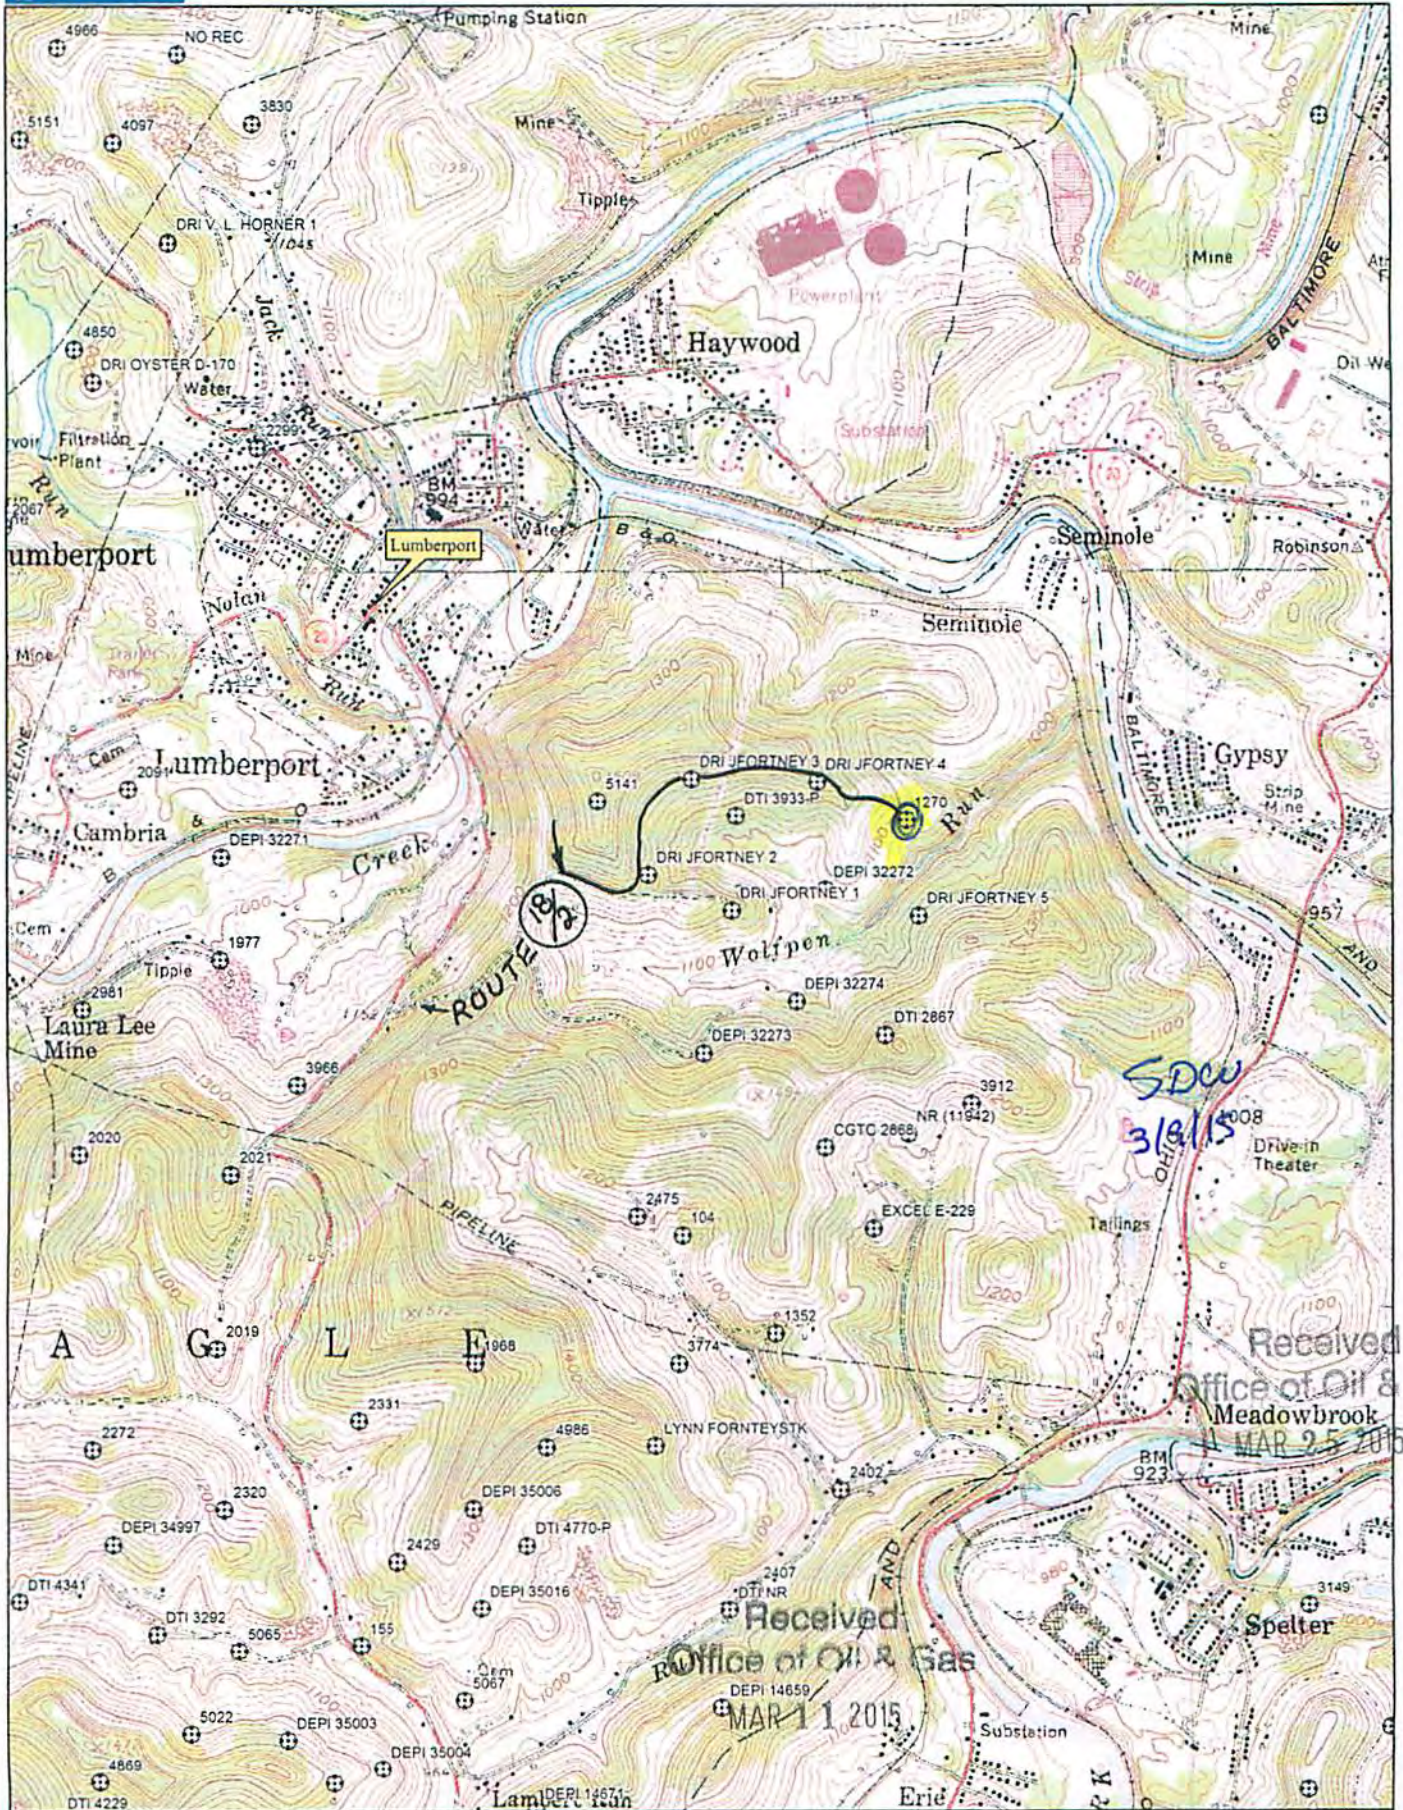

Data use subject to license.

© DeLorme. XMap® 7.

www.delorme.com

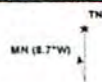

Scale 1 : 24,000



1" = 2,000.0 ft Data Zoom 13-0