


47-033-02081P

12'30"

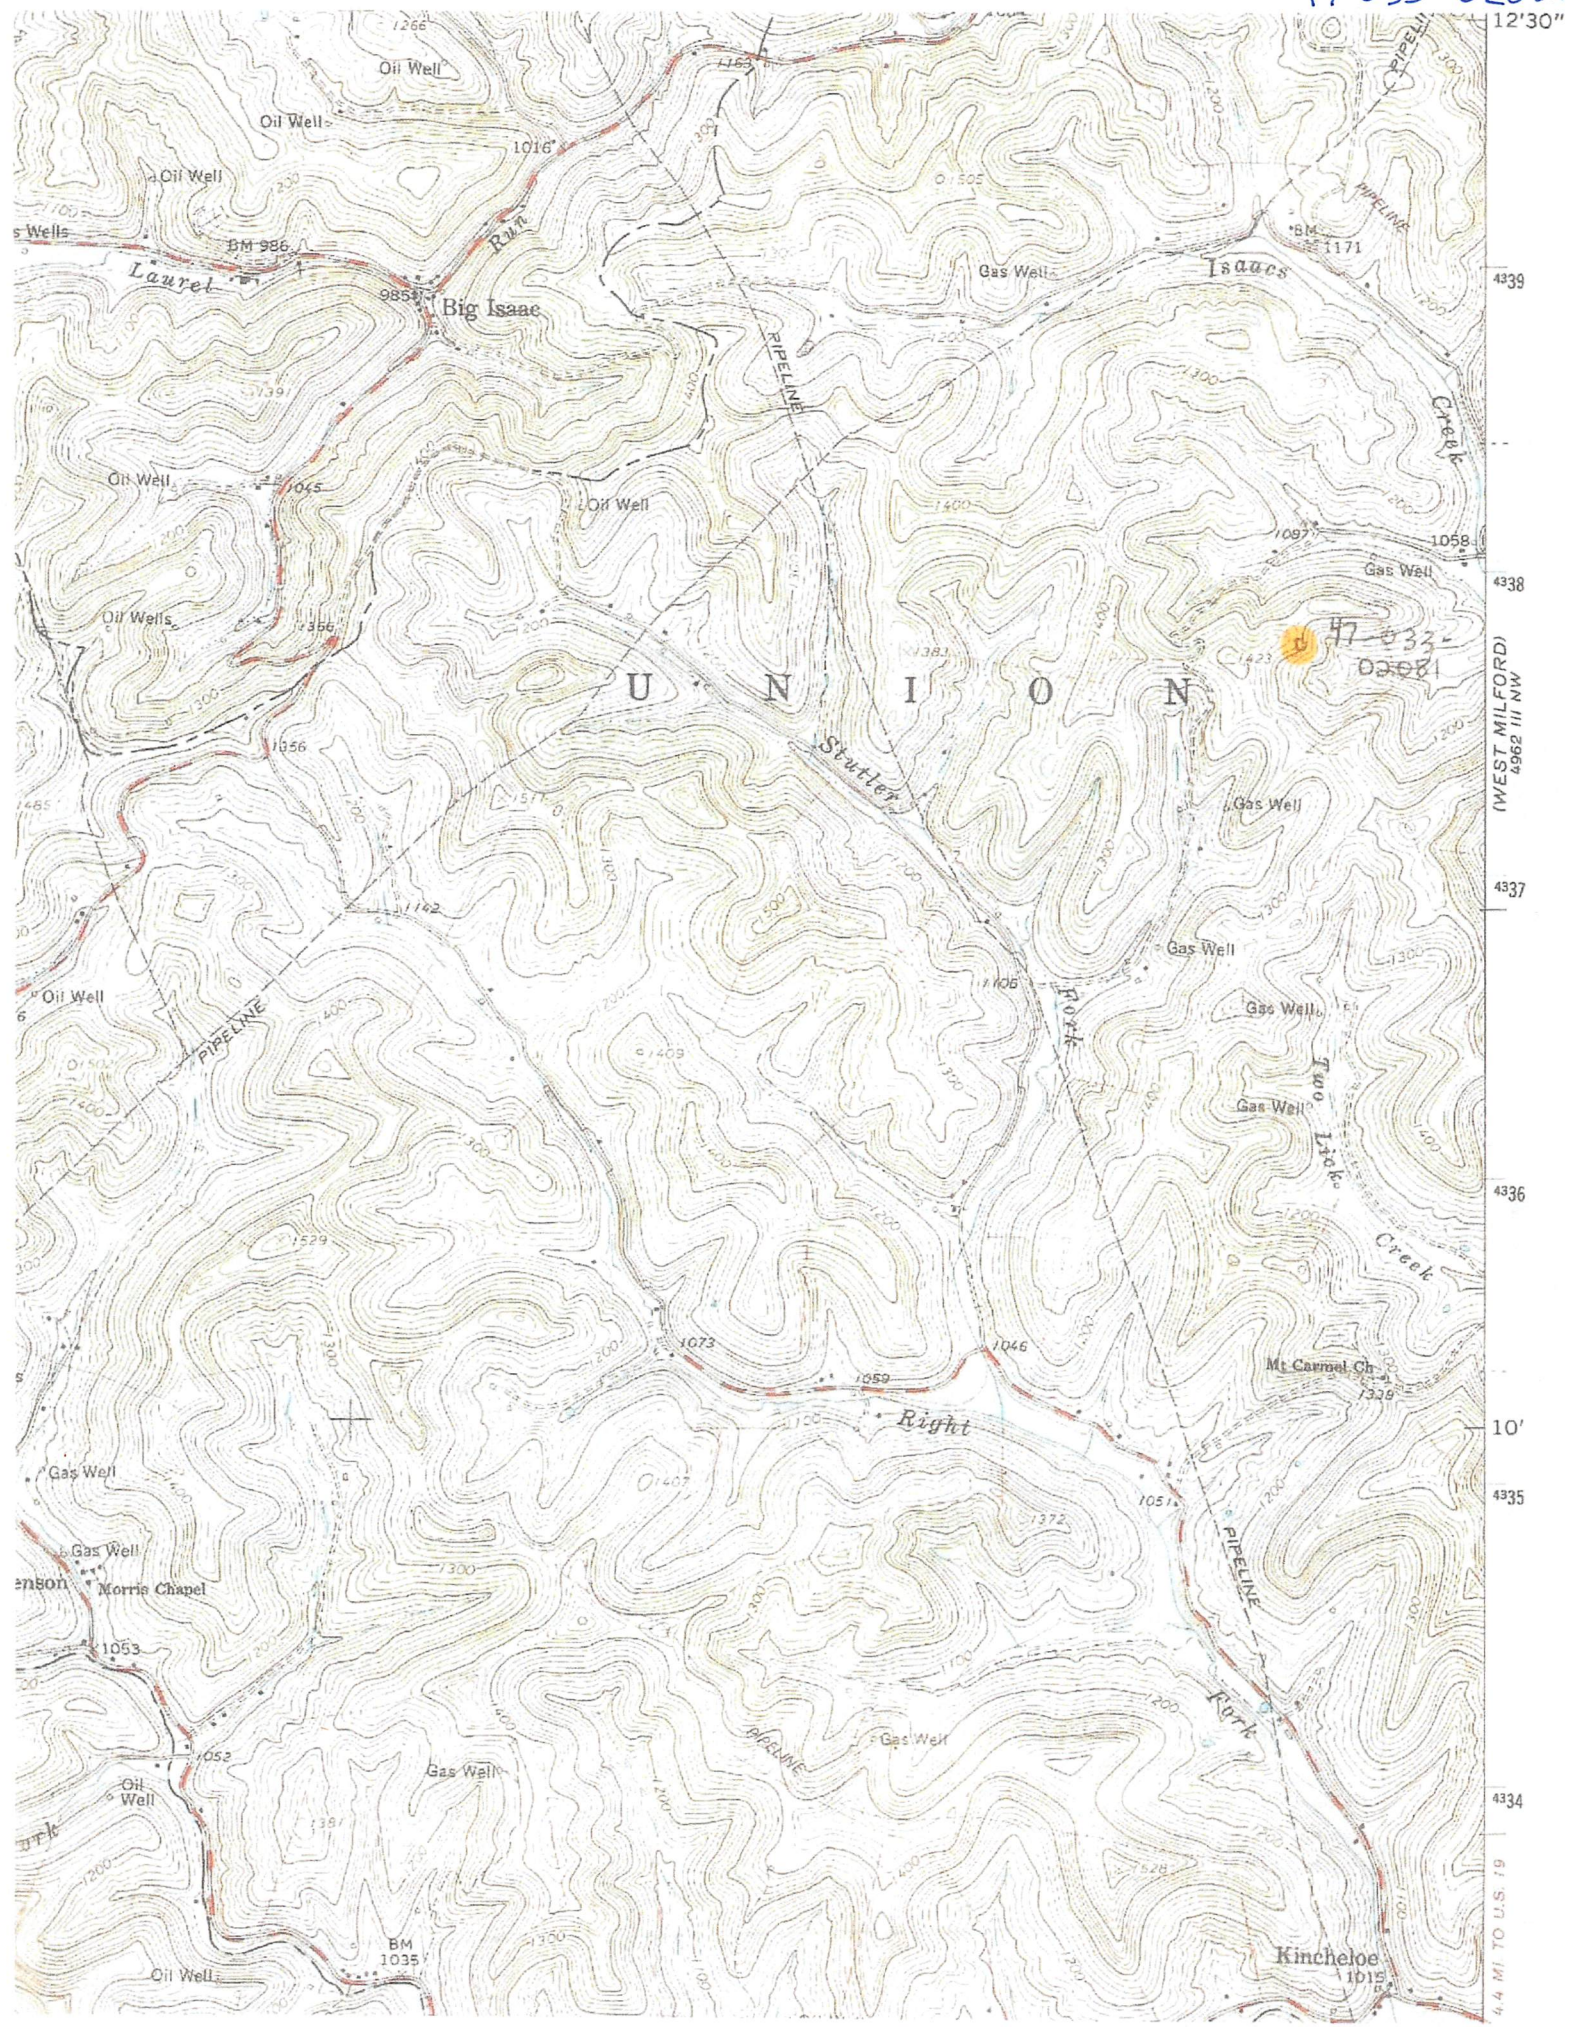

WEST MILFORD  
4962 III NW

4337

4336

4335

4334

4.4 MI TO U.S. 19