

WW-7
8-30-06



West Virginia Department of Environmental Protection
Office of Oil and Gas

WELL LOCATION FORM: GPS

API: 47-033-03438 WELL NO.: E-8004

FARM NAME: Morosa

RESPONSIBLE PARTY NAME: XTO Energy, Inc.

COUNTY: Harrison DISTRICT: Eagle and Clay

QUADRANGLE: Shinnston

SURFACE OWNER: William Salerno

ROYALTY OWNER: See attached list

UTM GPS NORTHING: 4364078.2

UTM GPS EASTING: 556743.9 GPS ELEVATION: 364m (1193')

The Responsible Party named above has chosen to submit GPS coordinates in lieu of preparing a new well location plat for a plugging permit or assigned API number on the above well. The Office of Oil and Gas will not accept GPS coordinates that do not meet the following requirements:

1. Datum: NAD 1983, Zone: 17 North, Coordinate Units: meters, Altitude: height above mean sea level (MSL) – meters.
2. Accuracy to Datum – 3.05 meters
3. Data Collection Method:

Survey grade GPS ; Post Processed Differential

Real-Time Differential

Mapping Grade GPS ; Post Processed Differential

Real-Time Differential

4. Letter size copy of the topography map showing the well location.

I the undersigned, hereby certify this data is correct to the best of my knowledge and belief and shows all the information required by law and the regulations issued and prescribed by the Office of Oil and Gas.


[Signature]
Signature

Project Manager
Title

May 29, 2015
Date

07/17/2015


RECEIVED
Office of Oil and Gas
JUN 04 2015
WV Department of
Environmental Protection

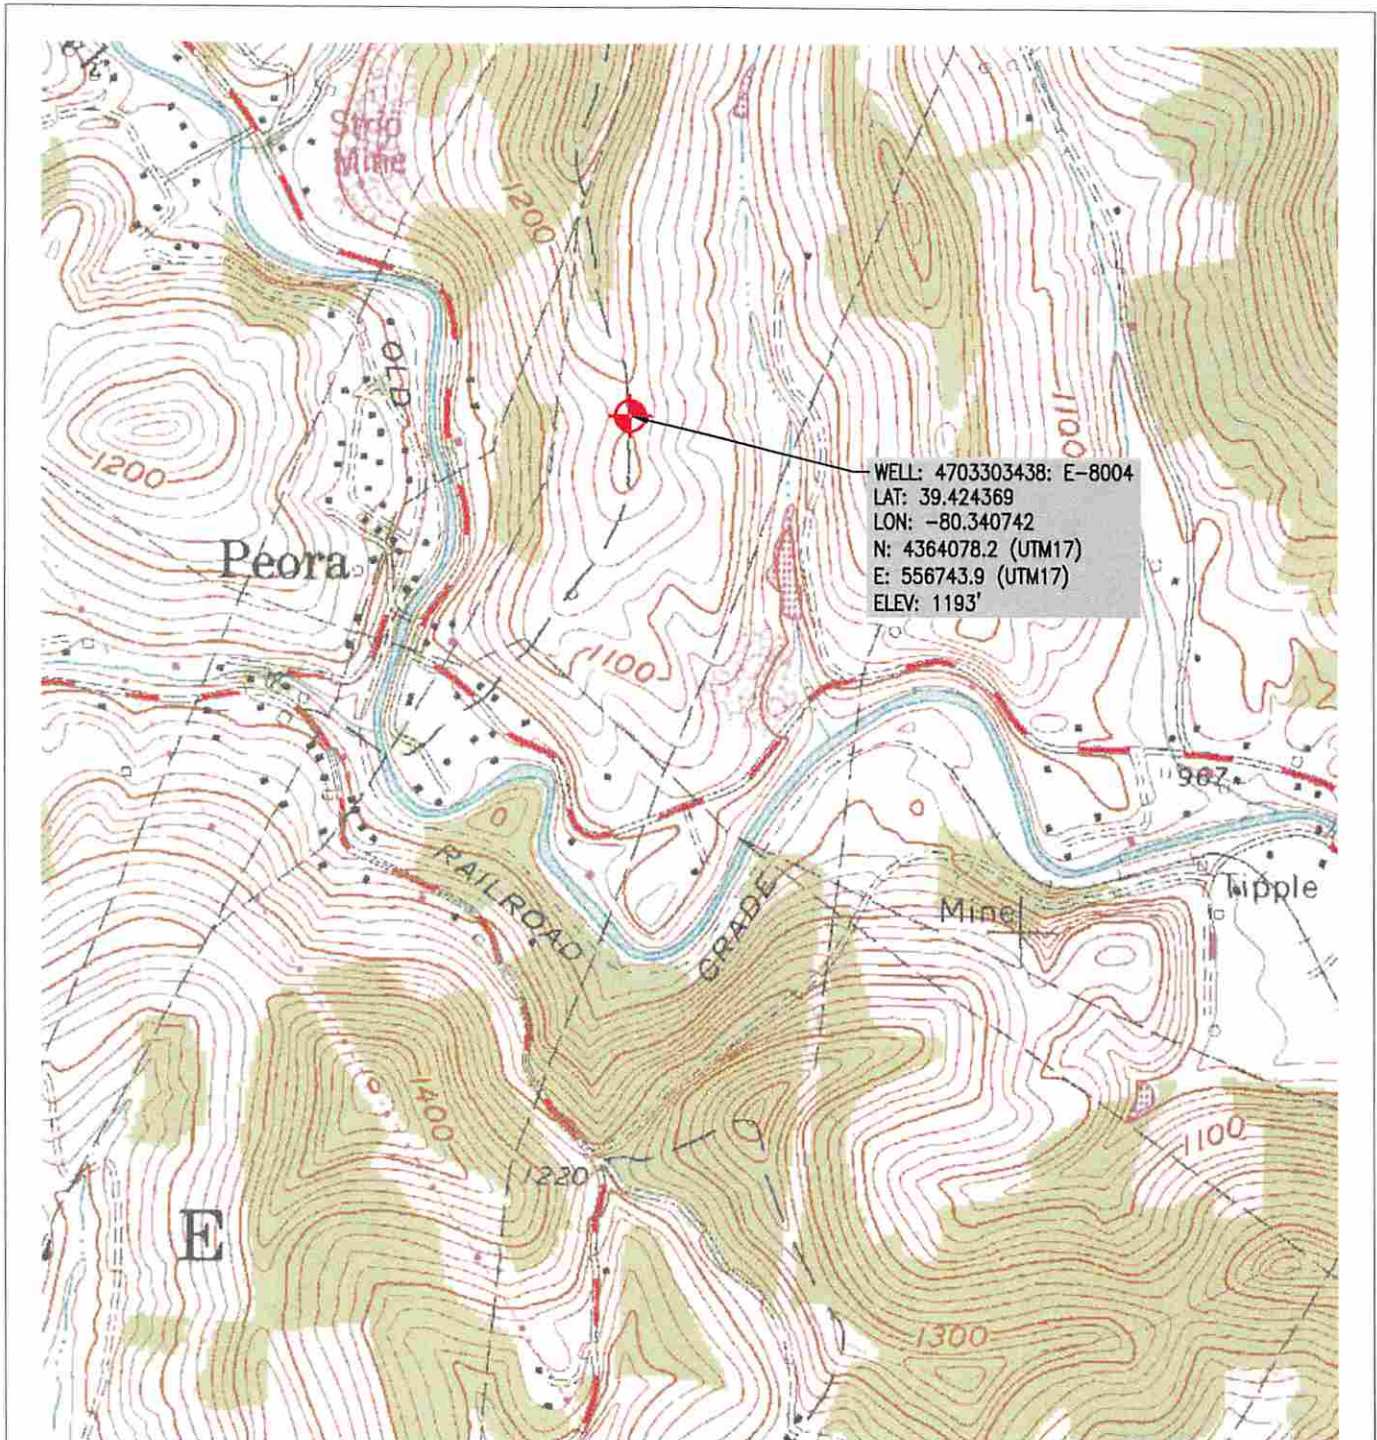

MAP REFERENCE: U.S.G.S. SHINNSTON, WV



810 HOUSTON STREET
FORT WORTH, TX 76102

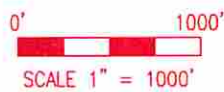

Voice: (724) 635-0210

TRI-COUNTY ENGINEERING, LLC

An ENERCON Company
319 Paintersville Road
Hunker, PA 15639
www.tricountyeng.com

Fax: (724) 635-0676



Excellence-Every project. Every day.

LOCATION MAP

MOROSA E-8004 WELL PLUG

DRAWN BY:
ZJC
DATE:
5/12/2015
SCALE:
AS NOTED

EAGLE AND CLAY DISTRICTS,
HARRISON COUNTY, WEST VIRGINIA
SHEET:
1 OF 1
FILE NO.
OG61-18

07/17/2015

RECEIVED
Office of Oil and Gas

JUN 04 2015

WV Department of
Environmental Protection