



Diversified Gas & Oil
Corporation
100 Diversified Way
Pikeville KY, 41051

47-033-03607

Well Plugging Map




Legend


- Well
- Access Road
- Pits
- Pad
- Public Roads

RECEIVED
Office of Oil and Gas

APR 04 2025

WV Department of
Environmental Protection

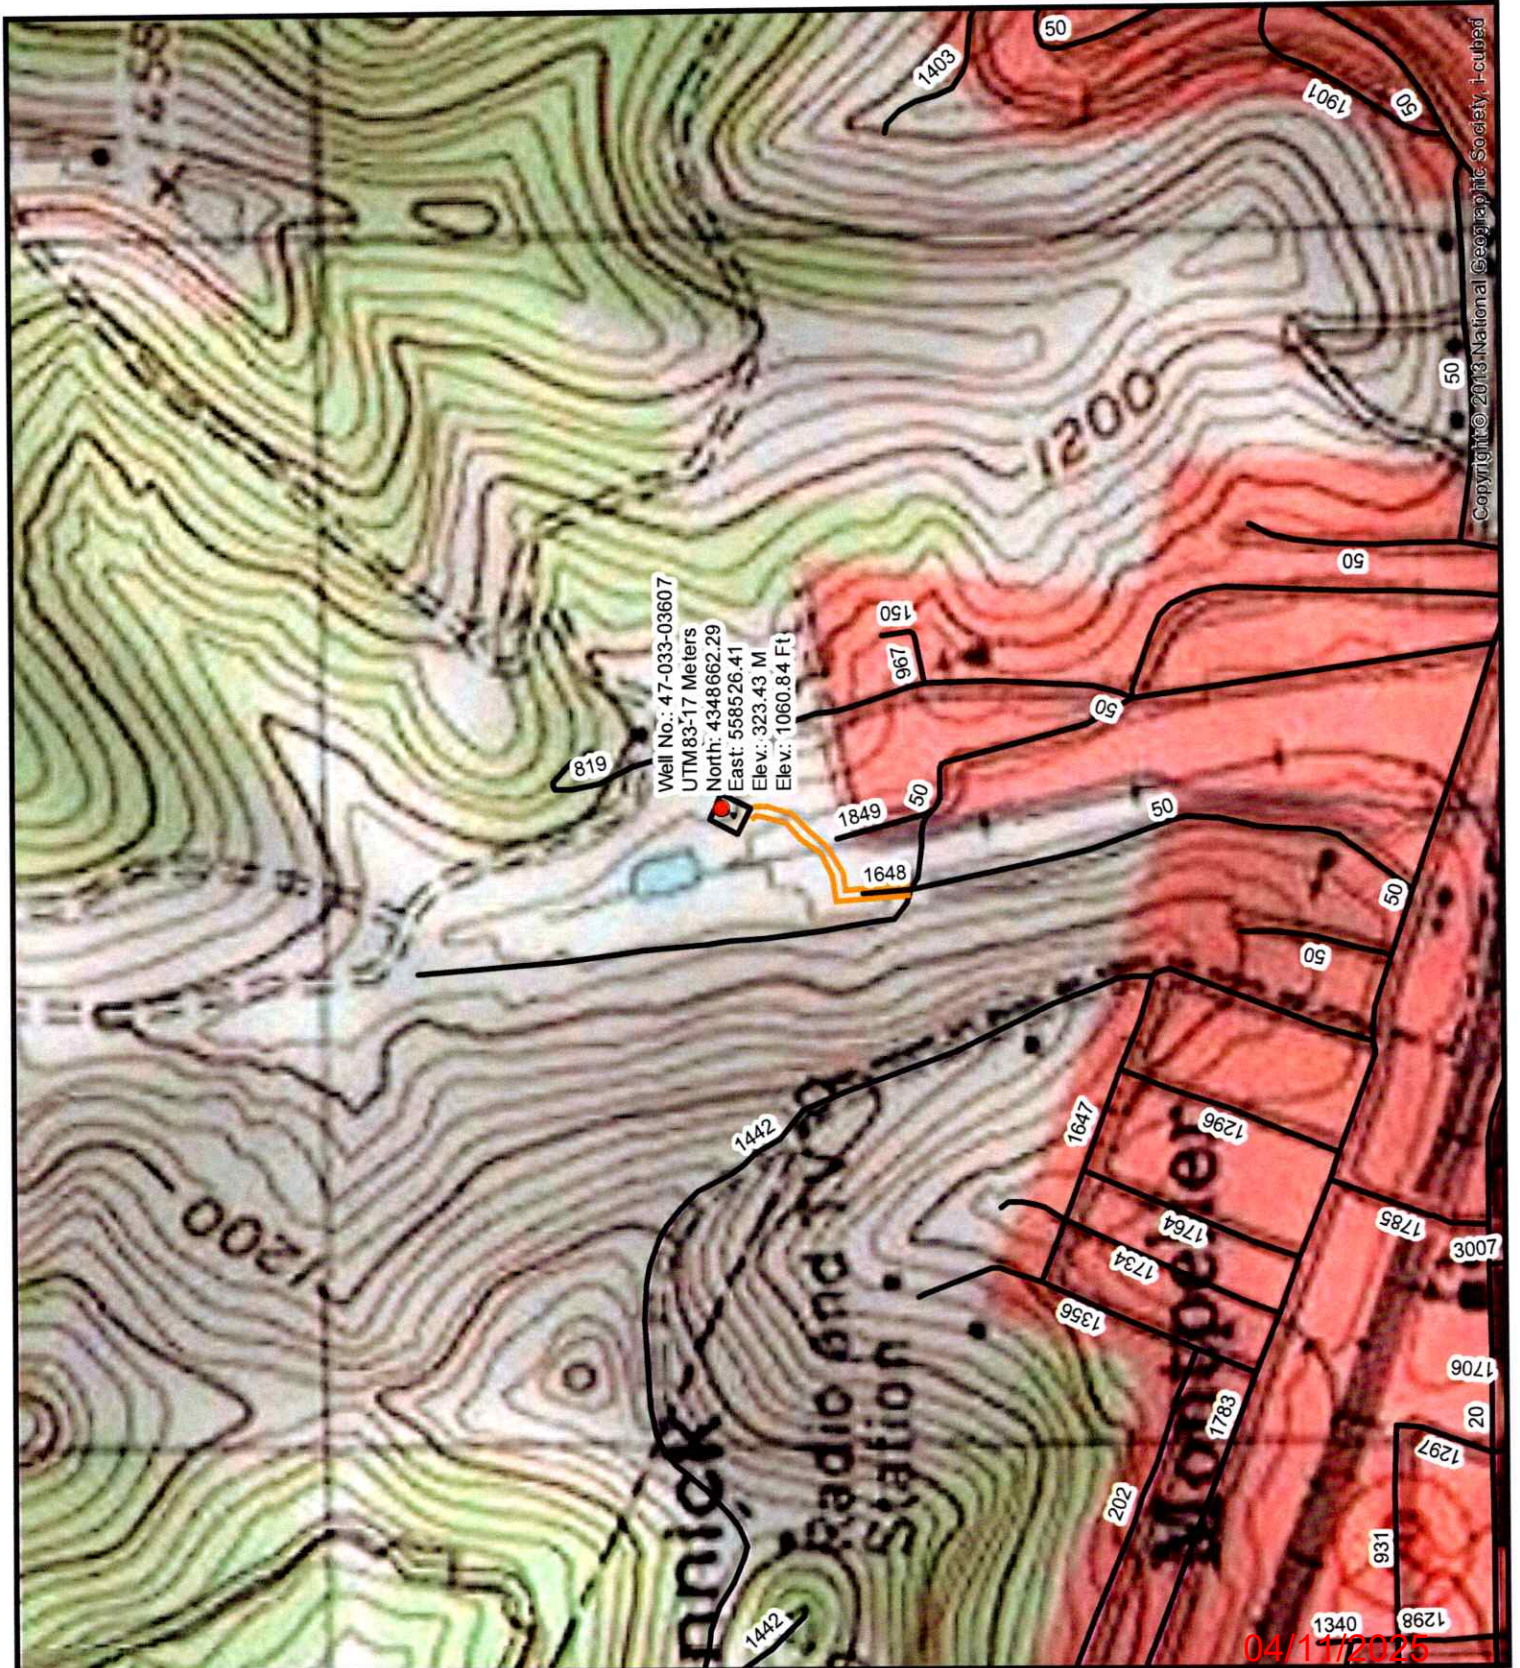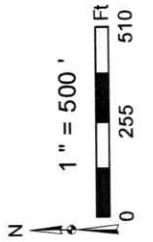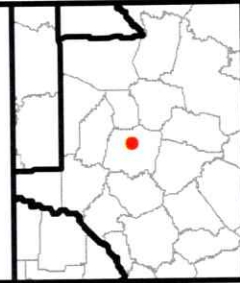

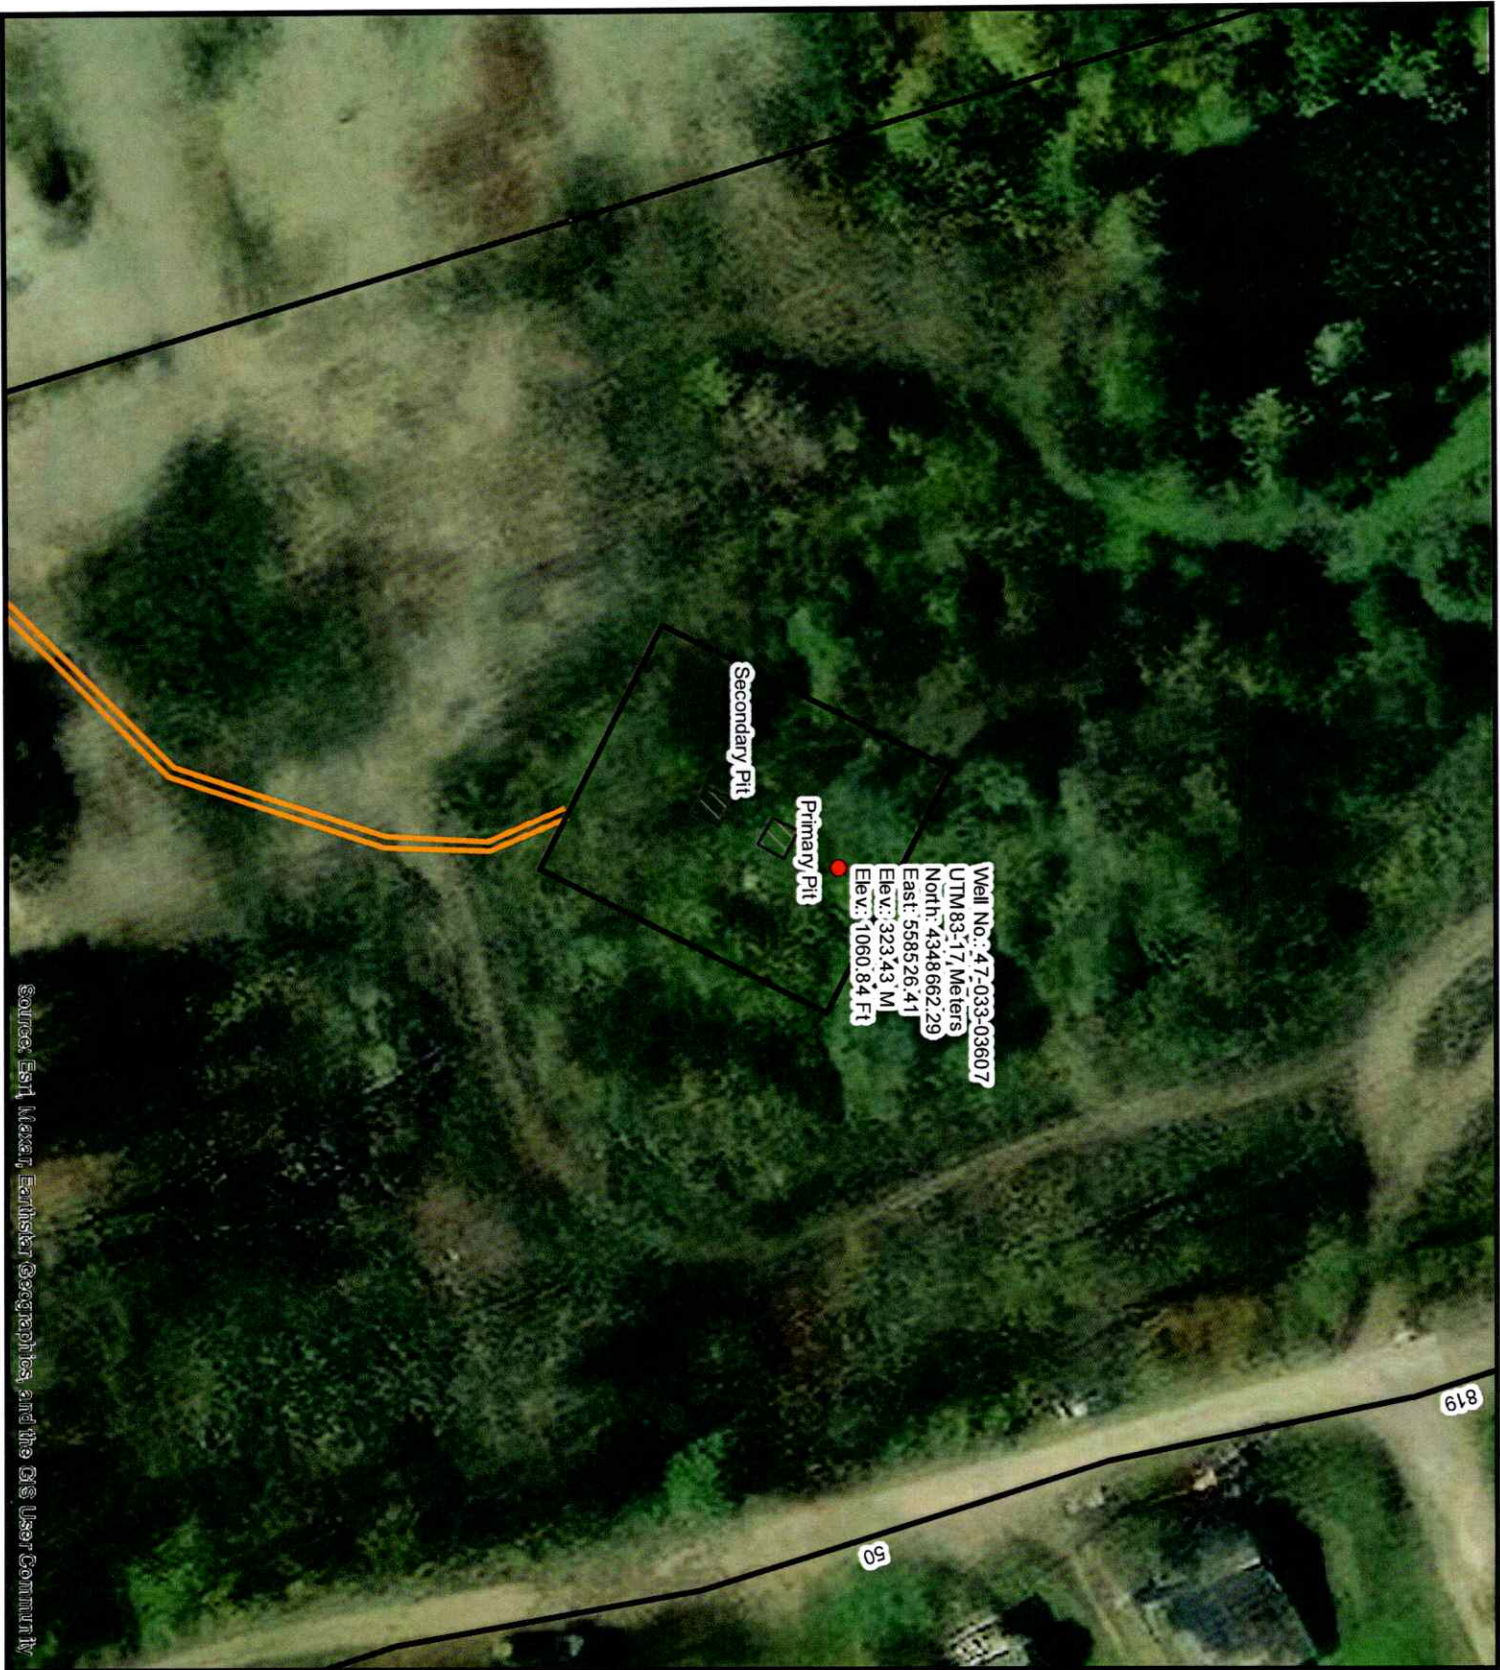

Diversified Gas & Oil
 Corporation
 100 Diversified Way
 Pikeville KY, 41051

04/11/2025



47-033-03607

Well Plugging Map

Legend

- Well
- ▬ Access Road
- ▨ Pits
- ▭ Pad
- Public Roads

RECEIVED
 Office of Oil and Gas
 APR 04 2025
 WV Department of
 Environmental Protection

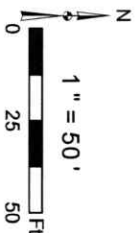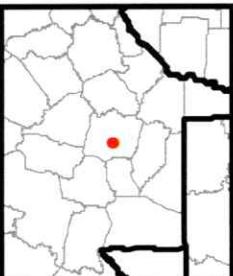

WW-7
8-30-06



West Virginia Department of Environmental Protection
Office of Oil and Gas
WELL LOCATION FORM: GPS

API: 4703303607 WELL NO.: Jackson
FARM NAME: P.K. Development
RESPONSIBLE PARTY NAME: Diversified Production, LLC
COUNTY: Harrison DISTRICT: Coal
QUADRANGLE: Clarksburg 7.5'
SURFACE OWNER: Harrison County Commission
ROYALTY OWNER: See Attached
UTM GPS NORTHING: 434866.29
UTM GPS EASTING: 558526.41 GPS ELEVATION: 1060.84'

The Responsible Party named above has chosen to submit GPS coordinates in lieu of preparing a new well location plat for a plugging permit or assigned API number on the above well. The Office of Oil and Gas will not accept GPS coordinates that do not meet the following requirements:

1. Datum: NAD 1983, Zone: 17 North, Coordinate Units: meters, Altitude: height above mean sea level (MSL) – meters.
2. Accuracy to Datum – 3.05 meters
3. Data Collection Method:
Survey grade GPS ____: Post Processed Differential ____
Real-Time Differential ____
Mapping Grade GPS X: Post Processed Differential X
Real-Time Differential ____

RECEIVED
Office of Oil and Gas

APR 04 2025

WV Department of
Environmental Protection

4. Letter size copy of the topography map showing the well location.
I the undersigned, hereby certify this data is correct to the best of my knowledge and belief and shows all the information required by law and the regulations issued and prescribed by the Office of Oil and Gas.


Signature

Chris Veazey - Director of Administration
Title

3/31/2025
Date

04/11/2025