

WW-7  
8-30-06



West Virginia Department of Environmental Protection  
Office of Oil and Gas

**WELL LOCATION FORM: GPS**

API: 47-033-05794 WELL NO.: Plaughter 1H

FARM NAME: Varner West

RESPONSIBLE PARTY NAME: Antero Resources Corporation

COUNTY: Harrison DISTRICT: Tenmile

QUADRANGLE: Salem & Big Isaac

SURFACE OWNER: James A. Varner

ROYALTY OWNER: James A. Varner Sr.

UTM GPS NORTHING: 4345136.35 m

UTM GPS EASTING: 539077.24 m GPS ELEVATION: 1455.7 ft

The Responsible Party named above has chosen to submit GPS coordinates in lieu of preparing a new well location plat for a plugging permit or assigned API number on the above well. The Office of Oil and Gas will not accept GPS coordinates that do not meet the following requirements:

- Datum: NAD 1983, Zone: 17 North, Coordinate Units: meters, Altitude: height above mean sea level (MSL) – meters.
- Accuracy to Datum – 3.05 meters
- Data Collection Method:

Survey grade GPS X: Post Processed Differential \_\_\_\_\_


Real-Time Differential X

Mapping Grade GPS X: Post Processed Differential \_\_\_\_\_

Real-Time Differential X

- Letter size copy of the topography map showing the well location.

I the undersigned, hereby certify this data is correct to the best of my knowledge and belief and shows all the information required by law and the regulations issued and prescribed by the Office of Oil and Gas.

  
Signature

Permitting Manager

Title

4/14/22

Date


RECEIVED  
Office of Oil and Gas

APR 26 2022

WV Department of  
Environmental Protection

05/27/2022



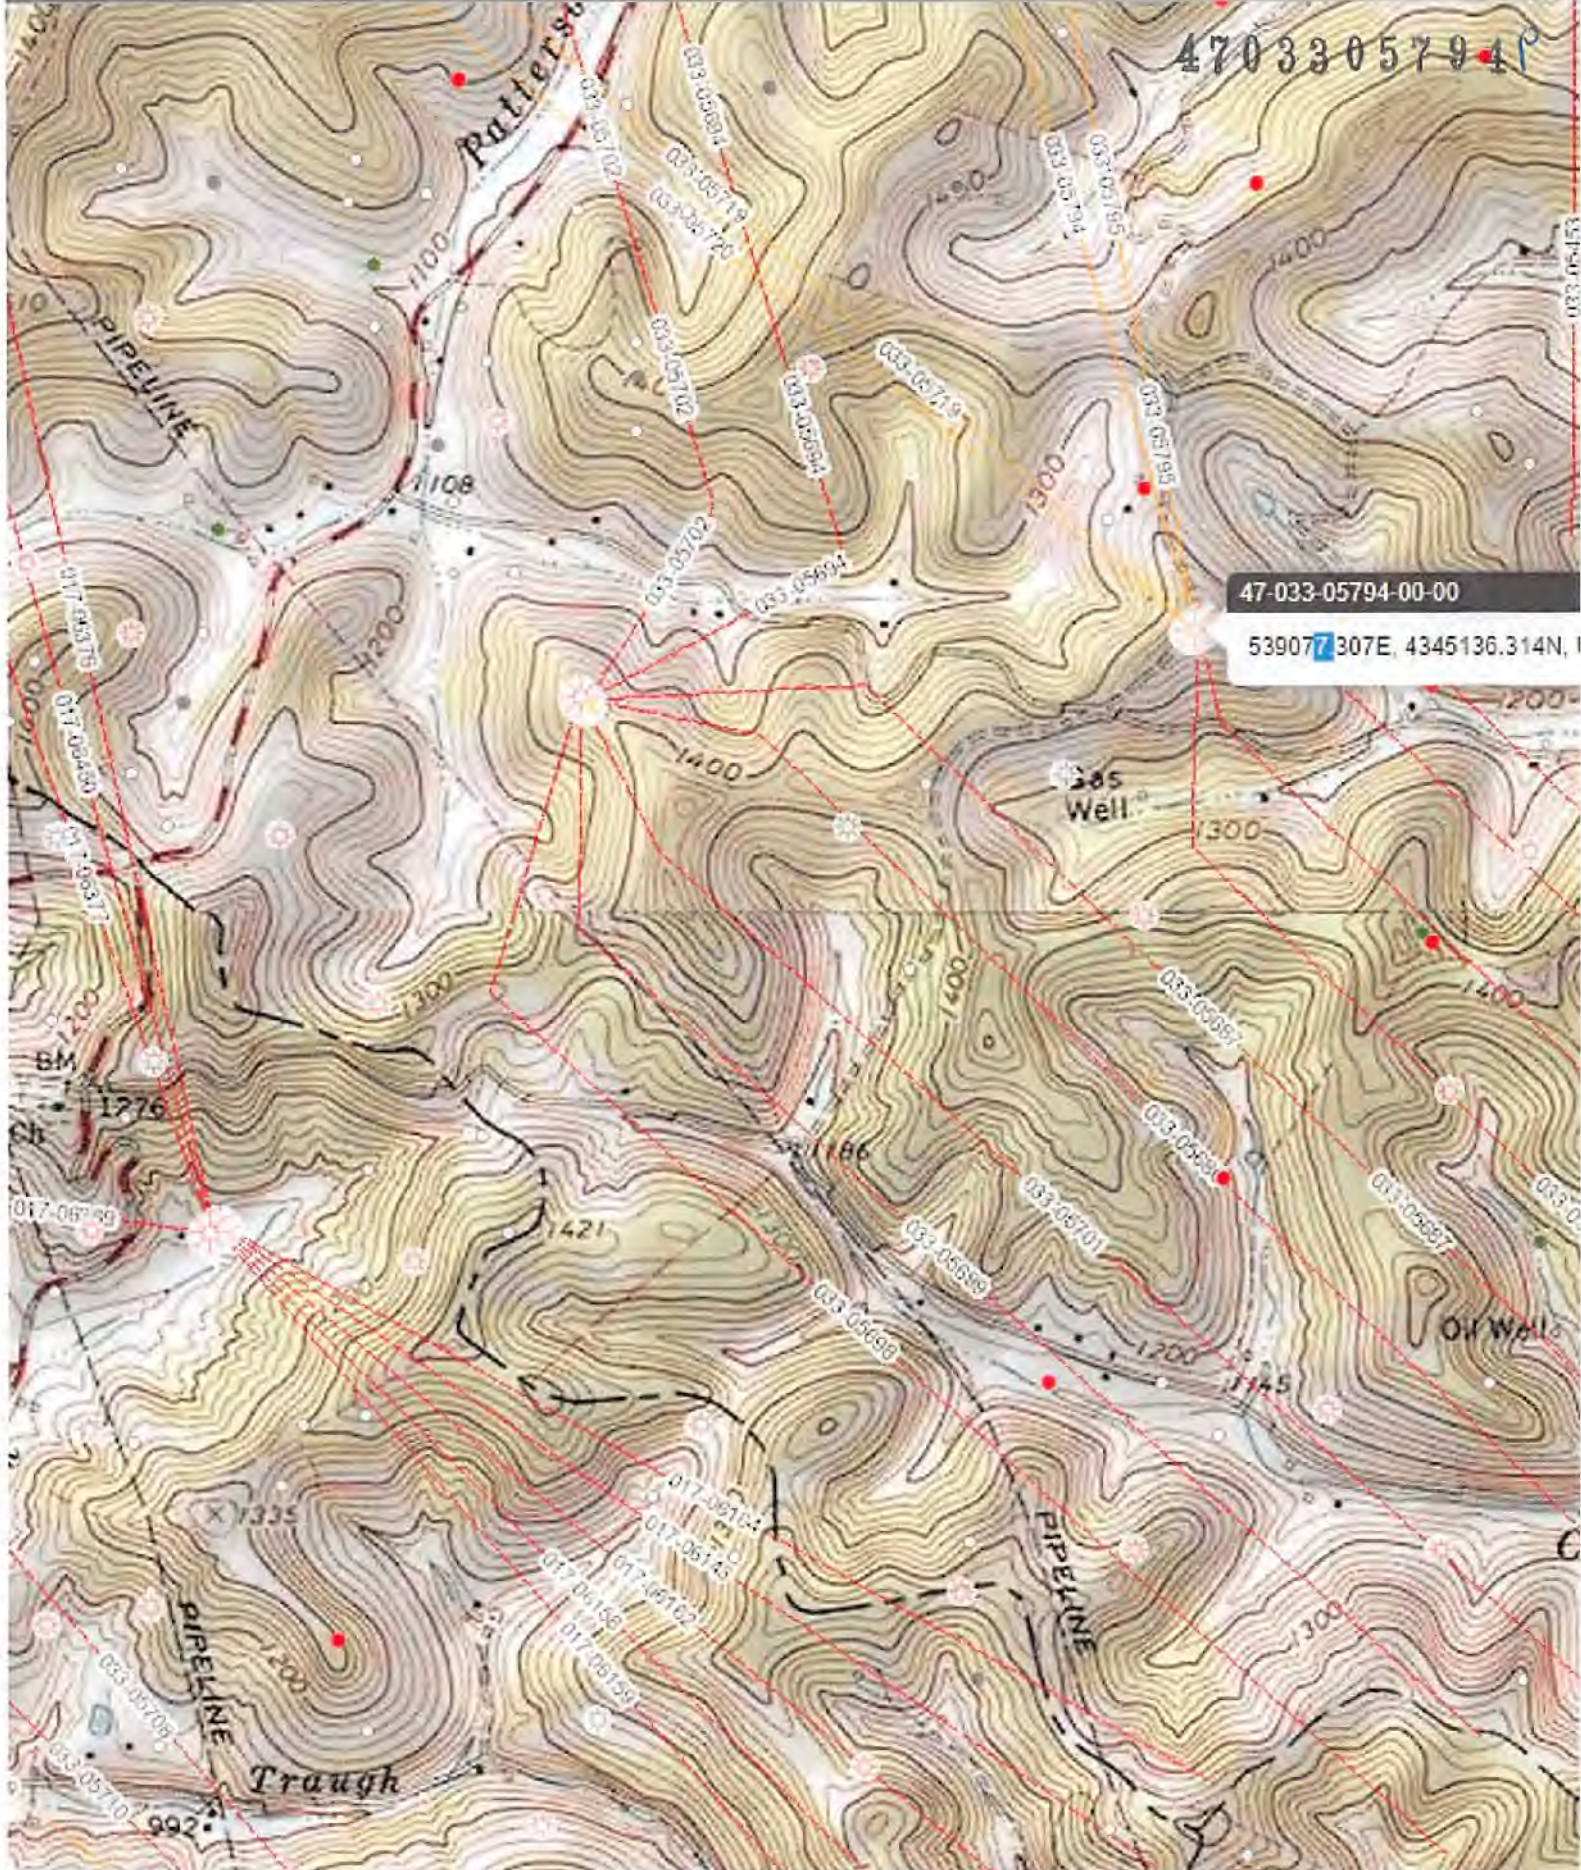

🔍 Type here to search



05/27/2022