

HG Energy II
 Appalachia, LLC
 Well No. Schoen
 1205 N-2H As-Drilled

Page 2 of 5



Legend	
	Proposed gas well
	Well Reference, as noted
	Monument, as noted
	Existing Well, as noted
	Existing Plugged Well, as noted
	Digitized Well, as noted
	Surface boundary (approx.)
	Interior surface tracts (approx.)
	Creek or Drain
	Existing Road
	Railroad Tracks

ID	Lease
s1	A.B. Post, et al
s3	Emma A. Waggoner, et al
s4	Charlotte C. Gerlach, et al
s6	Susan V. Curry, et al
2	Marcella R. Bond, et vir et al
4	Gertude Hardaway, et al
17	Lillie Gifford, et al
17.1	Lillie Gifford, et al
19	Georgia A. Barnes
20	Ray T. Swisher, et al
21	A.W. Smith
22	Frank Swisher, et al
25	C.H. Woodford, et ux, et al
32	Porter Maxwell, et ux, et al
34	I. Wilson & Edna M. Swisher
37	W.B. Van Horn, et ux
38	Locie C. Stout, et al
42	O. Glen Kennedy, et al


West Virginia Coordinate
 System of 1927, North Zone
 based upon Differential GPS
 Measurements.

Notes: Well No.
 Schoen 1205 N-2H
 WVCS 1927, North Zone
 Top Hole Coordinates
 Lat: 39°09'08.40"
 Lon: 80°21'07.59"
 Landing Point Coordinates
 Lat: 39°09'04.22"
 Lon: 80°21'24.90"
 Bottom Hole Coordinates
 Lat: 39°11'45.93"
 Lon: 80°22'37.16"

UTM Zone 17, NAD 1983
 Plat orientation and corner and well references are based
 upon the grid north meridian. Well location references are
 based upon the magnetic meridian.

Notes: Well No.
 Schoen 1205 N-2H
 UTM NAD 1983 (USF)
 Top Hole Coordinates
 N: 14,218,776.04'
 E: 1,824,137.36'
 Landing Point Coordinates
 N: 14,218,343.38'
 E: 1,822,776.70'
 Bottom Hole Coordinates
 N: 14,234,658.73'
 E: 1,816,974.15'

Notes: Well No.
 Schoen 1205 N-2H
 UTM NAD 1983 (Meters)
 Top Hole Coordinates
 N: 4,333,891.603m
 E: 555,998.179m
 Landing Point Coordinates
 N: 4,333,759.730m
 E: 555,583.449m
 Bottom Hole Coordinates
 N: 4,338,732.658m
 E: 553,814.829m

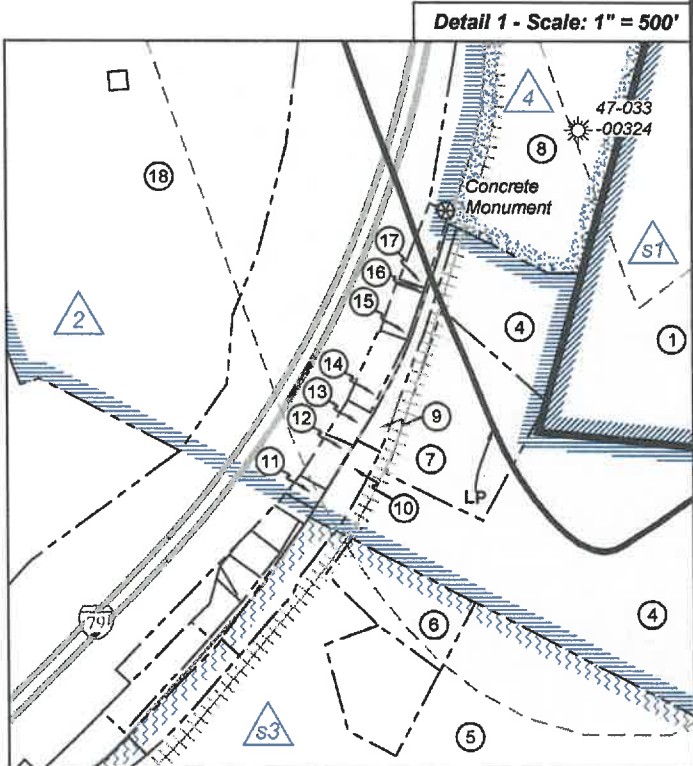

FILE NO: 32-36-G-19
 DRAWING NO: Schoen 1205 N-2H Well Plat
 SCALE: 1" = 2000'
 MINIMUM DEGREE OF ACCURACY:
 Submeter
 PROVEN SOURCE OF ELEVATION:
 CORS, Bridgeport, WV

STATE OF WEST VIRGINIA
 DEPARTMENT OF ENVIRONMENTAL PROTECTION
 OIL AND GAS DIVISION

DATE: May 14 20 25
 OPERATOR'S WELL NO. Schoen 1205 N-2H
 API WELL NO
 47 — 033 — 06000
 STATE COUNTY PERMIT


WELL TYPE: ☐ OIL ☒ GAS ☐ LIQUID INJECTION ☐ WASTE DISPOSAL
 (IF GAS) PRODUCTION : ☐ STORAGE ☐ DEEP ☒ SHALLOW

LOCATION: ELEVATION: 1,407.3' WATERSHED: Middle West Fork Creek
 DISTRICT: Grant / Union
 SURFACE OWNER: George & Rosanne Schoen
 ROYALTY OWNER: Willa Post Robey, et al LEASE NO: ACREAGE: 65.00
 PROPOSED WORK: ☒ DRILL ☐ CONVERT ☐ DRILL DEEPER ☐ FRACTURE OR STIMULATE ☐ PLUG OFF OLD FORMATION
☐ PERFORATE NEW FORMATION ☒ OTHER PHYSICAL CHANGE IN WELL (SPECIFY) As-Drilled
☐ PLUG AND ABANDON ☐ CLEAN OUT AND REPLUG TARGET FORMATION: Marcellus Shale ESTIMATED DEPTH: 7,463' TVD 25,009' MD

WELL OPERATOR: HG Energy II Appalachia, LLC DESIGNATED AGENT: Diane C. White
 ADDRESS: 5260 Dupont Road ADDRESS: 5260 Dupont Road
 Parkersburg, WV 26101 Parkersburg, WV 26101



Detail 2 - Scale: 1" = 500'

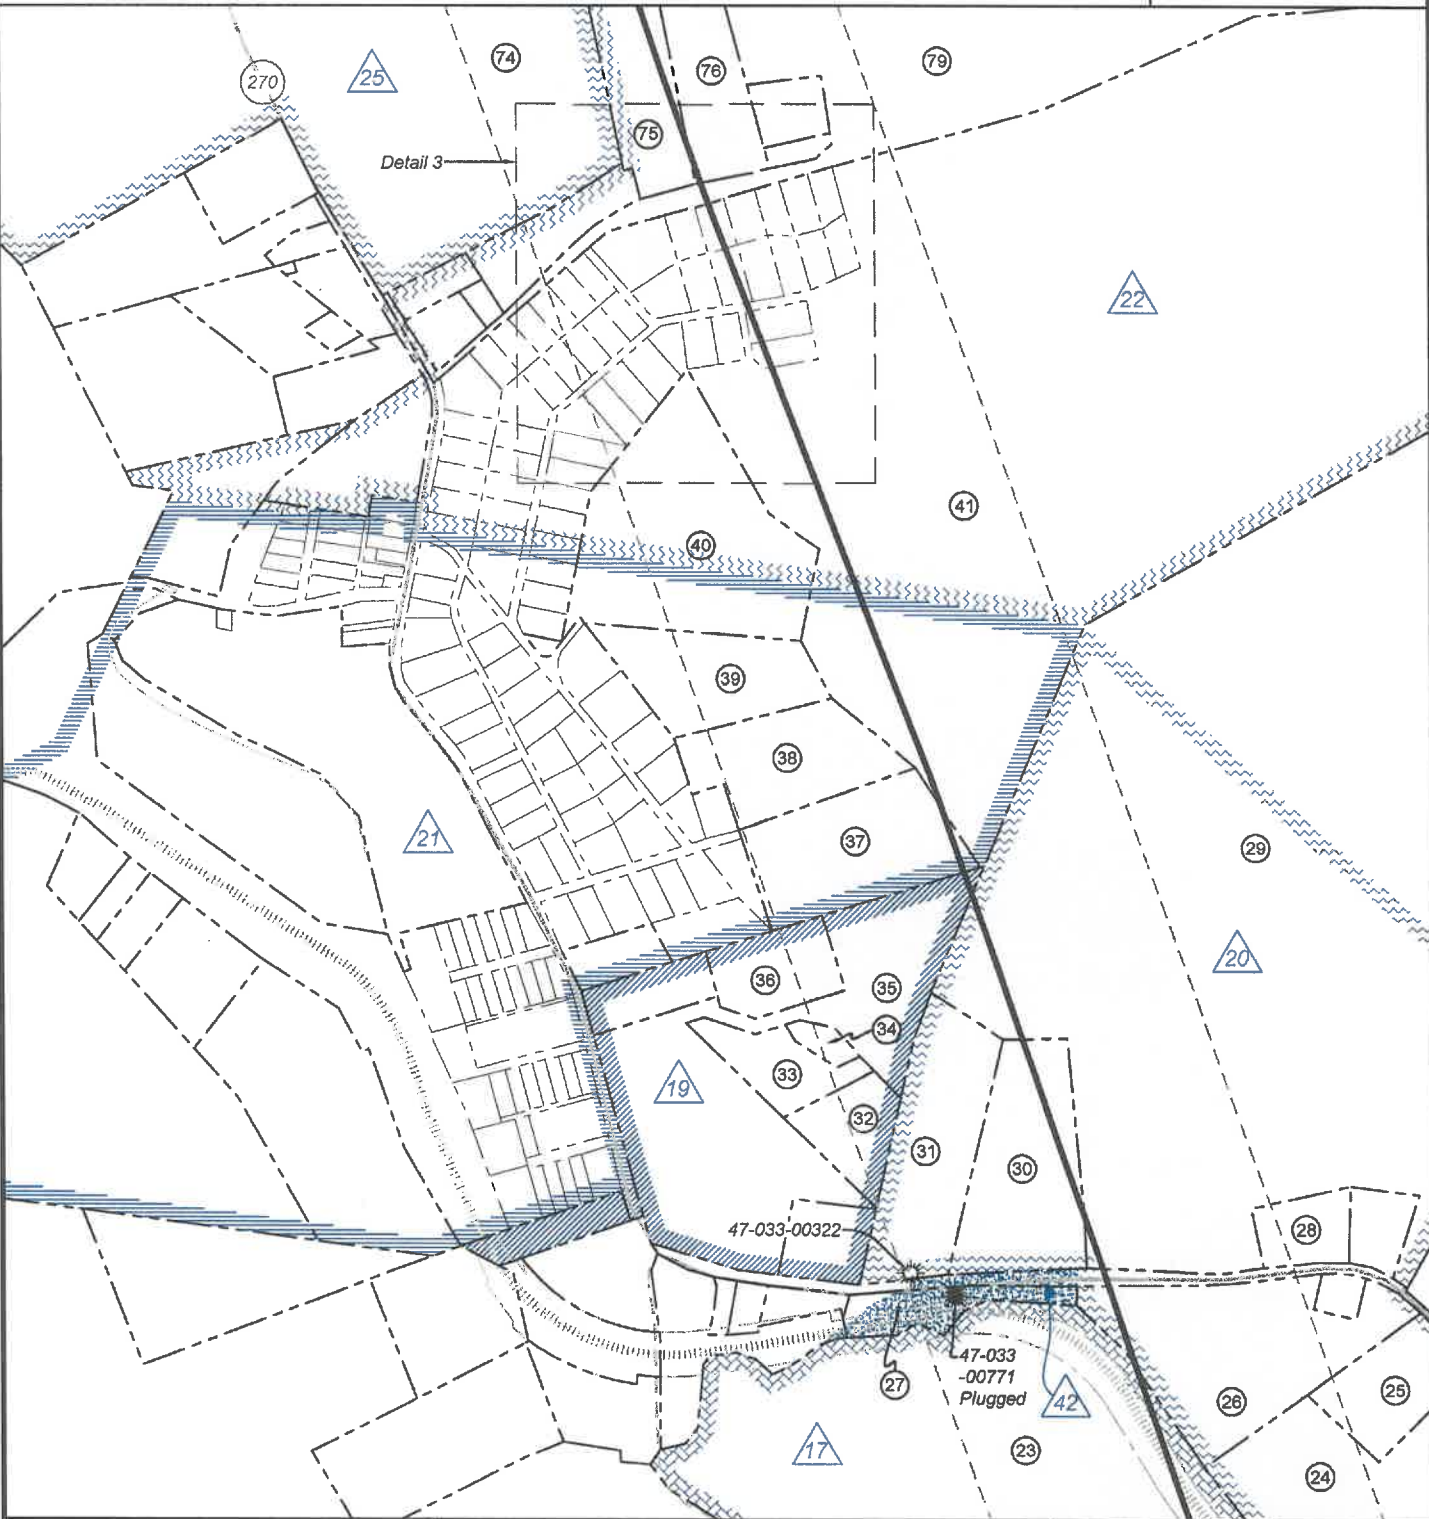

FILE NO: 32-36-G-19
 DRAWING NO: Schoen 1205 N-2H Well Plat
 SCALE: 1" = 2000'
 MINIMUM DEGREE OF ACCURACY:
 Submeter
 PROVEN SOURCE OF ELEVATION:
 CORS, Bridgeport, WV

STATE OF WEST VIRGINIA
 DEPARTMENT OF ENVIRONMENTAL PROTECTION
 OIL AND GAS DIVISION
 OF WEST VIRGINIA
 MARIAN SEMPER LIBER

DATE: May 14 20 25
 OPERATOR'S WELL NO. Schoen 1205 N-2H
 API WELL NO
 47 — 033 — 06000
 STATE COUNTY PERMIT

WELL TYPE: ☐ OIL ☒ GAS ☐ LIQUID INJECTION ☐ WASTE DISPOSAL
 (IF GAS) PRODUCTION: ☐ STORAGE ☐ DEEP ☒ SHALLOW

LOCATION: ELEVATION: 1,407.3' WATERSHED: Middle West Fork Creek
 DISTRICT: Grant / Union

QUADRANGLE: Top: Mount Clare
 Btm: West Milford
 COUNTY: Harrison

SURFACE OWNER: George & Rosanne Schoen
 ROYALTY OWNER: Willa Post Robey, et al

ACREAGE: 65.00
 ACREAGE: 78.20

PROPOSED WORK: ☒ DRILL ☐ CONVERT ☐ DRILL DEEPER ☐ FRACTURE OR STIMULATE ☐ PLUG OFF OLD FORMATION
☐ PERFORATE NEW FORMATION ☒ OTHER PHYSICAL CHANGE IN WELL (SPECIFY) As-Drilled
☐ PLUG AND ABANDON ☐ CLEAN OUT AND REPLUG TARGET FORMATION: Marcellus Shale ESTIMATED DEPTH: 7,468' TVD 25,009' MD

WELL OPERATOR: HG Energy II Appalachia, LLC
 ADDRESS: 5260 Dupont Road
 Parkersburg, WV 26101

DESIGNATED AGENT: Diane C. White
 ADDRESS: 5260 Dupont Road
 Parkersburg, WV 26101

HG Energy II
Appalachia, LLC
Well No. Schoen
1205 N-2H As-Drilled

Page 4 of 5



Detail 3 - Scale: NTS



FILE NO: 32-36-G-19

DRAWING NO: Schoen 1205 N-2H Well Plat

SCALE: 1" = 2000'

MINIMUM DEGREE OF ACCURACY:
Submeter

PROVEN SOURCE OF ELEVATION:
CORS, Bridgeport, WV

STATE OF WEST VIRGINIA
DEPARTMENT OF ENVIRONMENTAL PROTECTION
OIL AND GAS DIVISION



DATE: May 14 20 25

OPERATOR'S WELL NO. Schoen 1205 N-2H

API WELL NO

47 — 033 — 06000
STATE COUNTY PERMIT

WELL TYPE: ☐ OIL ☒ GAS ☐ LIQUID INJECTION ☐ WASTE DISPOSAL
(IF GAS) PRODUCTION: ☐ STORAGE ☐ DEEP ☒ SHALLOW

LOCATION: ELEVATION: 1,407.3' WATERSHED: Middle West Fork Creek

DISTRICT: Grant / Union

SURFACE OWNER: George & Rosanne Schoen

ROYALTY OWNER: Willa Post Robey, et al

LEASE NO: ACREAGE: 78.20

PROPOSED WORK: ☒ DRILL ☐ CONVERT ☐ DRILL DEEPER ☐ FRACTURE OR STIMULATE ☐ PLUG OFF OLD FORMATION
☐ PERFORATE NEW FORMATION ☒ OTHER PHYSICAL CHANGE IN WELL (SPECIFY) As-Drilled

☐ PLUG AND ABANDON ☐ CLEAN OUT AND REPLUG TARGET FORMATION: Marcellus Shale ESTIMATED DEPTH: 7,468' TVD 25,009' MD

WELL OPERATOR: HG Energy II Appalachia, LLC

DESIGNATED AGENT: Diane C. White

ADDRESS: 5260 Dupont Road

ADDRESS: 5260 Dupont Road

Parkersburg, WV 26101

Parkersburg, WV 26101

Top: Mount Clare
QUADRANGLE: Btm: West Milford

COUNTY: Harrison

ACREAGE: 78.20

09/19/2025



No.	TM / Par	Owner	Bk / Pg	Ac.
1	447 / 2	George & Roseanne Schoen	1148 / 1059	65.00
2	447 / 3	George & Roseanne Schoen	1253 / 302	10.06
3	446 / 29	John F. McCuskey II, et al	1121 / 25	75.00
4	446 / 15	Vera E. & Oral K. Haught	1582 / 896	14.40
5	446 / 28.2	David D. Vanhorn (LE), et al	W177 / 92	42.66
6	446 / 28.5	Robert L. Vanhorn	1352 / 91	1.52
7	446 / 12	Marilyn Gaines	1192 / 300	2.93
8	446 / 8	Ruth Ann & Ralph Bradbury	1403 / 610	22.10
9	446 / 15.2	Mildred R. Dean	1060 / 270	0.72
10	446 / 15.1	David & Grace Hughes	1257 / 694	0.31
11	446 / 14	Lisa D. Grogg	1583 / 301	0.14
12	446 / 13	Kimberly Vanscoy	1306 / 5	0.27
13	446 / 13.1	Mack & Thelma Samples	1578 / 761	0.21
14	446 / 11	Mildred Dean	1080 / 270	0.41
15	446 / 10	Karen A. Hayes	1397 / 1135	0.25
16	446 / 7.1	Karen A. Hayes	1397 / 1135	0.03
17	446 / 9	Karen A. Hayes	1397 / 1135	0.36
18	446 / 7	James R. & Sharon L. Allman	1437 / 165	91.79
19	426 / 79	William Lynn Snyder	1022 / 1098	22.00
20	426 / 66	Michael W. & Robert D. Rector	1621 / 719	41.75
21	426 / 65	G. Thomas Smith	1277 / 1174	29.79
22	426 / 51	MBW LLC	1539 / 573	3.60
23	426 / 50	G. Thomas Smith	1277 / 1174	66.80
24	426 / 35.9	MBW LLC	1539 / 573	12.77
25	426 / 35.8	CARCAR LLC	1555 / 1001	2.00
26	426 / 35	Bernard D. Bennett II	1423 / 586	5.66
27	426 / 35.11	Brian M. Koontz	1495 / 551	1.05
28	426 / 35.2	George & Amy Dawson	1380 / 505	1.08
29	426 / 35.8	Lost Creek Salvage LLC	1539 / 1088	85.23
30	426 / 35.4	Christopher M. Fogg, et al	1332 / 822	3.93
31	426 / 35.3	Michael A. Ramsey	1645 / 1003	3.92
32	426 / 31.4	Mark E. Gray & Roberta J. Reed	1301 / 788	1.32
33	426 / 31.5	Timothy V. Gray	1257 / 1211	1.33
34	426 / 31.6	Timothy V. Gray	1265 / 785	0.30
35	426 / 31	Mark A. & Janet H. Benincosa	1054 / 401	10.41
36	426 / 31.3	Steven A. McClung	1629 / 183	1.58
37	426 / 34.6	Daniel & Paul Bright	1474 / 624	3.76
38	426 / 34.5	Allen D. & Vida J. Roy	1343 / 769	2.92
39	426 / 34.7	Allen D. & Vida J. Roy	1343 / 769	2.82
40	426 / 12.1	Derek & Jennifer Cutlip	1393 / 456	7.07
41	426 / 12	Annette J. Cobun	1498 / 37	74.90
42	2015 / 49	Judith A. & Robert T. Carr, III	1229 / 992	0.31
43	2015 / 48	Nancy K. Stemple	1357 / 398	0.40

No.	TM / Par	Owner	Bk / Pg	Ac.
44	2015 / 47	Travis S. Yost	1671 / 817	0.31
45	2015 / 46	Stephanie & Garry W. Hedrick, Sr.	1376 / 126	0.28
46	2015 / 45	Brenda S. Cool	1474 / 485	0.32
47	2015 / 44	Miracle Properties, LLC	1463 / 1257	0.27
48	2015 / 43	Stephen J. Wood	1416 / 814	0.25
49	2015 / 42	Matthew M. & Lindsay D. Cather-Barnes	1527 / 1116	0.25
50	2015 / 41	Annette J. Cobun	1498 / 37	0.26
51	2015 / 40	Addie J. Gabriel	1375 / 341	0.31
52	2015 / 22	Jonathan A. & Laurel L. Hill	1621 / 874	0.22
53	2015 / 20	Sharon R. & Nicole R. Elliott	1405 / 34	0.22
54	2015 / 19	Vicki L. Stickel	1618 / 1309	0.23
55	2015 / 18	Sharon R. & Nicole R. Elliott	1319 / 652	0.22
56	2015 / 17	James M. & Crystal L. Gizzi	1419 / 1201	0.23
57	2015 / 16	Caleb & Stephanie Childers	1639 / 1310	0.22
58	2015 / 15	Richard C. Casto	1557 / 588	0.23
59	2015 / 14	Hope Haught	1578 / 472	0.26
60	2015 / 13	Rose M. Kroll	1223 / 130	0.72
61	2015 / 12	Paul J. & Lynn M. Dempsey	1245 / 403	0.28
62	2015 / 11	Laura E. Clark	1434 / 234	0.27
63	2015 / 10	James T. & Atha V. Matheny	1306 / 155	0.30
64	2015 / 9	Thomas K. Barratt, et al	1670 / 412	0.26
65	2015 / 8	Michael B. & Maria L. Ammons	1364 / 386	0.33
66	2015 / 7	Nathan & Carrie Jo Rhoades	1630 / 108	0.26
67	2015 / 6	Jennifer A. Wright & David E. Bush Jr.	1496 / 1040	0.29
68	2015 / 5	Joseph L. & Erica D. Reed	1358 / 1142	0.24
69	2015 / 4	Bryan L. & Katessa R. Ware	1496 / 500	0.28
70	2015 / 3	Robert J. Morris	1360 / 501	0.26
71	2015 / 2	Peter Mueller & Margot Eakle	1246 / 175	0.32
72	2015 / 1	Robert W. McCulley	1581 / 308	0.26
73	406 / 47.1	James & Matlisa Swenskie	1506 / 1137	1.49
74	406 / 24	Clarence H. Woodford II, et ux	W163 / 1145	160.49
75	406 / 44.1	Christine & Philip D. Wright	1301 / 588	3.01
76	406 / 44	Lawrence & Jane Hill	1301 / 586	3.11
77	406 / 46	Samuel & Mary Ann Danes	1317 / 924	0.22
78	406 / 45	Lidda Danes	767 / 472	0.73
79	406 / 47	Annette J. Cobun	1496 / 37	72.13
80	406 / 23	Roger L. & Teri A. Wilmoth	1332 / 1017	57.94
81	406 / 23.2	Trans Allegheny Interstate Line Company	1544 / 463	7.50
82	406 / 21	Robert K. Lowther	1427 / 565	17.44
83	406 / 21.2	Robert K. & Linda K. Lowther	1025 / 1071	0.90
84	406 / 21.8	Brian K. & Jayme E. Lowther	1506 / 806	49.53
85	406 / 9	John L. & Mary E. Stenger	1580 / 204	309.00
86	406 / 8	Robert J. Stenger	1621 / 54	166.25

FILE NO: 32-36-G-19

DRAWING NO: Schoen 1205 N-2H Well Plat

SCALE: 1" = 2000'

MINIMUM DEGREE OF ACCURACY:
Submeter

PROVEN SOURCE OF ELEVATION:
CORS, Bridgeport, WV

STATE OF WEST VIRGINIA
DEPARTMENT OF ENVIRONMENTAL PROTECTION
OIL AND GAS DIVISION

DATE: May 14 20 25

OPERATOR'S WELL NO. Schoen 1205 N-2H

API WELL NO

47 - 033 - 06000
STATE COUNTY PERMIT

WELL TYPE: ☐ OIL ☒ GAS ☐ LIQUID INJECTION ☐ WASTE DISPOSAL
(IF GAS) PRODUCTION: ☐ STORAGE ☐ DEEP ☒ SHALLOW

LOCATION: ELEVATION: 1,407.3' WATERSHED: Middle West Fork Creek

DISTRICT: Grant / Union

SURFACE OWNER: George & Rosanne Schoen

ROYALTY OWNER: Willa Post Robey, et al

PROPOSED WORK: ☒ DRILL ☐ CONVERT ☐ DRILL DEEPER ☐ FRACTURE OR STIMULATE ☐ PLUG OFF OLD FORMATION

☐ PERFORATE NEW FORMATION ☒ OTHER PHYSICAL CHANGE IN WELL (SPECIFY) As-Drilled

☐ PLUG AND ABANDON ☐ CLEAN OUT AND REPLUG TARGET FORMATION: Marcellus Shale ESTIMATED DEPTH: 7,468' TVD 25,009' MD

WELL OPERATOR: HG Energy II Appalachia, LLC

DESIGNATED AGENT: Diane C. White

ADDRESS: 5260 Dupont Road

ADDRESS: 5260 Dupont Road

Parkersburg, WV 26101

Parkersburg, WV 26101


Top: Mount Clare
QUADRANGLE: Btm: West Milford

COUNTY: Harrison

ACREAGE: 95.00

ACREAGE: 78.20

05/19/2025

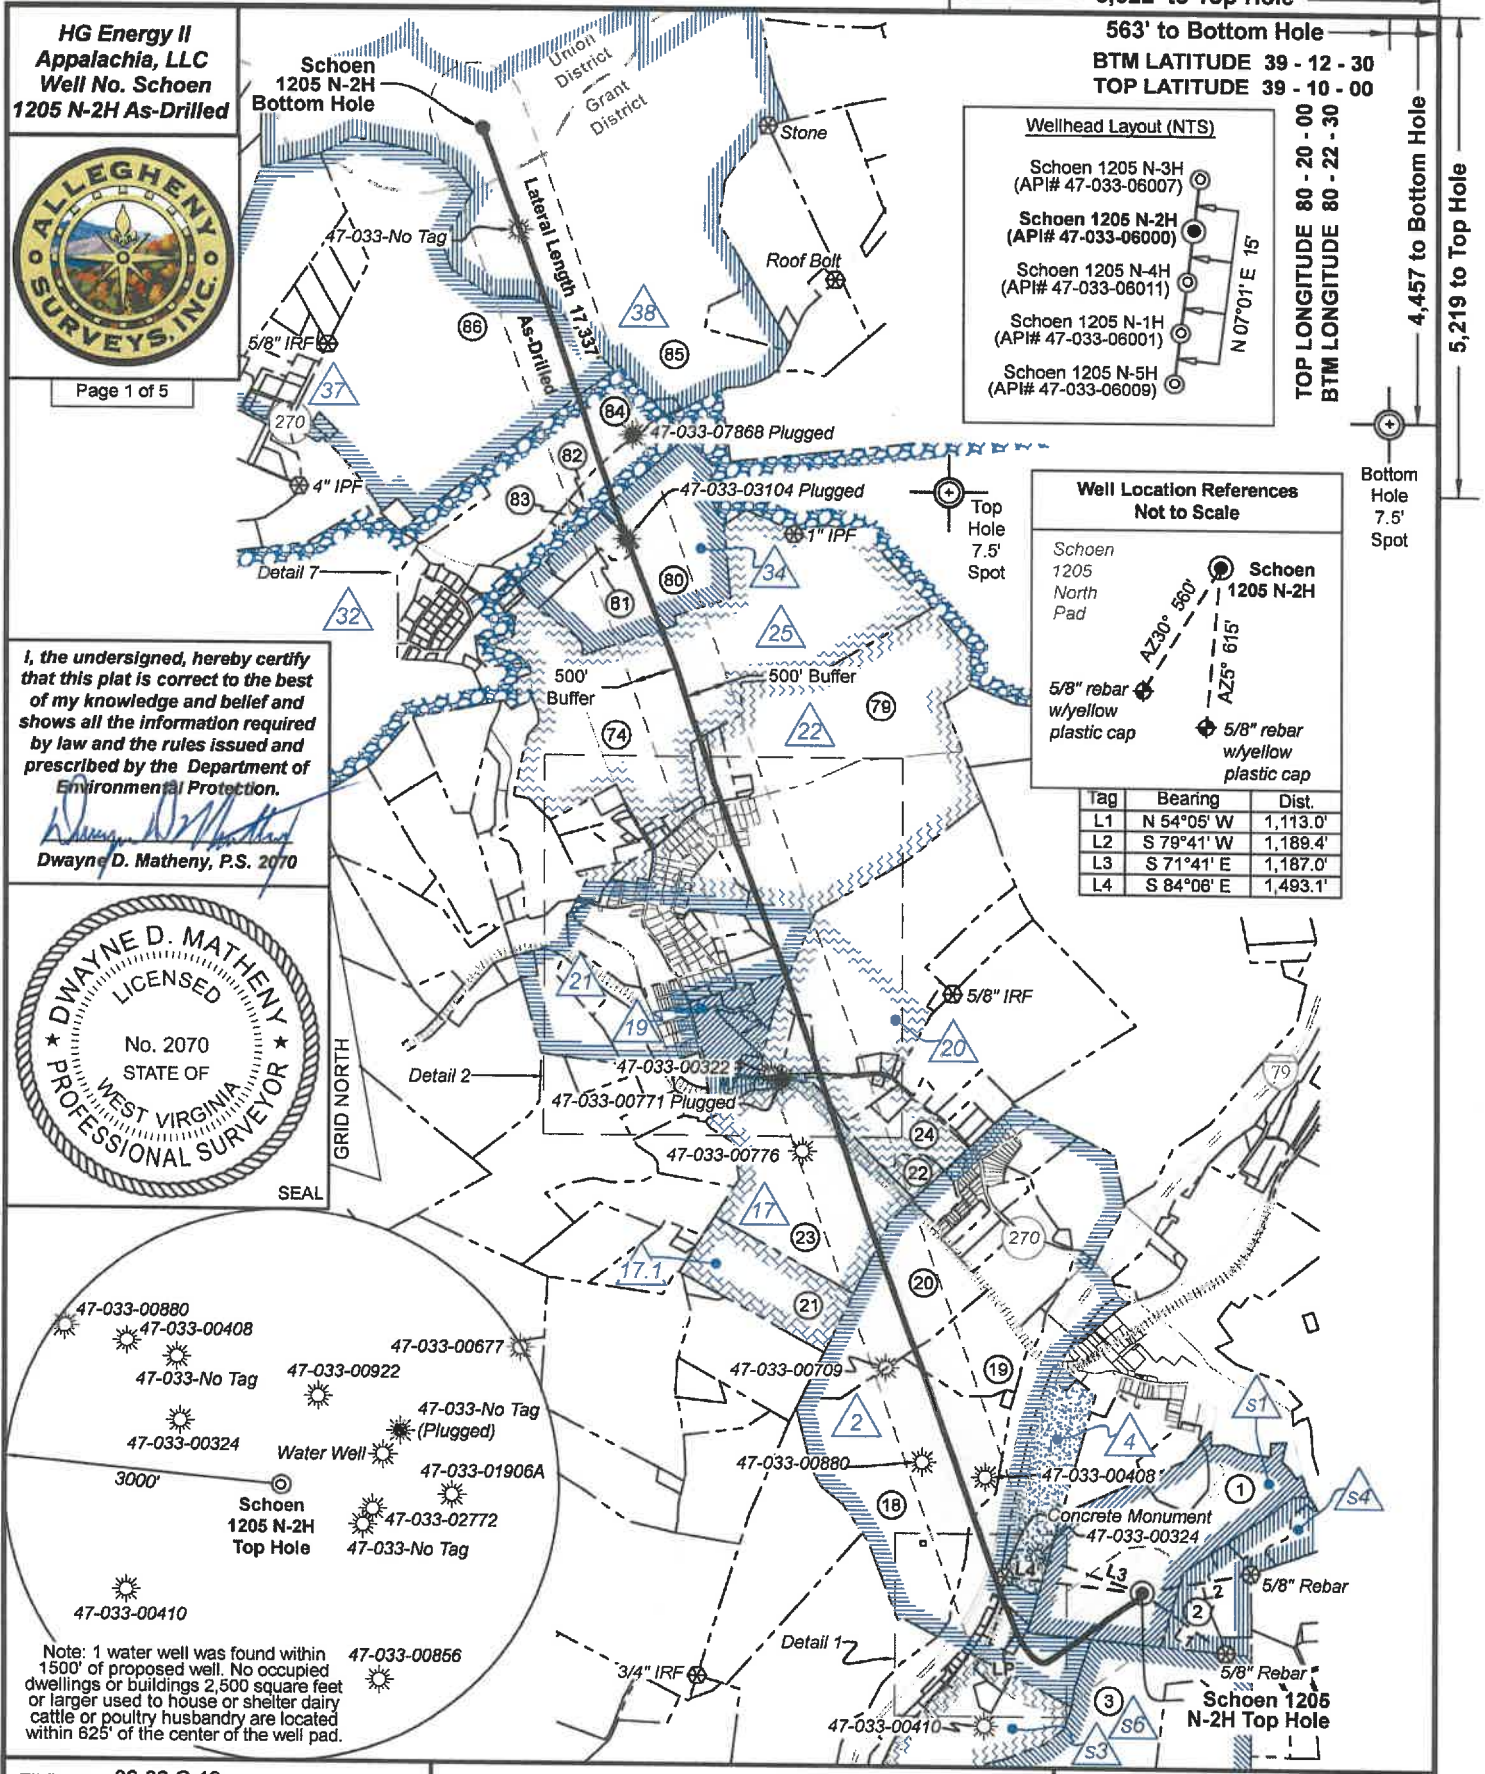




HG Energy II
Appalachia, LLC
Well No. Schoen
1205 N-2H As-Drilled



Page 1 of 5

I, the undersigned, hereby certify
that this plat is correct to the best
of my knowledge and belief and
shows all the information required
by law and the rules issued and
prescribed by the Department of
Environmental Protection.

Dwayne D. Matheny, P.S. 2070

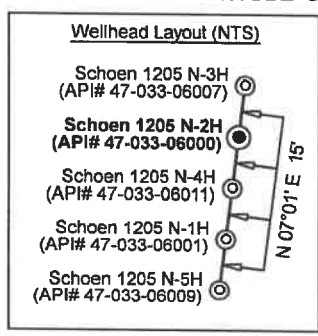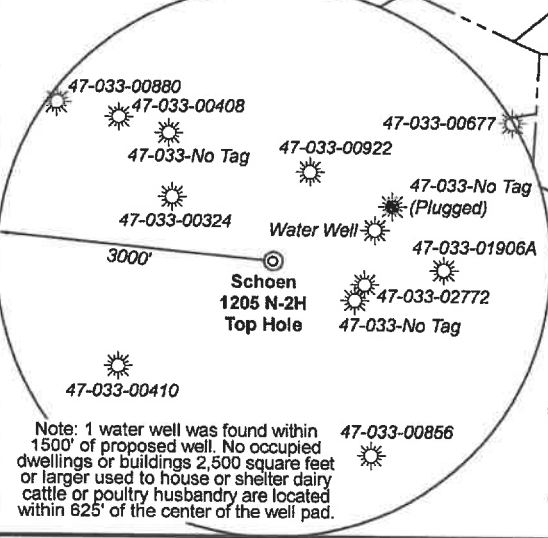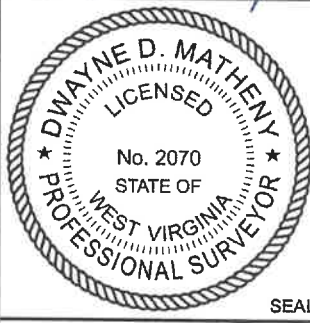

Well Location References
Not to Scale

Tag	Bearing	Dist.
L1	N 54°05' W	1,113.0'
L2	S 79°41' W	1,189.4'
L3	S 71°41' E	1,187.0'
L4	S 84°08' E	1,493.1'

FILE NO: 32-36-G-19
DRAWING NO: Schoen 1205 N-2H Well Plat
SCALE: 1" = 2000'
MINIMUM DEGREE OF ACCURACY:
Submeter
PROVEN SOURCE OF ELEVATION:
CORS, Bridgeport, WV

STATE OF WEST VIRGINIA
DEPARTMENT OF ENVIRONMENTAL PROTECTION
OIL AND GAS DIVISION

DATE: May 14 20 25
OPERATOR'S WELL NO. Schoen 1205 N-2H
API WELL NO
47 - 033 - 06000
STATE COUNTY PERMIT

WELL TYPE: ☐ OIL ☒ GAS ☐ LIQUID INJECTION ☐ WASTE DISPOSAL
(IF GAS) PRODUCTION: ☐ STORAGE ☐ DEEP ☒ SHALLOW

LOCATION: ELEVATION: 1,407.3' WATERSHED: Middle West Fork Creek
DISTRICT: Grant / Union

SURFACE OWNER: George & Rosanne Schoen
ROYALTY OWNER: Willa Post Robey, et al LEASE NO: ACREAGE: 78.20

PROPOSED WORK: ☒ DRILL ☐ CONVERT ☐ DRILL DEEPER ☐ FRACTURE OR STIMULATE ☐ PLUG OFF OLD FORMATION
☐ PERFORATE NEW FORMATION ☒ OTHER PHYSICAL CHANGE IN WELL (SPECIFY) As-Drilled

☐ PLUG AND ABANDON ☐ CLEAN OUT AND REPLUG TARGET FORMATION: Marcellus Shale ESTIMATED DEPTH: 7,488' TVD 25,009' MD

WELL OPERATOR: HG Energy II Appalachia, LLC DESIGNATED AGENT: Diane C. White
ADDRESS: 5260 Dupont Road ADDRESS: 5260 Dupont Road
Parkersburg, WV 26101 Parkersburg, WV 26101



**HG Energy II
Appalachia, LLC**
Well No. Schoen
1205 N-2H As-Drilled



Page 1 of 5

I, the undersigned, hereby certify
 that this plat is correct to the best
 of my knowledge and belief and
 shows all the information required
 by law and the rules issued and
 prescribed by the Department of
 Environmental Protection.

Dwayne D. Matheny, P.S. 2070

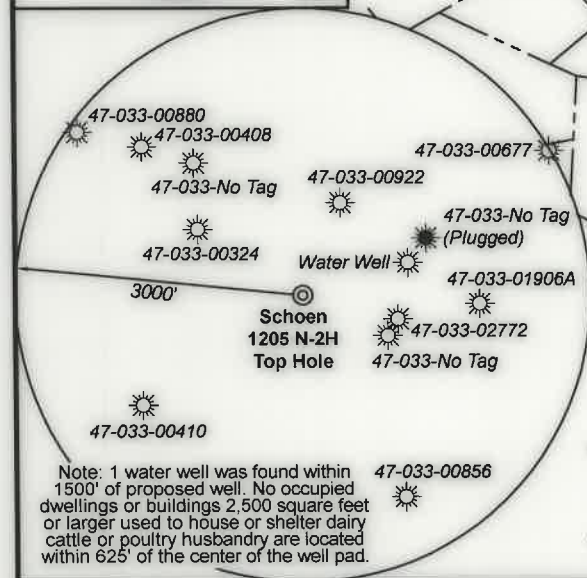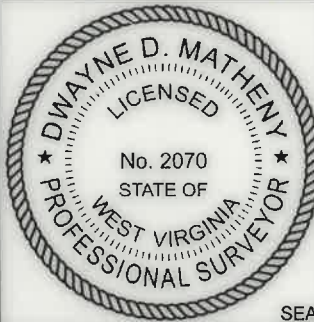

FILE NO: 32-36-G-19

DRAWING NO: Schoen 1205 N-2H Well Plat

SCALE: 1" = 2000'

MINIMUM DEGREE OF ACCURACY:
Submeter

PROVEN SOURCE OF ELEVATION:
CORS, Bridgeport, WV

STATE OF WEST VIRGINIA
 DEPARTMENT OF ENVIRONMENTAL PROTECTION
OIL AND GAS DIVISION

DATE: May 14 20 25

OPERATOR'S WELL NO: Schoen 1205 N-2H

API WELL NO

47 — 033 — 06000
 STATE COUNTY PERMIT

WELL TYPE: ☐ OIL ☒ GAS ☐ LIQUID INJECTION ☐ WASTE DISPOSAL
 (IF GAS) PRODUCTION: ☐ STORAGE ☐ DEEP ☒ SHALLOW

LOCATION: ELEVATION: 1,407.3' WATERSHED: Middle West Fork Creek

DISTRICT: Grant / Union

SURFACE OWNER: George & Rosanne Schoen

ROYALTY OWNER: Willa Post Robey, et al

LEASE NO: ACREAGE: 78.20

PROPOSED WORK: ☒ DRILL ☐ CONVERT ☐ DRILL DEEPER ☐ FRACTURE OR STIMULATE ☐ PLUG OFF OLD FORMATION
☐ PERFORATE NEW FORMATION ☒ OTHER PHYSICAL CHANGE IN WELL (SPECIFY) As-Drilled

☐ PLUG AND ABANDON ☐ CLEAN OUT AND REPLUG TARGET FORMATION: Marcellus Shale ESTIMATED DEPTH: 25,009' MD

WELL OPERATOR: HG Energy II Appalachia, LLC

DESIGNATED AGENT: Diane C. White

ADDRESS: 5260 Dupont Road
 Parkersburg, WV 26101



ADDRESS: 5260 Dupont Road
 Parkersburg, WV 26101

QUADRANGLE: Top: Mount Clare
 Btm: West Milford


ACREAGE: 65.00

DATE: 09/19/2025

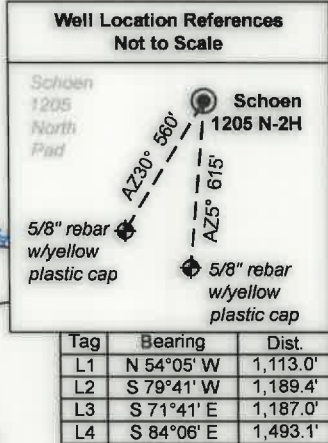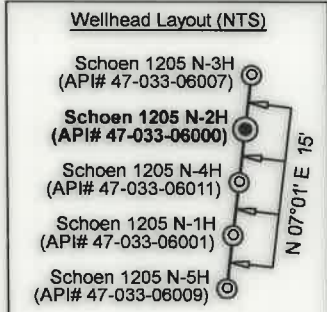



ID	Lease
s1	A.B. Post, et al
s3	Emma A. Waggoner, et al
s4	Charlotte C. Gerlach, et al
s6	Susan V. Curry, et al
2	Marcella R. Bond, et vir, et al
4	Gertude Hardaway, et al
17	Lillie Gifford, et al
17.1	Lillie Gifford, et al
19	Georgia A. Barnes
20	Ray T. Swisher, et al
21	A.W. Smith
22	Frank Swisher, et al
25	C.H. Woodford, et ux, et al
32	Porter Maxwell, et ux, et al
34	I. Wilson & Edna M. Swisher
37	W.B. Van Horn, et ux
38	Locie C. Stout, et al
42	O. Glen Kennedy, et al

Legend

- Proposed gas well
- Well Reference, as noted
- Monument, as noted
- Existing Well, as noted
- Existing Plugged Well, as noted
- Digitized Well, as noted
- Surface boundary (approx.)
- Interior surface tracts (approx.)
- Creek or Drain
- Existing Road
- Railroad Tracks

West Virginia Coordinate
 System of 1927, North Zone
 based upon Differential GPS
 Measurements.

Notes: Well No.
 Schoen 1205 N-2H
 WVCS 1927, North Zone
 Top Hole Coordinates
 Lat: 39°09'08.40"
 Lon: 80°21'07.59"
 Landing Point Coordinates
 Lat: 39°09'04.22"
 Lon: 80°21'24.90"
 Bottom Hole Coordinates
 Lat: 39°11'45.93"
 Lon: 80°22'37.16"


UTM Zone 17, NAD 1983

Plat orientation and corner and well references are based
 upon the grid north meridian. Well location references are
 based upon the magnetic meridian.

Notes: Well No.
 Schoen 1205 N-2H
 UTM NAD 1983 (USSF)
 Top Hole Coordinates
 N: 14,218,776.04'
 E: 1,824,137.36'
 Landing Point Coordinates
 N: 14,218,343.38'
 E: 1,822,776.70'
 Bottom Hole Coordinates
 N: 14,234,658.73'
 E: 1,816,974.15'

Notes: Well No.
 Schoen 1205 N-2H
 UTM NAD 1983 (Meters)
 Top Hole Coordinates
 N: 4,333,891.603m
 E: 555,998.179m
 Landing Point Coordinates
 N: 4,333,759.730m
 E: 555,583.449m
 Bottom Hole Coordinates
 N: 4,338,732.658m
 E: 553,814.829m

Detail 1 - Scale: 1" = 500'

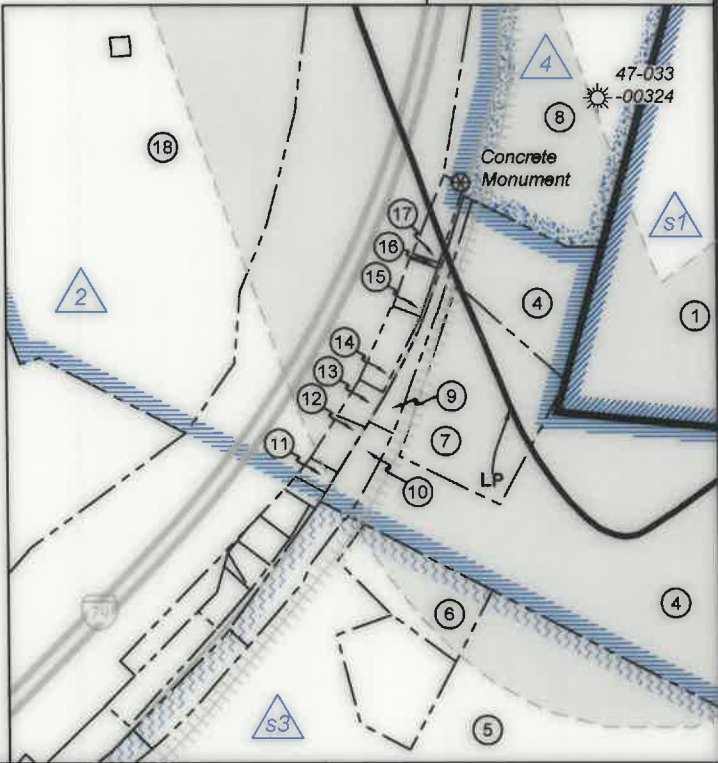

FILE NO: 32-36-G-19

DRAWING NO: Schoen 1205 N-2H Well Plat

SCALE: 1" = 2000'

MINIMUM DEGREE OF ACCURACY:
 Submeter

PROVEN SOURCE OF ELEVATION:
 CORS, Bridgeport, WV

STATE OF WEST VIRGINIA
 DEPARTMENT OF ENVIRONMENTAL PROTECTION
 OIL AND GAS DIVISION

DATE: May 14 20 25

OPERATOR'S WELL NO. Schoen 1205 N-2H

API WELL NO

47 - 033 - 06000
 STATE COUNTY PERMIT

WELL TYPE: ☐ OIL ☒ GAS ☐ LIQUID INJECTION ☐ WASTE DISPOSAL
 (IF GAS) PRODUCTION: ☐ STORAGE ☐ DEEP ☒ SHALLOW

LOCATION: ELEVATION: 1,407.3' WATERSHED: Middle West Fork Creek

DISTRICT: Grant / Union

SURFACE OWNER: George & Rosanne Schoen

ROYALTY OWNER: Willa Post Robey, et al

LEASE NO: ACREAGE: 78.20

PROPOSED WORK: ☒ DRILL ☐ CONVERT ☐ DRILL DEEPER ☐ FRACTURE OR STIMULATE ☐ PLUG OFF OLD FORMATION
☐ PERFORATE NEW FORMATION ☒ OTHER PHYSICAL CHANGE IN WELL (SPECIFY) As-Drilled

☐ PLUG AND ABANDON ☐ CLEAN OUT AND REPLUG TARGET FORMATION: Marcellus Shale ESTIMATED DEPTH: 25,009' MD

WELL OPERATOR: HG Energy II Appalachia, LLC

DESIGNATED AGENT: Diane C. White

ADDRESS: 5260 Dupont Road
 Parkersburg, WV 26101

ADDRESS: 5260 Dupont Road
 Parkersburg, WV 26101


Top: Mount Clare
 Btm: West Milford
 COUNTY: Harrison
 ACREAGE: 65.00

09/19/2025

7,468' TVD



Detail 2 - Scale: 1" = 500'

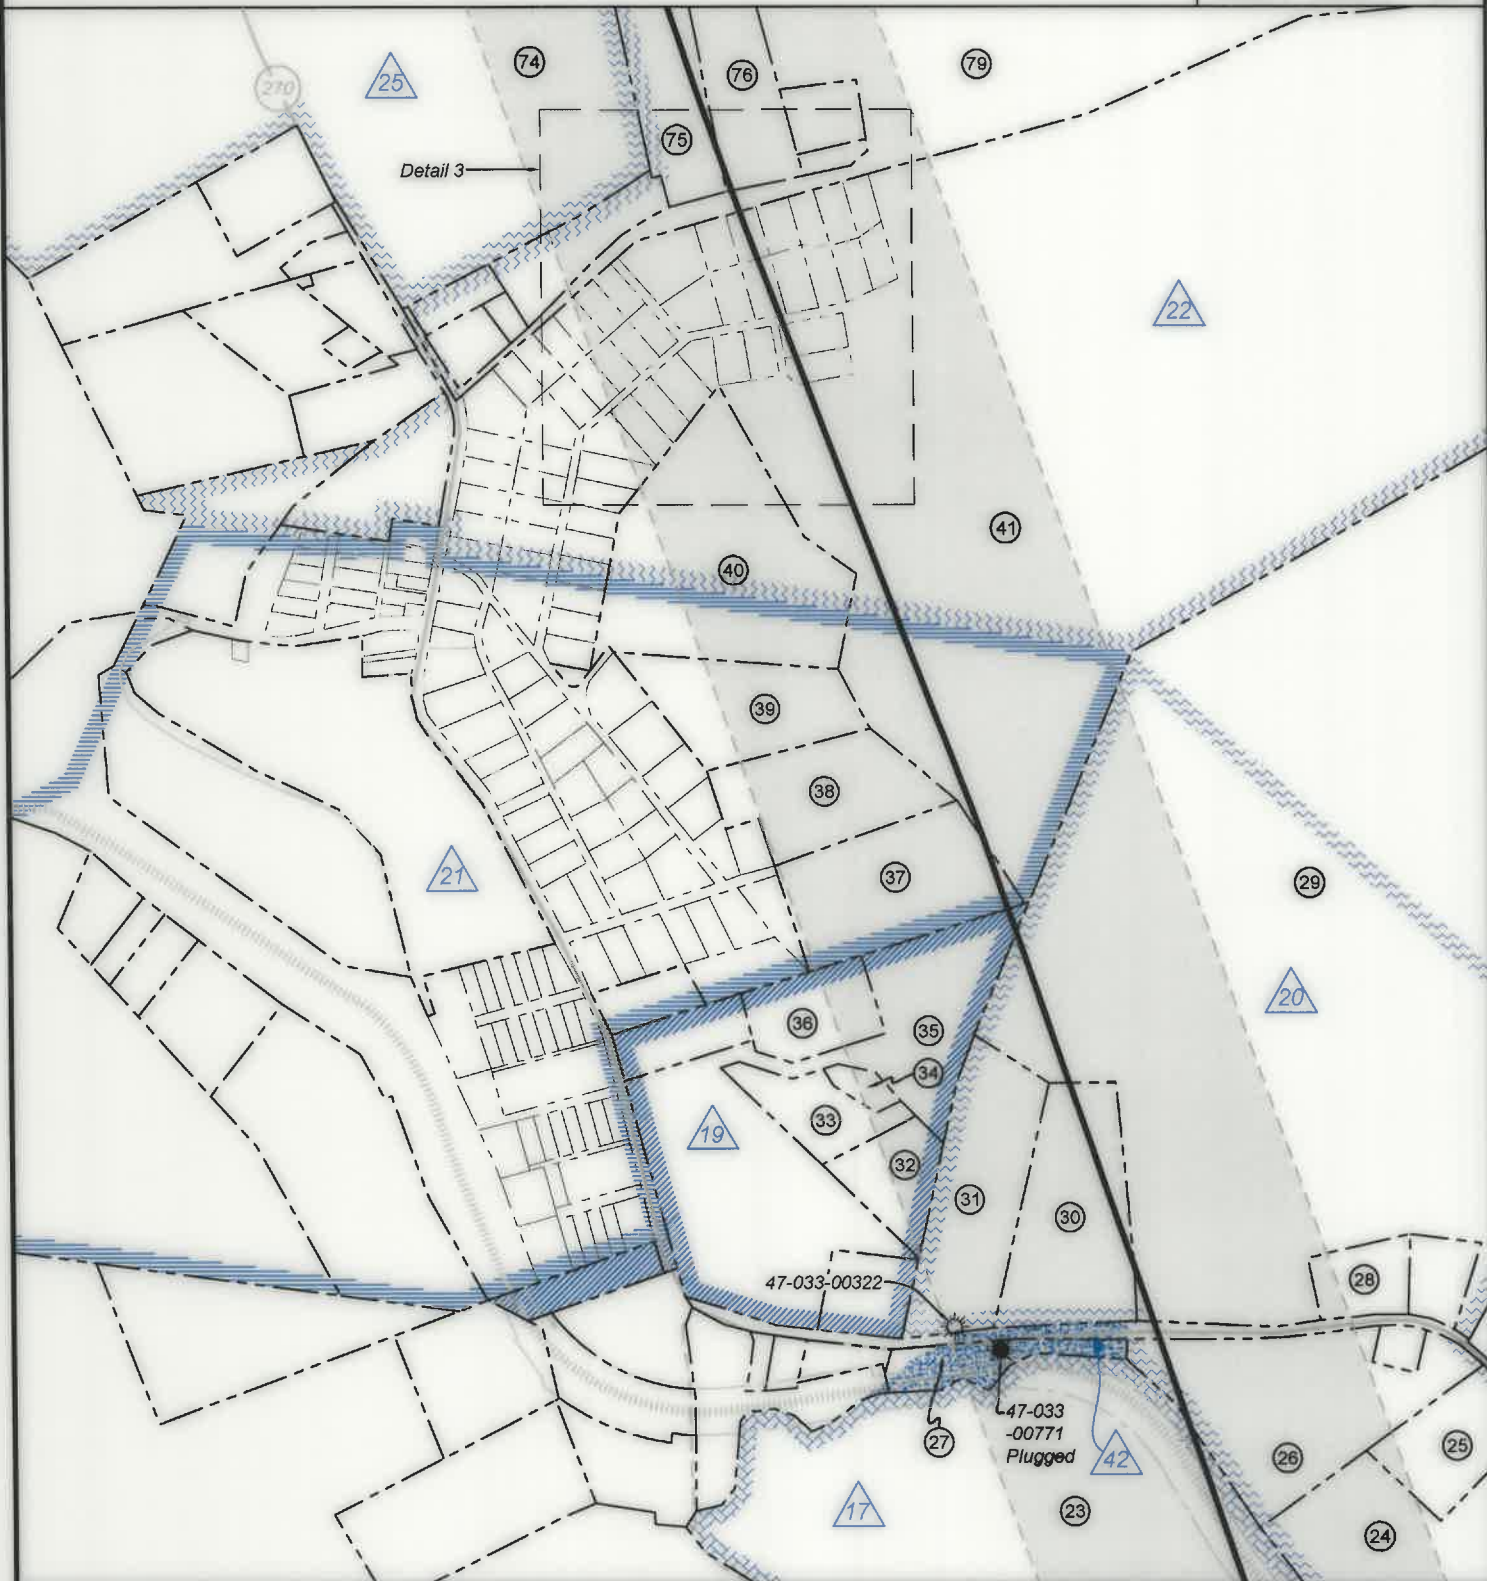

FILE NO: 32-36-G-19
DRAWING NO: Schoen 1205 N-2H Well Plat
SCALE: 1" = 2000'
MINIMUM DEGREE OF ACCURACY:
Submeter
PROVEN SOURCE OF ELEVATION:
CORS, Bridgeport, WV

STATE OF WEST VIRGINIA
DEPARTMENT OF ENVIRONMENTAL PROTECTION
OIL AND GAS DIVISION

DATE: May 14 20 25
OPERATOR'S WELL NO. Schoen 1205 N-2H
API WELL NO
47 - 033 - 06000
STATE COUNTY PERMIT

WELL TYPE: ☐ OIL ☒ GAS ☐ LIQUID INJECTION ☐ WASTE DISPOSAL
(IF GAS) PRODUCTION: ☐ STORAGE ☐ DEEP ☒ SHALLOW

LOCATION: ELEVATION: 1,407.3' WATERSHED: Middle West Fork Creek

DISTRICT: Grant / Union

SURFACE OWNER: George & Rosanne Schoen

ROYALTY OWNER: Willa Post Robey, et al

LEASE NO: ACREAGE: 78.20

PROPOSED WORK: ☒ DRILL ☐ CONVERT ☐ DRILL DEEPER ☐ FRACTURE OR STIMULATE ☐ PLUG OFF OLD FORMATION
☐ PERFORATE NEW FORMATION ☒ OTHER PHYSICAL CHANGE IN WELL (SPECIFY) As-Drilled

☐ PLUG AND ABANDON ☐ CLEAN OUT AND REPLUG TARGET FORMATION: Marcellus Shale ESTIMATED DEPTH: 7,488' TVD 25,009' MD

WELL OPERATOR: HG Energy II Appalachia, LLC

DESIGNATED AGENT: Diane C. White

ADDRESS: 5260 Dupont Road

ADDRESS: 5260 Dupont Road

Parkersburg, WV 26101

Parkersburg, WV 26101

Top: Mount Clare
QUADRANGLE: Btm: West Milford

COUNTY: Harrison

ACREAGE: 65.00

09/19/2025



Detail 3 - Scale: NTS



FILE NO: 32-36-G-19
DRAWING NO: Schoen 1205 N-2H Well Plat
SCALE: 1" = 2000'
MINIMUM DEGREE OF ACCURACY:
Submeter
PROVEN SOURCE OF ELEVATION:
CORS, Bridgeport, WV

STATE OF WEST VIRGINIA
DEPARTMENT OF ENVIRONMENTAL PROTECTION
OIL AND GAS DIVISION

DATE: May 14 20 25
OPERATOR'S WELL NO. Schoen 1205 N-2H
API WELL NO
47 - 033 - 06000
STATE COUNTY PERMIT

WELL TYPE: ☐ OIL ☒ GAS ☐ LIQUID INJECTION ☐ WASTE DISPOSAL
(IF GAS) PRODUCTION: ☐ STORAGE ☐ DEEP ☒ SHALLOW

LOCATION: ELEVATION: 1,407.3' WATERSHED: Middle West Fork Creek

DISTRICT: Grant / Union

SURFACE OWNER: George & Rosanne Schoen

ROYALTY OWNER: Willa Post Robey, et al

LEASE NO: ACREAGE: 78.20

PROPOSED WORK: ☒ DRILL ☐ CONVERT ☐ DRILL DEEPER ☐ FRACTURE OR STIMULATE ☐ PLUG OFF OLD FORMATION
☐ PERFORATE NEW FORMATION ☒ OTHER PHYSICAL CHANGE IN WELL (SPECIFY) As-Drilled

☐ PLUG AND ABANDON ☐ CLEAN OUT AND REPLUG TARGET FORMATION: Marcellus Shale ESTIMATED DEPTH: 25,009' MD

WELL OPERATOR: HG Energy II Appalachia, LLC

DESIGNATED AGENT: Diane C. White

ADDRESS: 5260 Dupont Road

ADDRESS: 5260 Dupont Road

Parkersburg, WV 26101

Parkersburg, WV 26101

Top: Mount Clare
QUADRANGLE: Btm: West Milford

COUNTY: Harrison
ACREAGE: 65.00

09/19/2025

7,468' TVD



No.	TM / Par	Owner	Bk / Pg	Ac.
1	447 / 2	George & Roseanne Schoen	1148 / 1059	65.00
2	447 / 3	George & Roseanne Schoen	1253 / 302	10.06
3	446 / 29	John F. McCuskey II, et al	1121 / 25	75.00
4	446 / 15	Vera E. & Oral K. Haught	1582 / 896	14.40
5	446 / 28.2	David D. Vanhorn (LE), et al	W177 / 92	42.66
6	446 / 28.5	Robert L. Vanhorn	1352 / 91	1.52
7	446 / 12	Marilyn Gaines	1192 / 300	2.93
8	446 / 8	Ruth Ann & Ralph Bradbury	1403 / 610	22.10
9	446 / 15.2	Mildred R. Dean	1060 / 270	0.72
10	446 / 15.1	David & Grace Hughes	1257 / 694	0.31
11	446 / 14	Lisa D. Grogg	1583 / 301	0.14
12	446 / 13	Kimberly Vanscoy	1306 / 5	0.27
13	446 / 13.1	Mack & Thelma Samples	1578 / 761	0.21
14	446 / 11	Mildred Dean	1060 / 270	0.41
15	446 / 10	Karen A. Hayes	1397 / 1135	0.25
16	446 / 7.1	Karen A. Hayes	1397 / 1135	0.03
17	446 / 9	Karen A. Hayes	1397 / 1135	0.36
18	446 / 7	James R. & Sharon L. Allman	1437 / 165	91.79
19	426 / 79	William Lynn Snyder	1022 / 1098	22.00
20	426 / 66	Michael W. & Robert D. Rector	1621 / 719	41.75
21	426 / 65	G. Thomas Smith	1277 / 1174	29.79
22	426 / 51	MBW LLC	1539 / 573	3.60
23	426 / 50	G. Thomas Smith	1277 / 1174	66.80
24	426 / 35.9	MBW LLC	1539 / 573	12.77
25	426 / 35.6	CARCAR LLC	1555 / 1001	2.00
26	426 / 35	Bernard D. Bennett II	1423 / 586	5.66
27	426 / 35.11	Brian M. Koontz	1495 / 551	1.05
28	426 / 35.2	George & Amy Dawson	1380 / 505	1.08
29	426 / 35.8	Lost Creek Salvage LLC	1539 / 1088	85.23
30	426 / 35.4	Christopher M. Fogg, et al	1332 / 822	3.93
31	426 / 35.3	Michael A. Ramsey	1645 / 1003	3.92
32	426 / 31.4	Mark E. Gray & Roberta J. Reed	1301 / 788	1.32
33	426 / 31.5	Timothy V. Gray	1257 / 1211	1.33
34	426 / 31.6	Timothy V. Gray	1265 / 785	0.30
35	426 / 31	Mark A. & Janet H. Benincosa	1054 / 401	10.41
36	426 / 31.3	Steven A. McClung	1629 / 183	1.58
37	426 / 34.6	Daniel & Paul Bright	1474 / 624	3.76
38	426 / 34.5	Allen D. & Vida J. Roy	1343 / 769	2.92
39	426 / 34.7	Allen D. & Vida J. Roy	1343 / 769	2.82
40	426 / 12.1	Derek & Jennifer Cutlip	1393 / 456	7.07
41	426 / 12	Annette J. Cobun	1496 / 37	74.90
42	2015 / 49	Judith A. & Robert T. Carr, III	1229 / 992	0.31
43	2015 / 48	Nancy K. Stemple	1357 / 398	0.40

No.	TM / Par	Owner	Bk / Pg	Ac.
44	2015 / 47	Travis S. Yost	1671 / 817	0.31
45	2015 / 46	Stephanie & Garry W. Hedrick, Sr.	1376 / 126	0.28
46	2015 / 45	Brenda S. Cool	1474 / 485	0.32
47	2015 / 44	Miracle Properties, LLC	1463 / 1257	0.27
48	2015 / 43	Stephen J. Wood	1416 / 814	0.25
49	2015 / 42	Matthew M. & Lindsay D. Cather-Barnes	1527 / 1116	0.25
50	2015 / 41	Annette J. Cobun	1496 / 37	0.26
51	2015 / 40	Addie J. Gabriel	1375 / 341	0.31
52	2015 / 22	Jonathan A. & Laurel L. Hill	1621 / 874	0.22
53	2015 / 20	Sharron R. & Nicole R. Elliott	1405 / 34	0.22
54	2015 / 19	Vicki L. Stickel	1618 / 1309	0.23
55	2015 / 18	Sharron R. & Nicole R. Elliott	1319 / 652	0.22
56	2015 / 17	James M. & Crystal L. Gizzi	1419 / 1201	0.23
57	2015 / 16	Caleb & Stephanie Childers	1639 / 1310	0.22
58	2015 / 15	Richard C. Casto	1557 / 588	0.23
59	2015 / 14	Hope Haught	1578 / 472	0.26
60	2015 / 13	Rose M. Kroll	1223 / 130	0.72
61	2015 / 12	Paul J. & Lynn M. Dempsey	1245 / 403	0.28
62	2015 / 11	Laura E. Clark	1434 / 234	0.27
63	2015 / 10	James T. & Atha V. Matheny	1306 / 155	0.30
64	2015 / 9	Thomas K. Barratt, et al	1670 / 412	0.26
65	2015 / 8	Michael B. & Maria L. Ammons	1364 / 386	0.33
66	2015 / 7	Nathan & Carrie Jo Rhoades	1630 / 108	0.26
67	2015 / 6	Jennifer A. Wright & David E. Bush Jr.	1496 / 1040	0.29
68	2015 / 5	Joseph L. & Erica D. Reed	1358 / 1142	0.24
69	2015 / 4	Bryan L. & Katesa R. Ware	1496 / 500	0.28
70	2015 / 3	Robert J. Morris	1360 / 501	0.26
71	2015 / 2	Peter Mueller & Margot Eakle	1246 / 175	0.32
72	2015 / 1	Robert W. McCulley	1581 / 308	0.26
73	406 / 47.1	James & Matilsa Swenskie	1506 / 1137	1.49
74	406 / 24	Clarence H. Woodford II, et ux	W163 / 1145	160.49
75	406 / 44.1	Christine & Philip D. Wright	1301 / 588	3.01
76	406 / 44	Lawrence & Jane Hill	1301 / 586	3.11
77	406 / 46	Samuel & Mary Ann Danes	1317 / 924	0.22
78	406 / 45	Lidda Danes	767 / 472	0.73
79	406 / 47	Annette J. Cobun	1496 / 37	72.13
80	406 / 23	Roger L. & Teri A. Wilmoth	1332 / 1017	57.94
81	406 / 23.2	Trans Allegheny Interstate Line Company	1544 / 463	7.50
82	406 / 21	Robert K. Lowther	1427 / 565	17.44
83	406 / 21.2	Robert K. & Linda K. Lowther	1025 / 1071	0.90
84	406 / 21.8	Brian K. & Jayme E. Lowther	1506 / 806	49.53
85	406 / 9	John L. & Mary E. Stenger	1580 / 204	309.00
86	406 / 8	Robert J. Stenger	1621 / 54	166.25

FILE NO: 32-36-G-19
DRAWING NO: Schoen 1205 N-2H Well Plat
SCALE: 1" = 2000'
MINIMUM DEGREE OF ACCURACY:
Submeter
PROVEN SOURCE OF ELEVATION:
CORS, Bridgeport, WV

STATE OF WEST VIRGINIA
DEPARTMENT OF ENVIRONMENTAL PROTECTION
OIL AND GAS DIVISION

DATE: May 14 20 25
OPERATOR'S WELL NO. Schoen 1205 N-2H
API WELL NO
47 — 033 — 06000
STATE COUNTY PERMIT

WELL TYPE: ☐ OIL ☒ GAS ☐ LIQUID INJECTION ☐ WASTE DISPOSAL
(IF GAS) PRODUCTION: ☐ STORAGE ☐ DEEP ☒ SHALLOW

LOCATION: ELEVATION: 1,407.3' WATERSHED: Middle West Fork Creek
DISTRICT: Grant / Union

Top: Mount Clare
Btm: West Milford
QUADRANGLE: 09/19/2025
ACREAGE: 65.00

SURFACE OWNER: George & Rosanne Schoen

ROYALTY OWNER: Willa Post Robey, et al

LEASE NO: ACREAGE: 78.20

PROPOSED WORK: ☒ DRILL ☐ CONVERT ☐ DRILL DEEPER ☐ FRACTURE OR STIMULATE ☐ PLUG OFF OLD FORMATION
☐ PERFORATE NEW FORMATION ☒ OTHER PHYSICAL CHANGE IN WELL (SPECIFY) As-Drilled

☐ PLUG AND ABANDON ☐ CLEAN OUT AND REPLUG TARGET FORMATION: Marcellus Shale ESTIMATED DEPTH: 7,468' TVD 25,009' MD

WELL OPERATOR: HG Energy II Appalachia, LLC

DESIGNATED AGENT: Diane C. White

ADDRESS: 5260 Dupont Road

ADDRESS: 5260 Dupont Road

Parkersburg, WV 26101

Parkersburg, WV 26101