



ID	Lease
1	Morris Mountaineer Oil & Gas, LLC
2	Locie C. Stout, et al
8	Porter & Bertha B. Maxwell, et al
11	C.H. & Constance Woodford, et al
12	E.S. & Nettie M. Swisher, et al
22	A.W. Smith
24	Hugh C. & Martha L. Davis, et al
28	Lillie Gifford, et al
30	Mary E. Kennedy, et al
31	S.J. Davisson
32	Marcella R. & H.D. Bond, et al
39	Willa Post Robey, et al
45	J.N. Rector, et al
46	Emma A. Waggoner, et al
47	Gregory A. & Jacqueline D. Abraham
48	J.O. & Dorothy H. Butcher
54	H.D. & Emma J. Smith, et al
66	Hattie B. Cummins, et al

Legend	
	Proposed gas well
	Well Reference, as noted
	Monument, as noted
	Existing Well, as noted
	Existing Plugged Well, as noted
	Digitized Well, as noted
	Surface boundary (approx.)
	Interior surface tracts (approx.)
	Creek or Drain
	Existing Road
	Railroad Tracks


West Virginia Coordinate
 System of 1927, North Zone
 based upon Differential GPS
 Measurements.

Notes: Well No.
 Schoen 1205 N-1H
 WVCS 1927, North Zone
 Top Hole Coordinates
 Lat: 39°09'08.10"
 Lon: 80°21'07.63"
 Landing Point Coordinates
 Lat: 39°09'00.02"
 Lon: 80°21'39.17"
 Bottom Hole Coordinates
 Lat: 39°11'52.39"
 Lon: 80°23'01.39"

UTM Zone 17, NAD 1983
 Plat orientation and corner and well references are based
 upon the grid north meridian. Well location references are
 based upon the magnetic meridian.

Notes: Well No.
 Schoen 1205 N-1H
 UTM NAD 1983 (USSF)
 Top Hole Coordinates
 N: 14,218,746.26'
 E: 1,824,133.72'
 Landing Point Coordinates
 N: 14,217,910.97'
 E: 1,821,656.41'
 Bottom Hole Coordinates
 N: 14,235,298.81'
 E: 1,815,062.60'

Notes: Well No.
 Schoen 1205 N-1H
 UTM NAD 1983 (Meters)
 Top Hole Coordinates
 N: 4,333,882.528m
 E: 555,997.070m
 Landing Point Coordinates
 N: 4,333,627.931m
 E: 555,241.984m
 Bottom Hole Coordinates
 N: 4,338,927.755m
 E: 553,232.187m

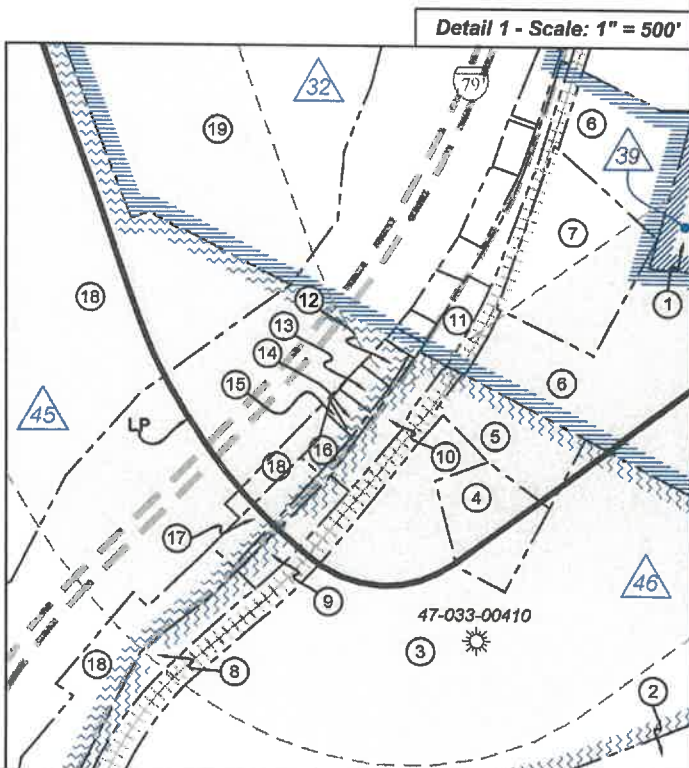

FILE NO: 32-36-G-19
 DRAWING NO: Schoen 1205 N-1H Well Plat
 SCALE: 1" = 2000'
 MINIMUM DEGREE OF ACCURACY:
 Submeter
 PROVEN SOURCE OF ELEVATION:
 CORS, Bridgeport, WV

STATE OF WEST VIRGINIA
 DEPARTMENT OF ENVIRONMENTAL PROTECTION
 OIL AND GAS DIVISION

DATE: May 14 20 25
 OPERATOR'S WELL NO. Schoen 1205 N-1H
 API WELL NO
 47 - 033 - 06001
 STATE COUNTY PERMIT


WELL TYPE: ☐ OIL ☒ GAS ☐ LIQUID INJECTION ☐ WASTE DISPOSAL
 (IF GAS) PRODUCTION: ☐ STORAGE ☐ DEEP ☒ SHALLOW

LOCATION: ELEVATION: 1,407.3' WATERSHED: Middle West Fork Creek
 DISTRICT: Grant / Union
 SURFACE OWNER: George & Rosanne Schoen
 ROYALTY OWNER: Willa Post Robey, et al LEASE NO: ACREAGE: 65.80
 PROPOSED WORK: ☐ DRILL ☐ CONVERT ☐ DRILL DEEPER ☐ FRACTURE OR STIMULATE ☐ PLUG OFF OLD FORMATION
☐ PERFORATE NEW FORMATION ☒ OTHER PHYSICAL CHANGE IN WELL (SPECIFY) As-Drilled
☐ PLUG AND ABANDON ☐ CLEAN OUT AND REPLUG TARGET FORMATION: Marcellus Shale ESTIMATED DEPTH: 7,436' TVD 26,890' MD

WELL OPERATOR: HG Energy II Appalachia, LLC DESIGNATED AGENT: Diane C. White
 ADDRESS: 5260 Dupont Road ADDRESS: 5260 Dupont Road
 Parkersburg, WV 26101 Parkersburg, WV 26101




Detail 2 - Scale: 1" = 500'

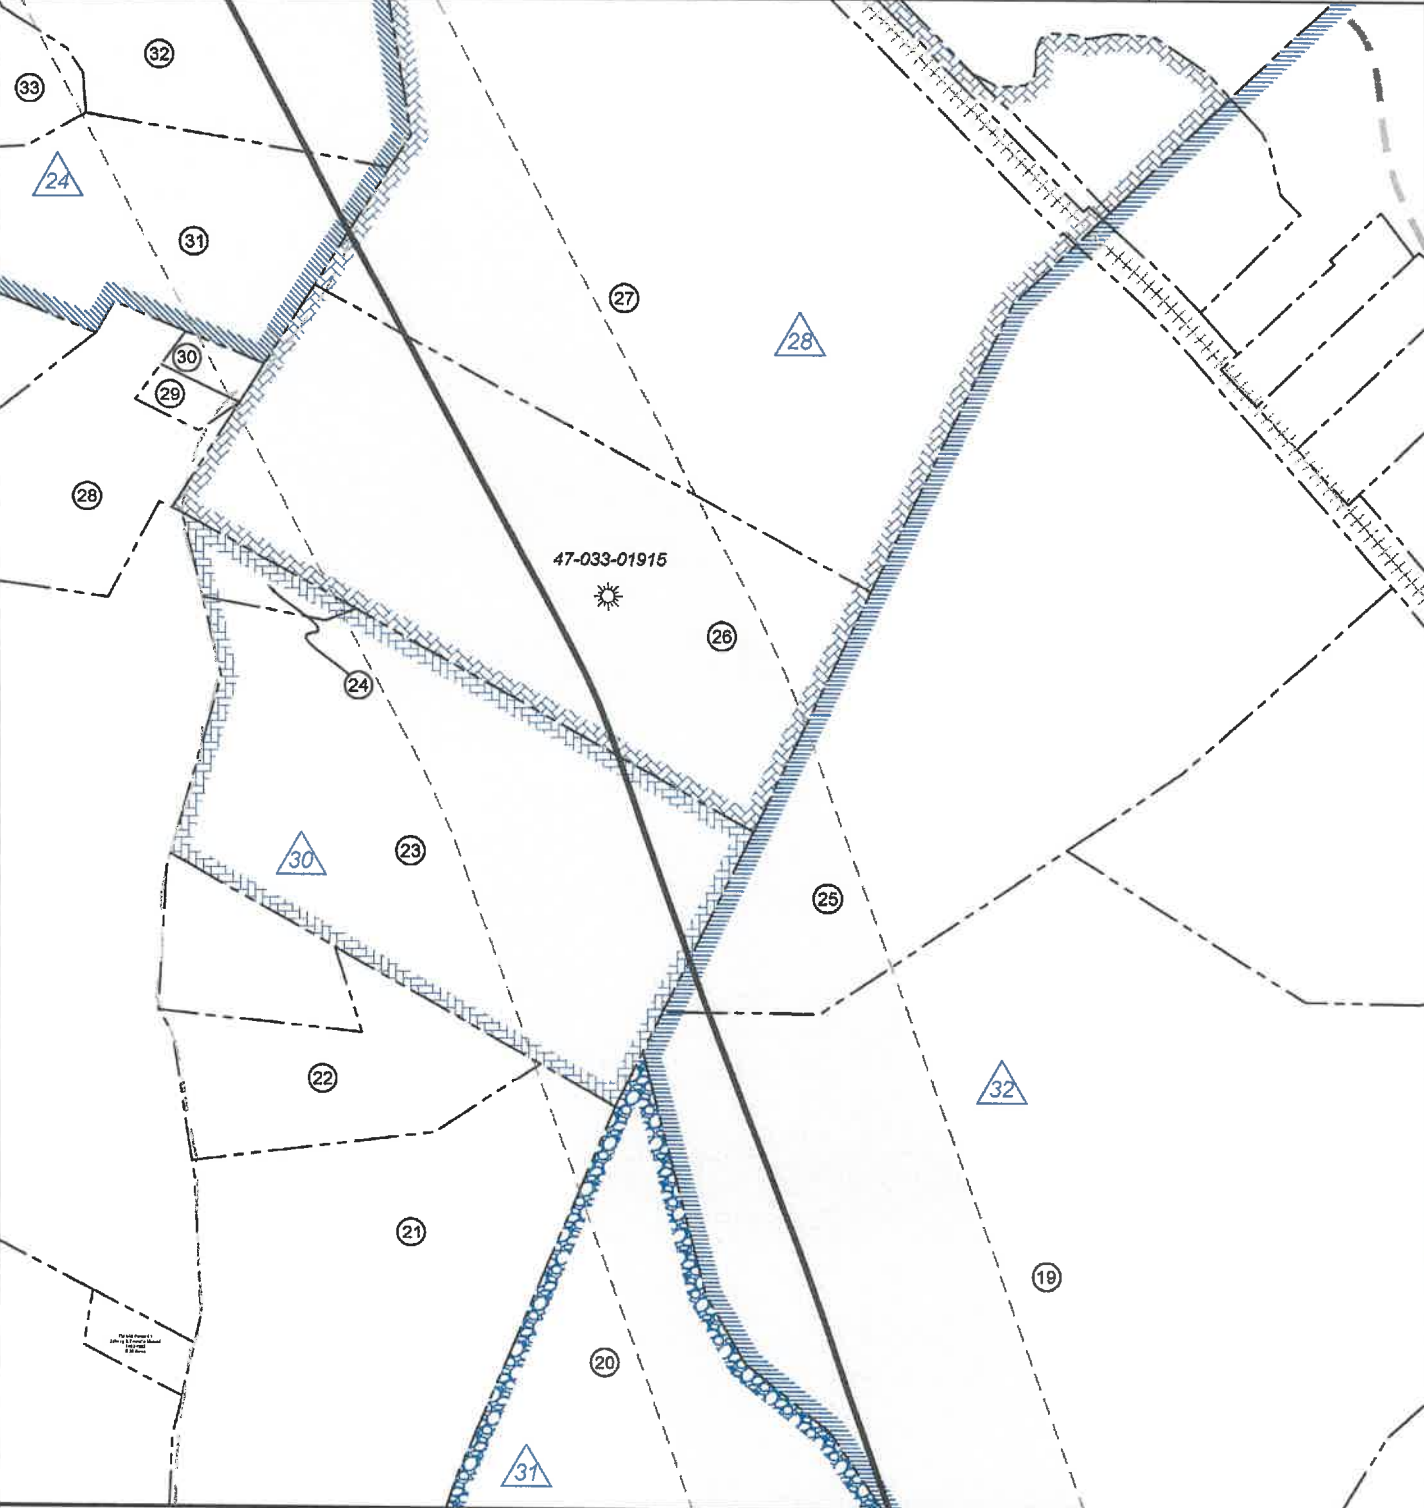

FILE NO: 32-36-G-19 DRAWING NO: Schoen 1205 N-1H Well Plat SCALE: 1" = 2000' MINIMUM DEGREE OF ACCURACY: Submeter PROVEN SOURCE OF ELEVATION: CORS, Bridgeport, WV	OF WEST VIRGINIA STATE OF WEST VIRGINIA DEPARTMENT OF ENVIRONMENTAL PROTECTION OIL AND GAS DIVISION 11000 SEMPER PARATI	DATE: May 14 20 25 OPERATOR'S WELL NO. Schoen 1205 N-1H API WELL NO 47 — 033 — 06001 STATE COUNTY PERMIT
WELL TYPE: ☐ OIL ☒ GAS ☐ LIQUID INJECTION ☐ WASTE DISPOSAL (IF GAS) PRODUCTION : ☐ STORAGE ☐ DEEP ☒ SHALLOW		
LOCATION: ELEVATION: 1,407.3' WATERSHED: Middle West Fork Creek DISTRICT: Grant / Union		Top: Mount Clare QUADRANGLE: Btm: West Milford COUNTY: Harrison ACREAGE: 65.00 09/19/2025 ACREAGE: 78.20
SURFACE OWNER: George & Rosanne Schoen ROYALTY OWNER: Willa Post Robey, et al		LEASE NO: _____
PROPOSED WORK: ☐ DRILL ☐ CONVERT ☐ DRILL DEEPER ☐ FRACTURE OR STIMULATE ☐ PLUG OFF OLD FORMATION ☐ PERFORATE NEW FORMATION ☒ OTHER PHYSICAL CHANGE IN WELL (SPECIFY) As-Drilled		
☐ PLUG AND ABANDON ☐ CLEAN OUT AND REPLUG TARGET FORMATION: Marcellus Shale ESTIMATED DEPTH: 7,436' TVD 28,890' MD		
WELL OPERATOR: HG Energy II Appalachia, LLC ADDRESS: 5260 Dupont Road Parkersburg, WV 26101		DESIGNATED AGENT: Diane C. White ADDRESS: 5260 Dupont Road Parkersburg, WV 26101



Detail 3 - Scale: 1" = 500'

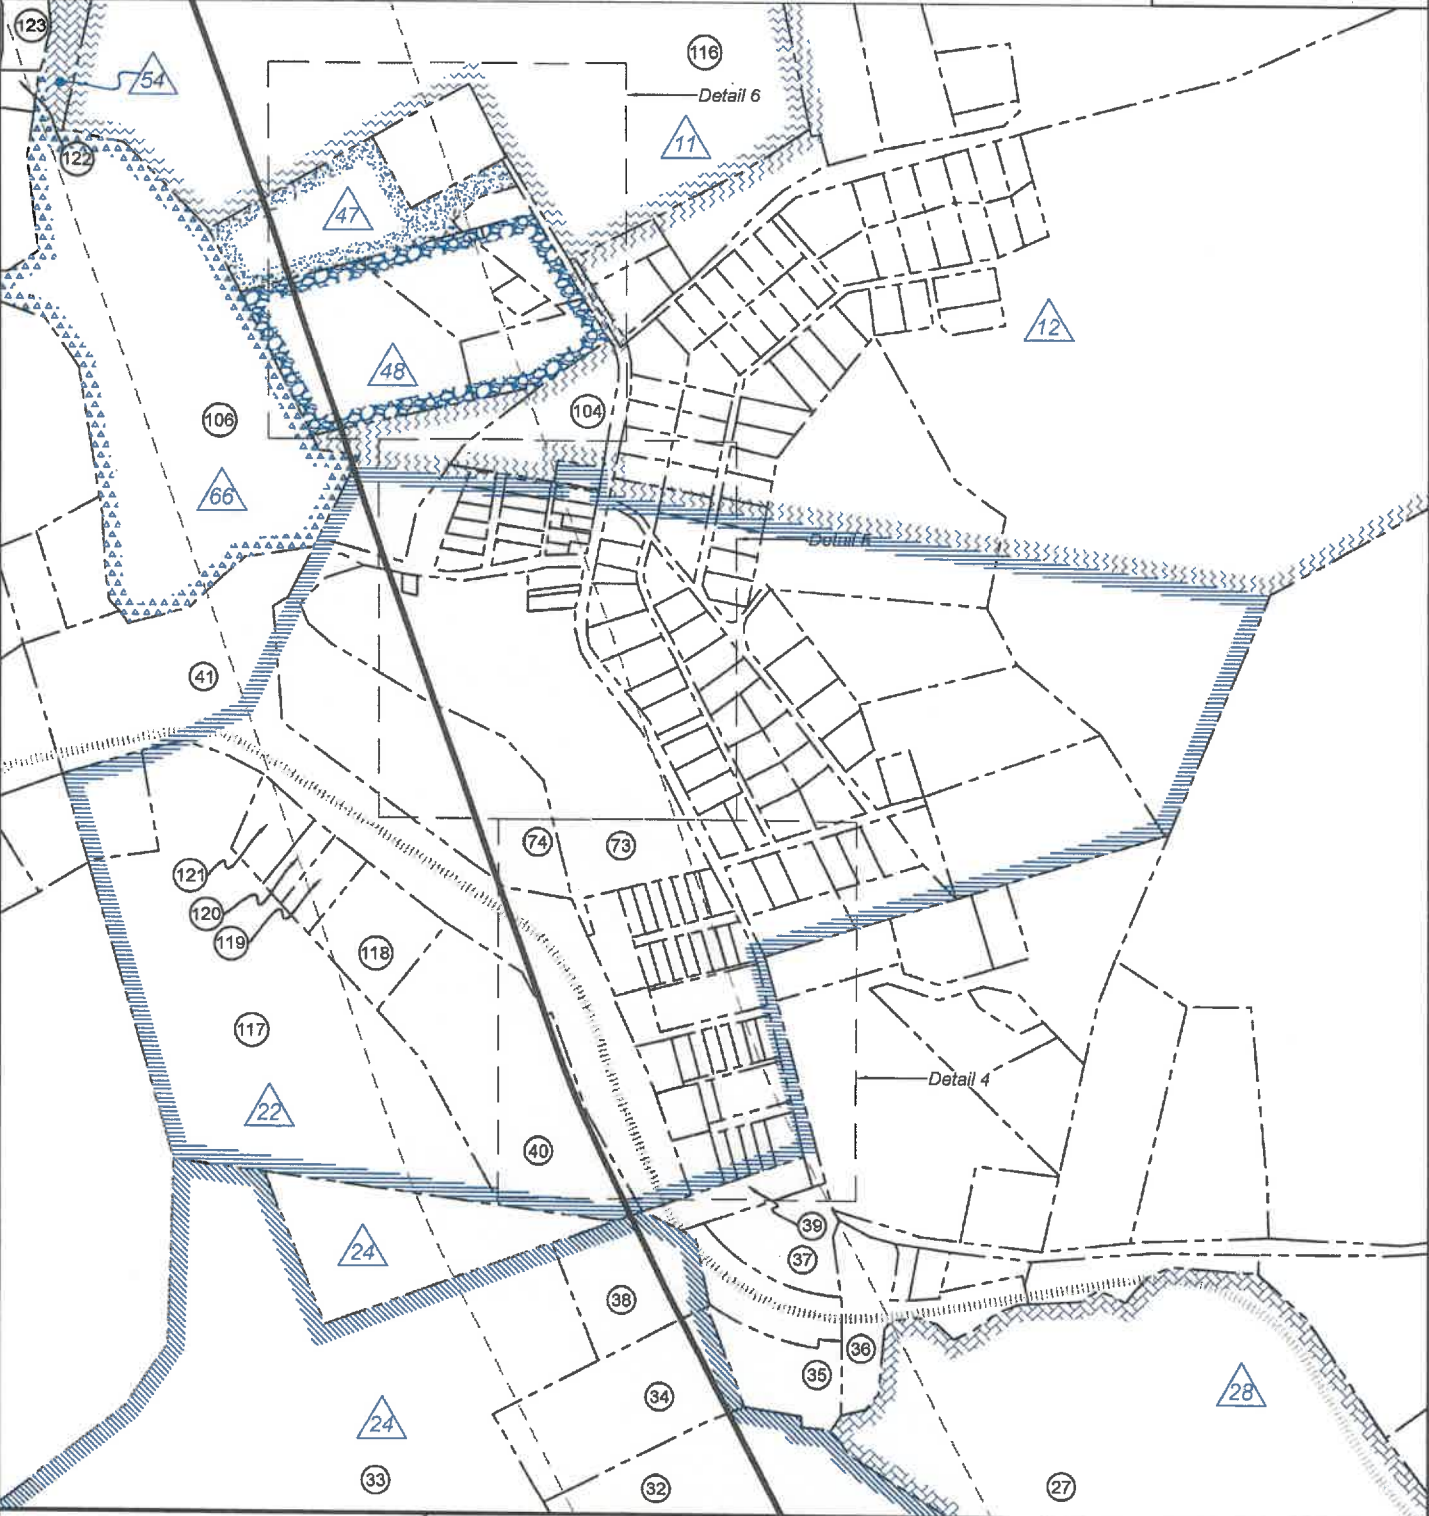

FILE NO: <u>32-36-G-19</u> DRAWING NO: <u>Schoen 1205 N-1H Well Plat</u> SCALE: <u>1" = 2000'</u> MINIMUM DEGREE OF ACCURACY: <u>Submeter</u> PROVEN SOURCE OF ELEVATION: <u>CORS, Bridgeport, WV</u>	STATE OF WEST VIRGINIA DEPARTMENT OF ENVIRONMENTAL PROTECTION OIL AND GAS DIVISION	DATE: <u>May 14</u> 20 <u>25</u> OPERATOR'S WELL NO. <u>Schoen 1205 N-1H</u> API WELL NO <u>47</u> — <u>033</u> — <u>06001</u> STATE COUNTY PERMIT
WELL TYPE: ☐ OIL ☒ GAS ☐ LIQUID INJECTION ☐ WASTE DISPOSAL (IF GAS) PRODUCTION: ☐ STORAGE ☐ DEEP ☒ SHALLOW		
LOCATION: ELEVATION: <u>1,407.3'</u> WATERSHED: <u>Middle West Fork Creek</u> DISTRICT: <u>Grant / Union</u> SURFACE OWNER: <u>George & Rosanne Schoen</u> ROYALTY OWNER: <u>Willia Post Robey, et al</u> LEASE NO: _____ ACREAGE: <u>65.08</u> PROPOSED WORK: ☐ DRILL ☐ CONVERT ☐ DRILL DEEPER ☐ FRACTURE OR STIMULATE ☐ PLUG OFF OLD FORMATION ☐ PERFORATE NEW FORMATION ☒ OTHER PHYSICAL CHANGE IN WELL (SPECIFY) <u>As-Drilled</u> ☐ PLUG AND ABANDON ☐ CLEAN OUT AND REPLUG TARGET FORMATION: <u>Marcellus Shale</u> ESTIMATED DEPTH: <u>7,436' TVD</u> <u>26,890' MD</u>		
WELL OPERATOR: <u>HG Energy II Appalachia, LLC</u> DESIGNATED AGENT: <u>Diane C. White</u> ADDRESS: <u>5260 Dupont Road</u> ADDRESS: <u>5260 Dupont Road</u> <u>Parkersburg, WV 26101</u> <u>Parkersburg, WV 26101</u>		





Detail 4 - Scale: NTS'




FILE NO: 32-36-G-19 DRAWING NO: Schoen 1205 N-1H Well Plat SCALE: 1" = 2000' MINIMUM DEGREE OF ACCURACY: Submeter PROVEN SOURCE OF ELEVATION: CORS, Bridgeport, WV	STATE OF WEST VIRGINIA DEPARTMENT OF ENVIRONMENTAL PROTECTION OIL AND GAS DIVISION OF WEST VIRGINIA SEMPER PARATUS	DATE: May 14 20 25 OPERATOR'S WELL NO. Schoen 1205 N-1H API WELL NO 47 — 033 — 06001 STATE COUNTY PERMIT
WELL TYPE: ☐ OIL ☒ GAS ☐ LIQUID INJECTION ☐ WASTE DISPOSAL (IF GAS) PRODUCTION: ☐ STORAGE ☐ DEEP ☒ SHALLOW		
LOCATION: ELEVATION: 1,407.3' WATERSHED: Middle West Fork Creek DISTRICT: Grant / Union SURFACE OWNER: George & Rosanne Schoen ROYALTY OWNER: Willa Post Robey, et al		Top: Mount Clare Btm: West Milford QUADRANGLE: COUNTY: Harrison ACREAGE: 65.00 LEASE NO: ACREAGE: 78.20
PROPOSED WORK: ☐ DRILL ☐ CONVERT ☐ DRILL DEEPER ☐ FRACTURE OR STIMULATE ☐ PLUG OFF OLD FORMATION ☐ PERFORATE NEW FORMATION ☒ OTHER PHYSICAL CHANGE IN WELL (SPECIFY) As-Drilled ☐ PLUG AND ABANDON ☐ CLEAN OUT AND REPLUG TARGET FORMATION: Marcellus Shale ESTIMATED DEPTH: 7,438' TVD 26,890' MD		
WELL OPERATOR: HG Energy II Appalachia, LLC DESIGNATED AGENT: Diane C. White ADDRESS: 5260 Dupont Road ADDRESS: 5260 Dupont Road Parkersburg, WV 26101 Parkersburg, WV 26101		

09/19/2025

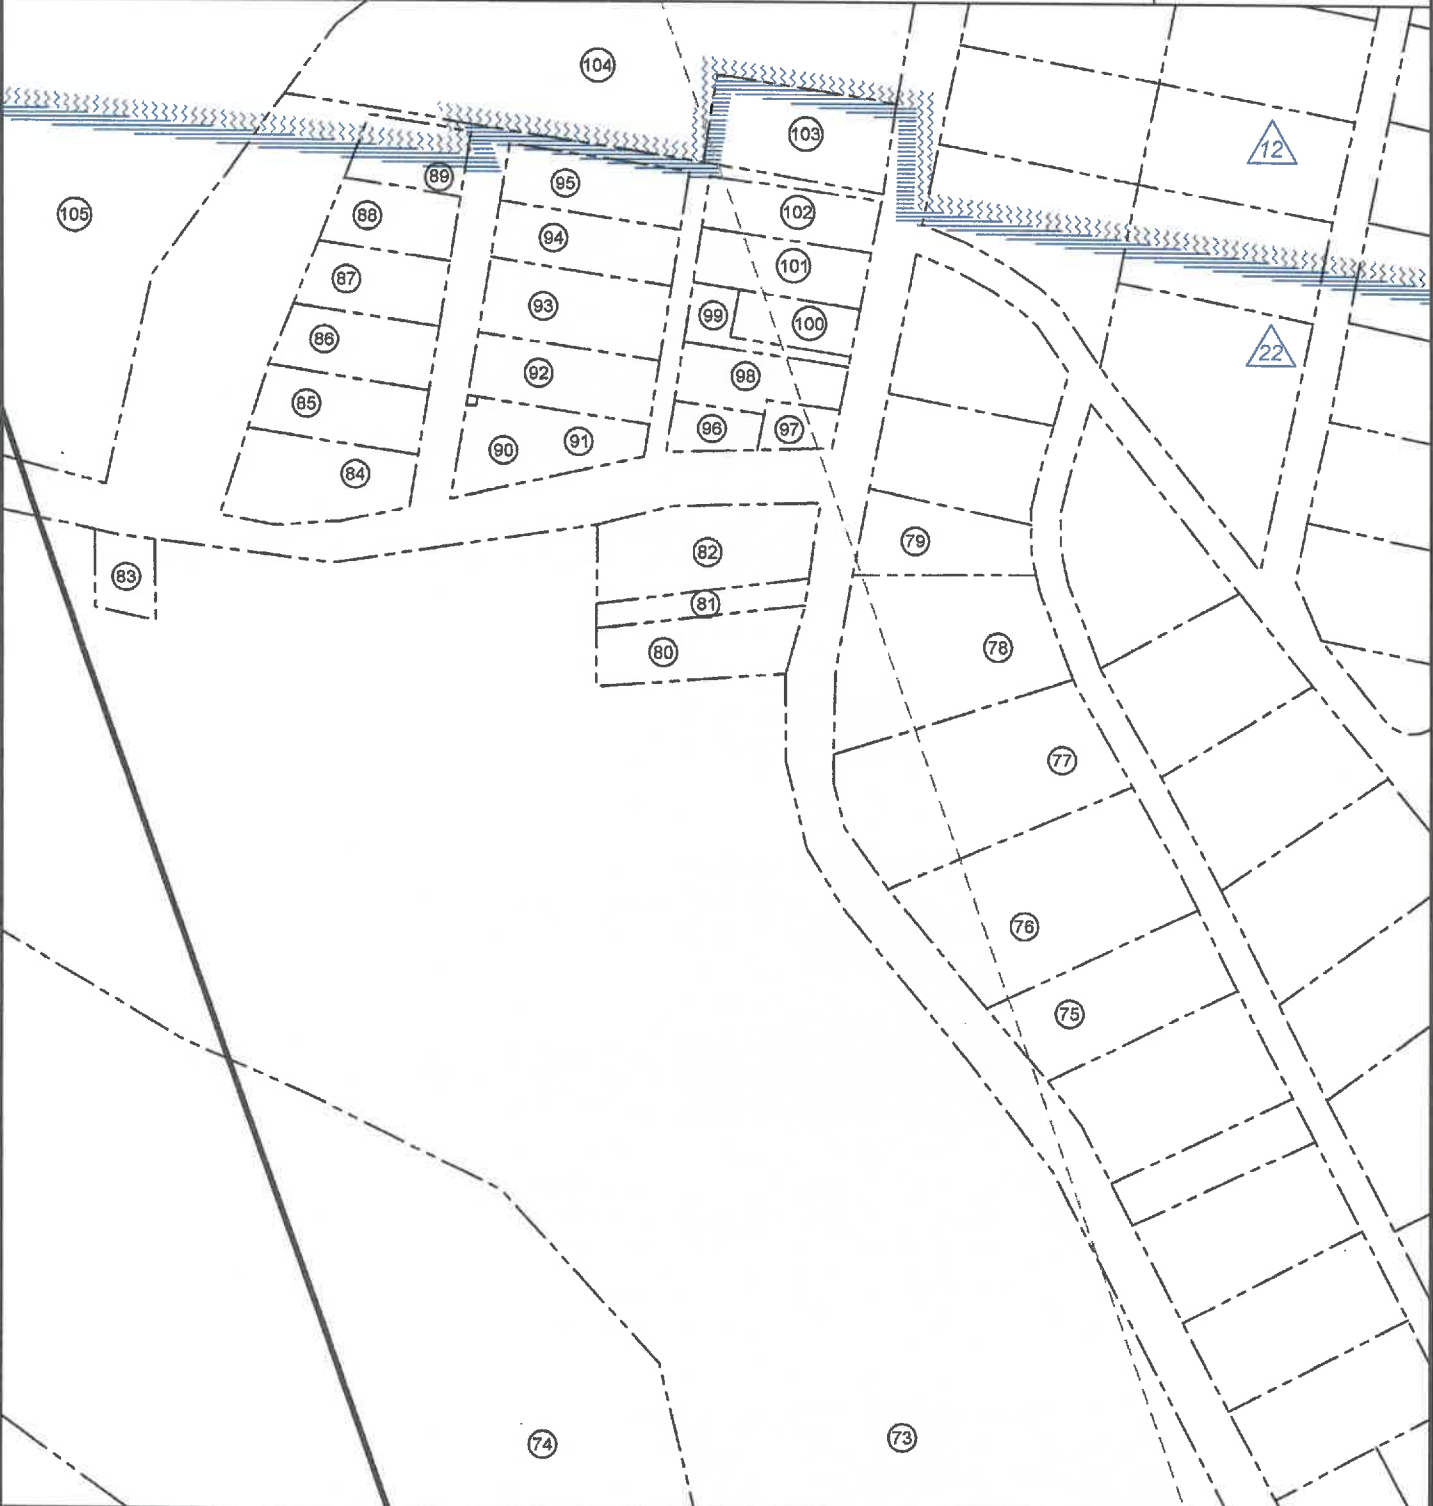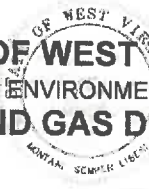HG Energy II Appalachia, LLC Well No. Schoen 1205 N-1H As-Drilled Page 6 of 11		 Detail 5 - Scale: NTS'			
					
FILE NO: 32-36-G-19 DRAWING NO: Schoen 1205 N-1H Well Plat SCALE: 1" = 2000' MINIMUM DEGREE OF ACCURACY: Submeter PROVEN SOURCE OF ELEVATION: CORS, Bridgeport, WV		STATE OF WEST VIRGINIA DEPARTMENT OF ENVIRONMENTAL PROTECTION OIL AND GAS DIVISION 		DATE: May 14 20 25 OPERATOR'S WELL NO. Schoen 1205 N-1H API WELL NO 47 — 033 — 06001 STATE COUNTY PERMIT	
WELL TYPE: ☐ OIL ☒ GAS ☐ LIQUID INJECTION ☐ WASTE DISPOSAL (IF GAS) PRODUCTION: ☐ STORAGE ☐ DEEP ☒ SHALLOW LOCATION: ELEVATION: 1,407.3' WATERSHED: Middle West Fork Creek DISTRICT: Grant / Union SURFACE OWNER: George & Rosanne Schoen ROYALTY OWNER: Willa Post Robey, et al PROPOSED WORK: ☐ DRILL ☐ CONVERT ☐ DRILL DEEPER ☐ FRACTURE OR STIMULATE ☐ PLUG OFF OLD FORMATION ☐ PERFORATE NEW FORMATION ☒ OTHER PHYSICAL CHANGE IN WELL (SPECIFY) As-Drilled ☐ PLUG AND ABANDON ☐ CLEAN OUT AND REPLUG TARGET FORMATION: Marcellus Shale ESTIMATED DEPTH: 7,436' TVD 26,890' MD					
WELL OPERATOR: HG Energy II Appalachia, LLC ADDRESS: 5260 Dupont Road Parkersburg, WV 26101		DESIGNATED AGENT: Diane C. White ADDRESS: 5260 Dupont Road Parkersburg, WV 26101			



Detail 6 - Scale: NTS'

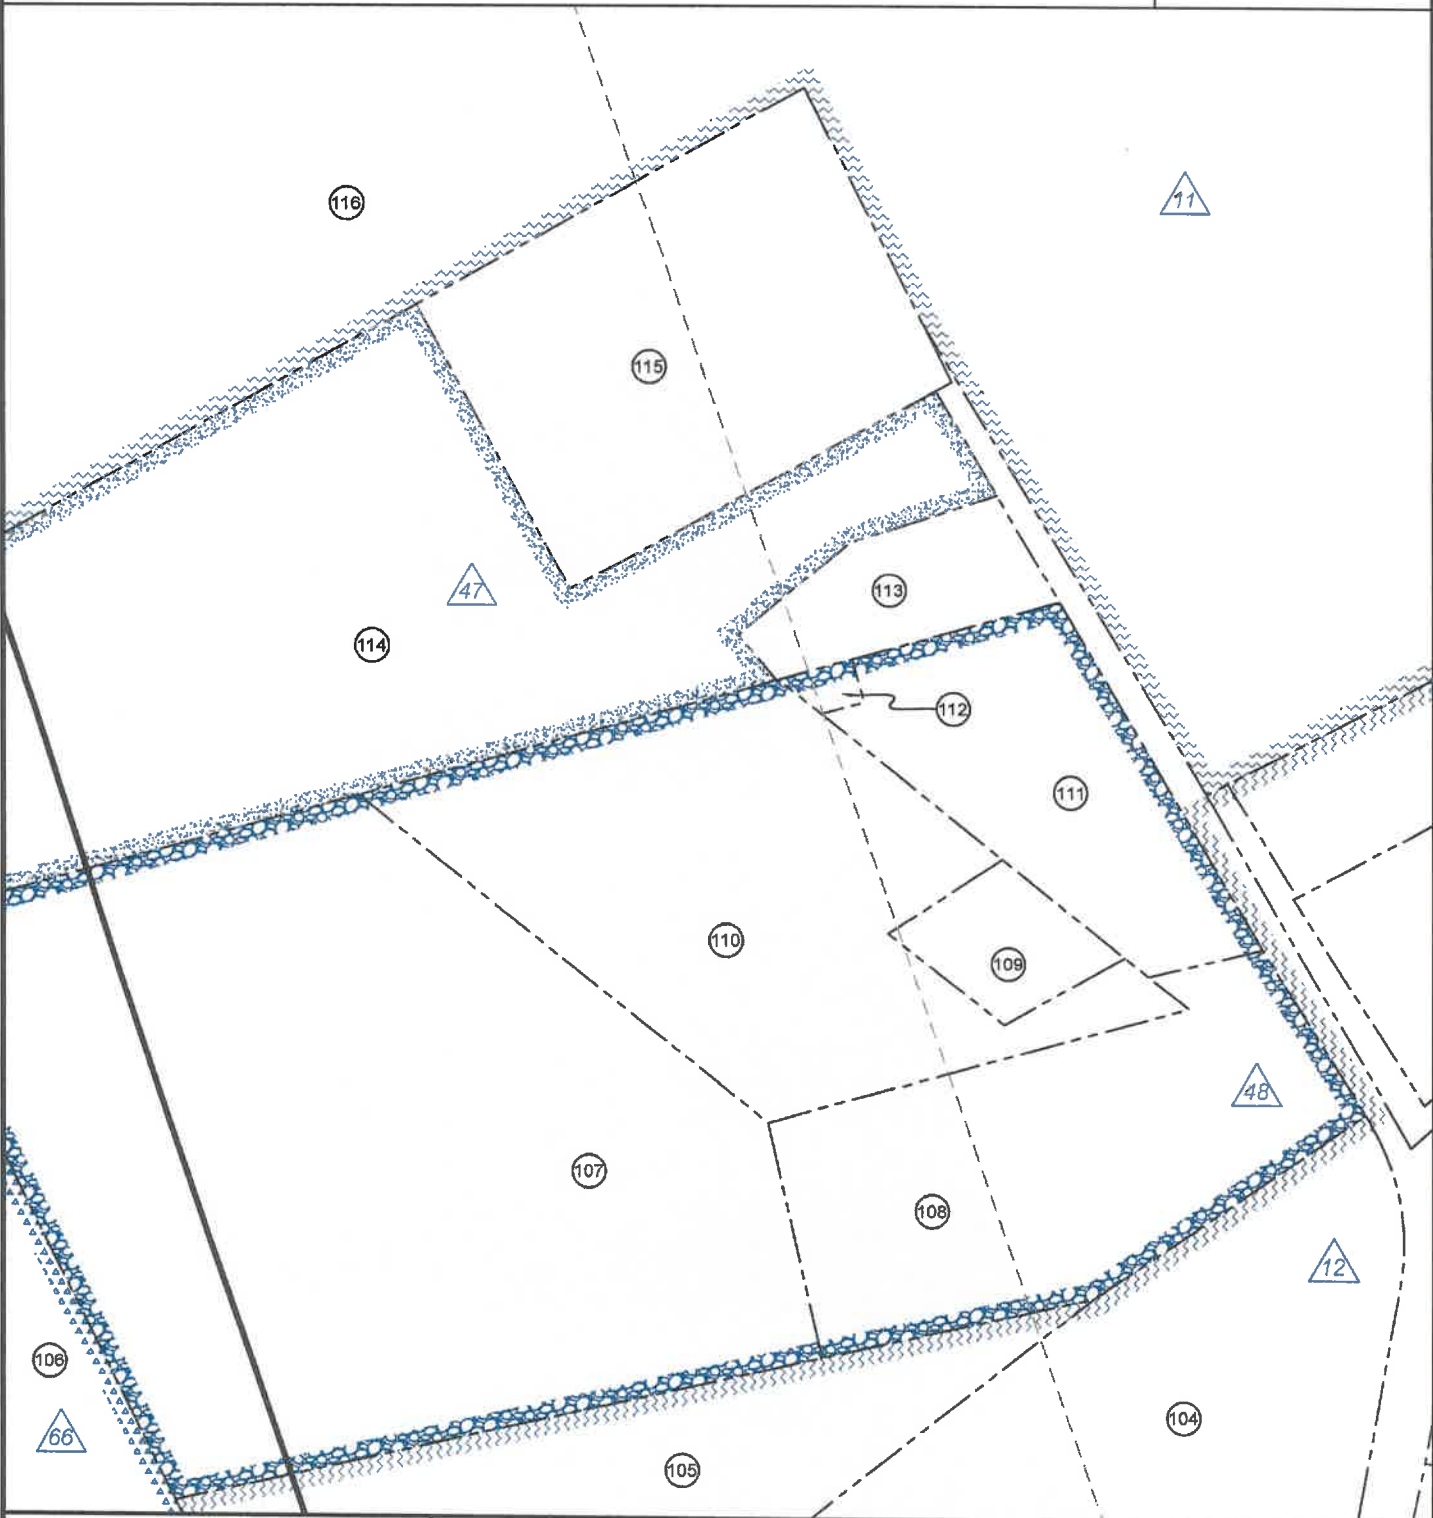

FILE NO: 32-36-G-19
 DRAWING NO: Schoen 1205 N-1H Well Plat
 SCALE: 1" = 2000'
 MINIMUM DEGREE OF ACCURACY:
 Submeter
 PROVEN SOURCE OF ELEVATION:
 CORS, Bridgeport, WV

STATE OF WEST VIRGINIA
 DEPARTMENT OF ENVIRONMENTAL PROTECTION
 OIL AND GAS DIVISION

DATE: May 14 20 25
 OPERATOR'S WELL NO. Schoen 1205 N-1H
 API WELL NO
 47 - 033 - 06001
 STATE COUNTY PERMIT

WELL TYPE: ☐ OIL ☒ GAS ☐ LIQUID INJECTION ☐ WASTE DISPOSAL
 (IF GAS) PRODUCTION : ☐ STORAGE ☐ DEEP ☒ SHALLOW

LOCATION: ELEVATION: 1,407.3' WATERSHED: Middle West Fork Creek
 DISTRICT: Grant / Union

SURFACE OWNER: George & Rosanne Schoen
 ROYALTY OWNER: Willa Post Robey, et al

PROPOSED WORK: ☐ DRILL ☐ CONVERT ☐ DRILL DEEPER ☐ FRACTURE OR STIMULATE ☐ PLUG OFF OLD FORMATION
☐ PERFORATE NEW FORMATION ☒ OTHER PHYSICAL CHANGE IN WELL (SPECIFY) As-Drilled
☐ PLUG AND ABANDON ☐ CLEAN OUT AND REPLUG TARGET FORMATION: Marcellus Shale ESTIMATED DEPTH: 7,438' TVD 26,890' MD


WELL OPERATOR: HG Energy II Appalachia, LLC DESIGNATED AGENT: Diane C. White
 ADDRESS: 5260 Dupont Road ADDRESS: 5260 Dupont Road
 Parkersburg, WV 26101 Parkersburg, WV 26101

HG Energy II
 Appalachia, LLC
 Well No. Schoen
 1205 N-1H As-Drilled

Page 8 of 11



Detail 7 - Scale: 1" = 500'

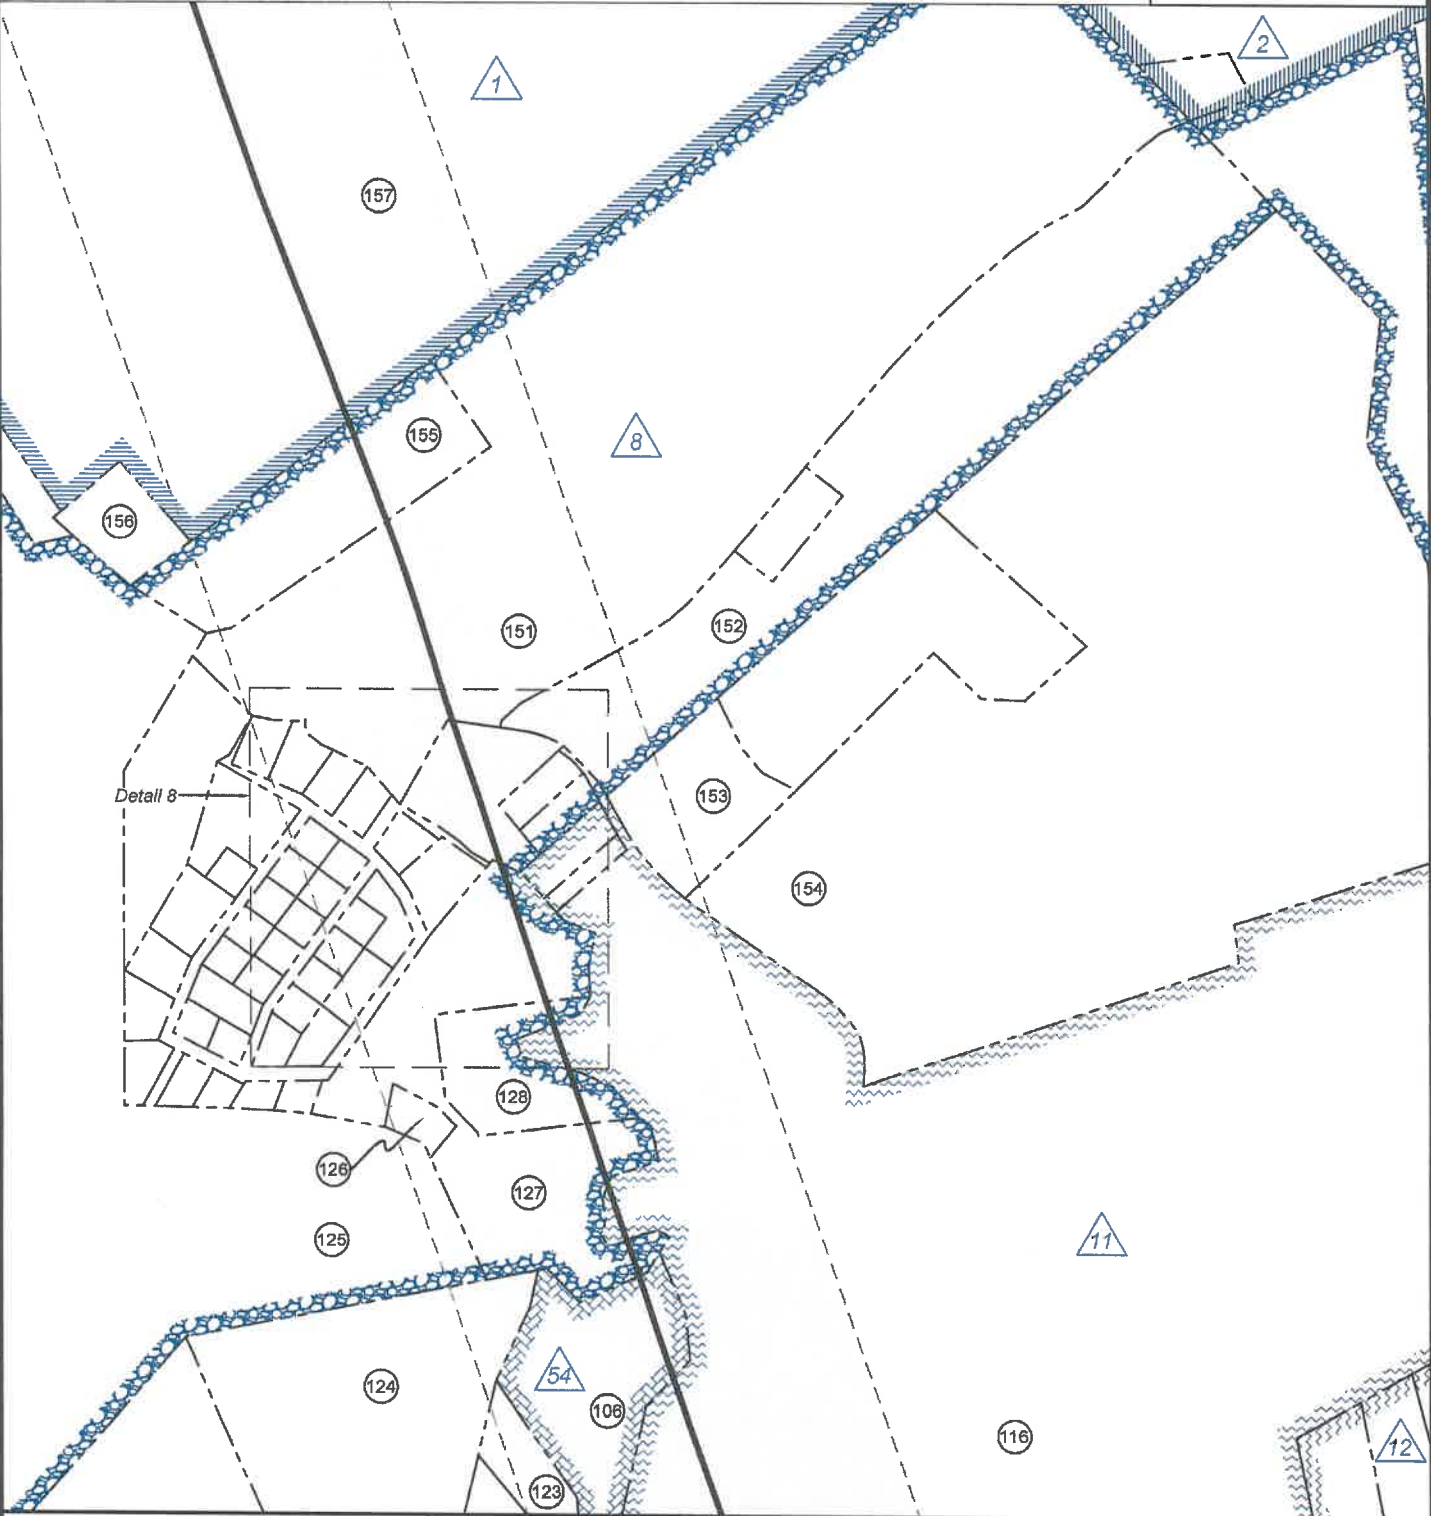

FILE NO: 32-36-G-19
 DRAWING NO: Schoen 1205 N-1H Well Plat
 SCALE: 1" = 2000'
 MINIMUM DEGREE OF ACCURACY:
 Submeter
 PROVEN SOURCE OF ELEVATION:
 CORS, Bridgeport, WV

STATE OF WEST VIRGINIA
 DEPARTMENT OF ENVIRONMENTAL PROTECTION
 OIL AND GAS DIVISION


DATE: May 14 20 25
 OPERATOR'S WELL NO. Schoen 1205 N-1H
 API WELL NO
 47 — 033 — 06001
 STATE COUNTY PERMIT

WELL TYPE: ☐ OIL ☒ GAS ☐ LIQUID INJECTION ☐ WASTE DISPOSAL
 (IF GAS) PRODUCTION : ☐ STORAGE ☐ DEEP ☒ SHALLOW
 LOCATION: ELEVATION: 1,407.3' WATERSHED: Middle West Fork Creek
 DISTRICT: Grant / Union
 SURFACE OWNER: George & Rosanne Schoen
 ROYALTY OWNER: Willa Post Robey, et al
 LEASE NO: ACREAGE: 65.00
 PROPOSED WORK: ☐ DRILL ☐ CONVERT ☐ DRILL DEEPER ☐ FRACTURE OR STIMULATE ☐ PLUG OFF OLD FORMATION
☐ PERFORATE NEW FORMATION ☒ OTHER PHYSICAL CHANGE IN WELL (SPECIFY) As-Drilled
☐ PLUG AND ABANDON ☐ CLEAN OUT AND REPLUG TARGET FORMATION: Marcellus Shale ESTIMATED DEPTH: 7,436' TVD 26,890' MD

WELL OPERATOR: HG Energy II Appalachia, LLC DESIGNATED AGENT: Diane C. White
 ADDRESS: 5260 Dupont Road ADDRESS: 5260 Dupont Road
 Parkersburg, WV 26101 Parkersburg, WV 26101



Detail 8 - Scale: NTS'

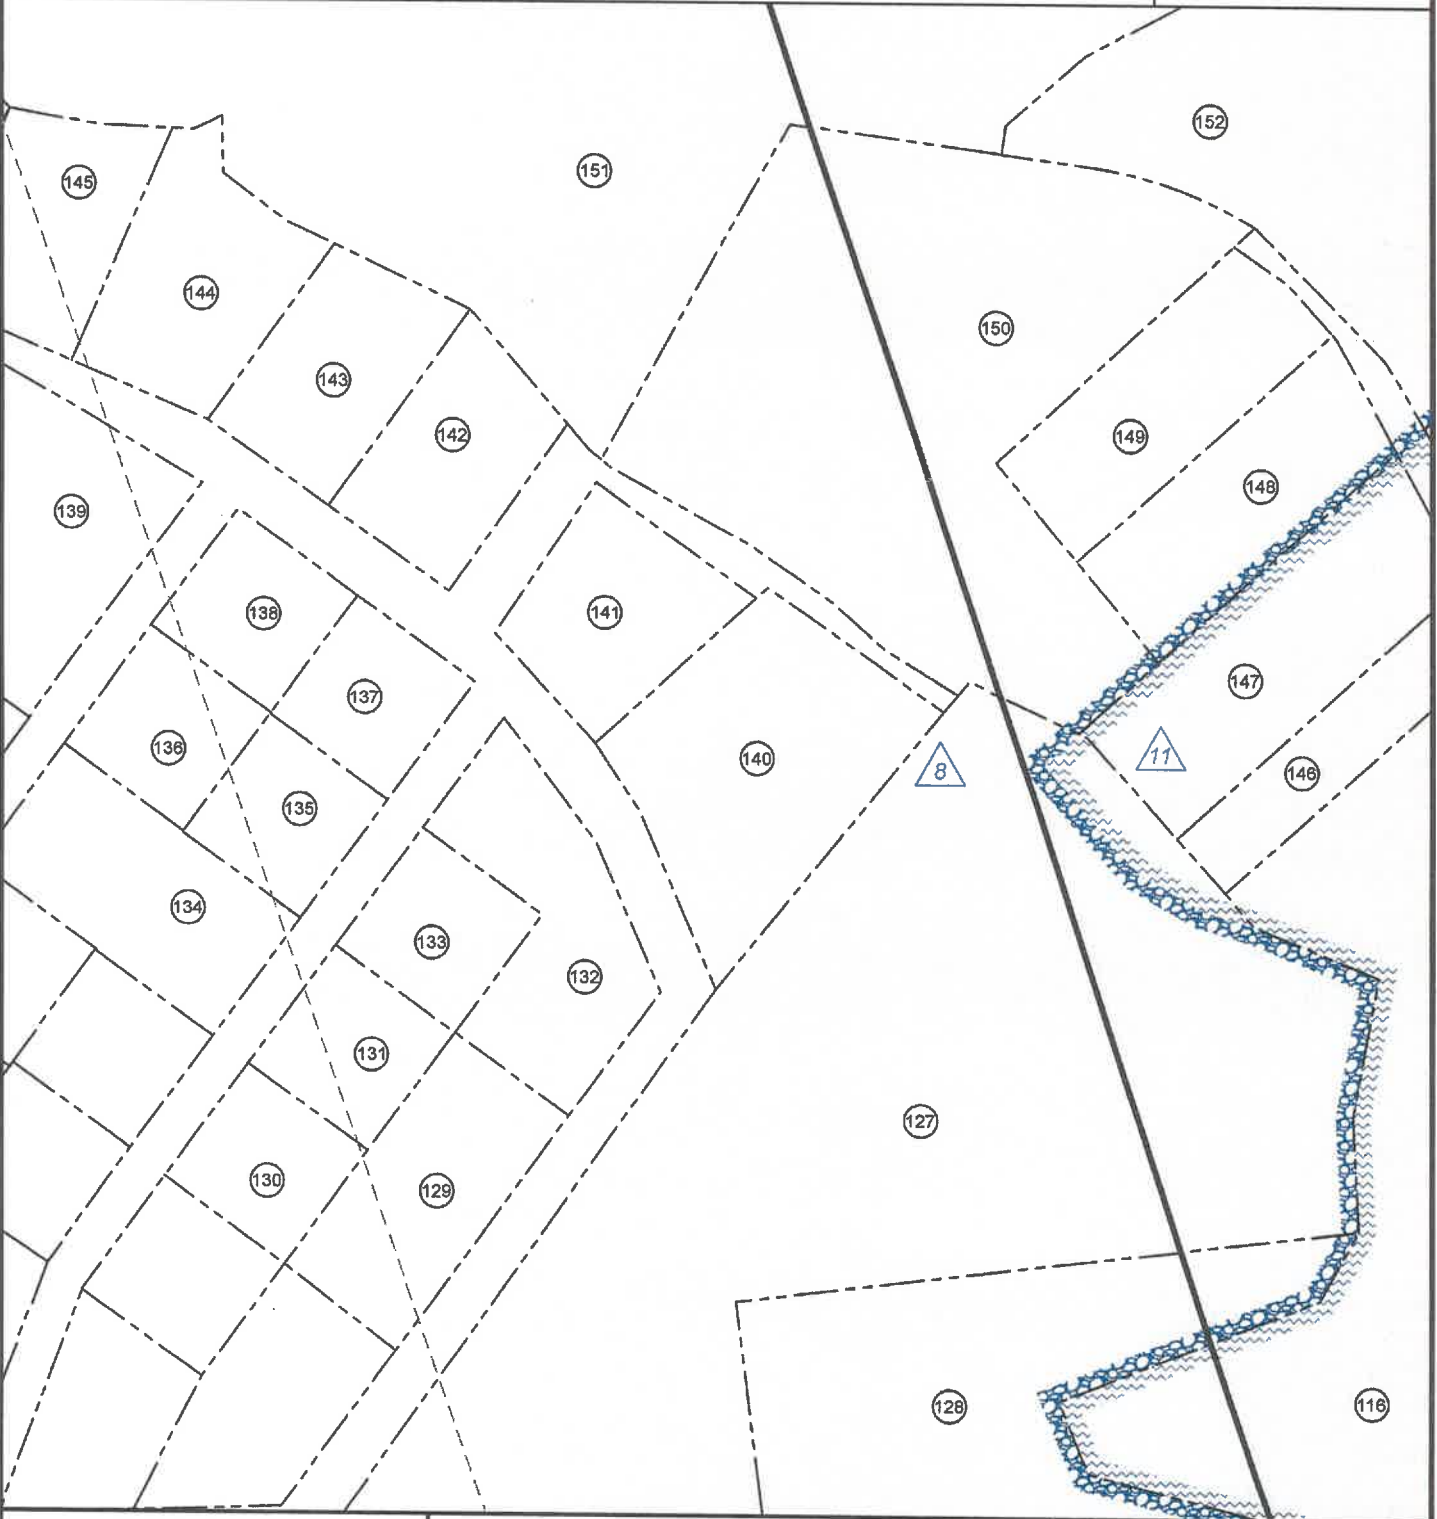

FILE NO: 32-36-G-19 DRAWING NO: Schoen 1205 N-1H Well Plat SCALE: 1" = 2000' MINIMUM DEGREE OF ACCURACY: Submeter PROVEN SOURCE OF ELEVATION: CORS, Bridgeport, WV	STATE OF WEST VIRGINIA DEPARTMENT OF ENVIRONMENTAL PROTECTION OIL AND GAS DIVISION	DATE: May 14 20 25 OPERATOR'S WELL NO. Schoen 1205 N-1H API WELL NO 47 — 033 — 06001 STATE COUNTY PERMIT
WELL TYPE: ☐ OIL ☒ GAS ☐ LIQUID INJECTION ☐ WASTE DISPOSAL (IF GAS) PRODUCTION : ☐ STORAGE ☐ DEEP ☒ SHALLOW		
LOCATION: ELEVATION: 1,407.3' WATERSHED: Middle West Fork Creek DISTRICT: Grant / Union SURFACE OWNER: George & Rosanne Schoen ROYALTY OWNER: Willa Post Robey, et al PROPOSED WORK: ☐ DRILL ☐ CONVERT ☐ DRILL DEEPER ☐ FRACTURE OR STIMULATE ☐ PLUG OFF OLD FORMATION ☐ PERFORATE NEW FORMATION ☒ OTHER PHYSICAL CHANGE IN WELL (SPECIFY) As-Drilled ☐ PLUG AND ABANDON ☐ CLEAN OUT AND REPLUG TARGET FORMATION: Marcellus Shale ESTIMATED DEPTH: 7,436' TVD 28,890' MD		Top: Mount Clare QUADRANGLE: Btm: West Milford COUNTY: Harrison ACREAGE: 65.08 ACREAGE: 78.20
WELL OPERATOR: HG Energy II Appalachia, LLC DESIGNATED AGENT: Diane C. White ADDRESS: 5260 Dupont Road ADDRESS: 5260 Dupont Road Parkersburg, WV 26101 Parkersburg, WV 26101		



No.	TM / Par	Owner	Bk / Pg	Ac.
1	447 / 2	George & Roseanne Schoen	1148 / 1059	65.00
2	446 / 29	John F. McCuskey II, et al	1121 / 25	75.00
3	446 / 28.2	David D. Vanhom (LE), et al	W177 / 82	42.66
4	446 / 28.4	Bradford Vanhom	1381 / 1181	1.52
5	446 / 28.5	Robert L. Vanhom	1352 / 91	1.52
6	446 / 15	Vera E. & Oral K. Haught	1582 / 898	14.40
7	446 / 12	Marilyn Gaines	1192 / 300	2.93
8	446 / 28.1	Andrew Schrader & Melinda Davis	1478 / 252	0.45
9	446 / 28.3	Sharon Willie	1349 / 1253	0.45
10	446 / 28	Larry E. Wilson II	1344 / 1211	0.57
11	446 / 15.1	David & Grace Hughes	1257 / 694	0.31
12	446 / 26.1	Robert Mendez Jr.	1435 / 330	0.18
13	446 / 24.5	Lester L. Cook Sr.	1364 / 265	0.21
14	446 / 24.1	Brooke & Lillie Swisher	1432 / 856	0.15
15	446 / 24.4	Brooke & Lillie Swisher	1432 / 856	0.03
16	446 / 24.2	Daniel Frazier (LE)	W165 / 1065	0.20
17	446 / 24.3	Mark & Karen Wilt	1157 / 579	0.58
18	446 / 24	Robert N. Rector (LE)	1621 / 719	82.90
19	446 / 7	James R. & Sharon L. Ailman	1437 / 165	91.79
20	446 / 6	Robert N. Rector (LE)	1621 / 719	49.33
21	446 / 5	Kathy D. Bennett	W184 / 51	20.83
22	426 / 76	Ethan Stonko	1622 / 771	7.00
23	426 / 77	Kenneth E. Rigdon	1569 / 903	28.26
24	426 / 64	Eugene Alkire Jr.	1271 / 1183	2.00
25	426 / 66	Michael W. & Robert D. Rector	1621 / 719	41.75
26	426 / 65	G. Thomas Smith	1277 / 1174	29.79
27	426 / 50	G. Thomas Smith	1277 / 1174	66.80
28	426 / 42	Cathleen Spitler (LE), et al	1405 / 449	11.69
29	426 / 42.1	Andrew D. & Sarah N. Spitler	1669 / 645	0.57
30	426 / 43.1	Andrew D. & Sarah N. Spitler	1669 / 645	0.62
31	426 / 44	AL-N-EL Farms, LLC	1623 / 1057	17.73
32	426 / 45	Constance & Gary I. Saunders II	1591 / 100	12.43
33	426 / 40	AL-N-EL Farms, LLC	1623 / 1057	57.97
34	426 / 46	Constance & Gary I. Saunders II	1591 / 100	4.00
35	426 / 47	Constance & Gary I. Saunders II	1591 / 100	1.00
36	426 / 48.2	John E. Messenger	1351 / 206	2.19
37	426 / 29	Daniel R. & Lana M. Messenger	1194 / 1027	1.50
38	426 / 28	Constance & Gary I. Saunders II	1591 / 100	2.32
39	426 / 30	Daniel R. & Lana M. Messenger	1151 / 210	0.82
40	426 / 26	David L. Bowles	1518 / 1298	6.05

No.	TM / Par	Owner	Bk / Pg	Ac.
41	426 / 27	Antonio P., LLC	1503 / 291	6.53
42	2005 / 68	Wilma L. & George W. Bennett, III	1655 / 43	0.43
43	2005 / 62	George W. Bennett Jr.	W149 / 468	0.14
44	2005 / 63	George W. Bennett Jr.	W149 / 468	0.13
45	2005 / 64	James L. & Margie H. Fultineer	1340 / 1154	0.12
46	2005 / 65	James L. & Margie H. Fultineer	1340 / 1154	0.12
47	2005 / 67	Daniel M. & Nita M. Richards	1619 / 832	0.29
48	2005 / 69	Wilma L. & George W. Bennett, III	1169 / 953	0.31
49	2005 / 56	Kathy D. Bennett	1374 / 379	0.11
50	2005 / 61	Kathy D. Bennett	1380 / 737	0.55
51	2005 / 70	Grant-Union Public Service District	1169 / 953	0.31
52	2005 / 39	Kathy D. Bennett	1281 / 712	0.11
53	2005 / 40	Kathy D. Bennett	1281 / 712	0.11
54	2005 / 41	Kathy D. Bennett	1281 / 712	0.11
55	2005 / 42	Kathy D. Bennett	1281 / 712	0.11
56	2005 / 43	Kathy D. Bennett	1281 / 712	0.11
57	2005 / 44	Kathy D. Bennett	1281 / 712	0.11
58	2005 / 71	Brenda Withers	1374 / 1062	0.32
59	2005 / 33	Brenda R. Withers & Mary V. Hayes	1344 / 136	0.88
60	2005 / 5	Michael A. Wright (Lots 30-44)	1626 / 1172	2.47
61	2005 / 16	Michael A. Wright	1626 / 1172	Lot 37
62	2005 / 17	Michael A. Wright	1626 / 1172	Lot 36
63	2005 / 18	Michael A. Wright	1626 / 1172	Lot 35
64	2005 / 19	Michael A. Wright	1626 / 1172	Lot 34
65	2005 / 20	Michael A. Wright	1626 / 1172	Lot 33
66	2005 / 21	Michael A. Wright	1626 / 1172	Lot 32
67	2005 / 6	Michael A. Wright	1626 / 1172	Lot 44
68	2005 / 7	Michael A. Wright	1626 / 1172	Lot 43
69	2005 / 8	Michael A. Wright	1626 / 1172	Lot 42
70	2005 / 9	Michael A. Wright	1626 / 1172	Lot 41
71	2005 / 10	Michael A. Wright	1626 / 1172	Lot 40
72	2005 / 11	Michael A. Wright	1626 / 1172	Lot 39
73	426 / 34.1	Jacob D. & Nancy L. Post	1023 / 150	9.27
74	426 / 20	Grafton Coal Company	1016 / 223	6.00
75	2015 / 78	Quintin J. Moore & Lora K. Varner	1602 / 451	0.28
76	2015 / 79	William R. Reed Jr.	1403 / 601	0.33
77	2015 / 80	Thomas M. Tice & Michelle L. Liptak	1319 / 1082	0.36
78	2015 / 81	Jesse D. Garrett	1403 / 1133	0.29
79	2015 / 82	John & Mary R. Miller	1397 / 1177	0.22
80	2005 / 55	Gale L. & Melissa A. Zickefoose	1475 / 318	0.12

FILE NO: 32-36-G-19
 DRAWING NO: Schoen 1205 N-1H Well Plat
 SCALE: 1" = 2000'
 MINIMUM DEGREE OF ACCURACY:
 Submeter
 PROVEN SOURCE OF ELEVATION:
 CORS, Bridgeport, WV

STATE OF WEST VIRGINIA
 DEPARTMENT OF ENVIRONMENTAL PROTECTION
 OIL AND GAS DIVISION

DATE: May 14 20 25
 OPERATOR'S WELL NO. Schoen 1205 N-1H
 API WELL NO
 47 — 033 — 06001
 STATE COUNTY PERMIT

WELL TYPE: ☐ OIL ☒ GAS ☐ LIQUID INJECTION ☐ WASTE DISPOSAL
 (IF GAS) PRODUCTION : ☐ STORAGE ☐ DEEP ☒ SHALLOW

LOCATION: ELEVATION: 1,407.3' WATERSHED: Middle West Fork Creek
 DISTRICT: Grant / Union
 SURFACE OWNER: George & Rosanne Schoen
 ROYALTY OWNER: Willa Post Robey, et al
 LEASE NO: ACREAGE: 78.20
 PROPOSED WORK: ☐ DRILL ☐ CONVERT ☐ DRILL DEEPER ☐ FRACTURE OR STIMULATE ☐ PLUG OFF OLD FORMATION
☐ PERFORATE NEW FORMATION ☒ OTHER PHYSICAL CHANGE IN WELL (SPECIFY) As-Drilled
☐ PLUG AND ABANDON ☐ CLEAN OUT AND REPLUG TARGET FORMATION: Marcellus Shale ESTIMATED DEPTH: 7,436' TVD 28,890' MD

WELL OPERATOR: HG Energy II Appalachia, LLC
 ADDRESS: 5260 Dupont Road
 Parkersburg, WV 26101

DESIGNATED AGENT: Diane C. White
 ADDRESS: 5260 Dupont Road
 Parkersburg, WV 26101

09/19/2025

HG Energy II
Appalachia, LLC
Well No. Schoen
1205 N-1H As-Drilled

Page 11 of 11




No.	TM / Par	Owner	Bk / Pg	Ac.
81	2005 / 54	Flossie B. Cogis	1247 / 10	0.08
82	2005 / 53	Flossie B. Cogis	1247 / 10	0.17
83	426 / 34.4	Grant-Union Public Service District	1170 / 132	0.03
84	2005 / 48	Flossie B. Cogis	W175 / 144	0.17
85	2005 / 48	Donald J. & Shelly A. Cavalier	1873 / 24	0.12
86	2005 / 36	Robert M. Tangari	1193 / 686	0.40
87	2005 / 24	Robert M. Tangari	1193 / 686	0.10
88	2005 / 13	Robert M. Tangari	1193 / 686	0.09
89	2005 / 1	Robert M. Tangari	1193 / 686	0.08
90	2005 / 50	Mary L. Smith, et al	W177 / 1175	48 SF
91	2005 / 49	Amanda D. Lewis & James A. Newman	1602 / 1229	0.15
92	2005 / 37	Timothy H. Bennett	1398 / 1065	0.12
93	2005 / 25	Timothy H. Bennett	1398 / 1065	0.12
94	2005 / 14	Timothy H. Bennett	1398 / 1065	0.12
95	2005 / 2	Timothy H. Bennett	1398 / 1065	0.11
96	2005 / 51	Timothy H. Bennett	1398 / 1065	0.17
97	2005 / 52	Timothy H. Bennett	1398 / 1065	0.05
98	2005 / 38	Timothy H. Bennett	1398 / 1065	0.09
99	2005 / 26	Timothy H. Bennett	1398 / 1065	0.00
100	2005 / 27	Timothy H. Bennett	1398 / 1065	0.06
101	2005 / 15	Timothy H. Bennett	1398 / 1065	0.11
102	2005 / 3	Timothy H. Bennett	1398 / 1065	0.10
103	2005 / 4	Timothy H. Bennett	1082 / 69	0.18
104	426 / 11	Nancy Sue Greaver	1231 / 836	2.00
105	426 / 10	Judith A. Eaton	1400 / 929	2.73
106	426 / 8	Antonio P. LLC	1503 / 291	19.00
107	426 / 9.1	Rose Belle	1609 / 588	4.30
108	426 / 9	Juliet Rose Belle	1603 / 338	1.38
109	406 / 36.2	Eugene Ray Messer	1819 / 210	0.21
110	406 / 36.1	Walter D. Snider & Rebecca A. Kayser	1348 / 961	1.74
111	406 / 36	Jacob & Nancy Post	1045 / 273	0.90
112	406 / 36.3	Grant-Union Public Service District	1164 / 952	0.03
113	406 / 37.1	Danielle Davisson & Robert Radabaugh	1515 / 979	0.32
114	406 / 37	Gregory & Jaqueline Abraham	1301 / 236	3.54
115	406 / 38	Judith Hayhurst	935 / 9	1.45
116	406 / 24	Clarence Howe Woodford II, et ux	W163/1145	160.49
117	426 / 25	Antonio P., LLC	1503 / 291	14.89
118	426 / 24	Ronald H. & Katherine R. Dever	1436 / 1133	1.76
119	426 / 23	Virginia M. Davisson	1349 / 60	0.62
120	426 / 22	Virginia M. Davisson	1349 / 60	0.37
121	426 / 21	Virginia M. Davisson	1349 / 60	0.75

No.	TM / Par	Owner	Bk / Pg	Ac.
122	406 / 34	Antonio P., LLC	1421 / 1185	0.26
123	406 / 33	Antonio P., LLC	1426 / 36	1.52
124	406 / 31	Antonio P., LLC	1503 / 291	14.65
125	406 / 28	Antonio P., LLC	1503 / 291	176.82
126	406 / 21.5	Monongahela Power Co.	1083 / 210	0.45
127	406 / 21.1	Terry L. & Cathy D. Williams	1662 / 1294	9.66
128	406 / 21.4	Monongahela Power Co.	1083 / 210	2.76
129	406A / 33	James & Megan Kennedy	1594 / 1121	0.43
130	406A / 24	Vincent & Amber Olliverio	1600 / 576	0.23
131	406A / 23	Timothy Ross	1349 / 303	0.23
132	406A / 21	James S. Skinner	1559 / 1053	0.47
133	406A / 22	James S. Skinner	1515 / 519	0.23
134	406A / 7	Charles & Naomi Burkhammer	1506 / 1150	0.46
135	406A / 6	Jerry Hughes	1095 / 649	0.23
136	406A / 13	James & Nancy Karis	1174 / 835	0.23
137	406A / 5	Jerry Hughes	1095 / 649	0.23
138	406A / 14	James & Nancy Karis	1068 / 939	0.23
139	406A / 19	Kathryn M. Fittro	1191 / 555	1.27
140	406A / 35	Harley R. & Linda L. Coberly	1229 / 315	0.79
141	406A / 20	Stephen & Shiela Nelson	1266 / 1097	0.36
142	406A / 1	Ernie & Linda Morgan	1266 / 35	0.35
143	406A / 2	Ernie & Linda Morgan	1266 / 35	0.35
144	406A / 3	David & Nancy Nester	1079 / 620	0.44
145	406A / 4	David & Nancy Nester	1079 / 620	0.42
146	406 / 24.2	Steven & Shanna Bolyard	1558 / 892	0.32
147	406 / 24.1	Steven & Shanna Bolyard	1558 / 892	0.72
148	406 / 22	David L. Scranage & Eva L. Scranage	952 / 204	0.38
149	406 / 22.1	David L. Scranage & Eva L. Scranage	912 / 274	0.46
150	406 / 21.7	Eva L. Scranage	1427 / 565	2.26
151	406 / 21.8	Brian K. & Jayme E. Lowther	1506 / 806	49.53
152	406 / 21	Robert K. Lowther	1427 / 565	17.44
153	406 / 23.1	Monongahela Power Co.	1192 / 644	3.12
154	406 / 23	Roger L. & Teri A. Wilmoth	1332 / 1017	57.94
155	406 / 21.9	Brian K. & Jayme E. Lowther	1652 / 85	6.03
156	406 / 20	Seventh Day Baptist Church	15 / 302	1.00
157	406 / 8	Robert J. Stenger	1621 / 54	166.25
158	406 / 7.13	Michael L. & Ciente V. Bond	1368 / 579	4.26
159	406 / 7.15	Michael L. & Ciente V. Bond	1393 / 1095	4.27
160	406 / 6	Richard K. Williams	1344 / 966	40.12
161	386 / 108	John L. Stenger	1309 / 666	7.44
162	406 / 9	John L. & Mary E. Stenger	1580 / 204	309.00

FILE NO: 32-36-G-19
DRAWING NO: Schoen 1205 N-1H Well Plat
SCALE: 1" = 2000'
MINIMUM DEGREE OF ACCURACY:
Submeter
PROVEN SOURCE OF ELEVATION:
CORS, Bridgeport, WV

STATE OF WEST VIRGINIA
DEPARTMENT OF ENVIRONMENTAL PROTECTION
OIL AND GAS DIVISION

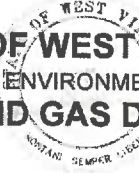

DATE: May 14 20 25
OPERATOR'S WELL NO. Schoen 1205 N-1H
API WELL NO
47 — 033 — 06001
STATE COUNTY PERMIT


WELL TYPE: ☐ OIL ☒ GAS ☐ LIQUID INJECTION ☐ WASTE DISPOSAL
(IF GAS) PRODUCTION: ☐ STORAGE ☐ DEEP ☒ SHALLOW

LOCATION: ELEVATION: 1,407.3' WATERSHED: Middle West Fork Creek
DISTRICT: Grant / Union
SURFACE OWNER: George & Rosanne Schoen
ROYALTY OWNER: Willa Post Robey, et al
PROPOSED WORK: ☐ DRILL ☐ CONVERT ☐ DRILL DEEPER ☐ FRACTURE OR STIMULATE ☐ PLUG OFF OLD FORMATION
☐ PERFORATE NEW FORMATION ☒ OTHER PHYSICAL CHANGE IN WELL (SPECIFY) As-Drilled
☐ PLUG AND ABANDON ☐ CLEAN OUT AND REPLUG TARGET FORMATION: Marcellus Shale ESTIMATED DEPTH: 7,436' TVD 26,890' MD

Top: Mount Clare
Btm: West Milford
COUNTY: Harrison
ACREAGE: 65.00
09/19/2025
ACREAGE: 78.20

WELL OPERATOR: HG Energy II Appalachia, LLC
ADDRESS: 5260 Dupont Road
Parkersburg, WV 26101

DESIGNATED AGENT: Diane C. White
ADDRESS: 5260 Dupont Road
Parkersburg, WV 26101

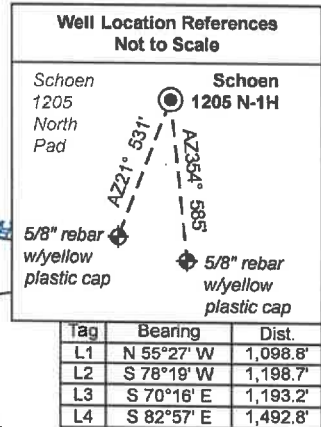






09/19/2025


HG Energy II
Appalachia, LLC
Well No. Schoen
1205 N-1H As-Drilled

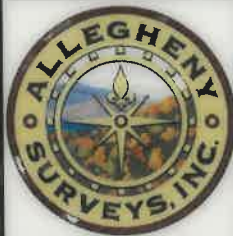


Page 1 of 11

I, the undersigned, hereby certify
that this plat is correct to the best
of my knowledge and belief and
shows all the information required
by law and the rules issued and
prescribed by the Department of
Environmental Protection.

Dwayne D. Matheny, P.S. 2070

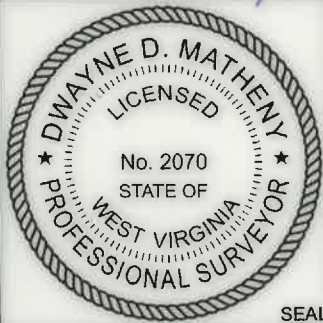

SEAL

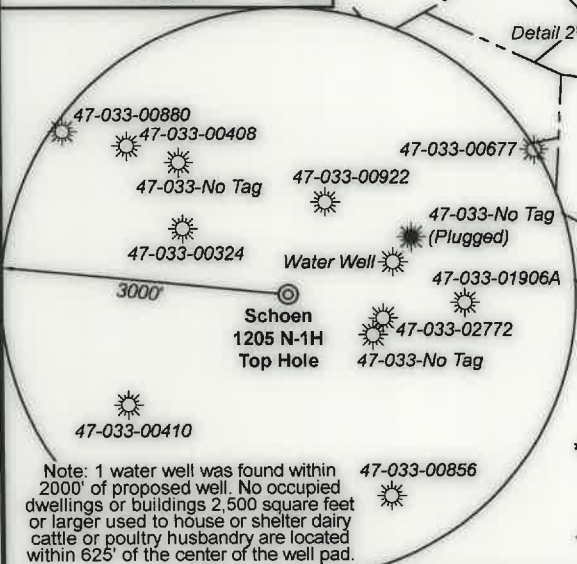

FILE NO: 32-36-G-19

DRAWING NO: Schoen 1205 N-1H Well Plat

SCALE: 1" = 2000'

MINIMUM DEGREE OF ACCURACY:
Submeter

PROVEN SOURCE OF ELEVATION:
CORS, Bridgeport, WV

STATE OF WEST VIRGINIA
DEPARTMENT OF ENVIRONMENTAL PROTECTION
OIL AND GAS DIVISION

DATE: May 14 20 25

OPERATOR'S WELL NO. Schoen 1205 N-1H

API WELL NO

47 - 033 - 06001
STATE COUNTY PERMIT

WELL TYPE: ☐ OIL ☒ GAS ☐ LIQUID INJECTION ☐ WASTE DISPOSAL
(IF GAS) PRODUCTION: ☐ STORAGE ☐ DEEP ☒ SHALLOW

LOCATION: ELEVATION: 1,407.3' WATERSHED: Middle West Fork Creek

DISTRICT: Grant / Union

SURFACE OWNER: George & Rosanne Schoen

ROYALTY OWNER: Willa Post Robey, et al

LEASE NO: ACREAGE: 78.20

PROPOSED WORK: ☐ DRILL ☐ CONVERT ☐ DRILL DEEPER ☐ FRACTURE OR STIMULATE ☐ PLUG OFF OLD FORMATION
☐ PERFORATE NEW FORMATION ☒ OTHER PHYSICAL CHANGE IN WELL (SPECIFY) As-Drilled

☐ PLUG AND ABANDON ☐ CLEAN OUT AND REPLUG TARGET FORMATION: Marcellus Shale ESTIMATED DEPTH: 26,890' MD 7,436' TVD

WELL OPERATOR: HG Energy II Appalachia, LLC

DESIGNATED AGENT: Diane C. White

ADDRESS: 5260 Dupont Road

ADDRESS: 5260 Dupont Road

Parkersburg, WV 26101

Parkersburg, WV 26101

2,470' to Bottom Hole

5,326' to Top Hole

BTM LATITUDE 39 - 12 - 30

TOP LATITUDE 39 - 10 - 00

TOP LONGITUDE 80 - 20 - 00

BTM LONGITUDE 80 - 22 - 30

5,249 to Top Hole

3,804 to Bottom Hole

Wellhead Layout (NTS)

Schoen 1205 N-3H
(API# 47-033-06007)

Schoen 1205 N-2H
(API# 47-033-06000)


Schoen 1205 N-4H
(API# 47-033-06011)

Schoen 1205 N-1H
(API# 47-033-06001)

Schoen 1205 N-5H
(API# 47-033-06009)

Bottom
Hole
7.5'
Spot

Well Location References
Not to Scale

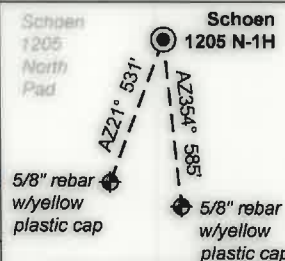

Tag	Bearing	Dist.
L1	N 55°27' W	1,098.8'
L2	S 78°19' W	1,198.7'
L3	S 70°16' E	1,193.2'
L4	S 82°57' E	1,492.8'



ID	Lease
1	Morris Mountaineer Oil & Gas, LLC
2	Locie C. Stout, et al
8	Porter & Bertha B. Maxwell, et al
11	C. H. & Constance Woodford, et al
12	E. S. & Nettie M. Swisher, et al
22	A. W. Smith
24	Hugh C. & Martha L. Davis, et al
28	Lillie Gifford, et al
30	Mary E. Kennedy, et al
31	S. J. Davisson
32	Marcella R. & H. D. Bond, et al
39	Willa Post Robey, et al
45	J. N. Rector, et al
46	Emma A. Waggoner, et al
47	Gregory A. & Jacqueline D. Abraham
48	J. O. & Dorothy H. Butcher
54	H. D. & Emma J. Smith, et al
66	Hattie B. Cummins, et al

Legend	
	Proposed gas well
	Well Reference, as noted
	Monument, as noted
	Existing Well, as noted
	Existing Plugged Well, as noted
	Digitized Well, as noted
	Surface boundary (approx.)
	Interior surface tracts (approx.)
	Creek or Drain
	Existing Road
	Railroad Tracks


West Virginia Coordinate
System of 1927, North Zone
based upon Differential GPS
Measurements.

Notes: Well No.
Schoen 1205 N-1H
WVCS 1927, North Zone
Top Hole Coordinates
Lat: 39°09'08.10"
Lon: 80°21'07.63"
Landing Point Coordinates
Lat: 39°09'00.02"
Lon: 80°21'39.17"
Bottom Hole Coordinates
Lat: 39°11'52.39"
Lon: 80°23'01.39"

UTM Zone 17, NAD 1983
Plat orientation and corner and well references are based
upon the grid north meridian. Well location references are
based upon the magnetic meridian.

Notes: Well No.
Schoen 1205 N-1H
UTM NAD 1983 (USSF)
Top Hole Coordinates
N: 14,218,746.26'
E: 1,824,133.72'
Landing Point Coordinates
N: 14,217,910.97'
E: 1,821,656.41'
Bottom Hole Coordinates
N: 14,235,298.81'
E: 1,815,062.60'

Notes: Well No.
Schoen 1205 N-1H
UTM NAD 1983 (Meters)
Top Hole Coordinates
N: 4,333,882.528m
E: 555,997.070m
Landing Point Coordinates
N: 4,333,627.931m
E: 555,241.984m
Bottom Hole Coordinates
N: 4,338,927.755m
E: 553,232.187m

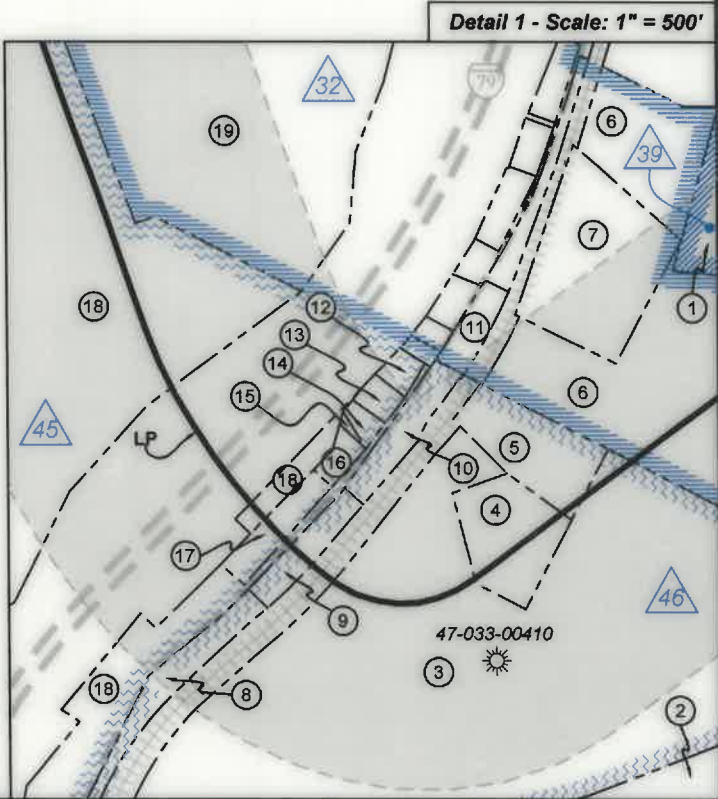

FILE NO: 32-36-G-19
DRAWING NO: Schoen 1205 N-1H Well Plat
SCALE: 1" = 2000'
MINIMUM DEGREE OF ACCURACY:
Submeter
PROVEN SOURCE OF ELEVATION:
CORS, Bridgeport, WV

STATE OF WEST VIRGINIA
DEPARTMENT OF ENVIRONMENTAL PROTECTION
OIL AND GAS DIVISION

DATE: May 14 20 25
OPERATOR'S WELL NO. Schoen 1205 N-1H
API WELL NO
47 - 033 - 06001
STATE COUNTY PERMIT

WELL TYPE: ☐ OIL ☒ GAS ☐ LIQUID INJECTION ☐ WASTE DISPOSAL
(IF GAS) PRODUCTION: ☐ STORAGE ☐ DEEP ☒ SHALLOW

LOCATION: ELEVATION: 1,407.3' WATERSHED: Middle West Fork Creek
DISTRICT: Grant / Union

SURFACE OWNER: George & Rosanne Schoen
ROYALTY OWNER: Willa Post Robey, et al LEASE NO: ACREAGE: 78.20


PROPOSED WORK: ☐ DRILL ☐ CONVERT ☐ DRILL DEEPER ☐ FRACTURE OR STIMULATE ☐ PLUG OFF OLD FORMATION
☐ PERFORATE NEW FORMATION ☒ OTHER PHYSICAL CHANGE IN WELL (SPECIFY) As-Drilled

☐ PLUG AND ABANDON ☐ CLEAN OUT AND REPLUG TARGET FORMATION: Marcellus Shale ESTIMATED DEPTH: 26,890' MD

WELL OPERATOR: HG Energy II Appalachia, LLC DESIGNATED AGENT: Diane C. White
ADDRESS: 5260 Dupont Road ADDRESS: 5260 Dupont Road
Parkersburg, WV 26101 Parkersburg, WV 26101



Detail 2 - Scale: 1" = 500'

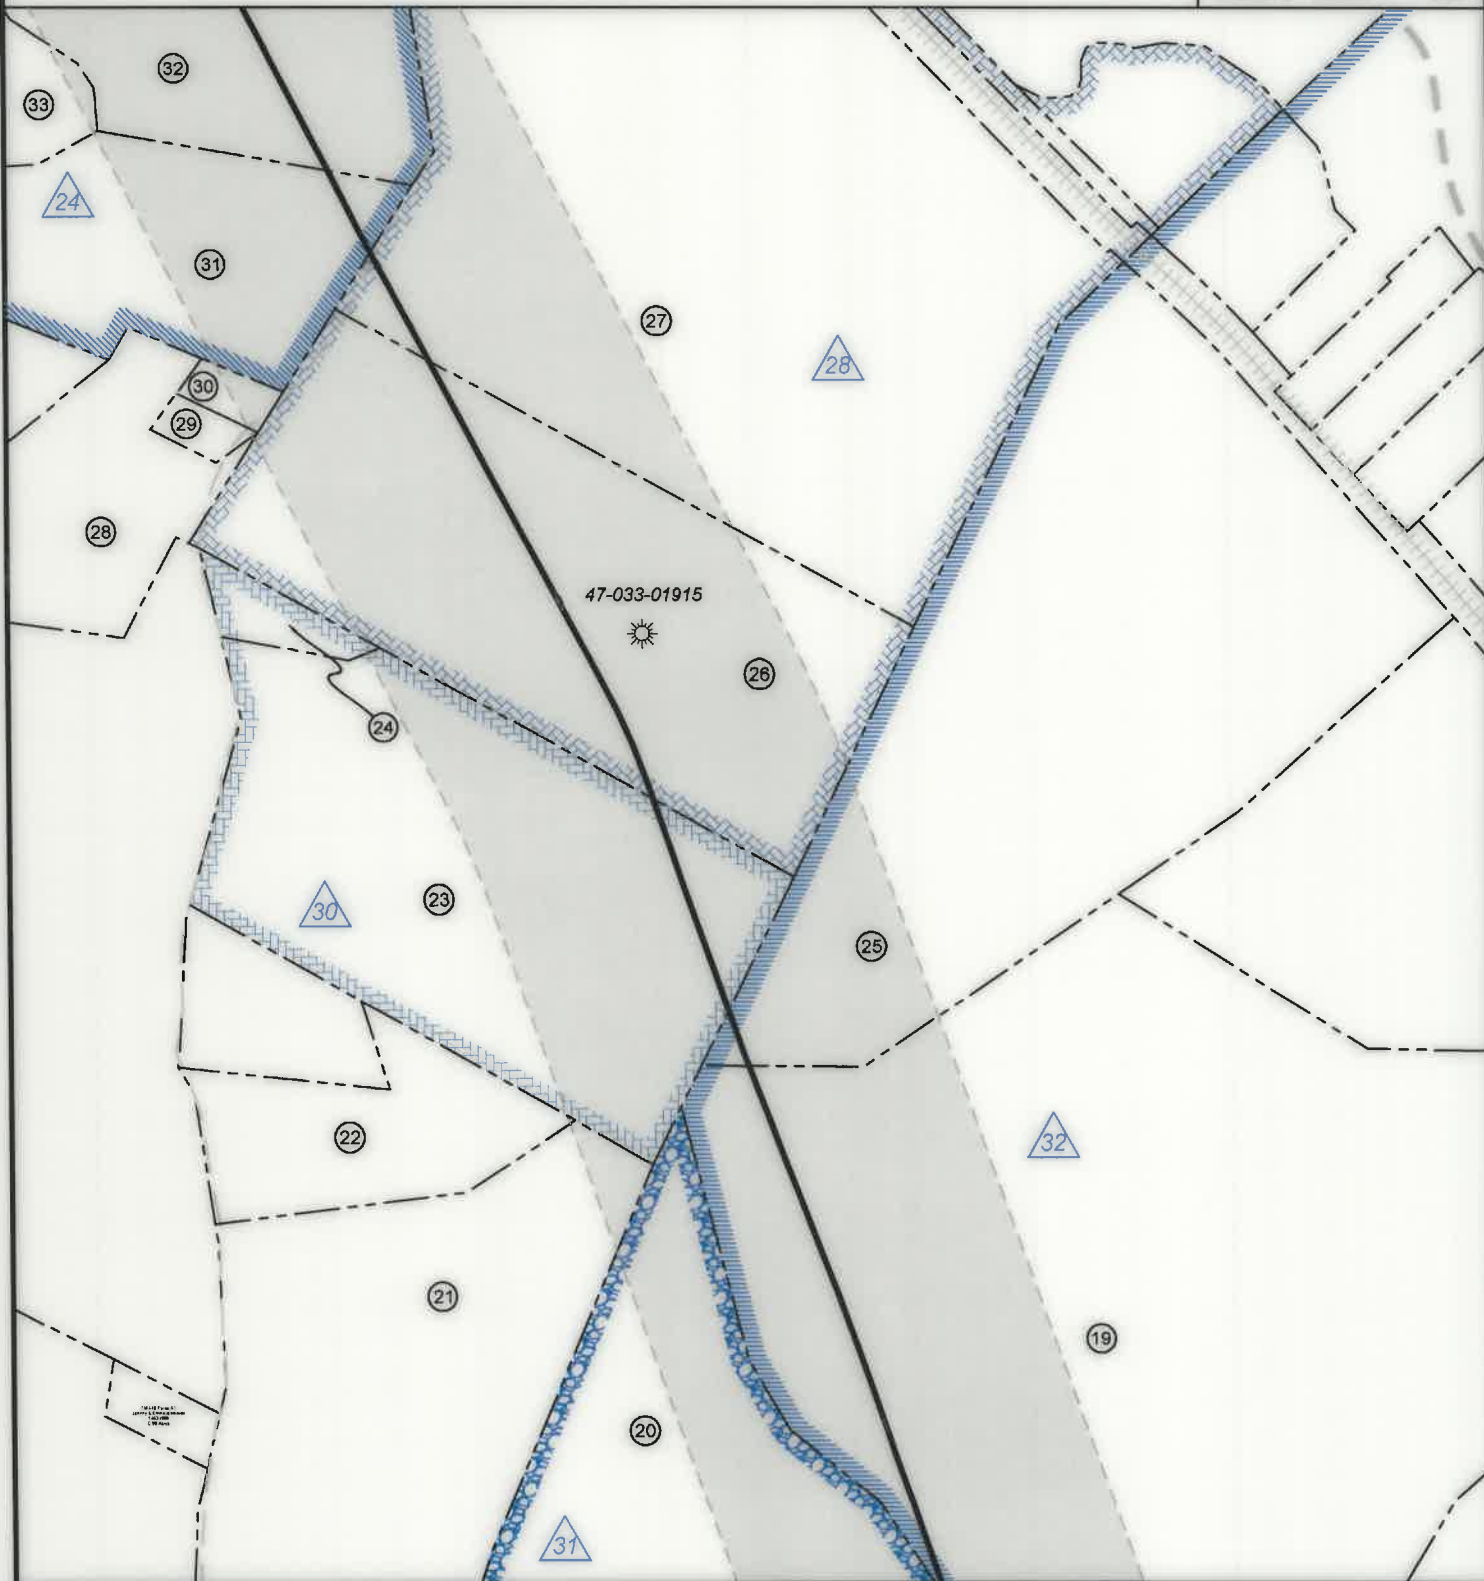

FILE NO: 32-36-G-19
 DRAWING NO: Schoen 1205 N-1H Well Plat
 SCALE: 1" = 2000'
 MINIMUM DEGREE OF ACCURACY:
 Submeter
 PROVEN SOURCE OF ELEVATION:
 CORS, Bridgeport, WV

STATE OF WEST VIRGINIA
 DEPARTMENT OF ENVIRONMENTAL PROTECTION
 OIL AND GAS DIVISION

DATE: May 14 20 25
 OPERATOR'S WELL NO. Schoen 1205 N-1H
 API WELL NO
 47 - 033 - 06001
 STATE COUNTY PERMIT

WELL TYPE: ☐ OIL ☒ GAS ☐ LIQUID INJECTION ☐ WASTE DISPOSAL
 (IF GAS) PRODUCTION: ☐ STORAGE ☐ DEEP ☒ SHALLOW

LOCATION: ELEVATION: 1,407.3' WATERSHED: Middle West Fork Creek

DISTRICT: Grant / Union

SURFACE OWNER: George & Rosanne Schoen

ROYALTY OWNER: Willa Post Robey, et al

LEASE NO: ACREAGE: 78.20

PROPOSED WORK: ☐ DRILL ☐ CONVERT ☐ DRILL DEEPER ☐ FRACTURE OR STIMULATE ☐ PLUG OFF OLD FORMATION
☐ PERFORATE NEW FORMATION ☒ OTHER PHYSICAL CHANGE IN WELL (SPECIFY) As-Drilled

☐ PLUG AND ABANDON ☐ CLEAN OUT AND REPLUG TARGET FORMATION: Marcellus Shale ESTIMATED DEPTH: 7,436' TVD 26,890' MD

WELL OPERATOR: HG Energy II Appalachia, LLC

DESIGNATED AGENT: Diane C. White

ADDRESS: 5260 Dupont Road

ADDRESS: 5260 Dupont Road

Parkersburg, WV 26101

Parkersburg, WV 26101

QUADRANGLE: Top: Mount Clare
 Btm: West Milford


COUNTY: Harrison

ACREAGE: 65.00

09/19/2025



Detail 3 - Scale: 1" = 500'

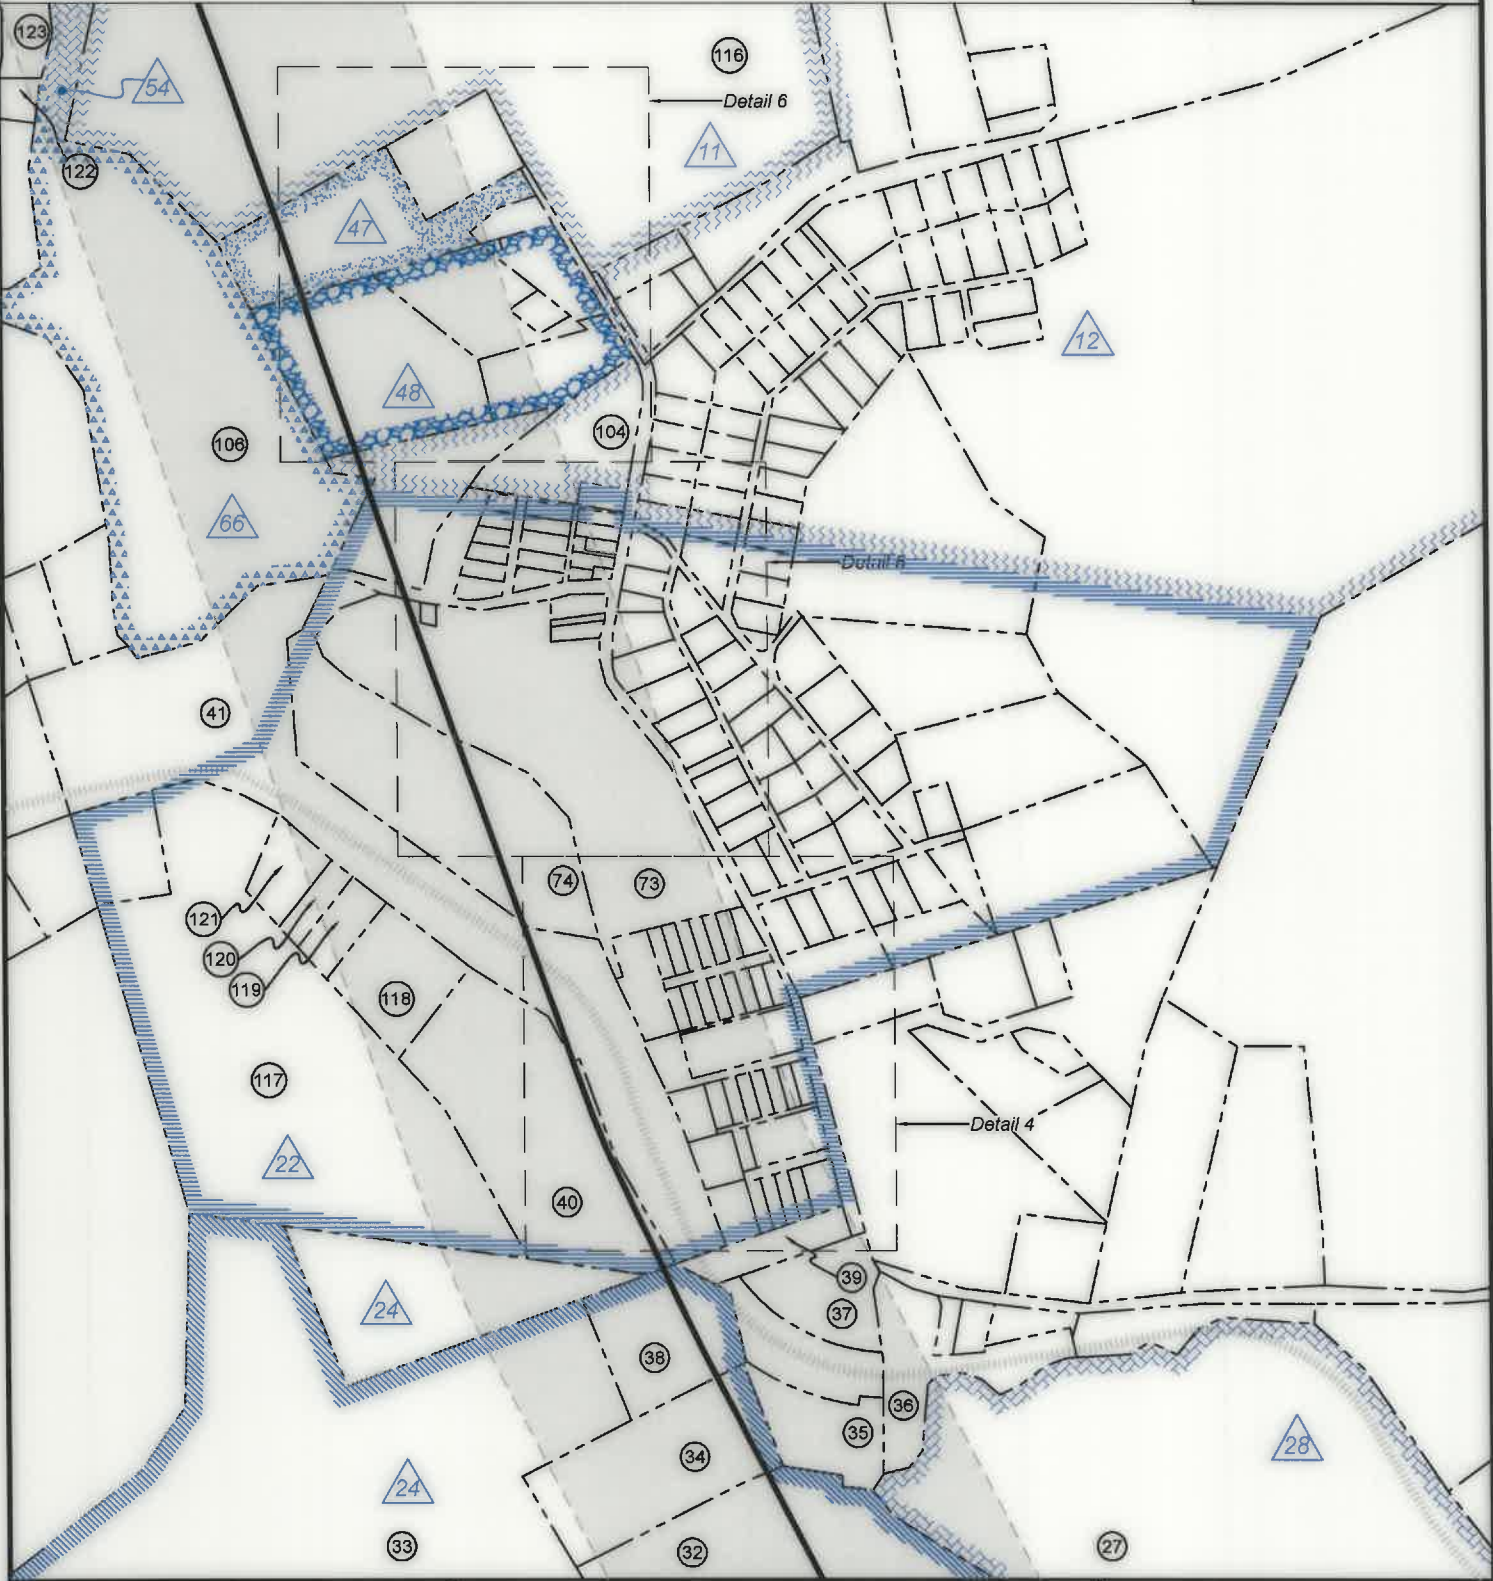

FILE NO: 32-36-G-19
 DRAWING NO: Schoen 1205 N-1H Well Plat
 SCALE: 1" = 2000'
 MINIMUM DEGREE OF ACCURACY:
 Submeter
 PROVEN SOURCE OF ELEVATION:
 CORS, Bridgeport, WV

STATE OF WEST VIRGINIA
 DEPARTMENT OF ENVIRONMENTAL PROTECTION
 OIL AND GAS DIVISION

DATE: May 14 20 25
 OPERATOR'S WELL NO. Schoen 1205 N-1H
 API WELL NO
 47 - 033 - 06001
 STATE COUNTY PERMIT

WELL TYPE: ☐ OIL ☒ GAS ☐ LIQUID INJECTION ☐ WASTE DISPOSAL
 (IF GAS) PRODUCTION: ☐ STORAGE ☐ DEEP ☒ SHALLOW

LOCATION: ELEVATION: 1,407.3' WATERSHED: Middle West Fork Creek

DISTRICT: Grant / Union

SURFACE OWNER: George & Rosanne Schoen

ROYALTY OWNER: Willa Post Robey, et al

LEASE NO: ACREAGE: 78.20

PROPOSED WORK: ☐ DRILL ☐ CONVERT ☐ DRILL DEEPER ☐ FRACTURE OR STIMULATE ☐ PLUG OFF OLD FORMATION
☐ PERFORATE NEW FORMATION ☒ OTHER PHYSICAL CHANGE IN WELL (SPECIFY) As-Drilled

☐ PLUG AND ABANDON ☐ CLEAN OUT AND REPLUG TARGET FORMATION: Marcellus Shale ESTIMATED DEPTH: 26,890' MD

WELL OPERATOR: HG Energy II Appalachia, LLC
 ADDRESS: 5260 Dupont Road
 Parkersburg, WV 26101

DESIGNATED AGENT: Diane C. White
 ADDRESS: 5260 Dupont Road
 Parkersburg, WV 26101

Top: Mount Clare
 Btm: West Milford
 QUADRANGLE: Harris
 COUNTY: Harrison
 ACREAGE: 65.00

09/19/2025



Detail 4 - Scale: NTS'



FILE NO: 32-36-G-19
 DRAWING NO: Schoen 1205 N-1H Well Plat
 SCALE: 1" = 2000'
 MINIMUM DEGREE OF ACCURACY:
 Submeter
 PROVEN SOURCE OF ELEVATION:
 CORS, Bridgeport, WV

STATE OF WEST VIRGINIA
 DEPARTMENT OF ENVIRONMENTAL PROTECTION
 OIL AND GAS DIVISION

DATE: May 14 20 25
 OPERATOR'S WELL NO. Schoen 1205 N-1H
 API WELL NO
 47 - 033 - 06001
 STATE COUNTY PERMIT

WELL TYPE: ☐ OIL ☒ GAS ☐ LIQUID INJECTION ☐ WASTE DISPOSAL
 (IF GAS) PRODUCTION: ☐ STORAGE ☐ DEEP ☒ SHALLOW

LOCATION: ELEVATION: 1,407.3' WATERSHED: Middle West Fork Creek

DISTRICT: Grant / Union

SURFACE OWNER: George & Rosanne Schoen

ROYALTY OWNER: Willa Post Robey, et al

LEASE NO: ACREAGE: 78.20

PROPOSED WORK: ☐ DRILL ☐ CONVERT ☐ DRILL DEEPER ☐ FRACTURE OR STIMULATE ☐ PLUG OFF OLD FORMATION
☐ PERFORATE NEW FORMATION ☒ OTHER PHYSICAL CHANGE IN WELL (SPECIFY) As-Drilled

☐ PLUG AND ABANDON ☐ CLEAN OUT AND REPLUG TARGET FORMATION: Marcellus Shale ESTIMATED DEPTH: 26,890' MD


Top: Mount Clare
 Btm: West Milford
 QUADRANGLE:
 COUNTY: Harrison
 ACREAGE: 65.00

WELL OPERATOR: HG Energy II Appalachia, LLC
 ADDRESS: 5260 Dupont Road
 Parkersburg, WV 26101

DESIGNATED AGENT: Diane C. White
 ADDRESS: 5260 Dupont Road
 Parkersburg, WV 26101



Detail 5 - Scale: NTS'

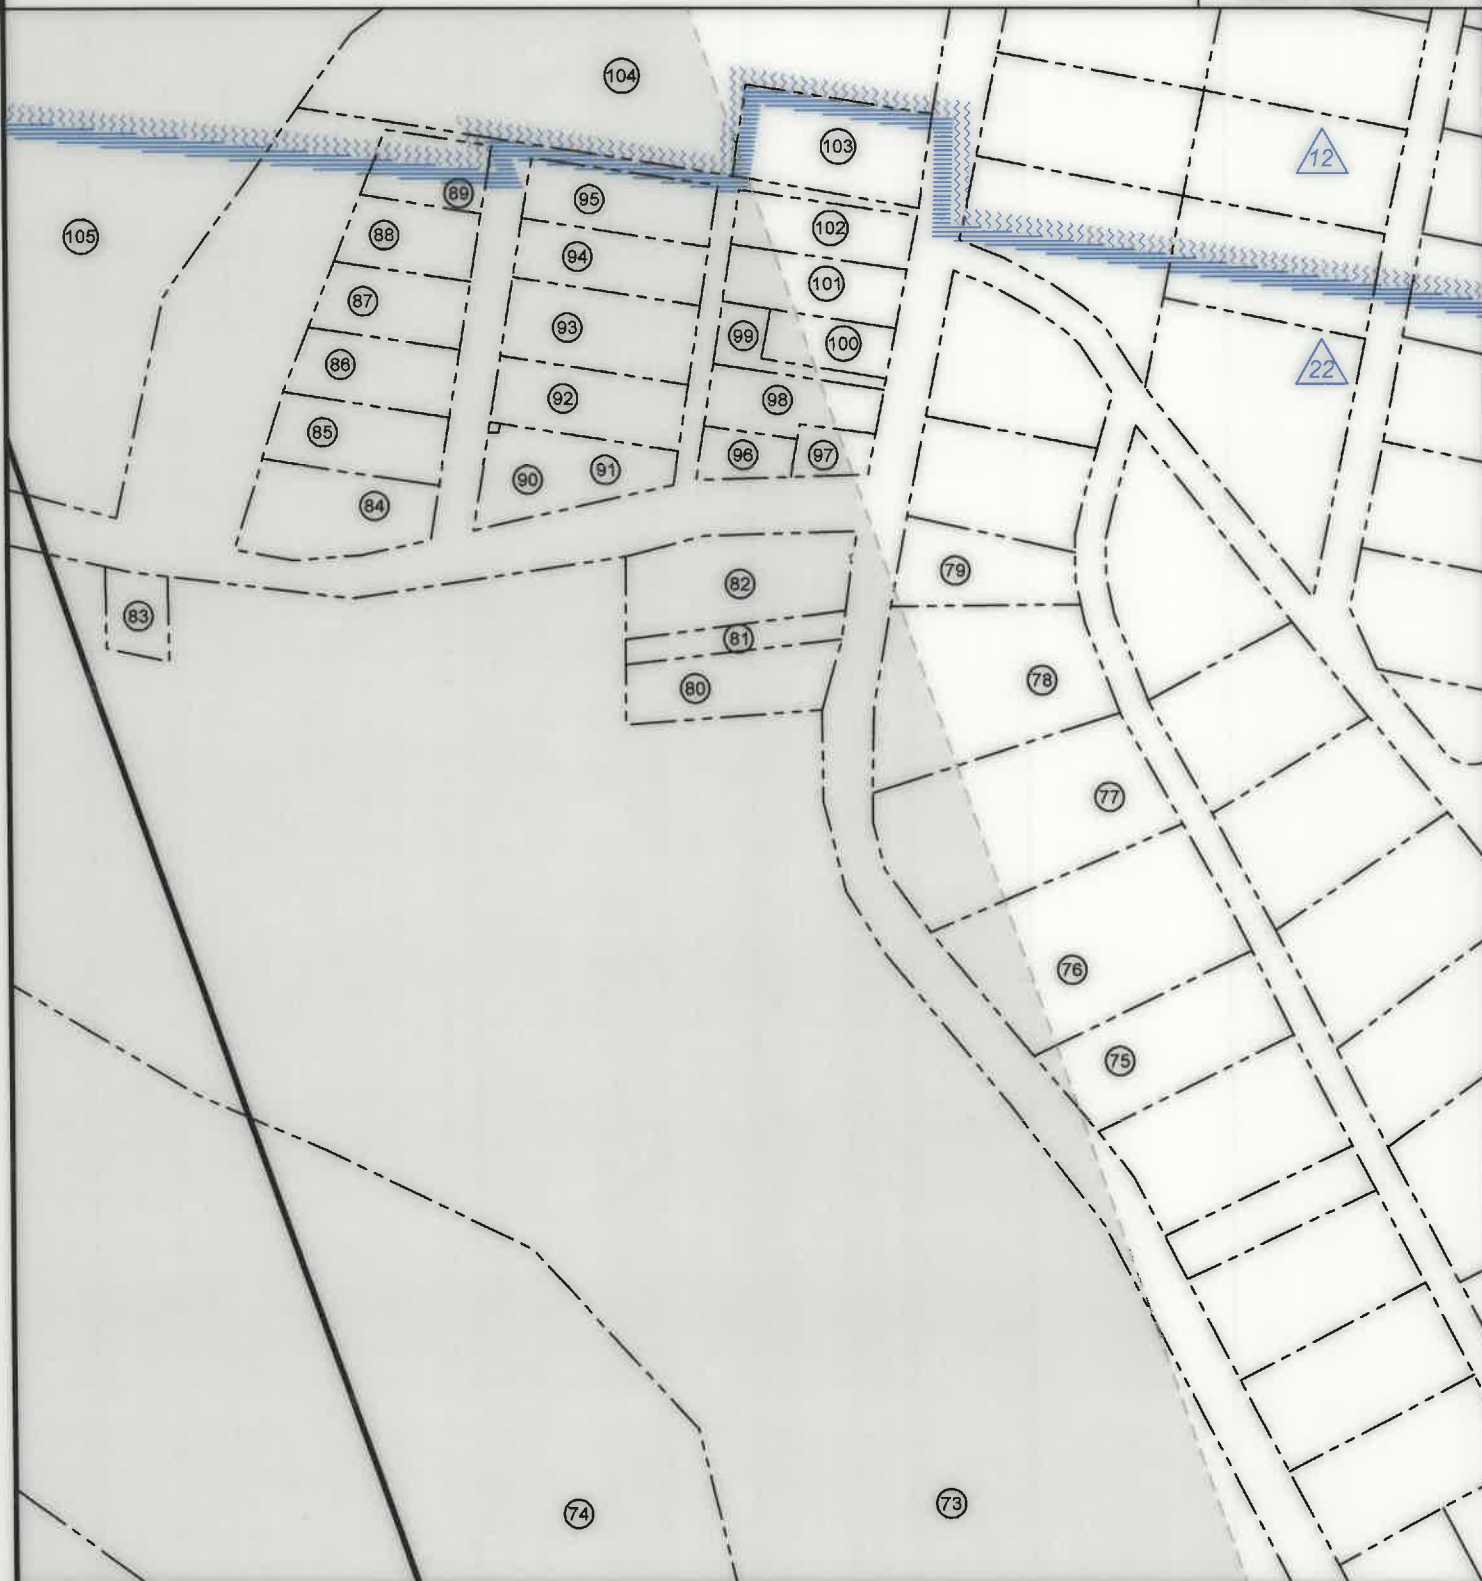

FILE NO: 32-36-G-19
 DRAWING NO: Schoen 1205 N-1H Well Plat
 SCALE: 1" = 2000'
 MINIMUM DEGREE OF ACCURACY:
 Submeter
 PROVEN SOURCE OF ELEVATION:
 CORS, Bridgeport, WV

STATE OF WEST VIRGINIA
 DEPARTMENT OF ENVIRONMENTAL PROTECTION
 OIL AND GAS DIVISION

DATE: May 14 20 25
 OPERATOR'S WELL NO. Schoen 1205 N-1H
 API WELL NO
 47 - 033 - 06001
 STATE COUNTY PERMIT

WELL TYPE: ☐ OIL ☒ GAS ☐ LIQUID INJECTION ☐ WASTE DISPOSAL
 (IF GAS) PRODUCTION: ☐ STORAGE ☐ DEEP ☒ SHALLOW

LOCATION: ELEVATION: 1,407.3' WATERSHED: Middle West Fork Creek

DISTRICT: Grant / Union

SURFACE OWNER: George & Rosanne Schoen

ROYALTY OWNER: Willa Post Robey, et al

LEASE NO: ACREAGE: 78.20

PROPOSED WORK: ☐ DRILL ☐ CONVERT ☐ DRILL DEEPER ☐ FRACTURE OR STIMULATE ☐ PLUG OFF OLD FORMATION
☐ PERFORATE NEW FORMATION ☒ OTHER PHYSICAL CHANGE IN WELL (SPECIFY) As-Drilled

☐ PLUG AND ABANDON ☐ CLEAN OUT AND REPLUG TARGET FORMATION: Marcellus Shale ESTIMATED DEPTH: 26,890' MD

Top: Mount Clare
 Btm: West Milford
 QUADRANGLE:
 COUNTY: Harrison
 ACREAGE: 65.00

WELL OPERATOR: HG Energy II Appalachia, LLC


DESIGNATED AGENT: Diane C. White

ADDRESS: 5260 Dupont Road
 Parkersburg, WV 26101

ADDRESS: 5260 Dupont Road
 Parkersburg, WV 26101




Detail 6 - Scale: NTS'

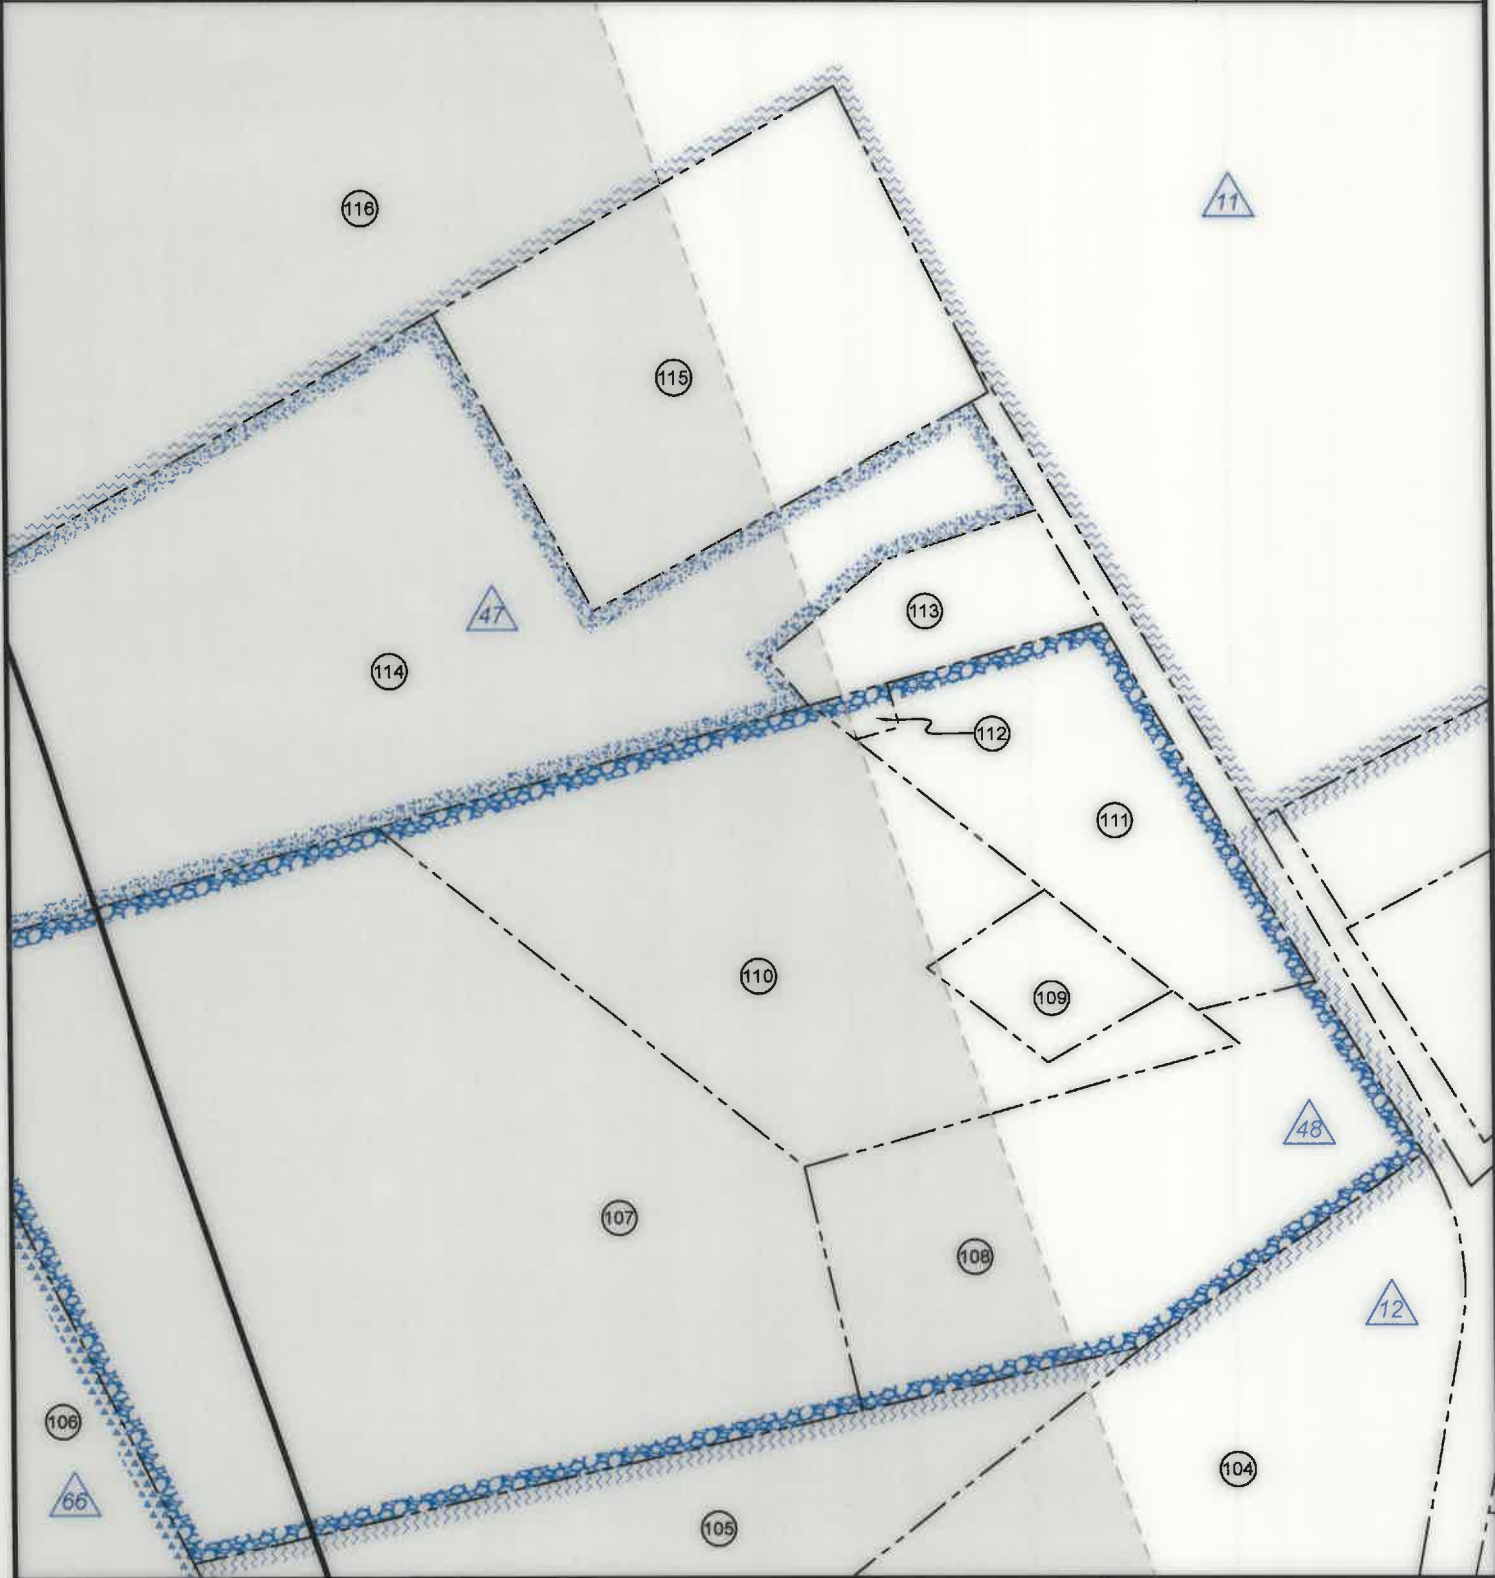

FILE NO: 32-36-G-19 DRAWING NO: Schoen 1205 N-1H Well Plat SCALE: 1" = 2000' MINIMUM DEGREE OF ACCURACY: Submeter PROVEN SOURCE OF ELEVATION: CORS, Bridgeport, WV	 STATE OF WEST VIRGINIA DEPARTMENT OF ENVIRONMENTAL PROTECTION OIL AND GAS DIVISION	DATE: May 14 2025 OPERATOR'S WELL NO. Schoen 1205 N-1H API WELL NO 47 - 033 - 06001 STATE COUNTY PERMIT
WELL TYPE: ☐ OIL ☒ GAS ☐ LIQUID INJECTION ☐ WASTE DISPOSAL (IF GAS) PRODUCTION: ☐ STORAGE ☐ DEEP ☒ SHALLOW		
LOCATION: ELEVATION: 1,407.3' WATERSHED: Middle West Fork Creek DISTRICT: Grant / Union SURFACE OWNER: George & Rosanne Schoen ROYALTY OWNER: Willa Post Robey, et al LEASE NO: ACREAGE: 78.20		Top: Mount Clare Btm: West Milford QUADRANGLE: Harrison COUNTY: Harrison ACREAGE: 65.00
PROPOSED WORK: ☐ DRILL ☐ CONVERT ☐ DRILL DEEPER ☐ FRACTURE OR STIMULATE ☐ PLUG OFF OLD FORMATION ☐ PERFORATE NEW FORMATION ☒ OTHER PHYSICAL CHANGE IN WELL (SPECIFY) As-Drilled 7,436' TVD ☐ PLUG AND ABANDON ☐ CLEAN OUT AND REPLUG TARGET FORMATION: Marcellus Shale ESTIMATED DEPTH: 26,890' MD		
WELL OPERATOR: HG Energy II Appalachia, LLC DESIGNATED AGENT: Diane C. White ADDRESS: 5260 Dupont Road ADDRESS: 5260 Dupont Road Parkersburg, WV 26101 Parkersburg, WV 26101		



Detail 7 - Scale: 1" = 500'

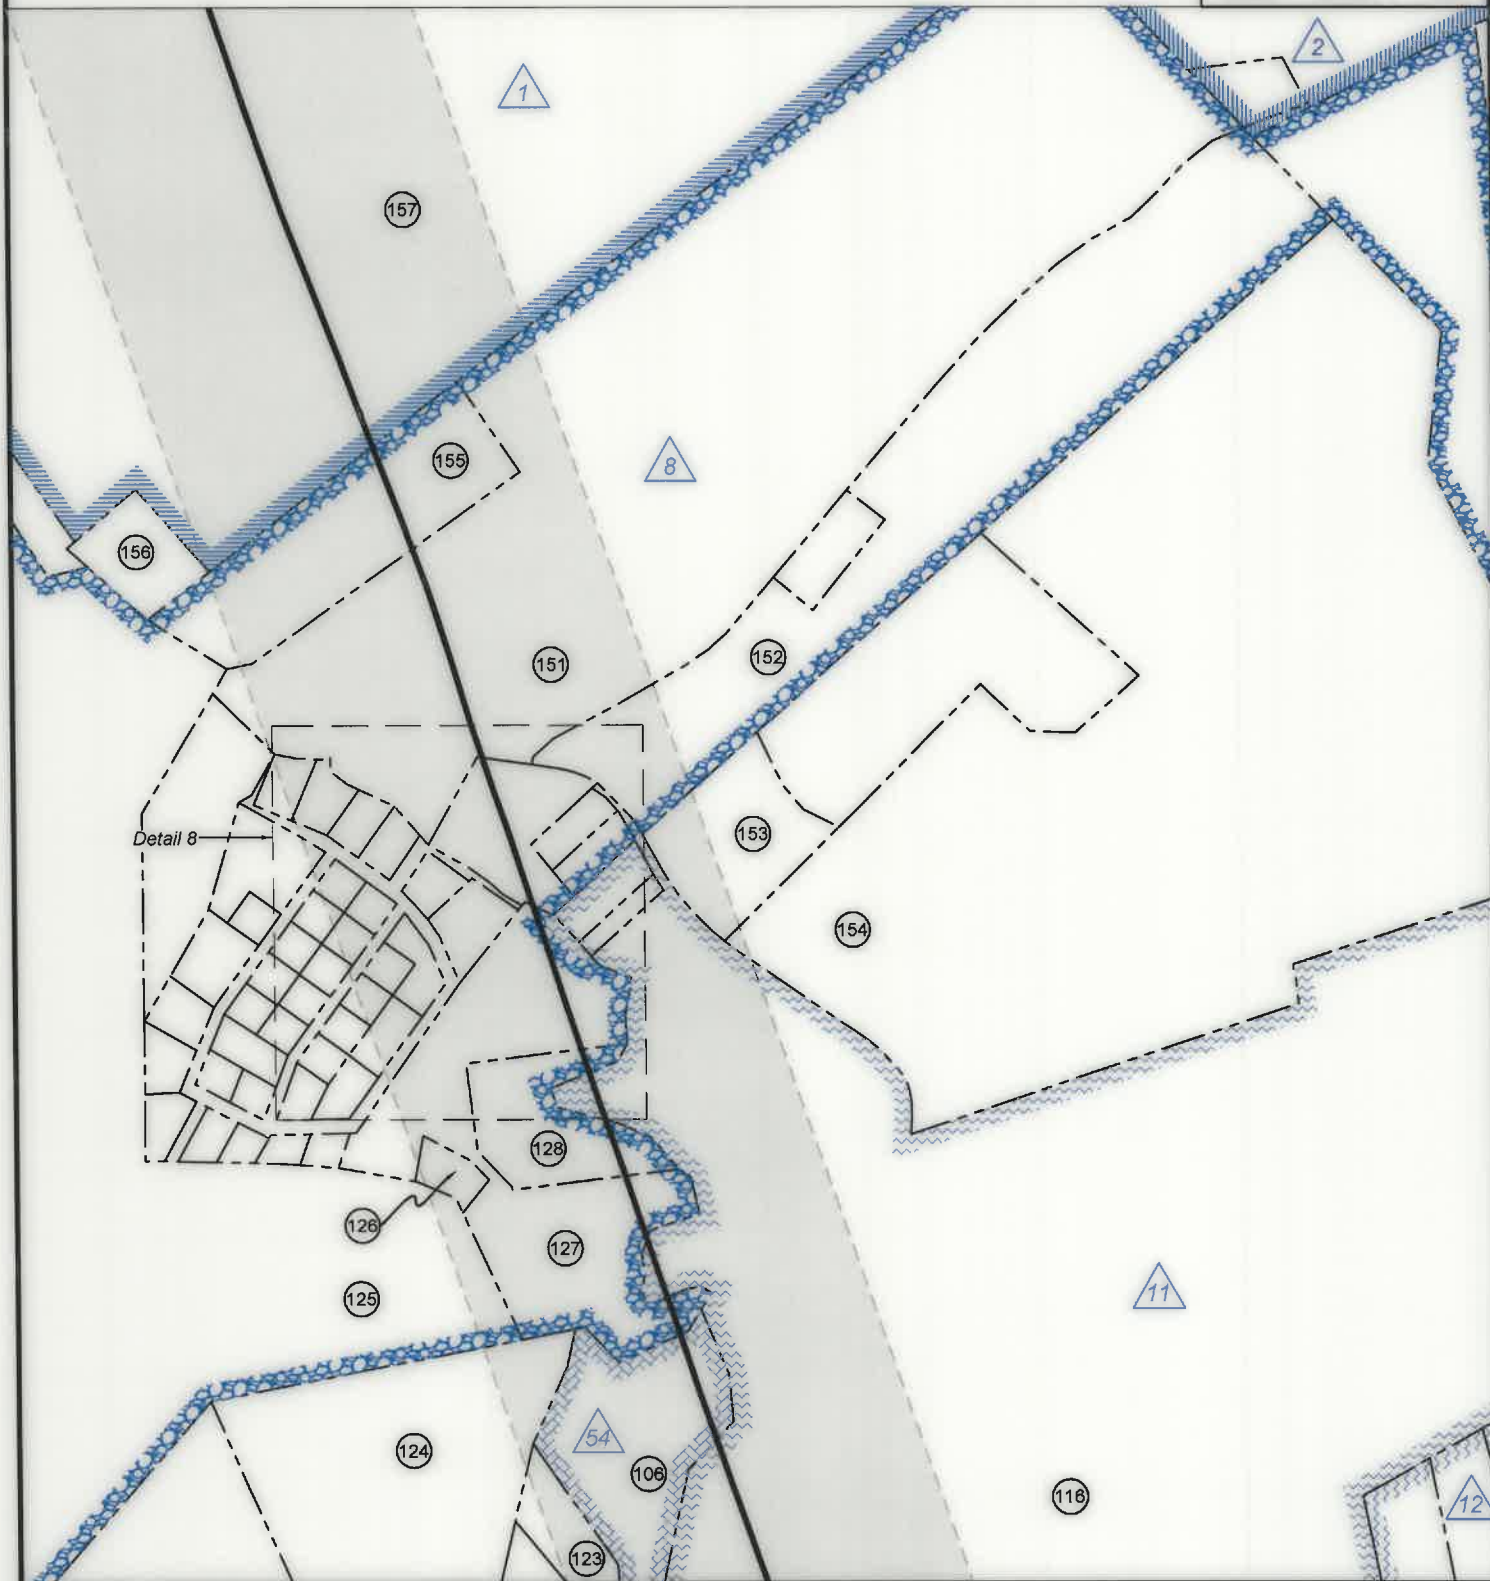

FILE NO: 32-36-G-19
 DRAWING NO: Schoen 1205 N-1H Well Plat
 SCALE: 1" = 2000'
 MINIMUM DEGREE OF ACCURACY:
 Submeter
 PROVEN SOURCE OF ELEVATION:
 CORS, Bridgeport, WV

STATE OF WEST VIRGINIA
 DEPARTMENT OF ENVIRONMENTAL PROTECTION
 OIL AND GAS DIVISION

DATE: May 14 20 25
 OPERATOR'S WELL NO. Schoen 1205 N-1H
 API WELL NO
 47 - 033 - 06001
 STATE COUNTY PERMIT

WELL TYPE: ☐ OIL ☒ GAS ☐ LIQUID INJECTION ☐ WASTE DISPOSAL
 (IF GAS) PRODUCTION: ☐ STORAGE ☐ DEEP ☒ SHALLOW

LOCATION: ELEVATION: 1,407.3' WATERSHED: Middle West Fork Creek

DISTRICT: Grant / Union

SURFACE OWNER: George & Rosanne Schoen

ROYALTY OWNER: Willa Post Robey, et al

LEASE NO: ACREAGE: 78.20

PROPOSED WORK: ☐ DRILL ☐ CONVERT ☐ DRILL DEEPER ☐ FRACTURE OR STIMULATE ☐ PLUG OFF OLD FORMATION
☐ PERFORATE NEW FORMATION ☒ OTHER PHYSICAL CHANGE IN WELL (SPECIFY) As-Drilled

☐ PLUG AND ABANDON ☐ CLEAN OUT AND REPLUG TARGET FORMATION: Marcellus Shale ESTIMATED DEPTH: 26,890' MD

Top: Mount Clare
 Btm: West Milford
 QUADRANGLE:
 COUNTY: Harrison
 ACREAGE: 65.00

WELL OPERATOR: HG Energy II Appalachia, LLC

DESIGNATED AGENT: Diane C. White

ADDRESS: 5260 Dupont Road

ADDRESS: 5260 Dupont Road

Parkersburg, WV 26101

Parkersburg, WV 26101



Detail 8 - Scale: NTS'



FILE NO: 32-36-G-19
 DRAWING NO: Schoen 1205 N-1H Well Plat
 SCALE: 1" = 2000'
 MINIMUM DEGREE OF ACCURACY:
 Submeter
 PROVEN SOURCE OF ELEVATION:
 CORS, Bridgeport, WV

STATE OF WEST VIRGINIA
 DEPARTMENT OF ENVIRONMENTAL PROTECTION
 OIL AND GAS DIVISION

DATE: May 14 20 25
 OPERATOR'S WELL NO. Schoen 1205 N-1H
 API WELL NO
 47 - 033 - 06001
 STATE COUNTY PERMIT

WELL TYPE: ☐ OIL ☒ GAS ☐ LIQUID INJECTION ☐ WASTE DISPOSAL
 (IF GAS) PRODUCTION: ☐ STORAGE ☐ DEEP ☒ SHALLOW

LOCATION: ELEVATION: 1,407.3' WATERSHED: Middle West Fork Creek

DISTRICT: Grant / Union

SURFACE OWNER: George & Rosanne Schoen

ROYALTY OWNER: Willa Post Robey, et al

LEASE NO: ACREAGE: 78.20

PROPOSED WORK: ☐ DRILL ☐ CONVERT ☐ DRILL DEEPER ☐ FRACTURE OR STIMULATE ☐ PLUG OFF OLD FORMATION
☐ PERFORATE NEW FORMATION ☒ OTHER PHYSICAL CHANGE IN WELL (SPECIFY) As-Drilled

☐ PLUG AND ABANDON ☐ CLEAN OUT AND REPLUG TARGET FORMATION: Marcellus Shale ESTIMATED DEPTH: 7,436' TVD 26,890' MD

Top: Mount Clare
 Btm: West Milford
 QUADRANGLE:
 COUNTY: Harrison
 ACREAGE: 65.00

WELL OPERATOR: HG Energy II Appalachia, LLC
 ADDRESS: 5260 Dupont Road
 Parkersburg, WV 26101

DESIGNATED AGENT: Diane C. White
 ADDRESS: 5260 Dupont Road
 Parkersburg, WV 26101



No.	TM / Par	Owner	Bk / Pg	Ac.
1	447 / 2	George & Roseanne Schoen	1148 / 1059	65.00
2	446 / 29	John F. McCuskey II, et al	1121 / 25	75.00
3	446 / 28.2	David D. Vanhorn (LE), et al	W177 / 92	42.66
4	446 / 28.4	Bradford Vanhorn	1381 / 1181	1.52
5	446 / 28.5	Robert L. Vanhorn	1352 / 91	1.52
6	446 / 15	Vera E. & Oral K. Haught	1582 / 896	14.40
7	446 / 12	Marilyn Gaines	1192 / 300	2.93
8	446 / 28.1	Andrew Schrader & Melinda Davis	1478 / 252	0.45
9	446 / 28.3	Sharon Willie	1349 / 1253	0.45
10	446 / 28	Larry E. Wilson II	1344 / 1211	0.57
11	446 / 15.1	David & Grace Hughes	1257 / 694	0.31
12	446 / 26.1	Robert Mendez Jr.	1435 / 330	0.18
13	446 / 24.5	Lester L. Cook Sr.	1364 / 265	0.21
14	446 / 24.1	Brooke & Lillie Swisher	1432 / 856	0.15
15	446 / 24.4	Brooke & Lillie Swisher	1432 / 856	0.03
16	446 / 24.2	Daniel Frazier (LE)	W165 / 1065	0.20
17	446 / 24.3	Mark & Karen Wilt	1157 / 579	0.58
18	446 / 24	Robert N. Rector (LE)	1621 / 719	82.90
19	446 / 7	James R. & Sharon L. Allman	1437 / 165	91.79
20	446 / 6	Robert N. Rector (LE)	1621 / 719	49.33
21	446 / 5	Kathy D. Bennett	W184 / 51	20.83
22	426 / 76	Ethan Stonko	1622 / 771	7.00
23	426 / 77	Kenneth E. Rigdon	1569 / 903	28.26
24	426 / 64	Eugene Alkire Jr.	1271 / 1183	2.00
25	426 / 66	Michael W. & Robert D. Rector	1621 / 719	41.75
26	426 / 65	G. Thomas Smith	1277 / 1174	29.79
27	426 / 50	G. Thomas Smith	1277 / 1174	66.80
28	426 / 42	Cathleen Spittler (LE), et al	1405 / 449	11.69
29	426 / 42.1	Andrew D. & Sarah N. Spittler	1669 / 645	0.57
30	426 / 43.1	Andrew D. & Sarah N. Spittler	1669 / 645	0.62
31	426 / 44	AL-N-EL Farms, LLC	1623 / 1057	17.73
32	426 / 45	Constance & Gary I. Saunders II	1591 / 100	12.43
33	426 / 40	AL-N-EL Farms, LLC	1623 / 1057	57.97
34	426 / 46	Constance & Gary I. Saunders II	1591 / 100	4.00
35	426 / 47	Constance & Gary I. Saunders II	1591 / 100	1.00
36	426 / 48.2	John E. Messenger	1351 / 206	2.19
37	426 / 29	Daniel R. & Lana M. Messenger	1194 / 1027	1.50
38	426 / 28	Constance & Gary I. Saunders II	1591 / 100	2.32
39	426 / 30	Daniel R. & Lana M. Messenger	1151 / 210	0.82
40	426 / 26	David L. Bowles	1518 / 1298	6.05

No.	TM / Par	Owner	Bk / Pg	Ac.
41	426 / 27	Antonio P., LLC	1503 / 291	6.53
42	2005 / 68	Wilma L. & George W. Bennett, III	1655 / 43	0.43
43	2005 / 62	George W. Bennett Jr.	W149 / 468	0.14
44	2005 / 63	George W. Bennett Jr.	W149 / 468	0.13
45	2005 / 64	James L. & Margie H. Fultineer	1340 / 1154	0.12
46	2005 / 65	James L. & Margie H. Fultineer	1340 / 1154	0.12
47	2005 / 67	Daniel M. & Nita M. Richards	1619 / 832	0.29
48	2005 / 69	Wilma L. & George W. Bennett, III	1169 / 953	0.31
49	2005 / 56	Kathy D. Bennett	1374 / 379	0.11
50	2005 / 61	Kathy D. Bennett	1380 / 737	0.55
51	2005 / 70	Grant-Union Public Service District	1169 / 953	0.31
52	2005 / 39	Kathy D. Bennett	1281 / 712	0.11
53	2005 / 40	Kathy D. Bennett	1281 / 712	0.11
54	2005 / 41	Kathy D. Bennett	1281 / 712	0.11
55	2005 / 42	Kathy D. Bennett	1281 / 712	0.11
56	2005 / 43	Kathy D. Bennett	1281 / 712	0.11
57	2005 / 44	Kathy D. Bennett	1281 / 712	0.11
58	2005 / 71	Brenda Withers	1374 / 1062	0.32
59	2005 / 33	Brenda R. Withers & Mary V. Hayes	1344 / 136	0.88
60	2005 / 5	Michael A. Wright (Lots 30-44)	1626 / 1172	2.47
61	2005 / 16	Michael A. Wright	1626 / 1172	Lot 37
62	2005 / 17	Michael A. Wright	1626 / 1172	Lot 36
63	2005 / 18	Michael A. Wright	1626 / 1172	Lot 35
64	2005 / 19	Michael A. Wright	1626 / 1172	Lot 34
65	2005 / 20	Michael A. Wright	1626 / 1172	Lot 33
66	2005 / 21	Michael A. Wright	1626 / 1172	Lot 32
67	2005 / 6	Michael A. Wright	1626 / 1172	Lot 44
68	2005 / 7	Michael A. Wright	1626 / 1172	Lot 43
69	2005 / 8	Michael A. Wright	1626 / 1172	Lot 42
70	2005 / 9	Michael A. Wright	1626 / 1172	Lot 41
71	2005 / 10	Michael A. Wright	1626 / 1172	Lot 40
72	2005 / 11	Michael A. Wright	1626 / 1172	Lot 39
73	426 / 34.1	Jacob D. & Nancy L. Post	1023 / 150	9.27
74	426 / 20	Grafton Coal Company	1016 / 223	6.00
75	2015 / 78	Quintin J. Moore & Lora K. Varner	1602 / 451	0.28
76	2015 / 79	William R. Reed Jr.	1403 / 601	0.33
77	2015 / 80	Thomas M. Tice & Michelle L. Liptak	1319 / 1062	0.36
78	2015 / 81	Jesse D. Garrett	1403 / 1133	0.29
79	2015 / 82	John & Mary R. Miller	1397 / 1177	0.22
80	2005 / 55	Gale L. & Melissa A. Zickefoose	1475 / 318	0.12

FILE NO: 32-36-G-19

DRAWING NO: Schoen 1205 N-1H Well Plat

SCALE: 1" = 2000'

MINIMUM DEGREE OF ACCURACY:
 Submeter

PROVEN SOURCE OF ELEVATION:
 CORS, Bridgeport, WV

STATE OF WEST VIRGINIA
 DEPARTMENT OF ENVIRONMENTAL PROTECTION
 OIL AND GAS DIVISION

DATE: May 14 20 25

OPERATOR'S WELL NO: Schoen 1205 N-1H

API WELL NO

47 — 033 — 06001
 STATE COUNTY PERMIT

WELL TYPE: ☐ OIL ☒ GAS ☐ LIQUID INJECTION ☐ WASTE DISPOSAL
 (IF GAS) PRODUCTION: ☐ STORAGE ☐ DEEP ☒ SHALLOW

LOCATION: ELEVATION: 1,407.3' WATERSHED: Middle West Fork Creek

DISTRICT: Grant / Union

SURFACE OWNER: George & Rosanne Schoen

ROYALTY OWNER: Willa Post Robey, et al

LEASE NO: ACREAGE: 78.20

PROPOSED WORK: ☐ DRILL ☐ CONVERT ☐ DRILL DEEPER ☐ FRACTURE OR STIMULATE ☐ PLUG OFF OLD FORMATION
☐ PERFORATE NEW FORMATION ☒ OTHER PHYSICAL CHANGE IN WELL (SPECIFY) As-Drilled

☐ PLUG AND ABANDON ☐ CLEAN OUT AND REPLUG TARGET FORMATION: Marcellus Shale ESTIMATED DEPTH: 26,890' MD

WELL OPERATOR: HG Energy II Appalachia, LLC

DESIGNATED AGENT: Diane C. White

ADDRESS: 5260 Dupont Road

ADDRESS: 5260 Dupont Road

Parkersburg, WV 26101

Parkersburg, WV 26101

Top: Mount Clare
 Btm: West Milford

QUADRANGLE: Harrison

COUNTY: Harrison

ACREAGE: 65.00

09/19/2025

7,436' TVD



No.	TM / Par	Owner	Bk / Pg	Ac.
81	2005 / 54	Flossie B. Cogis	1247 / 10	0.08
82	2005 / 53	Flossie B. Cogis	1247 / 10	0.17
83	426 / 34.4	Grant-Union Public Service District	1170 / 132	0.03
84	2005 / 46	Flossie B. Cogis	W175 / 144	0.17
85	2005 / 48	Donald J. & Shelly A. Cavalier	1673 / 24	0.12
86	2005 / 36	Robert M. Tangari	1193 / 686	0.40
87	2005 / 24	Robert M. Tangari	1193 / 686	0.10
88	2005 / 13	Robert M. Tangari	1193 / 686	0.09
89	2005 / 1	Robert M. Tangari	1193 / 686	0.08
90	2005 / 50	Mary L. Smith, et al	W177 / 1175	48 SF
91	2005 / 49	Amanda D. Lewis & James A. Newman	1602 / 1229	0.15
92	2005 / 37	Timothy H. Bennett	1398 / 1065	0.12
93	2005 / 25	Timothy H. Bennett	1398 / 1065	0.12
94	2005 / 14	Timothy H. Bennett	1398 / 1065	0.12
95	2005 / 2	Timothy H. Bennett	1398 / 1065	0.11
96	2005 / 51	Timothy H. Bennett	1398 / 1065	0.17
97	2005 / 52	Timothy H. Bennett	1398 / 1065	0.05
98	2005 / 38	Timothy H. Bennett	1398 / 1065	0.09
99	2005 / 26	Timothy H. Bennett	1398 / 1065	0.00
100	2005 / 27	Timothy H. Bennett	1398 / 1065	0.06
101	2005 / 15	Timothy H. Bennett	1398 / 1065	0.11
102	2005 / 3	Timothy H. Bennett	1398 / 1065	0.10
103	2005 / 4	Timothy H. Bennett	1082 / 69	0.16
104	426 / 11	Nancy Sue Greaver	1231 / 836	2.00
105	426 / 10	Judith A. Eaton	1400 / 929	2.73
106	426 / 8	Antonio P. LLC	1503 / 291	19.00
107	426 / 9.1	Rose Belle	1609 / 568	4.30
108	426 / 9	Juliet Rose Belle	1603 / 338	1.38
109	406 / 36.2	Eugene Ray Messer	1619 / 210	0.21
110	406 / 36.1	Walter D. Snider & Rebecca A. Kayser	1346 / 961	1.74
111	406 / 36	Jacob & Nancy Post	1045 / 273	0.90
112	406 / 36.3	Grant-Union Public Service District	1164 / 952	0.03
113	406 / 37.1	Danielle Davisson & Robert Radabaugh	1515 / 979	0.32
114	406 / 37	Gregory & Jaqueline Abraham	1301 / 236	3.54
115	406 / 38	Judith Hayhurst	935 / 9	1.45
116	406 / 24	Clarence Howe Woodford II, et ux	W163/1145	160.49
117	426 / 25	Antonio P., LLC	1503 / 291	14.89
118	426 / 24	Ronald H. & Katherine R. Dever	1436 / 1133	1.76
119	426 / 23	Virginia M. Davisson	1349 / 60	0.62
120	426 / 22	Virginia M. Davisson	1349 / 60	0.37
121	426 / 21	Virginia M. Davisson	1349 / 60	0.75

No.	TM / Par	Owner	Bk / Pg	Ac.
122	406 / 34	Antonio P., LLC	1421 / 1185	0.26
123	406 / 33	Antonio P., LLC	1426 / 36	1.52
124	406 / 31	Antonio P., LLC	1503 / 291	14.65
125	406 / 28	Antonio P., LLC	1503 / 291	176.82
126	406 / 21.5	Monongahela Power Co.	1083 / 210	0.45
127	406 / 21.1	Terry L. & Cathy D. Williams	1662 / 1294	9.66
128	406 / 21.4	Monongahela Power Co.	1083 / 210	2.76
129	406A / 33	James & Megan Kennedy	1594 / 1121	0.43
130	406A / 24	Vincent & Amber Olliverio	1600 / 576	0.23
131	406A / 23	Timothy Ross	1349 / 303	0.23
132	406A / 21	James S. Skinner	1559 / 1053	0.47
133	406A / 22	James S. Skinner	1515 / 519	0.23
134	406A / 7	Charles & Naomi Burkhammer	1506 / 1150	0.46
135	406A / 6	Jerry Hughes	1095 / 649	0.23
136	406A / 13	James & Nancy Karis	1174 / 835	0.23
137	406A / 5	Jerry Hughes	1095 / 649	0.23
138	406A / 14	James & Nancy Karis	1068 / 939	0.23
139	406A / 19	Kathryn M. Fittro	1191 / 555	1.27
140	406A / 35	Harley R. & Linda L. Coberly	1229 / 315	0.79
141	406A / 20	Stephen & Shiela Nelson	1266 / 1097	0.36
142	406A / 1	Ernie & Linda Morgan	1266 / 35	0.35
143	406A / 2	Ernie & Linda Morgan	1266 / 35	0.35
144	406A / 3	David & Nancy Nester	1079 / 620	0.44
145	406A / 4	David & Nancy Nester	1079 / 620	0.42
146	406 / 24.2	Steven & Shanna Bolyard	1558 / 892	0.32
147	406 / 24.1	Steven & Shanna Bolyard	1558 / 892	0.72
148	406 / 22	David L. Scranage & Eva L. Scranage	952 / 204	0.38
149	406 / 22.1	David L. Scranage & Eva L. Scranage	912 / 274	0.46
150	406 / 21.7	Eva L. Scranage	1427 / 565	2.26
151	406 / 21.8	Brian K. & Jayme E. Lowther	1506 / 806	49.53
152	406 / 21	Robert K. Lowther	1427 / 565	17.44
153	406 / 23.1	Monongahela Power Co.	1192 / 644	3.12
154	406 / 23	Roger L. & Teri A. Wilmoth	1332 / 1017	57.94
155	406 / 21.9	Brian K. & Jayme E. Lowther	1652 / 85	6.03
156	406 / 20	Seventh Day Baptist Church	15 / 302	1.00
157	406 / 8	Robert J. Stenger	1621 / 54	166.25
158	406 / 7.13	Michael L. & Clenta V. Bond	1368 / 579	4.26
159	406 / 7.15	Michael L. & Clenta V. Bond	1393 / 1095	4.27
160	406 / 6	Richard K. Williams	1344 / 966	40.12
161	386 / 108	John L. Stenger	1309 / 666	7.44
162	406 / 9	John L. & Mary E. Stenger	1580 / 204	309.00

FILE NO: 32-36-G-19	STATE OF WEST VIRGINIA DEPARTMENT OF ENVIRONMENTAL PROTECTION OIL AND GAS DIVISION	DATE: May 14 20 25
DRAWING NO: Schoen 1205 N-1H Well Plat		OPERATOR'S WELL NO. Schoen 1205 N-1H
SCALE: 1" = 2000'		API WELL NO
MINIMUM DEGREE OF ACCURACY: Submeter		47 — 033 — 06001
PROVEN SOURCE OF ELEVATION: CORS, Bridgeport, WV		STATE COUNTY PERMIT
WELL TYPE: ☐ OIL ☒ GAS ☐ LIQUID INJECTION ☐ WASTE DISPOSAL (IF GAS) PRODUCTION: ☐ STORAGE ☐ DEEP ☒ SHALLOW		
LOCATION: ELEVATION: 1,407.3' WATERSHED: Middle West Fork Creek		Top: Mount Clare Btm: West Milford
DISTRICT: Grant / Union		COUNTY Harrison
SURFACE OWNER: George & Rosanne Schoen		ACREAGE: 65.00
ROYALTY OWNER: Willa Post Robey, et al		LEASE NO: ACREAGE: 78.20
PROPOSED WORK: ☐ DRILL ☐ CONVERT ☐ DRILL DEEPER ☐ FRACTURE OR STIMULATE ☐ PLUG OFF OLD FORMATION ☐ PERFORATE NEW FORMATION ☒ OTHER PHYSICAL CHANGE IN WELL (SPECIFY) As-Drilled 7,436' TVD		
☐ PLUG AND ABANDON ☐ CLEAN OUT AND REPLUG TARGET FORMATION: Marcellus Shale ESTIMATED DEPTH: 26,890' MD		
WELL OPERATOR: HG Energy II Appalachia, LLC		DESIGNATED AGENT: Diane C. White
ADDRESS: 5260 Dupont Road		ADDRESS: 5260 Dupont Road
Parkersburg, WV 26101		Parkersburg, WV 26101