



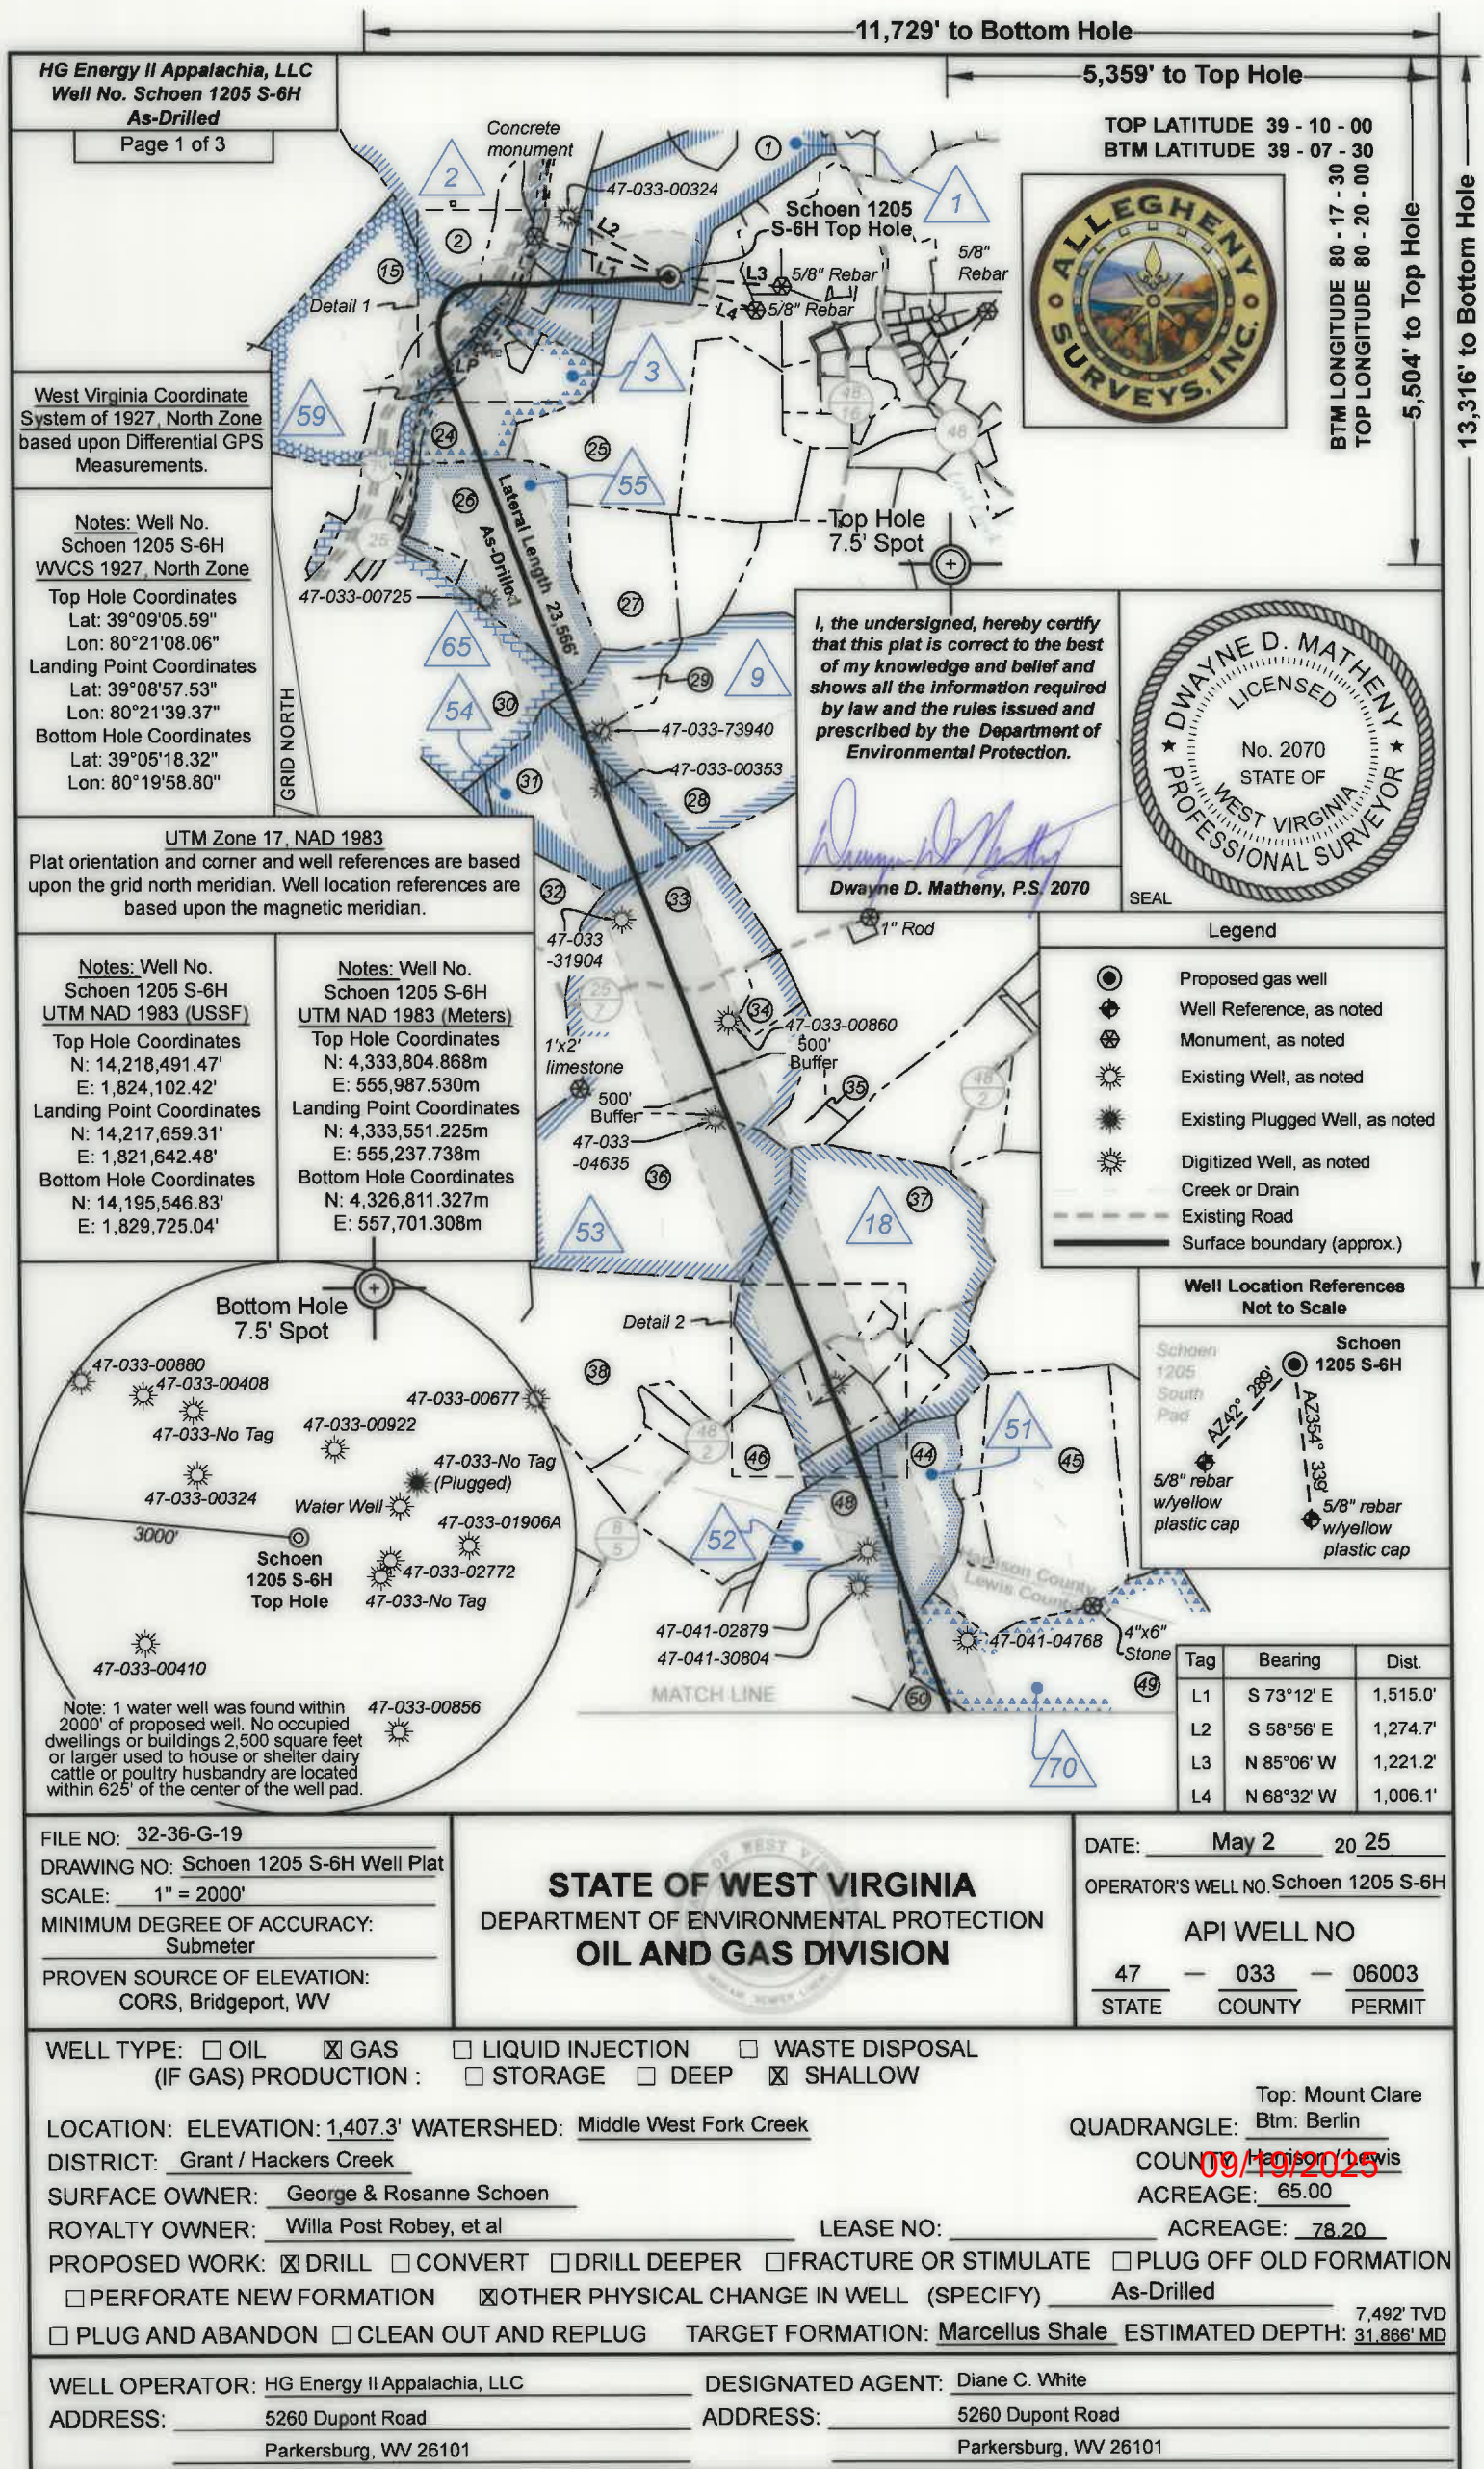

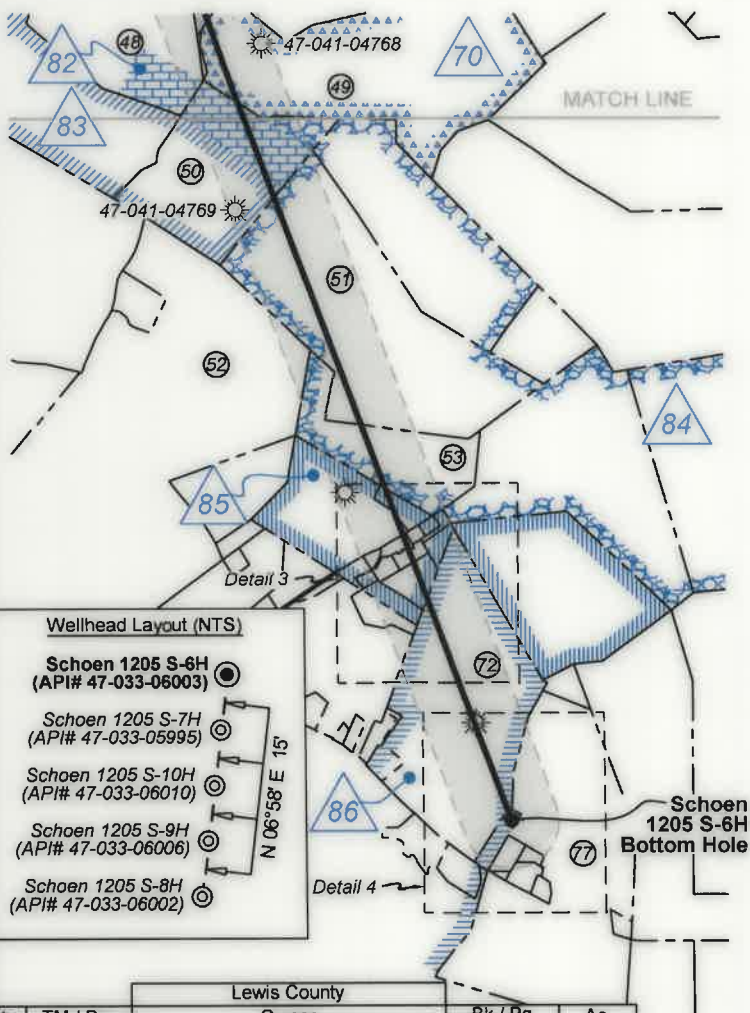

ID	Lease
1	A.B. Post, et al
2	H.D. & Marcella R. Bond, et al
3	Emma A. Waggoner, et al
9	L.D. & Addie Swisher
18	Sidney Cookman, et al
51	John W. Lewis, et al
52	A.S. Holbert
53	B. & I.M. Swisher
54	G. Manley & Mary G. Curry
55	Willa E. & John P. Ware, et al
59	J.N. & Julia E. Rector
61	WV DOT - State Rail Authority
65	G. Manley & Mary G. Curry
70	Mary Alkire
82	John Bean, et al
83	B.B. & Martha A. Curtis
84	George & Ella Cummings
85	HG Energy II Appalachia, LLC
86	George M. & Canzada Post
100	WV DOT - Division of Highways

Lewis County				
No.	TM / Par	Owner	Bk / Pg	Ac.
48	10C / 2	Myrtle B. Arbogast	W17 / 218	78.64
49	10C / 11	Thomas C. Kennedy Testamentary Trust	W34 / 428	92.50
50	10C / 9	Ricky D. & Leisha A. Hitt	605 / 249	44.22
51	10C / 12	George W. & Amy J. Dawson	505 / 549	124.00
52	10D / 1	Howard A. Mearns	W18 / 658	240.73
53	10D / 9	George W. & Amy J. Dawson	505 / 549	29.00
54	10D / 8.1	Timothy D. Vaughn	656 / 299	26.44
55	10D / 8.10	Kenneth L. Farrell	779 / 237	2.46
56	10D / 10	George W. & Amy J. Dawson	505 / 549	80.00
57	10D / 12.2	Gordon W. & Judy R. Moore	597 / 485	0.71
58	10D / 12.3	Shirley A. Burrows	480 / 47	0.60
59	10D / 12	Richard L. Dix, Sr.	784 / 9	0.51
60	10D / 8.2	Jonathan L. Veneta McKeown	712 / 300	1.15
61	10D / 8.5	Louella C. Stalnaker	744 / 742	0.50
62	10D / 8.4	James R. Riffle	701 / 890	1.22
63	10D / 8	Randi D. Rowe & Christopher L. Riddle	724 / 834	0.54
64	10D / 8.7	Gordon W. & Judy R. Moore	597 / 485	1.05
65	10D / 8.9	Gordon W. & Judy R. Moore	597 / 485	1.26
66	10D / 8.6	Gordon W. & Judy R. Moore	597 / 485	1.53
67	10D / 11	Gordon W. & Judy R. Moore	597 / 485	49.00
68	10D / 8.8	Gordon W. & Judy R. Moore	597 / 485	3.84
69	10D / 8.3	James R. Riffle	701 / 890	2.65
70	10D / 6.3	James R. Riffle	701 / 890	3.17
71	10D / 6	Daniel K. Tucker or David Tucker, et al	678 / 101	37.72
72	10D / 14.3	Jack L. & Gladys M. Frazier	463 / 157	115.76
73	10D / 14.1	Elijah Simmons	658 / 297	2.35
74	10D / 15.1	Ricky L. & Joyce Morrison	380 / 233	1.84
75	10D / 15.2	Randy L. Morrison	541 / 114	1.79
76	10D / 15.6	Robert Morrison	760 / 373	0.78
77	10D / 15	Robert D. Morrison, et al	W25 / 199	101.90

Harrison County				
No.	TM / Par	Owner	Bk / Pg	Ac.
1	447 / 2	George & Rosanne Schoen	1148 / 1059	65.00
2	446 / 7	James R. & Sharon L. Allman	1437 / 165	91.97
3	446 / 10	Karen A. Hayes	1397 / 1136	0.25
4	446 / 11	Mildred Dean	1060 / 270	0.41
5	446 / 13.1	Mack & Thelma Samples	1578 / 761	0.21
6	446 / 13	Kimberly Vanscoy	1306 / 5	0.27
7	446 / 14	Lisa Dawn Grogg	1583 / 301	0.14
8	446 / 25	Lisa Dawn Grogg	1583 / 301	0.08
9	446 / 26.1	Robert Mendez Jr.	1435 / 330	0.18
10	446 / 24.5	Brooke & Lillie Swisher	1432 / 856	0.15
11	446 / 24.1	Brooke & Lillie Swisher	1432 / 856	0.15
12	446 / 24.4	Brooke & Lillie Swisher	1432 / 856	0.03
13	446 / 24.2	Daniel & Mary L. Frazier	W165 / 1065	0.20
14	446 / 24.3	Mark & Karen Wilt	1157 / 579	0.58
15	446 / 24	Robert N. Rector	1621 / 719	82.90
16	446 / 28.1	Andrew Schrader & Melinda Davis	1478 / 252	1.28
17	446 / 28.3	Sharon Willie	1349 / 1253	0.45
18	446 / 28	Larry E. Wilson II	1344 / 1211	0.57
19	446 / 15.1	David & Grace Hughes	1257 / 694	0.31
20	446 / 12	Marilyn Gaines	1192 / 300	2.93
21	446 / 15	Vera E. Oral K. Haught	1582 / 896	14.40
22	446 / 28.5	Robert L. Vanhorn	1352 / 91	1.52
23	446 / 28.4	Bradford Vanhorn	1381 / 1181	1.52
24	446 / 28.2	David D. Vanhorn, et al	W177 / 92	42.66
25	446 / 29	John F. McCuskey II, et al	1121 / 25	75.00
26	446 / 38	Sandra J. Hogsed	1257 / 137	70.16
27	447 / 32	Joseph C. Queen	1349 / 508	36.00
28	447 / 43	Betty J. & Isaac H. Maxwell III	1543 / 141	123.95
29	447 / 43.1	Joseph C. Queen	1349 / 508	17.16
30	446 / 48	Charles R. & Franklin L. Sutton	--- / ---	88.00
31	466 / 19	Charles R. & Franklin L. Sutton	--- / ---	63.00
32	466 / 38	Charles R. & Franklin L. Sutton	1342 / 1173	123.00
33	467 / 29.1	Charles R. & Franklin L. Sutton	--- / ---	129.61
34	467 / 29	Gretna J. Adkins	1207 / 424	8.39
35	467 / 30.1	Charles R. & Franklin L. Sutton	--- / ---	11.05
36	466 / 56	Charles R. & Franklin L. Sutton	--- / ---	110.00
37	466 / 49	Charles R. & Franklin L. Sutton	--- / ---	105.17
38	466 / 71	Joyce A. & Vernon D. Cochran, Jr.	1253 / 240	91.79
39	487 / 2.1	Travis & Lauren J. Williston	1576 / 490	5.00
40	467 / 50	David L. & Celia K. Radcliff	1314 / 1289	6.00
41	487 / 2.2	Travis & Lauren J. Williston	1576 / 490	5.12
42	487 / 2	Mark Hutson	1410 / 156	10.17
43	487 / 10	Donley W. & Mark Hutson	1410 / 164	6.85
44	487 / 3	Myrtle B. Arbogast	W148 / 426	29.17
45	487 / 4.1	Catherine A. Mauro	1244 / 135	95.45
46	467 / 49.1	Jane E. & Cody R. Ball	1570 / 114	2.08
47	467 / 51.2	Gary Jedrosko	1561 / 1064	8.38

FILE NO: 32-36-G-19
 DRAWING NO: Schoen 1205 S-6H Well Plat
 SCALE: 1" = 2000'
 MINIMUM DEGREE OF ACCURACY:
 Submeter
 PROVEN SOURCE OF ELEVATION:
 CORS, Bridgeport, WV

STATE OF WEST VIRGINIA
 DEPARTMENT OF ENVIRONMENTAL PROTECTION
OIL AND GAS DIVISION

DATE: May 2 20 25
 OPERATOR'S WELL NO. Schoen 1205 S-6H
 API WELL NO
 47 - 033 - 06003
 STATE COUNTY PERMIT

WELL TYPE: ☐ OIL ☒ GAS ☐ LIQUID INJECTION ☐ WASTE DISPOSAL
 (IF GAS) PRODUCTION: ☐ STORAGE ☐ DEEP ☒ SHALLOW

LOCATION: ELEVATION: 1,407.3' WATERSHED: Middle West Fork Creek

DISTRICT: Grant / Hackers Creek

SURFACE OWNER: George & Rosanne Schoen

ROYALTY OWNER: Willa Post Robey, et al

PROPOSED WORK: ☒ DRILL ☐ CONVERT ☐ DRILL DEEPER ☐ FRACTURE OR STIMULATE ☐ PLUG OFF OLD FORMATION
☐ PERFORATE NEW FORMATION ☒ OTHER PHYSICAL CHANGE IN WELL (SPECIFY) As-Drilled

☐ PLUG AND ABANDON ☐ CLEAN OUT AND REPLUG TARGET FORMATION: Marcellus Shale ESTIMATED DEPTH: 31,866' MD

WELL OPERATOR: HG Energy II Appalachia, LLC
 ADDRESS: 5260 Dupont Road
 Parkersburg, WV 26101

DESIGNATED AGENT: Diane C. White
 ADDRESS: 5260 Dupont Road
 Parkersburg, WV 26101

Top: Mount Clare
 QUADRANGLE: Btm: Berlin
 COUNTY: Harrison / Lewis
 ACREAGE: 65.00


09/19/2025

ACREAGE: 78.20

7,492' TVD




Detail 1 (Scale 1"=500')

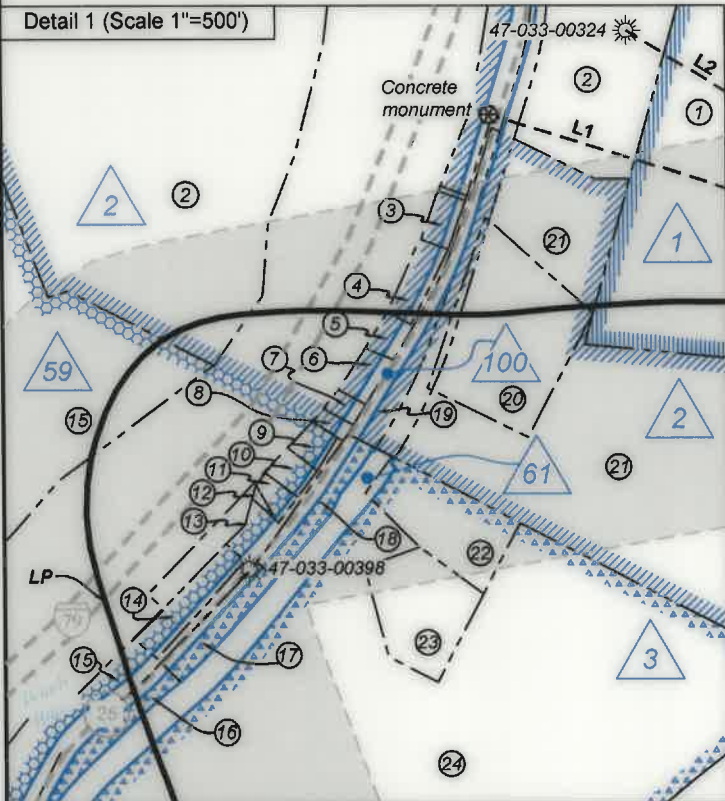


Detail 2 (Scale 1"=500')



Detail 3 (Scale 1"=500')

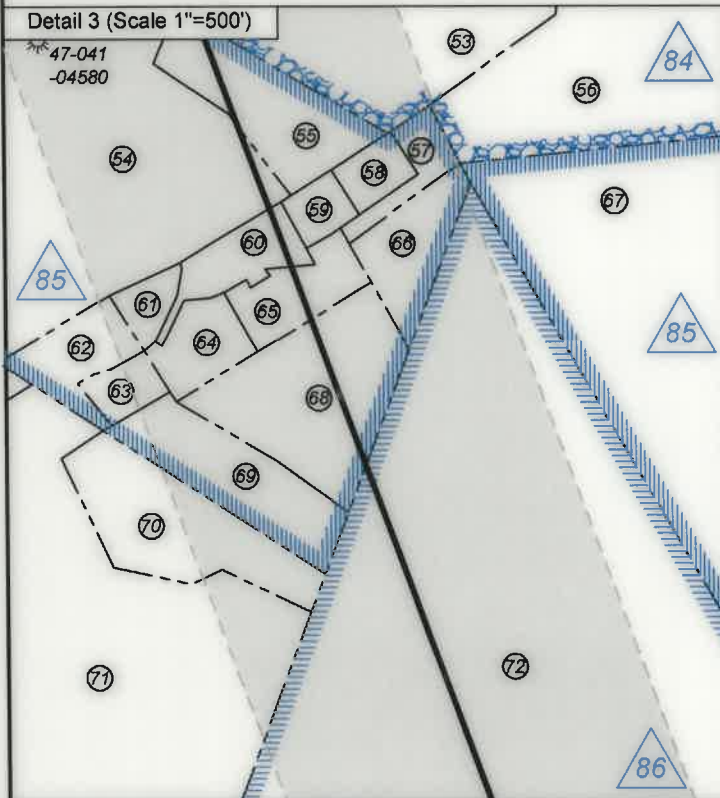

Detail 4 (Scale 1"=500')

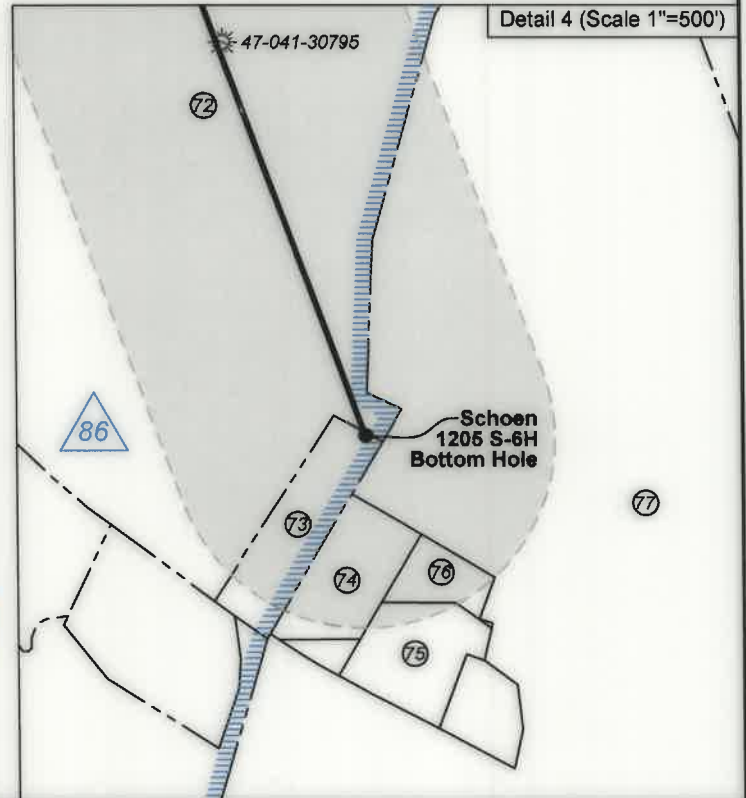

FILE NO: 32-36-G-19
 DRAWING NO: Schoen 1205 S-6H Well Plat
 SCALE: 1" = 2000'
 MINIMUM DEGREE OF ACCURACY:
 Submeter
 PROVEN SOURCE OF ELEVATION:
 CORS, Bridgeport, WV

STATE OF WEST VIRGINIA
 DEPARTMENT OF ENVIRONMENTAL PROTECTION
 OIL AND GAS DIVISION

DATE: May 2, 2025
 OPERATOR'S WELL NO. Schoen 1205 S-6H
 API WELL NO
 47 - 033 - 06003
 STATE COUNTY PERMIT

WELL TYPE: ☐ OIL ☒ GAS ☐ LIQUID INJECTION ☐ WASTE DISPOSAL
 (IF GAS) PRODUCTION: ☐ STORAGE ☐ DEEP ☒ SHALLOW

LOCATION: ELEVATION: 1,407.3' WATERSHED: Middle West Fork Creek

DISTRICT: Grant / Hackers Creek

SURFACE OWNER: George & Rosanne Schoen

ROYALTY OWNER: Willa Post Robey, et al

LEASE NO: ACREAGE: 78.20

PROPOSED WORK: ☒ DRILL ☐ CONVERT ☐ DRILL DEEPER ☐ FRACTURE OR STIMULATE ☐ PLUG OFF OLD FORMATION
☐ PERFORATE NEW FORMATION ☒ OTHER PHYSICAL CHANGE IN WELL (SPECIFY) As-Drilled

☐ PLUG AND ABANDON ☐ CLEAN OUT AND REPLUG TARGET FORMATION: Marcellus Shale ESTIMATED DEPTH: 7,492' TVD 31,866' MD

WELL OPERATOR: HG Energy II Appalachia, LLC

DESIGNATED AGENT: Diane C. White

ADDRESS: 5260 Dupont Road

ADDRESS: 5260 Dupont Road

Parkersburg, WV 26101

Parkersburg, WV 26101

QUADRANGLE: Top: Mount Clare
 Btm: Berlin

COUNTY: Harrison / Lewis

ACREAGE: 65.00

09/19/2025