

State of West Virginia  
Department of Environmental Protection - Office of Oil and Gas  
Well Operator's Report of Well Work

API 47 - 033 - 06009 County Harrison District Grant  
Quad Mount Clare 7.5' Pad Name Schoen 1205 Field/Pool Name Fink/Kennedy  
Farm name Schoen Well Number Schoen 1205 N5H  
Operator (as registered with the OOG) HG Energy II Appalachia, LLC  
Address 5260 Dupont Rd. City Parkersburg State WV Zip 26101

As Drilled location NAD 83/UTM Attach an as-drilled plat, profile view, and deviation survey  
Top hole Northing 4333875.995 Easting 555996.515  
Landing Point of Curve Northing 4334183.454 Easting 556884.710  
Bottom Hole Northing 4338835.852 Easting 555229.241

Elevation (ft) 1407 GL Type of Well ☒ New ☐ Existing Type of Report ☐ Interim ☒ Final  
Permit Type ☐ Deviated ☐ Horizontal ☒ Horizontal 6A ☐ Vertical Depth Type ☐ Deep ☐ Shallow  
Type of Operation ☐ Convert ☐ Deepen ☒ Drill ☐ Plug Back ☐ Redrilling ☐ Rework ☐ Stimulate  
Well Type ☐ Brine Disposal ☐ CBM ☒ Gas ☐ Oil ☐ Secondary Recovery ☐ Solution Mining ☐ Storage ☐ Other \_\_\_\_\_  
Type of Completion ☐ Single ☒ Multiple Fluids Produced ☒ Brine ☒ Gas ☐ NGL ☐ Oil ☐ Other \_\_\_\_\_  
Drilled with ☐ Cable ☒ Rotary

Drilling Media Surface hole ☒ Air ☐ Mud ☐ Fresh Water Intermediate hole ☒ Air ☒ Mud ☐ Fresh Water ☐ Brine  
Production hole ☐ Air ☒ Mud ☐ Fresh Water ☐ Brine

Mud Type(s) and Additive(s)

Air/WBM(gas storage)/ OBM

Barite, Lime, CaCL, base oil, Gilsonite, Asphalt, clay, Emulsifier, sulfatone, safevert FLG, safevert WA

Date permit issued 5/19/2021 Date drilling commenced 9/21/2021 Date drilling ceased 4/13/2023  
Date completion activities began 5/4/2023 Date completion activities ceased 9/28/2023  
Verbal plugging (Y/N) \_\_\_\_\_ Date permission granted \_\_\_\_\_ Granted by \_\_\_\_\_

RECEIVED  
Office of Oil and Gas

Please note: Operator is required to submit a plugging application within 5 days of verbal permission to plug

JUN 02 2025

Freshwater depth(s) ft 149, 416 Open mine(s) (Y/N) depths N WV Department of  
Salt water depth(s) ft 1615 Void(s) encountered (Y/N) depths N Environmental Protection  
Coal depth(s) ft 416,818,1058 Cavern(s) encountered (Y/N) depths N  
Is coal being mined in area (Y/N) No

Reviewed by:

*OP*  
8-13-2025

09/19/2025

WR-35  
Rev. 8/23/13

Page \_\_\_\_ of \_\_\_\_

API 47-033 - 06009

Farm name Schoen

Well number Schoen 1205 N5H

| CASING STRINGS            | Hole Size | Casing Size | Depth | New or Used | Grade wt/ft       | Basket Depth(s) | Did cement circulate (Y/ N)<br>* Provide details below* |
|---------------------------|-----------|-------------|-------|-------------|-------------------|-----------------|---------------------------------------------------------|
| Conductor                 | 30"       | 30"         | 120   | New         | 157 lbs/ft        |                 | Drilled in                                              |
| Surface                   | 26"       | 20"         | 1203  | New         | 94 lbs/ft J-55    |                 | yes 110 bbl to surface                                  |
| Coal                      |           |             |       |             |                   |                 |                                                         |
| Intermediate 1            | 17.5"     | 13.375"     | 2117  | New         | 68 lbs/ft J55     |                 | yes 124 bbl to surface                                  |
| Intermediate 2            | 12.25"    | 9.625"      | 5905  | New         | 40 lbs/ft L80-J55 |                 | yes 110 bbl to surface                                  |
| Intermediate 3            |           |             |       |             |                   |                 |                                                         |
| Production                | 8.5       | 5.5         | 24632 | New         | 23 lbs/ft P-110HP |                 | yes 320 bbl to surface                                  |
| Tubing                    |           |             |       |             |                   |                 |                                                         |
| Packer type and depth set |           |             |       |             |                   |                 |                                                         |

Comment Details cement squeeze plug set 1650-1050' due to hole making ~1000 bph water, then losses (3500 bbl water gain total, loaded hole with KCL water in casing to 511'), pumped 234 bbl 16.0 ppg w/ 20% excess, 12/20/2022

| CEMENT DATA    | Class/Type of Cement | Number of Sacks | Slurry wt (ppg) | Yield (ft <sup>3</sup> /sks) | Volume (ft <sup>3</sup> ) | Cement Top (MD) | WOC (hrs) |
|----------------|----------------------|-----------------|-----------------|------------------------------|---------------------------|-----------------|-----------|
| Conductor      |                      |                 |                 |                              |                           |                 |           |
| Surface        | Class A              | 1159/964        | 15/15.6         | 1.15/1.11                    | 1333/1070                 | Surface         | 8         |
| Coal           |                      |                 |                 |                              |                           |                 |           |
| Intermediate 1 | Class A              | 1717/487        | 16/16.4         | 1.2/1.14                     | 2060/555                  | Surface         | 24        |
| Intermediate 2 | Class A              | 744/234         | 10.5/15.2       | 2.97/1.5                     | 2210/351                  | Surface         | 8         |
| Intermediate 3 |                      |                 |                 |                              |                           |                 |           |
| Production     | Class A              | 1023/703/3435   | 13.5/13.5/14.8  | 1.82/1.67/1.34               | 1862/1174/4603            | Surface         | 8         |
| Tubing         |                      |                 |                 |                              |                           |                 |           |

Drillers TD (ft) 24662

Loggers TD (ft)

Deepest formation penetrated Marcellus

Plug back to (ft)

Plug back procedure

Kick off depth (ft) 7575

Check all wireline logs run

☒ caliper ☒ density ☐ deviated/directional ☐ induction  
☒ neutron ☒ resistivity ☒ gamma ray ☐ temperature ☐ sonic

Well cored ☐ Yes ☒ No

Conventional Sidewall

Were cuttings collected ☒ Yes ☐ No

DESCRIBE THE CENTRALIZER PLACEMENT USED FOR EACH CASING STRING

20" casing: centralizer every 3 joints to surface

13.375" casing: Bow spring centralizer on every joint

9.625" casing: Bow spring on first 2 joints then every 3rd joint to 100' from surface

5.5" casing: Centralizer run every 3 joints to top of curve (KOP) then centralizers placed every 5 joints to surface

RECEIVED  
Office of Oil and Gas

WAS WELL COMPLETED AS SHOT HOLE ☐ Yes ☒ No DETAILS

JUN 02 2025

WAS WELL COMPLETED OPEN HOLE? ☐ Yes ☒ No DETAILS

WV Department of  
Environmental Protection

WERE TRACERS USED ☐ Yes ☒ No TYPE OF TRACER(S) USED

JP 8-13-2025

09/19/2025

Well number Schoen 1205 N5H

[illegible]

### STIMULATION INFORMATION PER STAGE

[illegible]

RECEIVED  
Office of Oil and Gas  
JUN 02 2025  
WV Department of  
Environmental Protection

09/19/2025

**HG Energy II Appalachia, LLC**  
**Schoen 1205 N-5H**  
**Stimulation Record**

| Stage #  | Date      | Average Pump Rate (BPM) | Average Treatment Pressure (PSI) | Maximum Breakdown | ISIP (PSI) | Proppant (LBS) | Water (BBLs) |
|----------|-----------|-------------------------|----------------------------------|-------------------|------------|----------------|--------------|
| Sleeve/1 | 7/1/2023  | 62.0                    | 10506                            | 10705             | 5281       | 2000           | 4,160        |
| 2        | 7/6/2023  | 77.0                    | 9,747                            | 10,362            | 4,749      | 710000         | 14,972       |
| 3        | 7/7/2023  | 80.0                    | 9,953                            | 10,699            | 4,672      | 499100         | 13,080       |
| 4        | 7/7/2023  | 73.0                    | 10,026                           | 10,618            | 4,370      | 361900         | 12,771       |
| 5        | 7/7/2023  | 77.0                    | 9,871                            | 10,583            | 5,110      | 702500         | 13,179       |
| 6        | 7/8/2023  | 74.0                    | 9,869                            | 10,518            | 5,100      | 705000         | 12,728       |
| 7        | 7/9/2023  | 74.0                    | 9,856                            | 10,484            | 5,110      | 705500         | 10,623       |
| 8A       | 7/9/2023  | 37.0                    | 8,842                            | 10,912            | 5,385      | 5400           | 3,760        |
| 8B       | 7/10/2023 | 82.0                    | 10,236                           | 10,914            | 5,150      | 705500         | 10,058       |
| 9        | 7/10/2023 | 75.0                    | 10,068                           | 10,960            | 5,151      | 510800         | 9,057        |
| 10       | 7/11/2023 | 78.0                    | 10,016                           | 10,350            | 5,198      | 705500         | 9,784        |
| 11       | 7/11/2023 | 81.3                    | 10,060                           | 10,502            | 4,891      | 705500         | 9,785        |
| 12       | 7/17/2023 | 78.3                    | 10,130                           | 10,966            | 5,451      | 705500         | 9,805        |
| 13       | 7/18/2023 | 76.3                    | 10,063                           | 10,333            | 5,147      | 705500         | 10,257       |
| 14       | 7/18/2023 | 79.7                    | 10,411                           | 10,716            | 4,713      | 450770         | 8,465        |
| 15       | 7/18/2023 | 79.0                    | 10,171                           | 10,589            | 5,340      | 705500         | 10,230       |
| 16       | 7/19/2023 | 79.6                    | 10,233                           | 10,705            | 4,631      | 614970         | 10,517       |
| 17       | 7/19/2023 | 76.6                    | 10,226                           | 10,571            | 5,617      | 672350         | 9,981        |
| 18       | 7/20/2023 | 81.0                    | 10,333                           | 10,878            | 4,920      | 418940         | 9,890        |
| 19       | 7/20/2023 | 78.0                    | 10,055                           | 10,727            | 4,581      | 705500         | 11,528       |
| 20       | 7/21/2023 | 76.0                    | 10,018                           | 10,960            | 4,573      | 705500         | 9,849        |
| 21       | 7/21/2023 | 75.0                    | 10,221                           | 10,676            | 4,509      | 705500         | 10,853       |
| 22       | 7/22/2023 | 81.0                    | 10,116                           | 10,542            | 5,067      | 705500         | 9,950        |
| 23       | 7/22/2023 | 81.0                    | 10,221                           | 10,420            | 4,659      | 705500         | 10,742       |
| 24       | 7/23/2023 | 83.0                    | 10,176                           | 10,785            | 4,439      | 705500         | 11,113       |
| 25       | 7/23/2023 | 82.0                    | 9,974                            | 10,785            | 4,320      | 705500         | 10,941       |
| 26A      | 7/24/2023 | 64.0                    | 10,393                           | 10,907            | 5,344      | 7000           | 2,763        |
| 26B      | 7/24/2023 | 84.0                    | 10,039                           | 10,740            | 4,655      | 705500         | 9,831        |
| 27A      | 7/25/2023 | 59.0                    | 10,382                           | 11,007            | 5,137      | 8000           | 3,000        |
| 27B      | 7/25/2023 | 84.0                    | 10,106                           | 10,675            | 4,409      | 705500         | 11,773       |
| 28       | 7/31/2023 | 79.0                    | 10,035                           | 10,571            | 4,851      | 705500         | 10,842       |
| 29       | 7/31/2023 | 83.0                    | 10,228                           | 10,751            | 4,330      | 705500         | 9,889        |
| 30       | 8/1/2023  | 90.0                    | 10,214                           | 10,880            | 4,062      | 705500         | 10,406       |
| 31       | 8/1/2023  | 81.0                    | 10,237                           | 10,679            | 5,334      | 467500         | 8,277        |
| 32A      | 8/2/2023  | 66.0                    | 10,055                           | 11,001            | 4,664      | 6000           | 2,551        |
| 32B      | 8/2/2023  | 91.0                    | 10,171                           | 10,611            | 4,261      | 699500         | 9,769        |
| 33       | 8/2/2023  | 94.0                    | 10,163                           | 10,623            | 5,105      | 700000         | 9,769        |
| 34       | 8/3/2023  | 85.0                    | 10,143                           | 10,664            | 4,960      | 700000         | 10,045       |
| 35       | 8/3/2023  | 81.0                    | 10,108                           | 10,805            | 4,670      | 700000         | 10,391       |
| 36       | 8/4/2023  | 91.0                    | 10,147                           | 10,605            | 4,612      | 700000         | 9,768        |
| 37       | 8/4/2023  | 91.0                    | 10,165                           | 10,728            | 4,735      | 700000         | 10,620       |
| 38       | 8/5/2023  | 85.0                    | 10,126                           | 10,664            | 4,185      | 511000         | 10,313       |
| 39A      | 8/5/2023  | 27.0                    | 7,504                            | 10,489            | 5,060      | 0              | 2,500        |
| 39B      | 8/6/2023  | 96.0                    | 10,199                           | 10,786            | 4,418      | 700000         | 10,559       |
| 40       | 8/6/2023  | 85.0                    | 10,190                           | 10,710            | 4,885      | 667900         | 9,573        |
| 41       | 8/6/2023  | 92.0                    | 10,177                           | 10,576            | 4,558      | 700000         | 9,608        |
| 42       | 8/7/2023  | 87.0                    | 9,984                            | 10,815            | 5,174      | 705500         | 12,417       |
| 43       | 8/7/2023  | 90.0                    | 10,192                           | 10,623            | 4,722      | 646300         | 10,463       |
| 44       | 8/8/2023  | 88.0                    | 10,173                           | 10,640            | 5,117      | 415400         | 8,578        |
| 45       | 8/8/2023  | 85.0                    | 10,043                           | 10,553            | 4,648      | 705500         | 9,825        |
| 46A      | 8/16/2023 | 43.0                    | 9,338                            | 11,385            | 5,283      | 4172           | 3,039        |

RECEIVED  
Office of Oil and Gas  
02 2025  
Department of Environmental Protection



|     |           |       |        |        |       |        |        |
|-----|-----------|-------|--------|--------|-------|--------|--------|
| 46B | 8/16/2023 | 101.0 | 10,015 | 10,716 | 5,152 | 705500 | 9,735  |
| 47  | 8/17/2023 | 90.0  | 9,961  | 10,611 | 5,384 | 700000 | 9,542  |
| 48A | 8/18/2023 | 39.0  | 9,603  | 11,355 | 5,114 | 4000   | 2,627  |
| 48B | 8/18/2023 | 94.0  | 9,592  | 10,315 | 5,372 | 697000 | 9,902  |
| 49  | 8/18/2023 | 91.0  | 9,876  | 10,371 | 5,080 | 705500 | 9,798  |
| 50  | 8/19/2023 | 96.0  | 9,782  | 10,480 | 4,529 | 705500 | 9,803  |
| 51  | 8/19/2023 | 90.0  | 10,102 | 10,762 | 5,019 | 705500 | 9,575  |
| 52  | 8/20/2023 | 95.0  | 9,883  | 10,429 | 4,934 | 705500 | 9,588  |
| 53  | 8/20/2023 | 85.0  | 10,179 | 10,896 | 4,895 | 710000 | 10,248 |
| 54  | 8/21/2023 | 95.0  | 10,015 | 10,698 | 4,400 | 710000 | 10,323 |
| 55  | 8/21/2023 | 73.0  | 10,113 | 11,000 | 4,219 | 710000 | 11,956 |
| 56  | 8/22/2023 | 98.0  | 9,931  | 10,524 | 4,824 | 710000 | 11,454 |
| 57  | 8/22/2023 | 99.0  | 9,960  | 10,588 | 5,016 | 698900 | 11,464 |
| 58  | 8/30/2023 | 104.0 | 9,989  | 10,682 | 4,617 | 710000 | 9,454  |
| 59  | 8/30/2023 | 100.0 | 9,162  | 10,763 | 4,619 | 710000 | 10,603 |
| 60  | 8/31/2023 | 99.0  | 9,443  | 10,298 | 5,137 | 695400 | 9,332  |
| 61  | 8/31/2023 | 91.0  | 9,083  | 10,646 | 4,042 | 710000 | 11,629 |
| 62  | 9/1/2023  | 96.0  | 9,663  | 10,595 | 4,313 | 710000 | 11,184 |
| 63  | 9/1/2023  | 106.0 | 9,927  | 10,664 | 4,556 | 710000 | 11,468 |
| 64  | 9/2/2023  | 102.0 | 10,072 | 10,669 | 5,251 | 710000 | 11,196 |
| 65  | 9/2/2023  | 101.0 | 10,172 | 10,687 | 5,323 | 710000 | 11,197 |
| 66  | 9/3/2023  | 104.0 | 10,060 | 10,716 | 5,042 | 710000 | 11,090 |
| 67  | 9/3/2023  | 92.0  | 10,210 | 10,687 | 4,676 | 710000 | 11,436 |
| 68  | 9/4/2023  | 91.0  | 10,082 | 10,646 | 4,468 | 710000 | 12,440 |
| 69  | 9/4/2023  | 102.0 | 10,195 | 10,675 | 4,481 | 710000 | 12,305 |
| 70  | 9/5/2023  | 93.0  | 9,952  | 10,704 | 4,221 | 710000 | 12,094 |
| 71  | 9/5/2023  | 95.0  | 9,752  | 10,442 | 4,926 | 710000 | 12,312 |
| 72  | 9/13/2023 | 93.0  | 10,106 | 10,344 | 4,691 | 710000 | 11,984 |
| 73  | 9/14/2023 | 75.0  | 9,955  | 10,780 | 4,580 | 710000 | 13,319 |
| 74  | 9/15/2023 | 98.0  | 9,899  | 10,297 | 4,686 | 710000 | 11,835 |
| 75  | 9/16/2023 | 99.0  | 9,961  | 10,420 | 4,462 | 710000 | 11,690 |
| 76  | 9/17/2023 | 99.0  | 9,959  | 10,455 | 5,497 | 710000 | 11,852 |
| 77  | 9/18/2023 | 97.0  | 10,036 | 10,687 | 5,306 | 710000 | 12,050 |
| 78  | 9/19/2023 | 98.0  | 10,026 | 10,689 | 4,445 | 710000 | 11,949 |
| 79  | 9/20/2023 | 97.0  | 9,889  | 10,380 | 5,258 | 710000 | 11,766 |
| 80  | 9/21/2023 | 103.0 | 10,012 | 10,542 | 5,827 | 710000 | 11,724 |
| 81  | 9/22/2023 | 96    | 10,019 | 10,716 | 5,144 | 710000 | 11,734 |
| 82  | 9/23/2023 | 101   | 9,824  | 10,414 | 9,515 | 710000 | 11,779 |
| 83  | 9/24/2023 | 101   | 9,379  | 10,321 | 5,894 | 710000 | 12,095 |
| 84  | 9/25/2023 | 99    | 9,642  | 10,193 | 4,661 | 709999 | 11,653 |

RECEIVED  
Office of Oil and Gas

JUN 02 2025

WV Department of  
Environmental Protection

09/19/2025

RECEIVED  
Office of Oil and Gas  
JUN 02 2025  
WV Department of  
Environmental Protection

09/19/2025

RECEIVED  
Office of Oil and Gas  
JUN 02 2025  
WV Department of  
Environmental Protection

09/19/2025

**HG Energy II Appalachia, LLC**  
**Schoen 1205 N-5H**  
**Perforation Record**

| Stage #  | Perforation Date | Perforations From Depth | Perforations to Depth | Number of Perforations | Formation |
|----------|------------------|-------------------------|-----------------------|------------------------|-----------|
| Sleeve/1 | 7/1/2023         | 24584                   | 24561                 | 2                      | Marcellus |
| 2        | 7/6/2023         | 24528                   | 24360                 | 28                     | Marcellus |
| 3        | 7/7/2023         | 24334                   | 24166                 | 28                     | Marcellus |
| 4        | 7/7/2023         | 24140                   | 23972                 | 28                     | Marcellus |
| 5        | 7/7/2023         | 23946                   | 23778                 | 28                     | Marcellus |
| 6        | 7/8/2023         | 23752                   | 23584                 | 28                     | Marcellus |
| 7        | 7/9/2023         | 23558                   | 23390                 | 28                     | Marcellus |
| 8A       | 7/9/2023         | 23364                   | 23196                 | 28                     | Marcellus |
| 8B       | 7/10/2023        | 23364                   | 23166                 | 56                     | Marcellus |
| 9        | 7/10/2023        | 23137                   | 22987                 | 28                     | Marcellus |
| 10       | 7/11/2023        | 22958                   | 22808                 | 28                     | Marcellus |
| 11       | 7/11/2023        | 22782                   | 22614                 | 28                     | Marcellus |
| 12       | 7/17/2023        | 22588                   | 22420                 | 28                     | Marcellus |
| 13       | 7/18/2023        | 22394                   | 22226                 | 28                     | Marcellus |
| 14       | 7/18/2023        | 22200                   | 22032                 | 28                     | Marcellus |
| 15       | 7/18/2023        | 22006                   | 21838                 | 28                     | Marcellus |
| 16       | 7/19/2023        | 21812                   | 21644                 | 28                     | Marcellus |
| 17       | 7/19/2023        | 21618                   | 21450                 | 28                     | Marcellus |
| 18       | 7/20/2023        | 21424                   | 21256                 | 28                     | Marcellus |
| 19       | 7/20/2023        | 21230                   | 21062                 | 28                     | Marcellus |
| 20       | 7/21/2023        | 21036                   | 20868                 | 28                     | Marcellus |
| 21       | 7/21/2023        | 20842                   | 20674                 | 28                     | Marcellus |
| 22       | 7/22/2023        | 20648                   | 20480                 | 28                     | Marcellus |
| 23       | 7/22/2023        | 20454                   | 20286                 | 28                     | Marcellus |
| 24       | 7/23/2023        | 20260                   | 20092                 | 28                     | Marcellus |
| 25       | 7/23/2023        | 20066                   | 19898                 | 28                     | Marcellus |
| 26A      | 7/24/2023        | 19872                   | 19704                 | 28                     | Marcellus |
| 26B      | 7/24/2023        | 19872                   | 19674                 | 56                     | Marcellus |
| 27A      | 7/25/2023        | 19645                   | 19495                 | 28                     | Marcellus |
| 27B      | 7/25/2023        | 19645                   | 19465                 | 56                     | Marcellus |
| 28       | 7/31/2023        | 19466                   | 19316                 | 28                     | Marcellus |
| 29       | 7/31/2023        | 19290                   | 19122                 | 28                     | Marcellus |
| 30       | 8/1/2023         | 19096                   | 18928                 | 28                     | Marcellus |
| 31       | 8/1/2023         | 18902                   | 18734                 | 28                     | Marcellus |
| 32A      | 8/2/2023         | 18708                   | 18540                 | 28                     | Marcellus |
| 32B      | 8/2/2023         | 18708                   | 18540                 | 56                     | Marcellus |
| 33       | 8/2/2023         | 18481                   | 18510                 | 28                     | Marcellus |
| 34       | 8/3/2023         | 18302                   | 18152                 | 28                     | Marcellus |
| 35       | 8/3/2023         | 18126                   | 17958                 | 28                     | Marcellus |
| 36       | 8/4/2023         | 17932                   | 17764                 | 28                     | Marcellus |
| 37       | 8/4/2023         | 17738                   | 17570                 | 28                     | Marcellus |
| 38       | 8/5/2023         | 17544                   | 17376                 | 28                     | Marcellus |
| 39A      | 8/5/2023         | 17350                   | 17182                 | 28                     | Marcellus |
| 39B      | 8/6/2023         | 17350                   | 17152                 | 56                     | Marcellus |
| 40       | 8/6/2023         | 17123                   | 16973                 | 28                     | Marcellus |
| 41       | 8/6/2023         | 16944                   | 16794                 | 28                     | Marcellus |
| 42       | 8/7/2023         | 16768                   | 16600                 | 28                     | Marcellus |
| 43       | 8/7/2023         | 16574                   | 16406                 | 28                     | Marcellus |
| 44       | 8/8/2023         | 16380                   | 16212                 | 28                     | Marcellus |
| 45       | 8/8/2023         | 16186                   | 16018                 | 28                     | Marcellus |
| 46A      | 8/16/2023        | 15992                   | 15824                 | 28                     | Marcellus |

RECEIVED  
Office of Oil and Gas  
JUN 02 2025  
WV Department of  
Environmental Protection

09/19/2025



|     |           |       |        |    |           |
|-----|-----------|-------|--------|----|-----------|
| 46B | 8/16/2023 | 15992 | 15,794 | 56 | Marcellus |
| 47  | 8/17/2023 | 15765 | 15615  | 28 | Marcellus |
| 48A | 8/18/2023 | 15586 | 15436  | 28 | Marcellus |
| 48B | 8/18/2023 | 15586 | 15406  | 56 | Marcellus |
| 49  | 8/18/2023 | 15377 | 15227  | 28 | Marcellus |
| 50  | 8/19/2023 | 15198 | 15048  | 28 | Marcellus |
| 51  | 8/19/2023 | 15022 | 14854  | 28 | Marcellus |
| 52  | 8/20/2023 | 14828 | 14660  | 28 | Marcellus |
| 53  | 8/20/2023 | 14634 | 14466  | 28 | Marcellus |
| 54  | 8/21/2023 | 14440 | 14272  | 28 | Marcellus |
| 55  | 8/21/2023 | 14246 | 14078  | 28 | Marcellus |
| 56  | 8/22/2023 | 14052 | 13884  | 28 | Marcellus |
| 57  | 8/22/2023 | 13858 | 13690  | 28 | Marcellus |
| 58  | 8/30/2023 | 13664 | 13496  | 28 | Marcellus |
| 59  | 8/30/2023 | 13470 | 13302  | 28 | Marcellus |
| 60  | 8/31/2023 | 13276 | 13108  | 28 | Marcellus |
| 61  | 8/31/2023 | 13082 | 12914  | 28 | Marcellus |
| 62  | 9/1/2023  | 12888 | 12720  | 28 | Marcellus |
| 63  | 9/1/2023  | 12694 | 12526  | 28 | Marcellus |
| 64  | 9/2/2023  | 12500 | 12332  | 28 | Marcellus |
| 65  | 9/2/2023  | 12306 | 12138  | 28 | Marcellus |
| 66  | 9/3/2023  | 12112 | 11944  | 28 | Marcellus |
| 67  | 9/3/2023  | 11918 | 11750  | 28 | Marcellus |
| 68  | 9/4/2023  | 11724 | 11556  | 28 | Marcellus |
| 69  | 9/4/2023  | 11530 | 11362  | 28 | Marcellus |
| 70  | 9/5/2023  | 11336 | 11168  | 28 | Marcellus |
| 71  | 9/5/2023  | 11142 | 10974  | 28 | Marcellus |
| 72  | 9/13/2023 | 10948 | 10780  | 28 | Marcellus |
| 73  | 9/14/2023 | 10754 | 10586  | 28 | Marcellus |
| 74  | 9/15/2023 | 10560 | 10392  | 28 | Marcellus |
| 75  | 9/16/2023 | 10366 | 10198  | 28 | Marcellus |
| 76  | 9/17/2023 | 10172 | 10004  | 28 | Marcellus |
| 77  | 9/18/2023 | 9978  | 9810   | 28 | Marcellus |
| 78  | 9/19/2023 | 9784  | 9616   | 28 | Marcellus |
| 79  | 9/20/2023 | 9590  | 9422   | 28 | Marcellus |
| 80  | 9/21/2023 | 9396  | 9228   | 28 | Marcellus |
| 81  | 9/22/2023 | 9202  | 9034   | 28 | Marcellus |
| 82  | 9/23/2023 | 9008  | 8840   | 28 | Marcellus |
| 83  | 9/24/2023 | 8814  | 8646   | 28 | Marcellus |
| 84  | 9/25/2023 | 8620  | 8452   | 28 | Marcellus |
|     |           |       |        |    |           |

RECEIVED  
Office of Oil and Gas  
JUN 02 2025  
WV Department of  
Environmental Protection

09/19/2025

API 47- 033 - 06009 Farm name Schoen Well number Schoen 1205 N5H

| <u>PRODUCING FORMATION(S)</u> | <u>DEPTHS</u> |     |            |    |
|-------------------------------|---------------|-----|------------|----|
| Marcellus                     | 7234-7412     | TVD | 8439-24662 | MD |

Please insert additional pages as applicable.

GAS TEST    ☐ Build up    ☐ Drawdown    ☒ Open Flow    OIL TEST    ☐ Flow    ☐ Pump

SHUT-IN PRESSURE    Surface 2432    psi    Bottom Hole       psi    DURATION OF TEST 703    hrs

|           |       |     |     |       |   |
|-----------|-------|-----|-----|-------|---|
| OPEN FLOW | Gas   | Oil | NGL | Water | GAS MEASURED BY                                                                                               |
|           | 24260 |     |     | 1080  | <input type="checkbox"/> Estimated <input checked="" type="checkbox"/> Orifice <input type="checkbox"/> Pilot |
|           | mcfpd | bpd | bpd | bpd   |   |

[illegible][illegible]

Please insert additional pages as applicable.

Drilling Contractor Patterson Drilling  
Address 2198 University Drive City Lemont Furnace State PA Zip 15456

Logging Company Renegade Wireline Services  
Address 191 Earnhardt Rd. City Hunker State PA Zip 15639

Cementing Company Schlumberger  
Address 300 Schlumberger Dr. City Sugar Land State TX Zip 77478

|                     |                      |      |            |       |              |
|---------------------|----------------------|------|------------|-------|--------------|
| Stimulating Company | Nextier              |      |            |       |              |
| Address             | 8300 Route 119 North | City | Black Lick | State | PA Zip 15716 |

Please insert additional pages as applicable.

Completed by Diane White Telephone 304-420-1119  
Signature Diane White Title \_\_\_\_\_ Date 5/21/2025

Submittal of Hydraulic Fracturing Chemical Disclosure Information      Attach copy of FRACFOCUS Registry

8.13.2025

09/19/2025


**HG Energy II Appalachia, LLC**  
**Schoen 1205 N-5H**  
**Lithology Information**

| Formation       | Top MD | Top TVD | Base MD   | Base TVD |
|-----------------|--------|---------|-----------|----------|
| Coal            | 416    | 416     | 420       | 420      |
| Coal            | 818    | 818     | 824       | 824      |
| 1st salt sand   | 894    | 894     | 1021      | 1021     |
| Deepest Coal    | 1058   | 1058    | 1061      | 1061     |
| 2nd salt sand   | 1062   | 1062    | 1126      | 1126     |
| 3rd salt sand   | 1154   | 1154    | 1268      | 1268     |
| Maxton          | 1285   | 1285    | 1408      | 1408     |
| Little Lime     | 1518   | 1516    | 1543      | 1543     |
| Big Lime        | 1556   | 1556    | 1604      | 1604     |
| Big Injun       | 1634   | 1634    | 1739      | 1739     |
| Gantz           | 1944   | 1944    | 2012      | 2012     |
| 50 foot sand    | 2032   | 2032    | 2135      | 2135     |
| Casing depth    | 2145   |         | set depth | 2117     |
| 30 foot sand    | 2154   | 2154    | 2193      | 2193     |
| Gordon Stray    | 2235   | 2235    | 2288      | 2288     |
| Gordon Sand     | 2288   | 2288    | 2350      | 2350     |
| 4th sand        | 2358   | 2358    | 2382      | 2381     |
| 4th A sand      | 2408   | 2407    | 2421      | 2420     |
| Fifth sand      | 2479   | 2478    | 2510      | 2508     |
| Warren          | 2873   | 2866    | 2899      | 2891     |
| Upper Speechley | 3079   | 3067    | 3110      | 3097     |
| Lower Speechley | 3177   | 3161    | 3209      | 3191     |
| Balltown        | 3412   | 3381    | 3432      | 3399     |
| Bradford        | 3880   | 3804    | 3941      | 3858     |
| Benson          | 4729   | 4467    | 4764      | 4491     |
| Alexander       | 5217   | 4814    | 5574      | 5074     |
| Elk             | 5829   | 5261    | 5872      | 5294     |
| Casing depth    | 5945   | drill   | 5905      | 5318     |
| Rhinestreet     | 7275   | 6364    | 7563      | 6588     |
| Cashaqua        | 7563   | 6588    | 7802      | 6776     |
| Middlesex       | 7802   | 6776    | 7946      | 6890     |
| West River      | 7946   | 6890    | 8107      | 7017     |
| Burket          | 8107   | 7017    | 8147      | 7048     |
| Tully           | 8147   | 7048    | 8281      | 7146     |
| Hamilton        | 8281   | 7146    | 8377      | 7205     |
| Marcellus       | 8377   | 7205    | 24662     | 7412     |

RECEIVED  
Office of Oil and Gas  
JUN 02 2025  
WV Department of  
Environmental Protection

09/19/2025



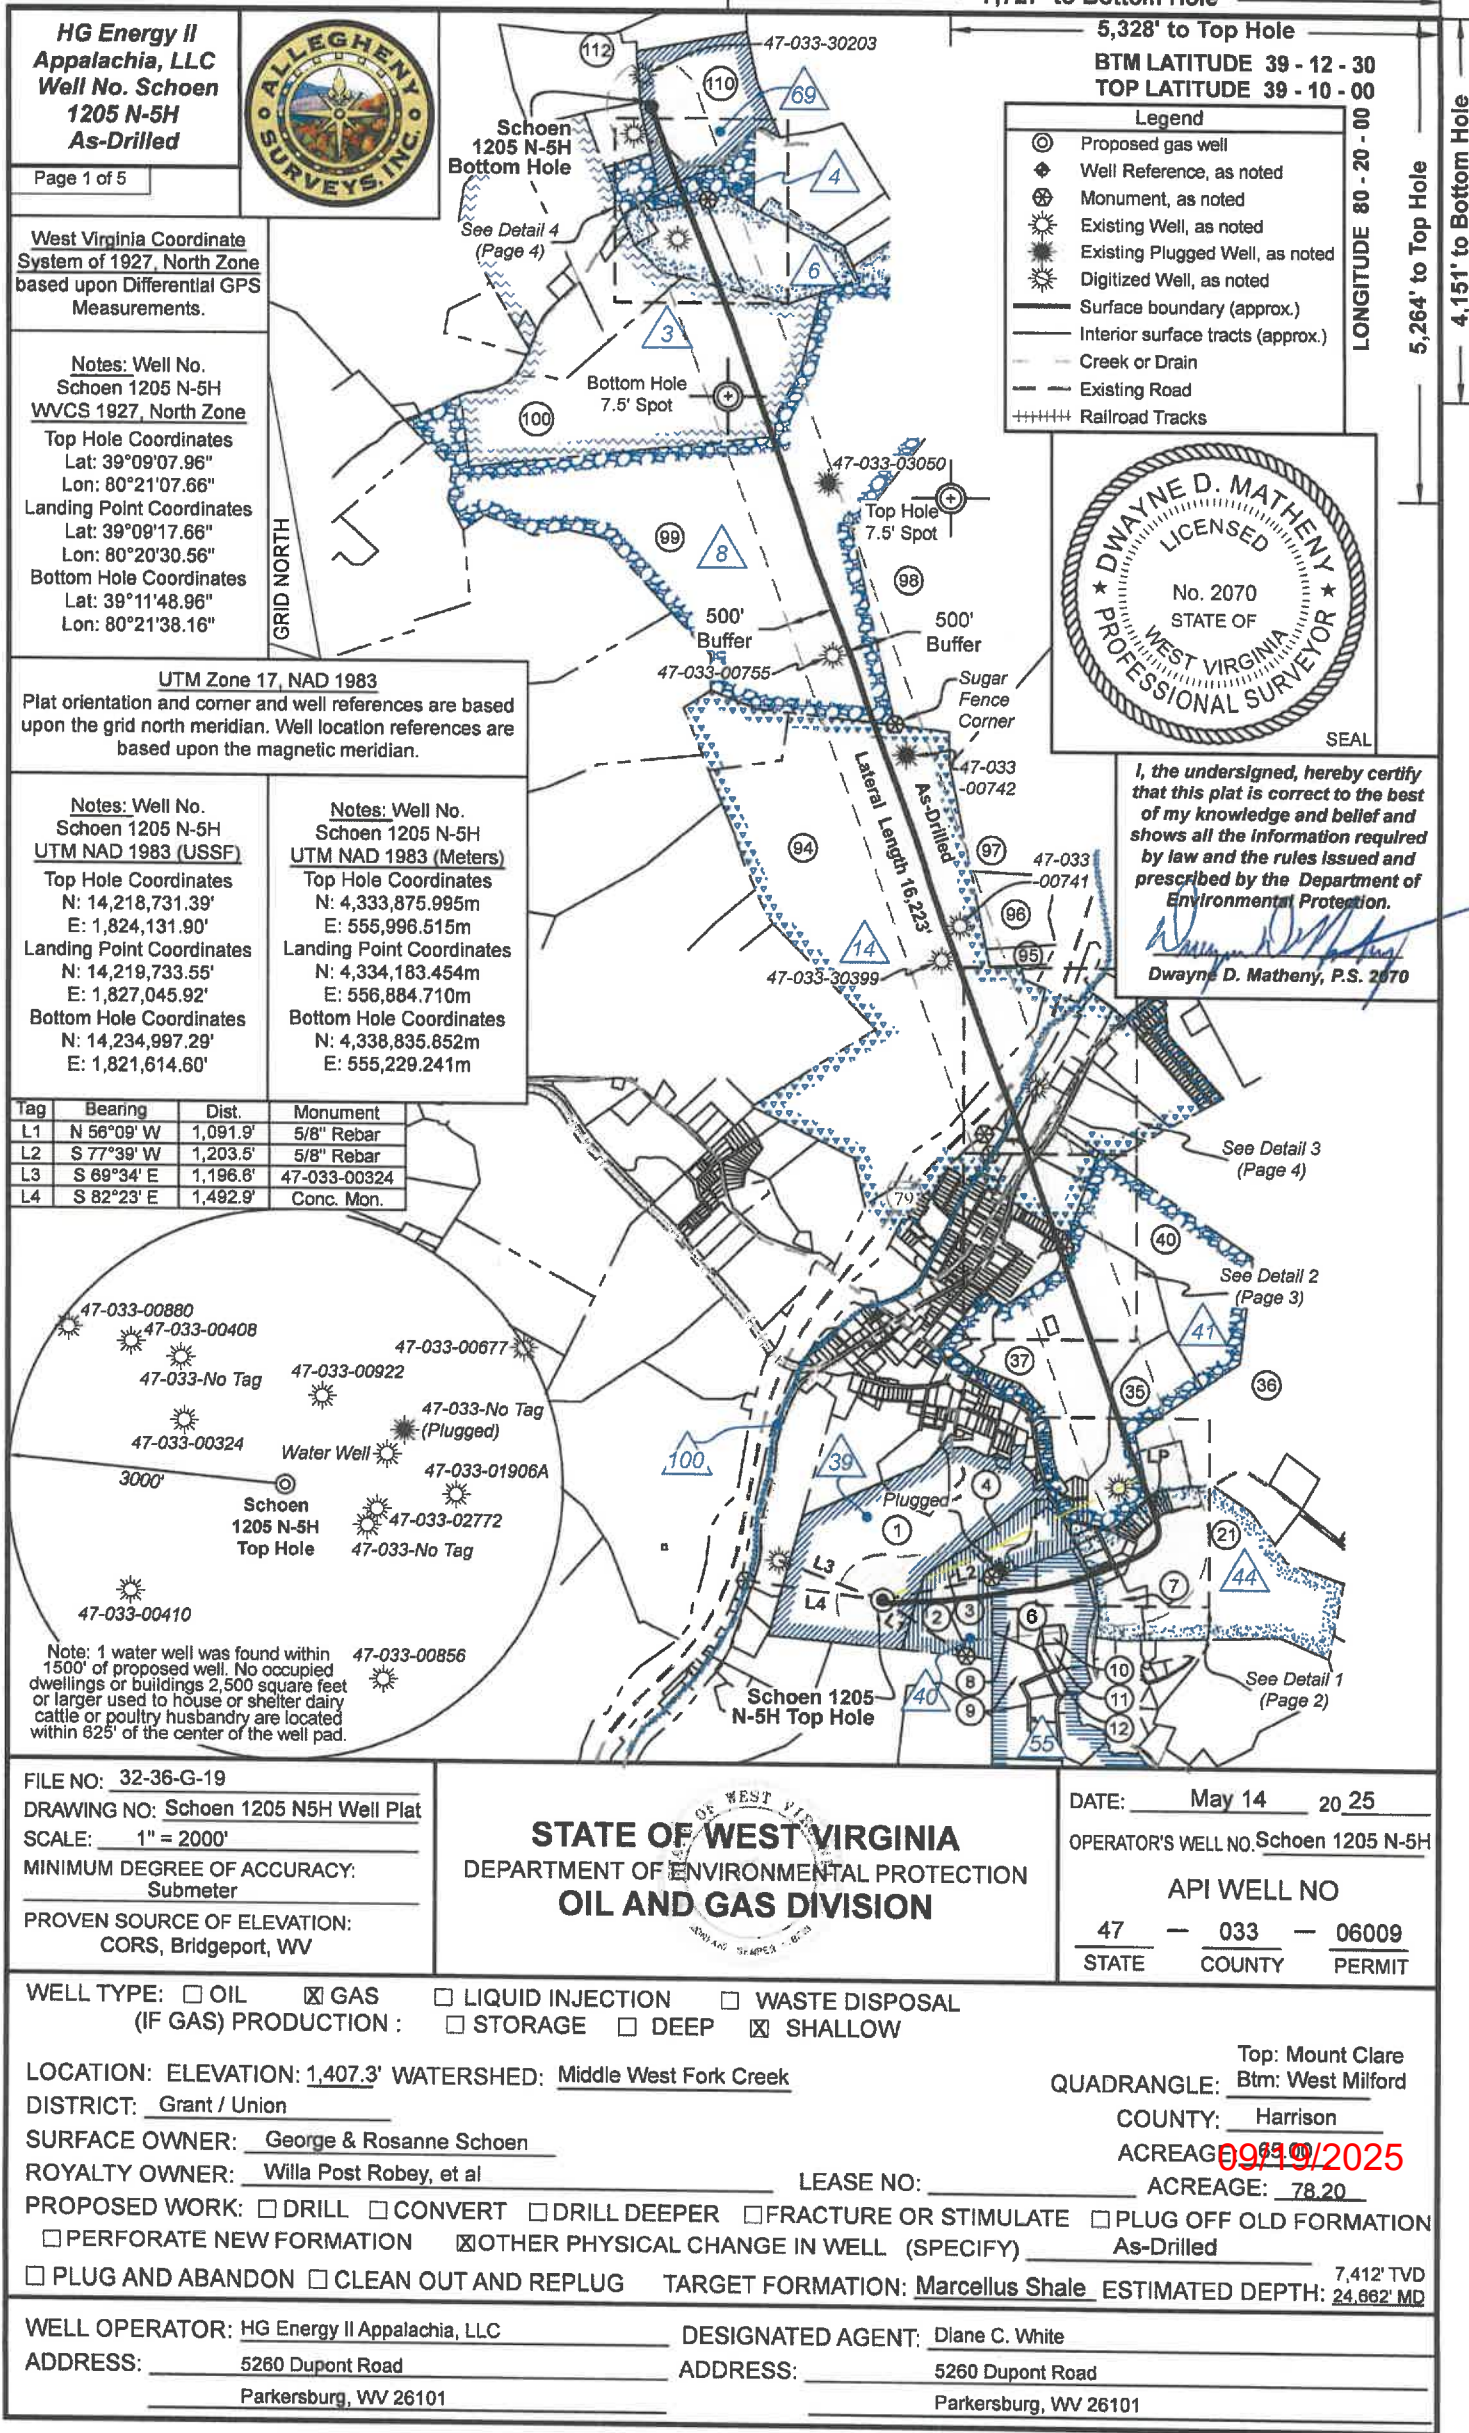

**HG Energy II  
Appalachia, LLC**  
**Well No. Schoen**  
**1205 N-5H**  
**As-Drilled**

Page 1 of 5

West Virginia Coordinate  
System of 1927, North Zone  
based upon Differential GPS  
Measurements.


**Notes: Well No.**  
**Schoen 1205 N-5H**  
**WVCS 1927, North Zone**  
Top Hole Coordinates  
Lat: 39°09'07.96"  
Lon: 80°21'07.66"  
Landing Point Coordinates  
Lat: 39°09'17.66"  
Lon: 80°20'30.56"  
Bottom Hole Coordinates  
Lat: 39°11'48.96"  
Lon: 80°21'38.16"

UTM Zone 17, NAD 1983  
Plat orientation and corner and well references are based upon the grid north meridian. Well location references are based upon the magnetic meridian.

**Notes: Well No.**  
**Schoen 1205 N-5H**  
**UTM NAD 1983 (USSF)**  
Top Hole Coordinates  
N: 14,218,731.39'  
E: 1,824,131.90'  
Landing Point Coordinates  
N: 14,219,733.55'  
E: 1,827,045.92'  
Bottom Hole Coordinates  
N: 14,234,997.29'  
E: 1,821,614.60'

**Notes: Well No.**  
**Schoen 1205 N-5H**  
**UTM NAD 1983 (Meters)**  
Top Hole Coordinates  
N: 4,333,875.995m  
E: 555,996.515m  
Landing Point Coordinates  
N: 4,334,183.454m  
E: 556,884.710m  
Bottom Hole Coordinates  
N: 4,338,835.852m  
E: 555,229.241m

| Tag | Bearing    | Dist.    | Monument     |
|-----|------------|----------|--------------|
| L1  | N 56°09' W | 1,091.9' | 5/8" Rebar   |
| L2  | S 77°39' W | 1,203.5' | 5/8" Rebar   |
| L3  | S 69°34' E | 1,196.8' | 47-033-00324 |
| L4  | S 82°23' E | 1,492.9' | Conc. Mon.   |

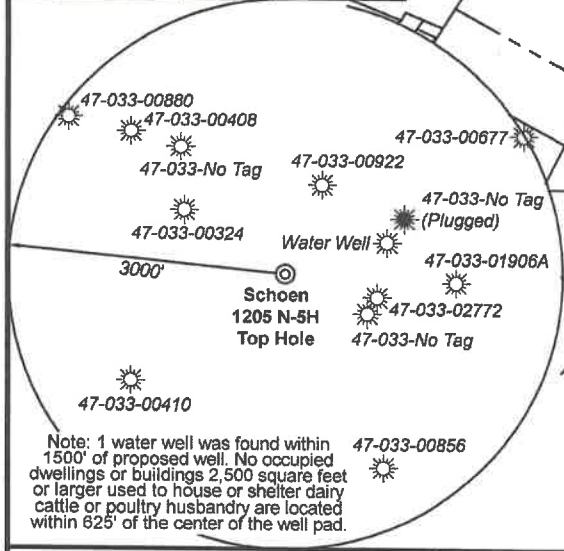

FILE NO: 32-36-G-19  
DRAWING NO: Schoen 1205 N5H Well Plat  
SCALE: 1" = 2000'  
MINIMUM DEGREE OF ACCURACY:  
Submeter  
PROVEN SOURCE OF ELEVATION:  
CORS, Bridgeport, WV

**STATE OF WEST VIRGINIA**  
**DEPARTMENT OF ENVIRONMENTAL PROTECTION**  
**OIL AND GAS DIVISION**

DATE: May 14 20 25  
OPERATOR'S WELL NO. Schoen 1205 N-5H  
API WELL NO  
47 - 033 - 06009  
STATE COUNTY PERMIT

WELL TYPE: ☐ OIL ☒ GAS ☐ LIQUID INJECTION ☐ WASTE DISPOSAL  
(IF GAS) PRODUCTION: ☐ STORAGE ☐ DEEP ☒ SHALLOW

LOCATION: ELEVATION: 1,407.3' WATERSHED: Middle West Fork Creek  
DISTRICT: Grant / Union

SURFACE OWNER: George & Rosanne Schoen  
ROYALTY OWNER: Willa Post Robey, et al LEASE NO: ACREAGE: 78.20


PROPOSED WORK: ☐ DRILL ☐ CONVERT ☐ DRILL DEEPER ☐ FRACTURE OR STIMULATE ☐ PLUG OFF OLD FORMATION  
☐ PERFORATE NEW FORMATION ☒ OTHER PHYSICAL CHANGE IN WELL (SPECIFY) As-Drilled

☐ PLUG AND ABANDON ☐ CLEAN OUT AND REPLUG TARGET FORMATION: Marcellus Shale ESTIMATED DEPTH: 7,412' TVD 24,862' MD


WELL OPERATOR: HG Energy II Appalachia, LLC DESIGNATED AGENT: Diane C. White  
ADDRESS: 5260 Dupont Road ADDRESS: 5260 Dupont Road  
Parkersburg, WV 26101 Parkersburg, WV 26101

HG Energy II  
Appalachia, LLC  
Well No. Schoen  
1205 N-5H  
As-Drilled

Page 2 of 5

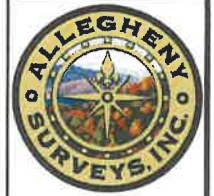

Detail 1  
NTS

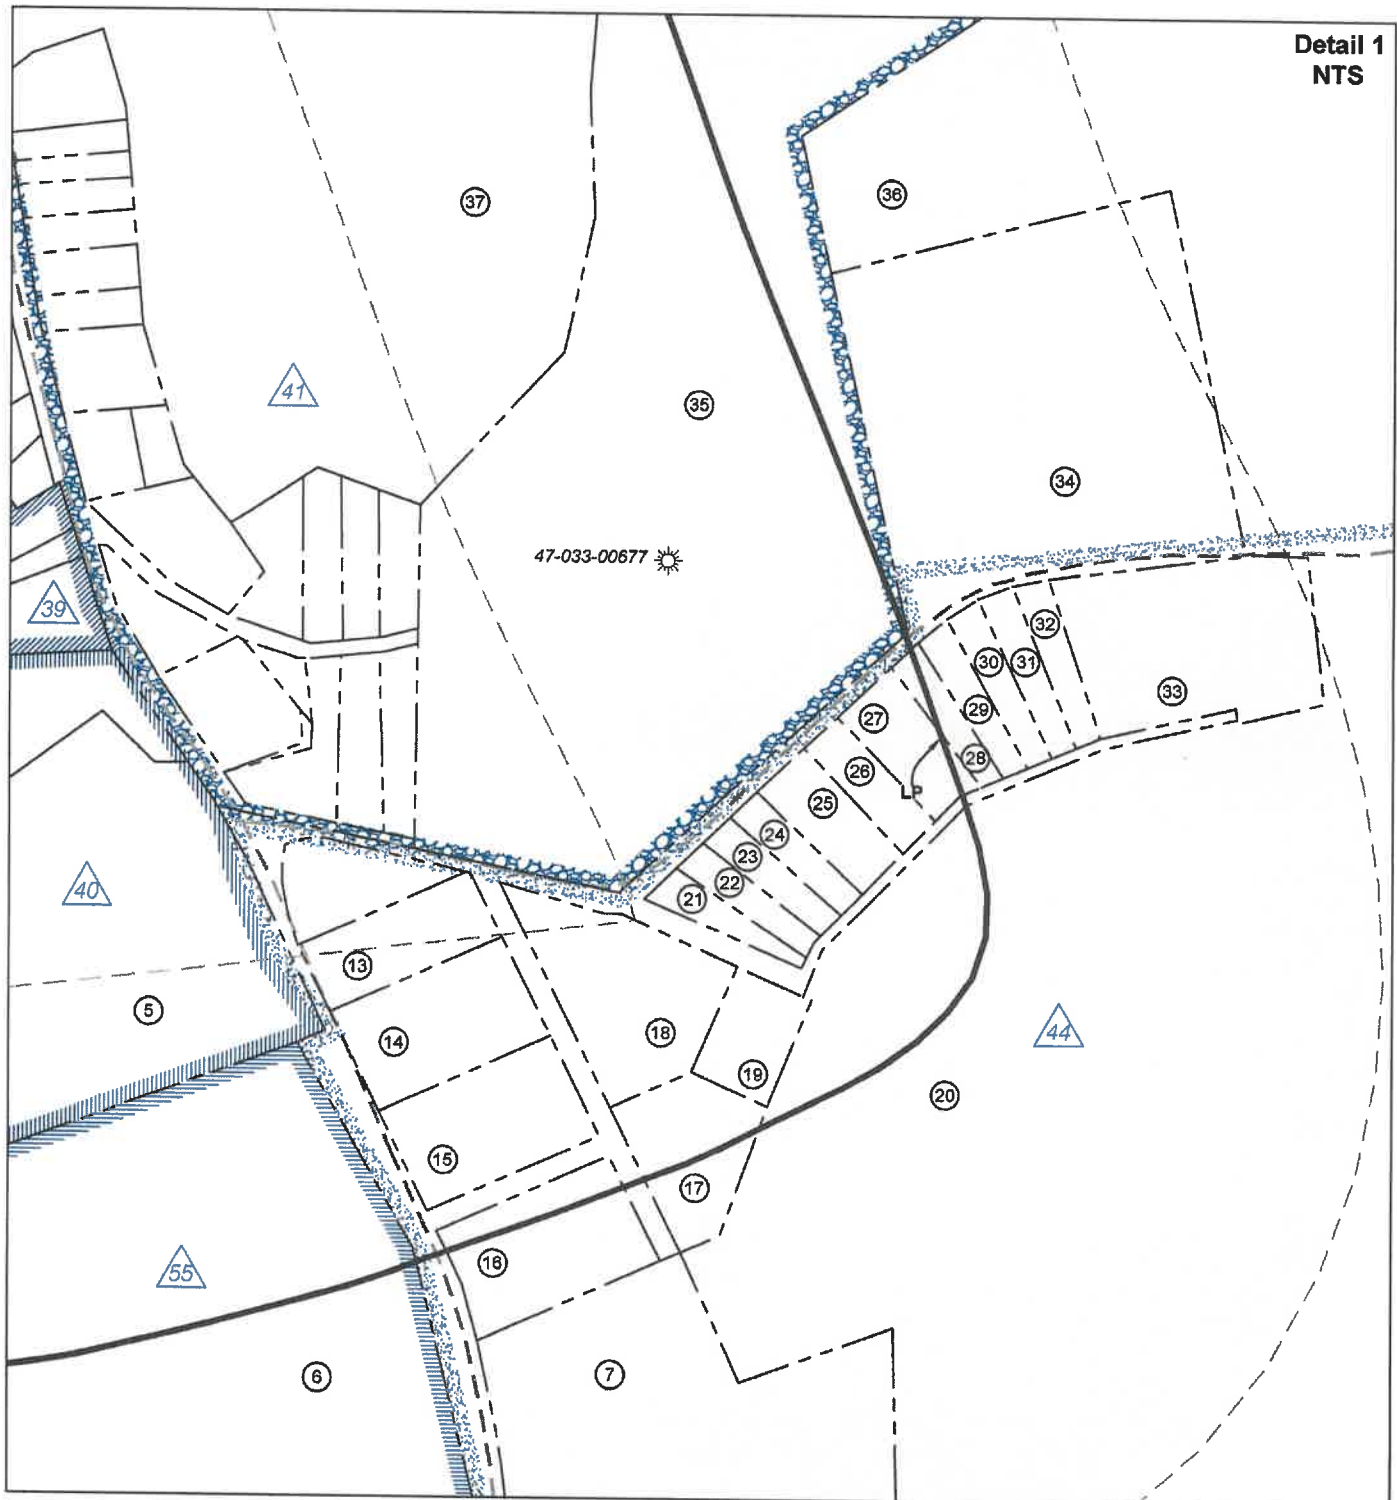

FILE NO: 32-36-G-19

DRAWING NO: Schoen 1205 N5H Well Plat

SCALE: 1" = 2000'

MINIMUM DEGREE OF ACCURACY:  
Submeter

PROVEN SOURCE OF ELEVATION:  
CORS, Bridgeport, WV

STATE OF WEST VIRGINIA  
DEPARTMENT OF ENVIRONMENTAL PROTECTION  
OIL AND GAS DIVISION

DATE: May 14 20 25

OPERATOR'S WELL NO. Schoen 1205 N-5H

API WELL NO

47 — 033 — 06009  
STATE COUNTY PERMIT

WELL TYPE: ☐ OIL ☒ GAS ☐ LIQUID INJECTION ☐ WASTE DISPOSAL  
(IF GAS) PRODUCTION: ☐ STORAGE ☐ DEEP ☒ SHALLOW

LOCATION: ELEVATION: 1,407.3' WATERSHED: Middle West Fork Creek

DISTRICT: Grant / Union

SURFACE OWNER: George & Rosanne Schoen

ROYALTY OWNER: Willa Post Robey, et al

LEASE NO:

Top: Mount Clare  
Btm: West Milford

QUADRANGLE:

COUNTY: Harrison

ACREAGE: 85.09

ACREAGE: 78.20

PROPOSED WORK: ☐ DRILL ☐ CONVERT ☐ DRILL DEEPER ☐ FRACTURE OR STIMULATE ☐ PLUG OFF OLD FORMATION  
☐ PERFORATE NEW FORMATION ☒ OTHER PHYSICAL CHANGE IN WELL (SPECIFY) As-Drilled

☐ PLUG AND ABANDON ☐ CLEAN OUT AND REPLUG TARGET FORMATION: Marcellus Shale ESTIMATED DEPTH: 7,412' TVD 24,862' MD

WELL OPERATOR: HG Energy II Appalachia, LLC

DESIGNATED AGENT: Diane C. White

ADDRESS: 5260 Dupont Road

ADDRESS: 5260 Dupont Road


Parkersburg, WV 26101

Parkersburg, WV 26101



HG Energy II  
Appalachia, LLC  
Well No. Schoen  
1205 N-5H  
As-Drilled

Page 3 of 5

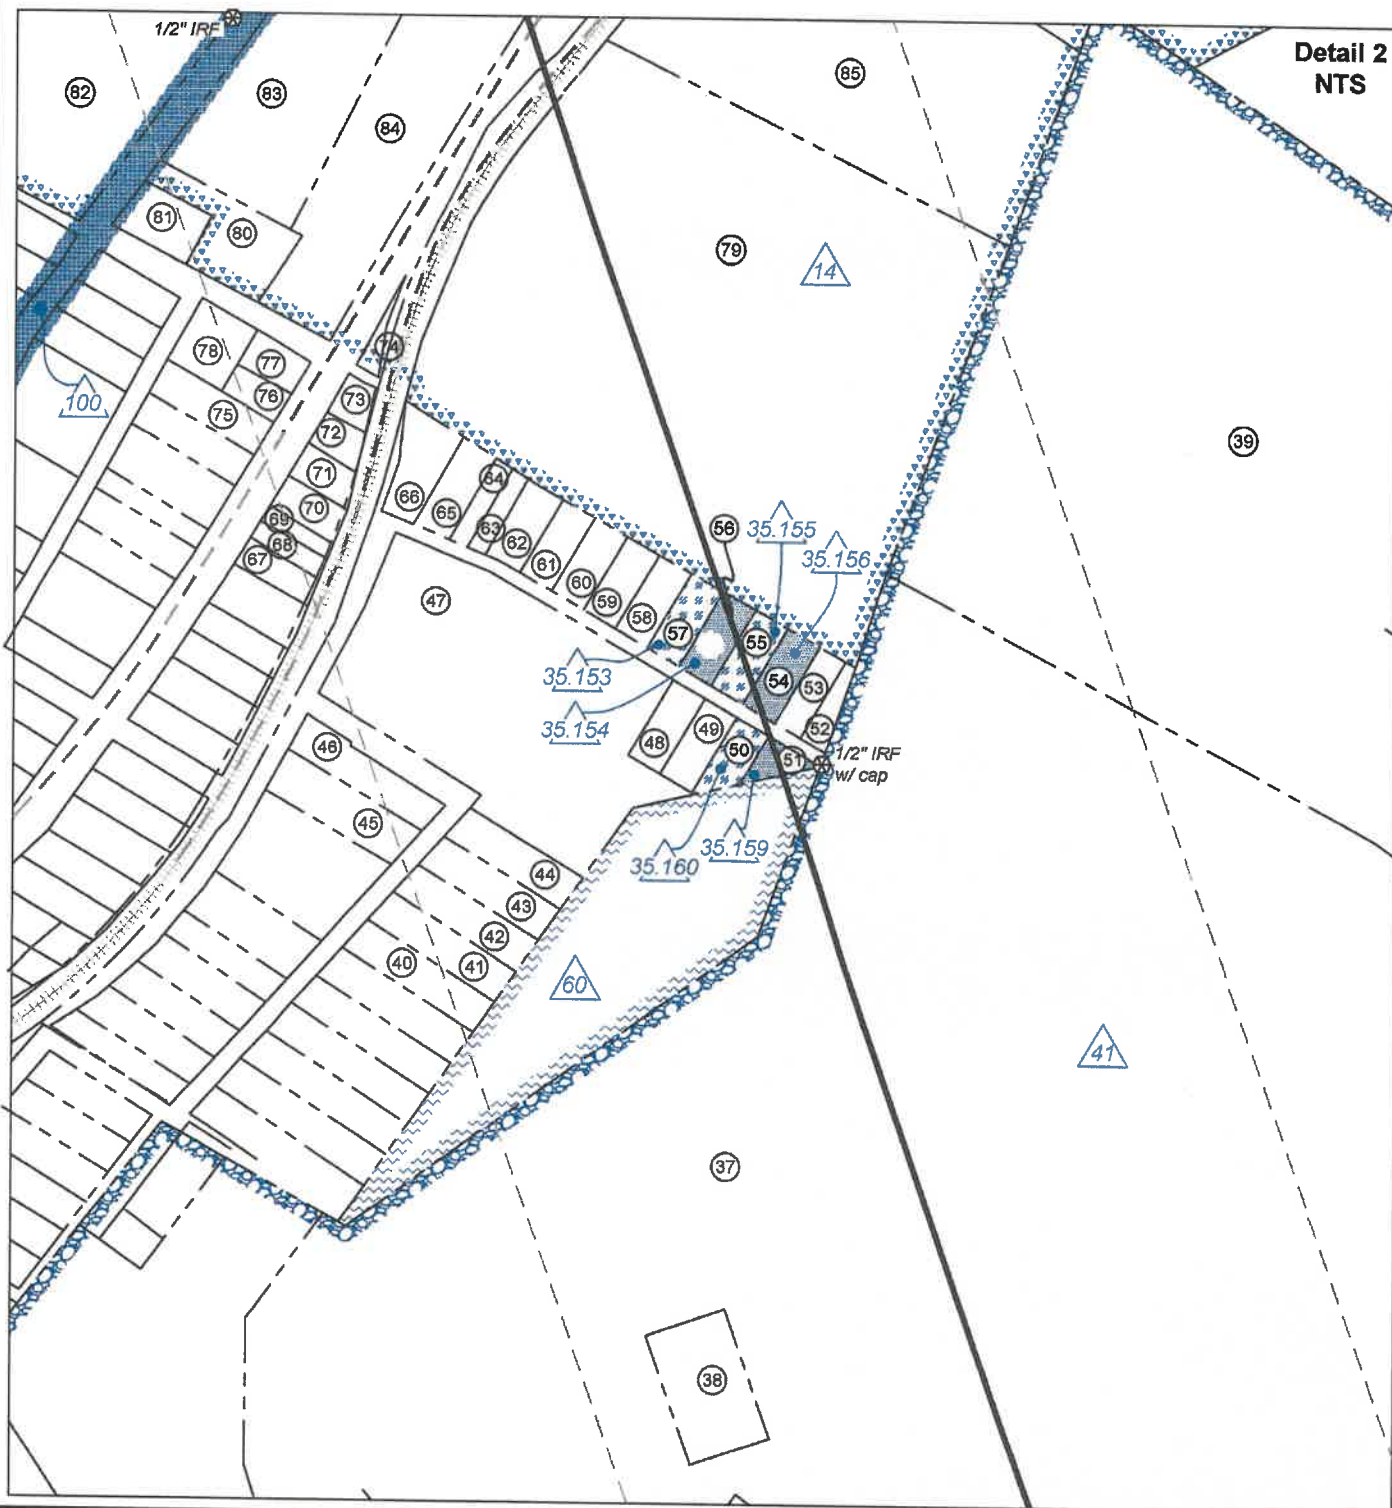

FILE NO: 32-36-G-19

DRAWING NO: Schoen 1205 N5H Well Plat

SCALE: 1" = 2000'

MINIMUM DEGREE OF ACCURACY:  
Submeter

PROVEN SOURCE OF ELEVATION:  
CORS, Bridgeport, WV

STATE OF WEST VIRGINIA  
DEPARTMENT OF ENVIRONMENTAL PROTECTION  
OIL AND GAS DIVISION

DATE: May 14 20 25

OPERATOR'S WELL NO. Schoen 1205 N-5H

API WELL NO

47 — 033 — 06009  
STATE COUNTY PERMIT

WELL TYPE: ☐ OIL ☒ GAS ☐ LIQUID INJECTION ☐ WASTE DISPOSAL  
(IF GAS) PRODUCTION: ☐ STORAGE ☐ DEEP ☒ SHALLOW

LOCATION: ELEVATION: 1,407.3' WATERSHED: Middle West Fork Creek

DISTRICT: Grant / Union

SURFACE OWNER: George & Rosanne Schoen

ROYALTY OWNER: Willa Post Robey, et al

LEASE NO: ACREAGE: 78.20

PROPOSED WORK: ☐ DRILL ☐ CONVERT ☐ DRILL DEEPER ☐ FRACTURE OR STIMULATE ☐ PLUG OFF OLD FORMATION  
☐ PERFORATE NEW FORMATION ☒ OTHER PHYSICAL CHANGE IN WELL (SPECIFY) As-Drilled

☐ PLUG AND ABANDON ☐ CLEAN OUT AND REPLUG TARGET FORMATION: Marcellus Shale ESTIMATED DEPTH: 7,412' TVD 24,662' MD

WELL OPERATOR: HG Energy II Appalachia, LLC

DESIGNATED AGENT: Diane C. White

ADDRESS: 5260 Dupont Road

ADDRESS: 5260 Dupont Road

Parkersburg, WV 26101

Parkersburg, WV 26101

Top: Mount Clare  
Btm: West Milford  
QUADRANGLE:  
COUNTY: Harrison

ACREAGE: 78.20

ACREAGE: 78.20


09/19/2025

HG Energy II  
Appalachia, LLC  
Well No. Schoen  
1205 N-5H  
As-Drilled

Page 4 of 5






Wellhead Layout (NTS)

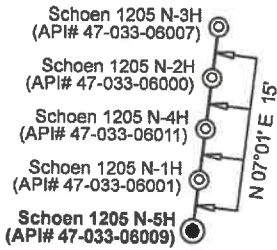

| ID     | Lease                             |
|--------|-----------------------------------|
| 3      | Emory L. & Elzia P. Stout         |
| 4      | Cassie G. Smith, et al            |
| 6      | Edna M. Swisher, et al            |
| 8      | Porter & Bertha B. Maxwell, et al |
| 14     | Mollie V. Bassell, et al          |
| 35.153 | Brenda Joyce Cogar, et al         |
| 35.154 | Charles D. Leeson                 |
| 35.155 | Charles D. Leeson                 |
| 35.156 | Charles D. Leeson                 |
| 35.159 | Charles D. Leeson                 |
| 35.160 | Charles D. Leeson                 |
| 39     | A.B. Post, et al                  |
| 40     | John H. & Charlotte C. Gerlach    |
| 41     | D.L. & Margaret R. Nutter         |
| 44     | Milton S. & Mary I. Davis         |
| 55     | French S. & Anna J. Young         |
| 80     | Betty J. & Isaac H. Maxwell, III  |
| 69     | Jo Ann Murtha                     |
| 100    | WV DOT, Division of Highways      |

Well Location References  
Not to Scale

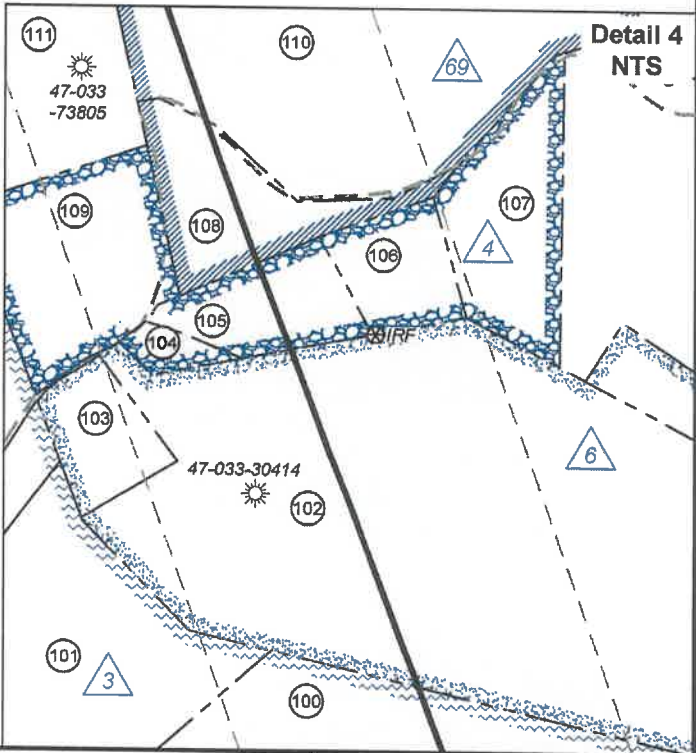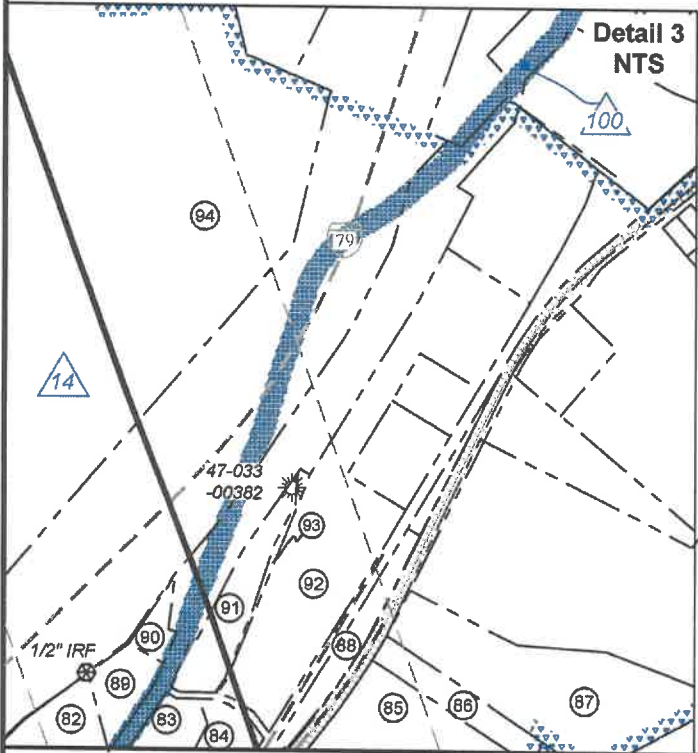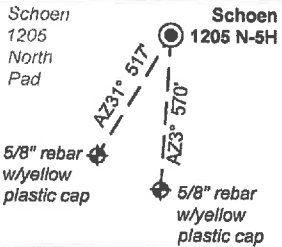

FILE NO: 32-36-G-19

DRAWING NO: Schoen 1205 N5H Well Plat

SCALE: 1" = 2000'

MINIMUM DEGREE OF ACCURACY:  
Submeter

PROVEN SOURCE OF ELEVATION:  
CORS, Bridgeport, WV

STATE OF WEST VIRGINIA  
DEPARTMENT OF ENVIRONMENTAL PROTECTION  
OIL AND GAS DIVISION

DATE: May 14 20 25

OPERATOR'S WELL NO. Schoen 1205 N-5H

API WELL NO

47 - 033 - 06009  
STATE COUNTY PERMIT

WELL TYPE: ☐ OIL ☒ GAS ☐ LIQUID INJECTION ☐ WASTE DISPOSAL  
(IF GAS) PRODUCTION: ☐ STORAGE ☐ DEEP ☒ SHALLOW

LOCATION: ELEVATION: 1,407.3' WATERSHED: Middle West Fork Creek

DISTRICT: Grant / Union

SURFACE OWNER: George & Rosanne Schoen

ROYALTY OWNER: Willa Post Robey, et al

PROPOSED WORK: ☐ DRILL ☐ CONVERT ☐ DRILL DEEPER ☐ FRACTURE OR STIMULATE ☐ PLUG OFF OLD FORMATION

☐ PERFORATE NEW FORMATION ☒ OTHER PHYSICAL CHANGE IN WELL (SPECIFY) As-Drilled

☐ PLUG AND ABANDON ☐ CLEAN OUT AND REPLUG TARGET FORMATION: Marcellus Shale ESTIMATED DEPTH: 7,412' TVD 24,662' MD

WELL OPERATOR: HG Energy II Appalachia, LLC

DESIGNATED AGENT: Diane C. White

ADDRESS: 5260 Dupont Road

ADDRESS: 5260 Dupont Road

Parkersburg, WV 26101

Parkersburg, WV 26101

Top: Mount Clare  
QUADRANGLE: Btm: West Milford

COUNTY: Harrison

ACREAGE: 78.20

09/19/2025



| No. | TM / Par    | Owner                              | Bk / Pg     | Ac.    |
|-----|-------------|------------------------------------|-------------|--------|
| 57  | 2103 / 21   | Joshua & Harley Miller Cogar       | W174 / 683  | ---    |
| 58  | 2103 / 20   | Joshua & Harley Miller Cogar       | W174 / 683  | ---    |
| 59  | 2103 / 19   | Dennis W. & Rose M. Chamberlain    | 1335 / 911  | ---    |
| 60  | 2103 / 18   | Dennis W. & Rose M. Chamberlain    | 1335 / 911  | ---    |
| 61  | 2103 / 17   | Jonah E. Cogar                     | 1432 / 493  | ---    |
| 62  | 2103 / 16   | Jonah E. Cogar                     | 1432 / 493  | ---    |
| 63  | 2103 / 15.1 | Jonah E. Cogar                     | 1432 / 493  | ---    |
| 64  | 2103 / 15   | Eugene R. Smith Jr.                | 1329 / 532  | ---    |
| 65  | 2103 / 14   | Eugene R. Smith Jr.                | 1329 / 532  | ---    |
| 66  | 2103 / 13   | Drexal L. Mullen                   | W134 / 323  | ---    |
| 67  | 2103 / 51   | Judith A. Corkrean                 | 1148 / 474  | 0.11   |
| 68  | 2103 / 46   | Judith A. Corkrean                 | 1148 / 474  | ---    |
| 69  | 2103 / 46.1 | Judith A. Corkrean                 | 1148 / 474  | ---    |
| 70  | 2103 / 36   | Judith A. Corkrean                 | 1148 / 474  | ---    |
| 71  | 2103 / 31   | Beverly A. Foster                  | 1096 / 205  | ---    |
| 72  | 2103 / 12   | Beverly A. Foster                  | 1096 / 20   | ---    |
| 73  | 2103 / 7    | Beverly A. Foster                  | 1096 / 205  | ---    |
| 74  | 2103 / 2    | Beverly A. Foster                  | 1096 / 205  | ---    |
| 75  | 2103 / 30   | Gregory A. Foster                  | 1404 / 455  | ---    |
| 76  | 2103 / 11   | Gregory A. & Beverly A. Foster     | 1256 / 109  | ---    |
| 77  | 2103 / 6    | Gregory A. & Beverly A. Foster     | 1256 / 109  | ---    |
| 78  | 2103 / 11.1 | Joshua D. Messenger                | 1492 / 197  | 0.24   |
| 79  | 427 / 13    | Dennis & Rose Chamberlain          | 1321 / 102  | 9.25   |
| 80  | 427 / 1.12  | Jerry & Myrna Kincaid              | 1484 / 1045 | 0.30   |
| 81  | 2103 / 1    | Jerry & Myrna Kincaid              | 1484 / 1045 | 0.19   |
| 82  | 427 / 1.6   | Michel M. Lewis                    | 1598 / 301  | 2.45   |
| 83  | 427 / 1.7   | Apostolic Christian                | 1598 / 301  | 3.83   |
| 84  | 427 / 1.13  | Apostolic Christian                | 1598 / 296  | 1.80   |
| 85  | 427 / 14    | Debra & David Shriver              | 1218 / 787  | 4.19   |
| 86  | 427 / 15    | Reid & Vicki Smith                 | 1506 / 332  | 0.63   |
| 87  | 427 / 16    | Reid & Vicy Smith                  | 1336 / 710  | 4.21   |
| 88  | 427 / 1.10  | Charles & Nancy Shock              | 1299 / 472  | 0.80   |
| 89  | 427 / 1.5   | Michel M. Lewis                    | 1444 / 142  | 0.76   |
| 90  | 427 / 1.4   | Walter & David Nutter              | 0.25        | 0.25   |
| 91  | 427 / 1.8   | Apostolic Christian                | 1466 / 825  | 1.41   |
| 92  | 427 / 1.9   | Charles & Nancy Shock              | 1368 / 201  | 5.96   |
| 93  | 427 / 1.14  | Apostolic Christian                | 1598 / 475  | 0.15   |
| 94  | 427 / 1     | Walter E. Nutter & David H. Nutter | 154 / 301   | 228.20 |
| 95  | 427 / 3     | Walter Nutter                      | W154 / 301  | 8.00   |
| 96  | 427 / 48    | Walter E. & David H. Nutter        | W154 / 301  | 33.00  |
| 97  | 427 / 61    | Walter E. & David H. Nutter        | W154 / 301  | 116.16 |
| 98  | 407 / 25    | Richard D. Mendez                  | W168 / 424  | 192.71 |
| 99  | 406 / 25    | Isaac H. III & Betty Jean Maxwell  | 1509/934    | 255.20 |
| 100 | 406 / 27    | James Stout                        | W161 / 306  | 43.50  |
| 101 | 406 / 11    | Mildred Stout                      | 1138 / 993  | 44.80  |
| 102 | 406 / 15    | Danny Haggerty                     | 1362 / 278  | 42.11  |
| 103 | 406 / 15.1  | Danny E. Jr. & Lisa A. Haggerty    | 1497 / 995  | 2.02   |
| 104 | 406 / 13.3  | Williard George Brown              | 1496 / 1170 | 0.58   |
| 105 | 406 / 13.2  | Leonard C. Paugh                   | 1524 / 1195 | 2.56   |
| 106 | 406 / 13    | Leonard C. Paugh                   | 1524 / 1195 | 2.12   |
| 107 | 406 / 14    | Danny E. & Debra D. Haggerty       | 1081 / 11   | 4.00   |
| 108 | 406 / 127.1 | Angela Renee Ricketts              | 1393 / 362  | 4.75   |
| 109 | 406 / 13.1  | Angela Renee Ricketts              | 1408 / 44   | 4.50   |
| 110 | 386 / 127   | Sherry Louise Ricketts             | 916 / 343   | 40.75  |
| 111 | 386 / 126   | Sherry Louise Ricketts             | W114 / 1014 | 7.12   |
| 112 | 386 / 125   | Sherry Louise Ricketts             | W114 / 1014 | 27.69  |

Parkersburg, WV 26101











Parkersburg, WV 26101



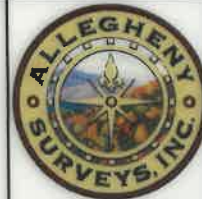

Detail 1  
 NTS

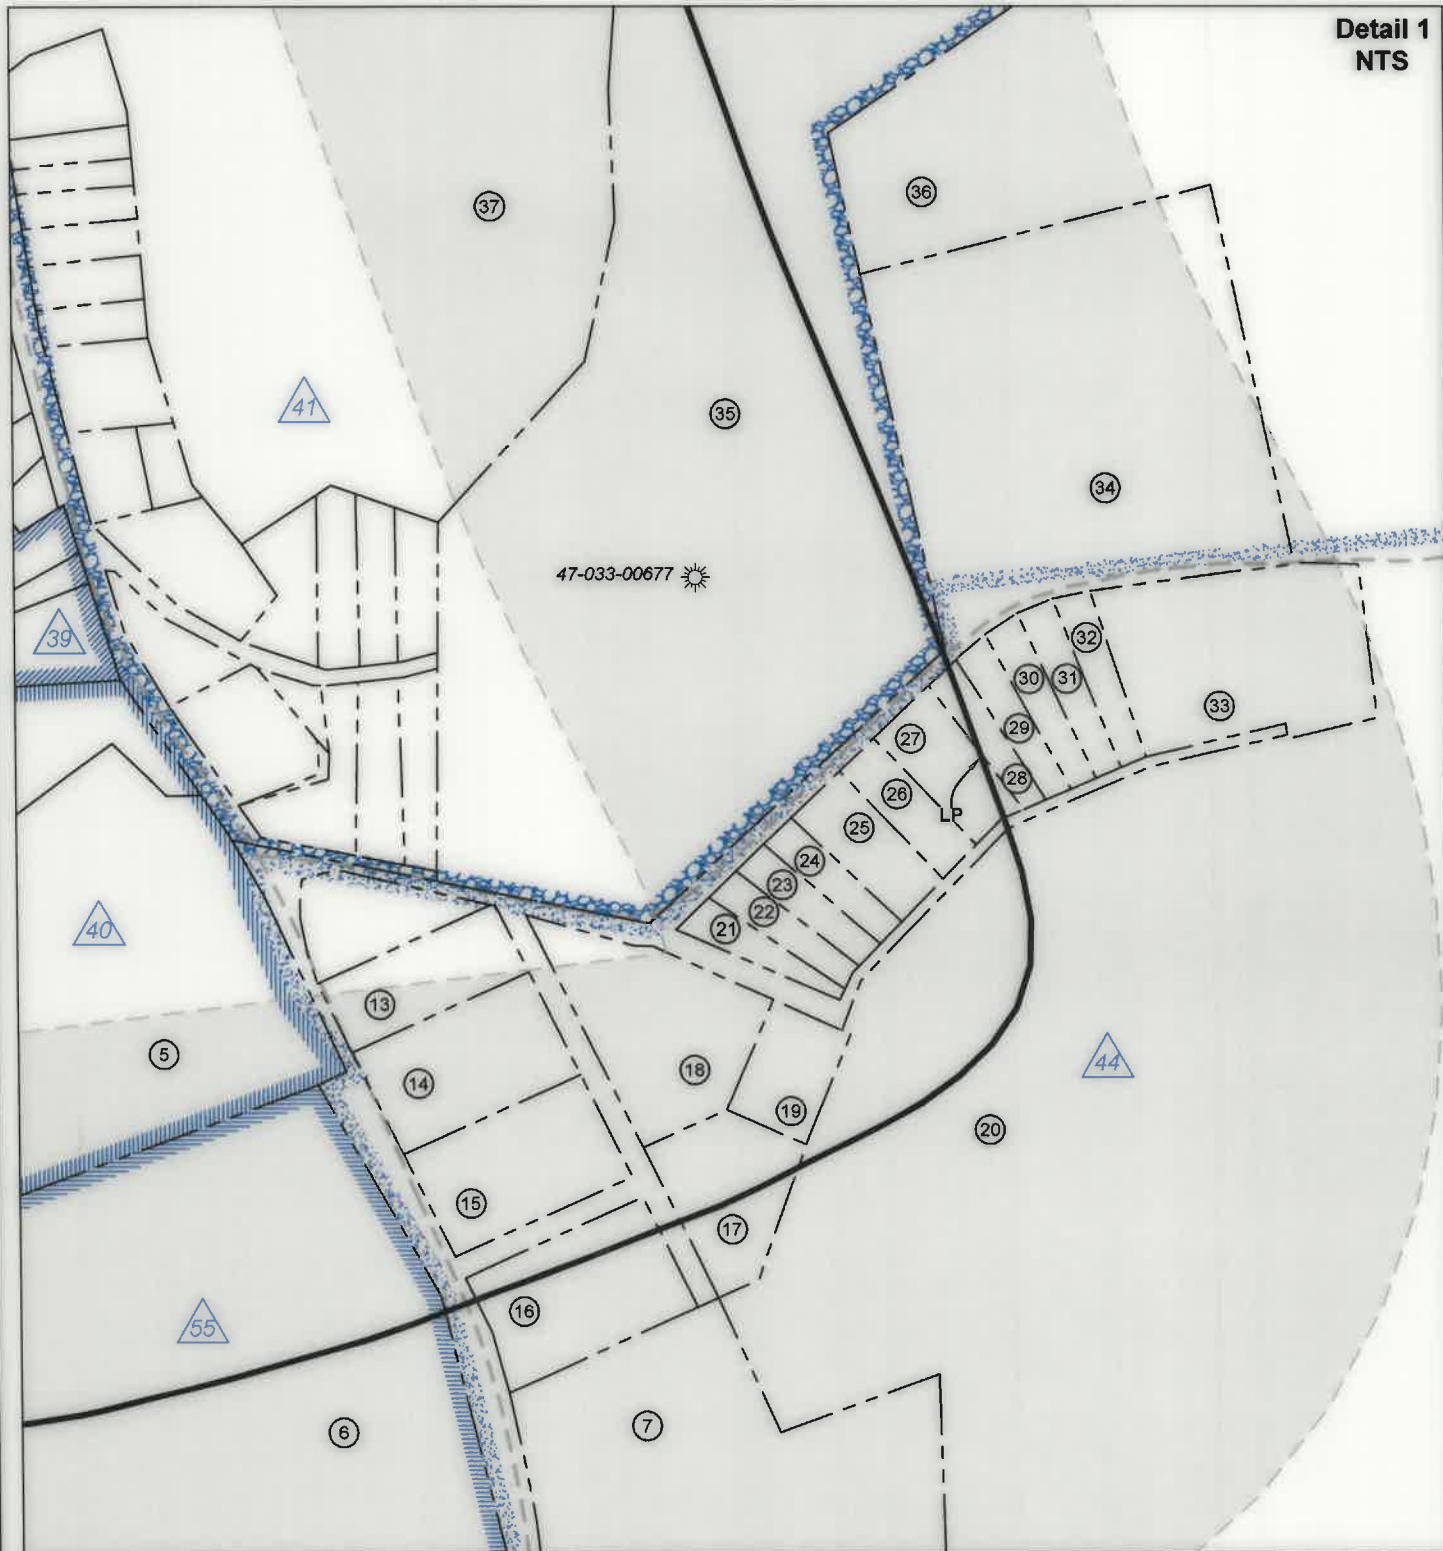

FILE NO: 32-36-G-19  
 DRAWING NO: Schoen 1205 N5H Well Plat  
 SCALE: 1" = 2000'  
 MINIMUM DEGREE OF ACCURACY:  
 Submeter  
 PROVEN SOURCE OF ELEVATION:  
 CORS, Bridgeport, WV

STATE OF WEST VIRGINIA  
 DEPARTMENT OF ENVIRONMENTAL PROTECTION  
 OIL AND GAS DIVISION

DATE: May 14 20 25  
 OPERATOR'S WELL NO. Schoen 1205 N-5H  
 API WELL NO  
 47 - 033 - 06009  
 STATE COUNTY PERMIT

WELL TYPE: ☐ OIL ☒ GAS ☐ LIQUID INJECTION ☐ WASTE DISPOSAL  
 (IF GAS) PRODUCTION: ☐ STORAGE ☐ DEEP ☒ SHALLOW

LOCATION: ELEVATION: 1,407.3' WATERSHED: Middle West Fork Creek

DISTRICT: Grant / Union

SURFACE OWNER: George & Rosanne Schoen

ROYALTY OWNER: Willa Post Robey, et al

LEASE NO: ACREAGE: 78.20

PROPOSED WORK: ☐ DRILL ☐ CONVERT ☐ DRILL DEEPER ☐ FRACTURE OR STIMULATE ☐ PLUG OFF OLD FORMATION  
☐ PERFORATE NEW FORMATION ☒ OTHER PHYSICAL CHANGE IN WELL (SPECIFY) As-Drilled

☐ PLUG AND ABANDON ☐ CLEAN OUT AND REPLUG TARGET FORMATION: Marcellus Shale ESTIMATED DEPTH: 24,662' MD


Top: Mount Clare  
 Btm: West Milford  
 QUADRANGLE:  
 COUNTY: Harrison  
 ACREAGE: 65.00

WELL OPERATOR: HG Energy II Appalachia, LLC  
 ADDRESS: 5260 Dupont Road  
 Parkersburg, WV 26101

DESIGNATED AGENT: Diane C. White  
 ADDRESS: 5260 Dupont Road  
 Parkersburg, WV 26101



Page 3 of 5

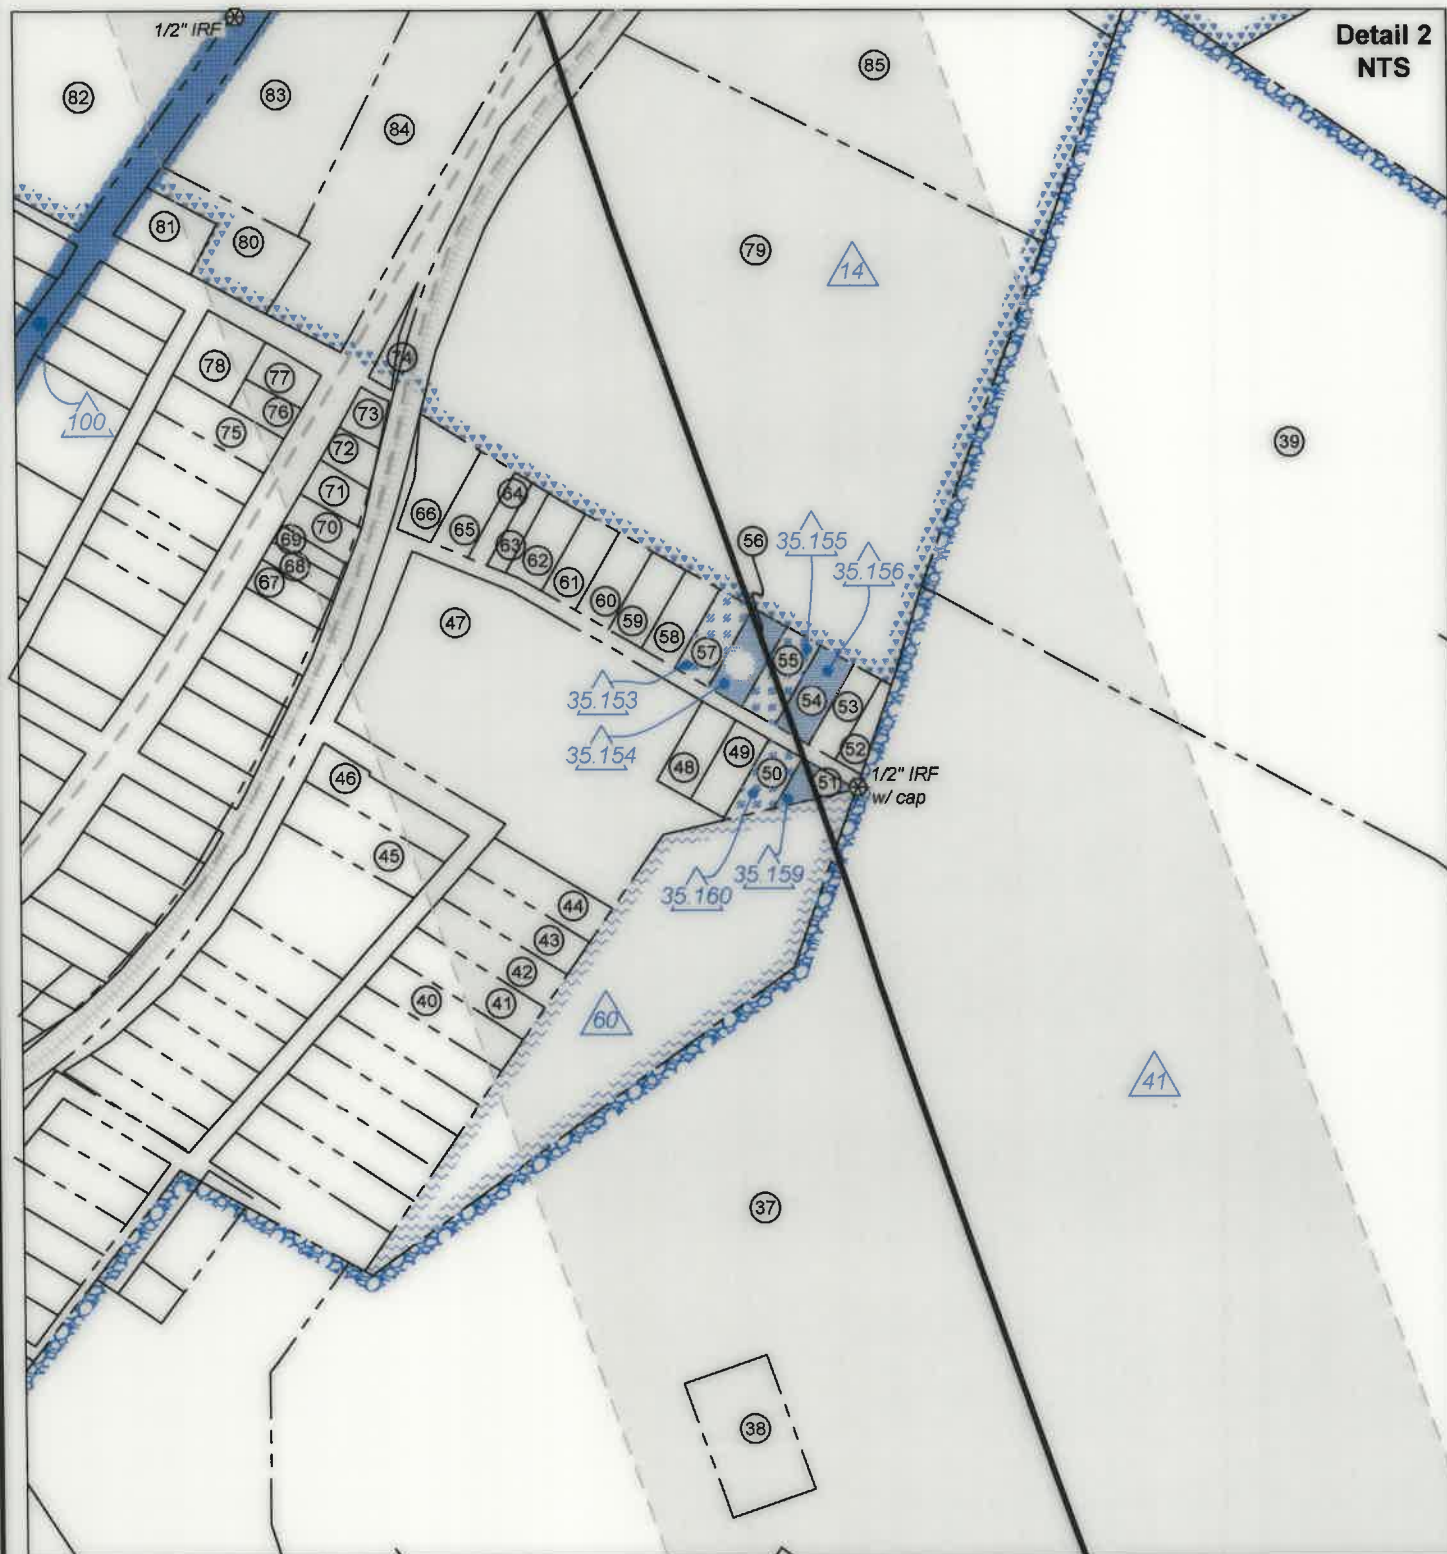


Parkersburg, WV 26101

Parkersburg, WV 26101








Wellhead Layout (NTS)

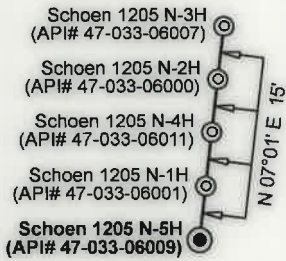

Well Location References  
 Not to Scale

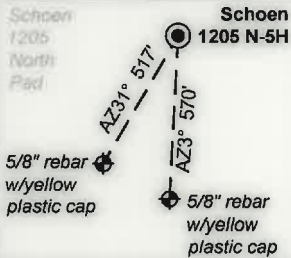

| ID     | Lease                             |
|--------|-----------------------------------|
| 3      | Emory L. & Elzia P. Stout         |
| 4      | Cassie G. Smith, et al            |
| 6      | Edna M. Swisher, et al            |
| 8      | Porter & Bertha B. Maxwell, et al |
| 14     | Mollie V. Bassell, et al          |
| 35.153 | Brenda Joyce Cogar, et al         |
| 35.154 | Charles D. Leeson                 |
| 35.155 | Charles D. Leeson                 |
| 35.156 | Charles D. Leeson                 |
| 35.159 | Charles D. Leeson                 |
| 35.160 | Charles D. Leeson                 |
| 39     | A.B. Post, et al                  |
| 40     | John H. & Charlotte C. Gerlach    |
| 41     | D.L. & Margaret R. Nutter         |
| 44     | Milton S. & Mary I. Davis         |
| 55     | French S. & Anna J. Young         |
| 60     | Betty J. & Isaac H. Maxwell, III  |
| 69     | Jo Ann Murtha                     |
| 100    | WV DOT, Division of Highways      |

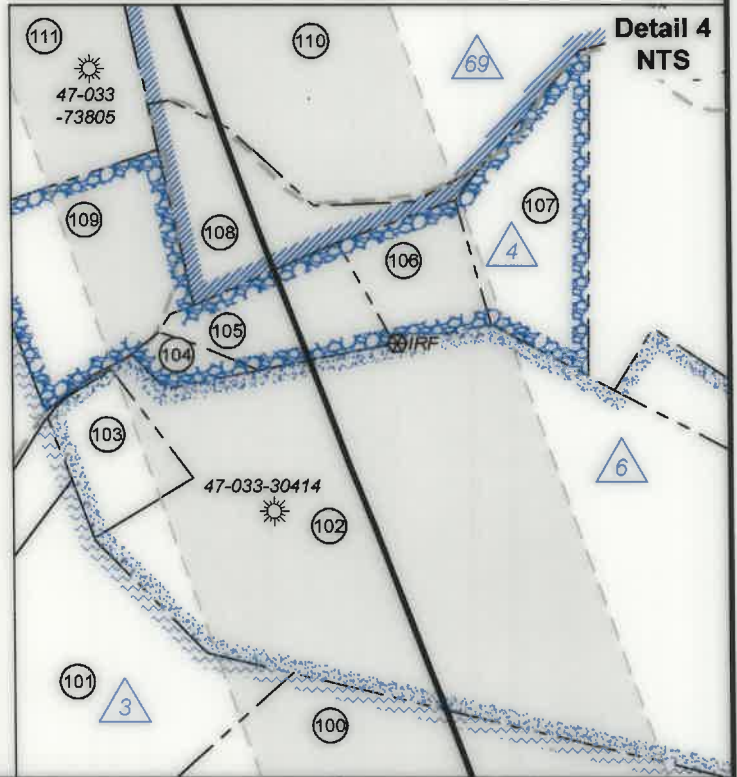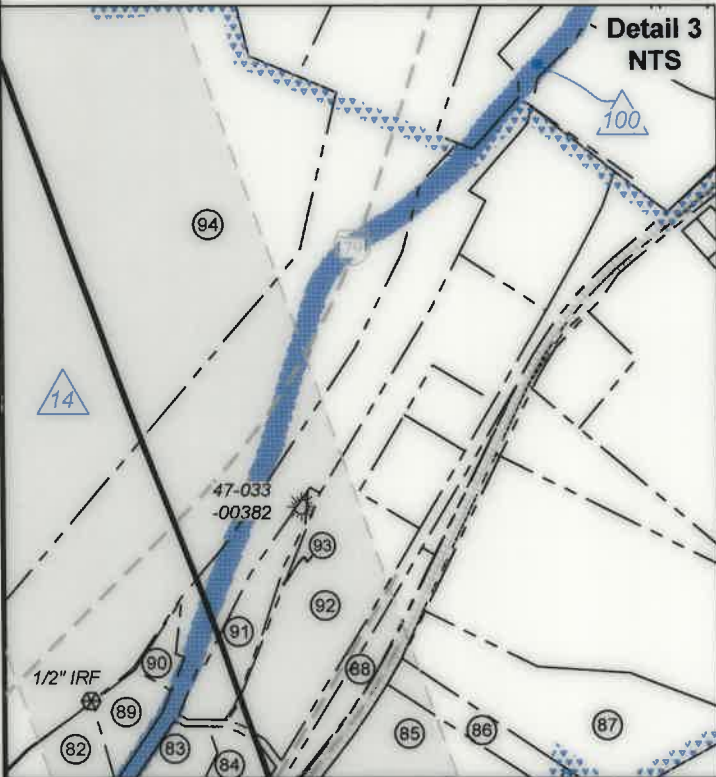

FILE NO: 32-36-G-19  
 DRAWING NO: Schoen 1205 N5H Well Plat  
 SCALE: 1" = 2000'  
 MINIMUM DEGREE OF ACCURACY:  
 Submeter  
 PROVEN SOURCE OF ELEVATION:  
 CORS, Bridgeport, WV

STATE OF WEST VIRGINIA  
 DEPARTMENT OF ENVIRONMENTAL PROTECTION  
 OIL AND GAS DIVISION

DATE: May 14 20 25  
 OPERATOR'S WELL NO. Schoen 1205 N-5H  
 API WELL NO  
 47 - 033 - 06009  
 STATE COUNTY PERMIT

WELL TYPE: ☐ OIL ☒ GAS ☐ LIQUID INJECTION ☐ WASTE DISPOSAL  
 (IF GAS) PRODUCTION: ☐ STORAGE ☐ DEEP ☒ SHALLOW

LOCATION: ELEVATION: 1,407.3' WATERSHED: Middle West Fork Creek

DISTRICT: Grant / Union

SURFACE OWNER: George & Rosanne Schoen

ROYALTY OWNER: Willa Post Robey, et al

LEASE NO: ACREAGE: 78.20

PROPOSED WORK: ☐ DRILL ☐ CONVERT ☐ DRILL DEEPER ☐ FRACTURE OR STIMULATE ☐ PLUG OFF OLD FORMATION  
☐ PERFORATE NEW FORMATION ☒ OTHER PHYSICAL CHANGE IN WELL (SPECIFY) As-Drilled

☐ PLUG AND ABANDON ☐ CLEAN OUT AND REPLUG TARGET FORMATION: Marcellus Shale ESTIMATED DEPTH: 7,412' TVD 24,662' MD

WELL OPERATOR: HG Energy II Appalachia, LLC

DESIGNATED AGENT: Diane C. White

ADDRESS: 5260 Dupont Road

ADDRESS: 5260 Dupont Road

Parkersburg, WV 26101

Parkersburg, WV 26101

Top: Mount Clare  
 QUADRANGLE: Btm: West Milford  
 COUNTY: Grant  
 ACREAGE: 65.00

09/19/2025





| No. | TM / Par   | Owner                         | Bk / Pg     | Ac.    |
|-----|------------|-------------------------------|-------------|--------|
| 1   | 447 / 2    | George & Rosanne Schoen       | 1148 / 1059 | 65.00  |
| 2   | 447 / 3    | George & Rosanne Schoen       | 1253 / 302  | 10.06  |
| 3   | 447 / 3.4  | Stephen M & Kimberly Goff     | 1257 / 189  | 7.67   |
| 4   | 447 / 3.3  | Charlotte C. Gerlach          | 1070 / 1041 | 6.10   |
| 5   | 447 / 3.2  | Michael Tillman & Mary Hencke | 1257 / 193  | 5.86   |
| 6   | 447 / 4.1  | Joseph & Karen Bowers         | 1295 / 887  | 21.87  |
| 7   | 447 / 6.1  | Michael & Charlotte Moses     | 1364 / 7    | 7.20   |
| 8   | 447 / 4.14 | Sarah N. & Andrew D. Spittler | 1622 / 331  | 2.00   |
| 9   | 447 / 4.1  | H. Keith & Diana L. Bramel    | 1438 / 63   | 7.46   |
| 10  | 447 / 4.10 | John L. Breen                 | 1512 / 1161 | 0.92   |
| 11  | 447 / 4.7  | John L. Breen                 | 1512 / 1161 | 2.21   |
| 12  | 447 / 4.12 | John L. Breen                 | 1512 / 1161 | 0.17   |
| 13  | 2105 / 119 | Church of God Trustees        | 1097 / 818  | Lot 23 |
| 14  | 2105 / 120 | Church of God Trustees        | 1097 / 818  | Lot 24 |
| 15  | 2105 / 121 | Charles & Mitzie Reider       | 1646 / 958  | 0.88   |
| 16  | 2105 / 122 | Janice Dean                   | 1456 / 1011 | 0.99   |
| 17  | 2105 / 57  | Thomas & Terri Hawkins        | 1558 / 1255 | 0.76   |
| 18  | 2105 / 56  | Thomas & Terri Hawkins        | 1558 / 1255 | 1.41   |
| 19  | 2105 / 58  | Thomas & Terri Hawkins        | 1558 / 1255 | 0.38   |
| 20  | 447 / 6    | Thomas E. & Terri E. Hawkins  | 1558 / 1255 | 84.25  |
| 21  | 2105 / 59  | Mary Ann Bowyer, et al        | F1118 / 63  | 0.23   |
| 22  | 2105 / 60  | Mary Ann Bowyer, et al        | F118 / 63   | 0.22   |
| 23  | 2105 / 61  | Lisa Hickman                  | 1621 / 760  | 0.21   |
| 24  | 2105 / 62  | Lisa Hickman                  | 1621 / 760  | 0.20   |
| 25  | 2105 / 63  | Lisa Hickman                  | 1621 / 760  | 0.38   |
| 26  | 2105 / 64  | David W. Stutler              | 1482 / 433  | 0.28   |
| 27  | 2105 / 65  | Jean Riffle Estate            | --- / ---   | 0.42   |
| 28  | 2105 / 67  | Jean Riffle Estate            | --- / ---   | 0.21   |
| 29  | 2105 / 68  | Jean Riffle Estate            | --- / ---   | 0.25   |
| 30  | 2105 / 69  | Jean Riffle Estate            | --- / ---   | 0.26   |
| 31  | 2105 / 70  | Kevin R. Kolenda              | 1257 / 800  | 0.26   |
| 32  | 2105 / 71  | Kevin R. Kolenda              | 1257 / 800  | 0.26   |
| 33  | 2105 / 73  | Paul Wintners Estate          | W201 / 472  | 1.53   |
| 34  | 427 / 28.1 | Allen Scott Hall              | 1265 / 589  | 5.40   |
| 35  | 427 / 34   | Worthy C. Hall                | 1577 / 626  | 27.00  |
| 36  | 427 / 28   | Worthy C. Hall                | 1577 / 626  | 248.44 |
| 37  | 427 / 33   | Isaac & Betty Maxwell         | 1539 / 141  | 72.00  |
| 38  | 427 / 33.1 | Greater Harrison Co.          | 1424 / 1161 | 0.48   |
| 39  | 427 / 27   | Worthy C. Hall                | 1577 / 626  | 51.75  |
| 40  | 2103 / 94  | Candice S. Wheeler            | W125 / 113  | 0.25   |
| 41  | 2103 / 88  | Candice S. Wheeler            | W125 / 113  | 0.24   |
| 42  | 2103 / 82  | Candice S. Wheeler            | W125 / 113  | 0.23   |
| 43  | 2103 / 75  | Candice S. Wheeler            | W125 / 113  | 0.22   |
| 44  | 2103 / 68  | Candice S. Wheeler            | W125 / 113  | 0.22   |
| 45  | 2103 / 74  | Eugene N. & Linda S. Alkire   | 1131 / 636  | 0.23   |
| 46  | 2103 / 67  | Charles Melton Estate, et al  | --- / ---   | 0.26   |
| 47  | 2103 / 37  | Christian R. Grymes           | 1516 / 139  | 2.95   |
| 48  | 2103 / 38  | Charles D. Lesson             | 1585 / 664  | ---    |
| 49  | 2103 / 39  | Charles D. Lesson             | 1585 / 664  | ---    |
| 50  | 2103 / 40  | Charles D. Lesson             | 1585 / 664  | ---    |
| 51  | 2103 / 41  | Charles D. Lesson             | 1585 / 664  | ---    |
| 52  | 2103 / 26  | Charles D. Lesson             | 1585 / 664  | ---    |
| 53  | 2103 / 25  | Charles D. Lesson             | 1585 / 664  | ---    |
| 54  | 2103 / 24  | Charles D. Lesson             | 1585 / 664  | ---    |
| 55  | 2103 / 23  | Charles D. Lesson             | 1585 / 664  | ---    |
| 56  | 2103 / 22  | Charles D. Lesson             | 1585 / 664  | ---    |

| No. | TM / Par    | Owner                              | Bk / Pg     | Ac.    |
|-----|-------------|------------------------------------|-------------|--------|
| 57  | 2103 / 21   | Joshua & Harley Miller Cogar       | W174 / 683  | ---    |
| 58  | 2103 / 20   | Joshua & Harley Miller Cogar       | W174 / 683  | ---    |
| 59  | 2103 / 19   | Dennis W. & Rose M. Chamberlain    | 1335 / 911  | ---    |
| 60  | 2103 / 18   | Dennis W. & Rose M. Chamberlain    | 1335 / 911  | ---    |
| 61  | 2103 / 17   | Jonah E. Cogar                     | 1432 / 493  | ---    |
| 62  | 2103 / 16   | Jonah E. Cogar                     | 1432 / 493  | ---    |
| 63  | 2103 / 15.1 | Jonah E. Cogar                     | 1432 / 493  | ---    |
| 64  | 2103 / 15   | Eugene R. Smith Jr.                | 1329 / 532  | ---    |
| 65  | 2103 / 14   | Eugene R. Smith Jr.                | 1329 / 532  | ---    |
| 66  | 2103 / 13   | Drexal L. Mullen                   | W134 / 323  | ---    |
| 67  | 2103 / 51   | Judith A. Corkrean                 | 1148 / 474  | 0.11   |
| 68  | 2103 / 46   | Judith A. Corkrean                 | 1148 / 474  | ---    |
| 69  | 2103 / 46.1 | Judith A. Corkrean                 | 1148 / 474  | ---    |
| 70  | 2103 / 36   | Judith A. Corkrean                 | 1148 / 474  | ---    |
| 71  | 2103 / 31   | Beverly A. Foster                  | 1096 / 205  | ---    |
| 72  | 2103 / 12   | Beverly A. Foster                  | 1096 / 20   | ---    |
| 73  | 2103 / 7    | Beverly A. Foster                  | 1096 / 205  | ---    |
| 74  | 2103 / 2    | Beverly A. Foster                  | 1096 / 205  | ---    |
| 75  | 2103 / 30   | Gregory A. Foster                  | 1404 / 455  | ---    |
| 76  | 2103 / 11   | Gregory A. & Beverly A. Foster     | 1256 / 109  | ---    |
| 77  | 2103 / 6    | Gregory A. & Beverly A. Foster     | 1256 / 109  | ---    |
| 78  | 2103 / 11.1 | Joshua D. Messenger                | 1492 / 197  | 0.24   |
| 79  | 427 / 13    | Dennis & Rose Chamberlain          | 1321 / 102  | 9.25   |
| 80  | 427 / 1.12  | Jerry & Myrna Kincaid              | 1484 / 1045 | 0.30   |
| 81  | 2103 / 1    | Jerry & Myrna Kincaid              | 1484 / 1045 | 0.19   |
| 82  | 427 / 1.6   | Michel M. Lewis                    | 1598 / 301  | 2.45   |
| 83  | 427 / 1.7   | Apostolic Christian                | 1598 / 301  | 3.83   |
| 84  | 427 / 1.13  | Apostolic Christian                | 1598 / 296  | 1.80   |
| 85  | 427 / 14    | Debra & David Shriver              | 1218 / 787  | 4.19   |
| 86  | 427 / 15    | Reid & Vicki Smith                 | 1506 / 332  | 0.63   |
| 87  | 427 / 16    | Reid & Vicy Smith                  | 1336 / 710  | 4.21   |
| 88  | 427 / 1.10  | Charles & Nancy Shock              | 1299 / 472  | 0.80   |
| 89  | 427 / 1.5   | Michel M. Lewis                    | 1444 / 142  | 0.76   |
| 90  | 427 / 1.4   | Walter & David Nutter              | 0.25        | 0.25   |
| 91  | 427 / 1.8   | Apostolic Christian                | 1466 / 825  | 1.41   |
| 92  | 427 / 1.9   | Charles & Nancy Shock              | 1368 / 201  | 5.96   |
| 93  | 427 / 1.14  | Apostolic Christian                | 1596 / 475  | 0.15   |
| 94  | 427 / 1     | Walter E. Nutter & David H. Nutter | 154 / 301   | 228.20 |
| 95  | 427 / 3     | Walter Nutter                      | W154 / 301  | 8.00   |
| 96  | 427 / 48    | Walter E. & David H. Nutter        | W154 / 301  | 33.00  |
| 97  | 427 / 61    | Walter E. & David H. Nutter        | W154 / 301  | 116.16 |
| 98  | 407 / 25    | Richard D. Mendez                  | W168 / 424  | 192.71 |
| 99  | 406 / 25    | Isaac H. III & Betty Jean Maxwell  | 1509/934    | 255.20 |
| 100 | 406 / 27    | James Stout                        | W161 / 306  | 43.50  |
| 101 | 406 / 11    | Mildred Stout                      | 1138 / 993  | 44.80  |
| 102 | 406 / 15    | Danny Haggerty                     | 1362 / 278  | 42.11  |
| 103 | 406 / 15.1  | Danny E. Jr. & Lisa A. Haggerty    | 1497 / 995  | 2.02   |
| 104 | 406 / 13.3  | Williard George Brown              | 1496 / 1170 | 0.58   |
| 105 | 406 / 13.2  | Leonard C. Paugh                   | 1524 / 1195 | 2.56   |
| 106 | 406 / 13    | Leonard C. Paugh                   | 1524 / 1195 | 2.12   |
| 107 | 406 / 14    | Danny E. & Debra D. Haggerty       | 1061 / 11   | 4.00   |
| 108 | 406 / 127.1 | Angela Renee Ricketts              | 1393 / 362  | 4.75   |
| 109 | 406 / 13.1  | Angela Renee Ricketts              | 1408 / 44   | 4.50   |
| 110 | 386 / 127   | Sherry Louise Ricketts             | 916 / 343   | 40.75  |
| 111 | 386 / 126   | Sherry Louise Ricketts             | W114 / 1014 | 7.12   |
| 112 | 386 / 125   | Sherry Louise Ricketts             | W114 / 1014 | 27.69  |

FILE NO: 32-36-G-19  
 DRAWING NO: Schoen 1205 N5H Well Plat  
 SCALE: 1" = 2000'  
 MINIMUM DEGREE OF ACCURACY:  
     Submeter  
 PROVEN SOURCE OF ELEVATION:  
     CORS, Bridgeport, WV

**STATE OF WEST VIRGINIA**  
 DEPARTMENT OF ENVIRONMENTAL PROTECTION  
**OIL AND GAS DIVISION**

DATE: May 14 20 25  
 OPERATOR'S WELL NO. Schoen 1205 N-5H  
**API WELL NO**  
47 - 033 - 06009  
 STATE COUNTY PERMIT

WELL TYPE: ☐ OIL ☒ GAS ☐ LIQUID INJECTION ☐ WASTE DISPOSAL  
 (IF GAS) PRODUCTION: ☐ STORAGE ☐ DEEP ☒ SHALLOW

LOCATION: ELEVATION: 1,407.3' WATERSHED: Middle West Fork Creek

DISTRICT: Grant / Union

SURFACE OWNER: George & Rosanne Schoen

ROYALTY OWNER: Willa Post Robey, et al

LEASE NO: \_\_\_\_\_ ACREAGE: 78.20

PROPOSED WORK: ☐ DRILL ☐ CONVERT ☐ DRILL DEEPER ☐ FRACTURE OR STIMULATE ☐ PLUG OFF OLD FORMATION  
☐ PERFORATE NEW FORMATION ☒ OTHER PHYSICAL CHANGE IN WELL (SPECIFY) As-Drilled

☐ PLUG AND ABANDON ☐ CLEAN OUT AND REPLUG TARGET FORMATION: Marcellus Shale ESTIMATED DEPTH: 7,412' TVD  
24,662' MD

WELL OPERATOR: HG Energy II Appalachia, LLC

DESIGNATED AGENT: Diane C. White

ADDRESS: 5260 Dupont Road

ADDRESS: 5260 Dupont Road

Parkersburg, WV 26101

Parkersburg, WV 26101

Top: Mount Clare  
 Btm: West Milford  
 QUADRANGLE: 09/19/2025  
 COUNTY: Clayton  
 ACREAGE: 65.00