


Parkersburg, WV 26101

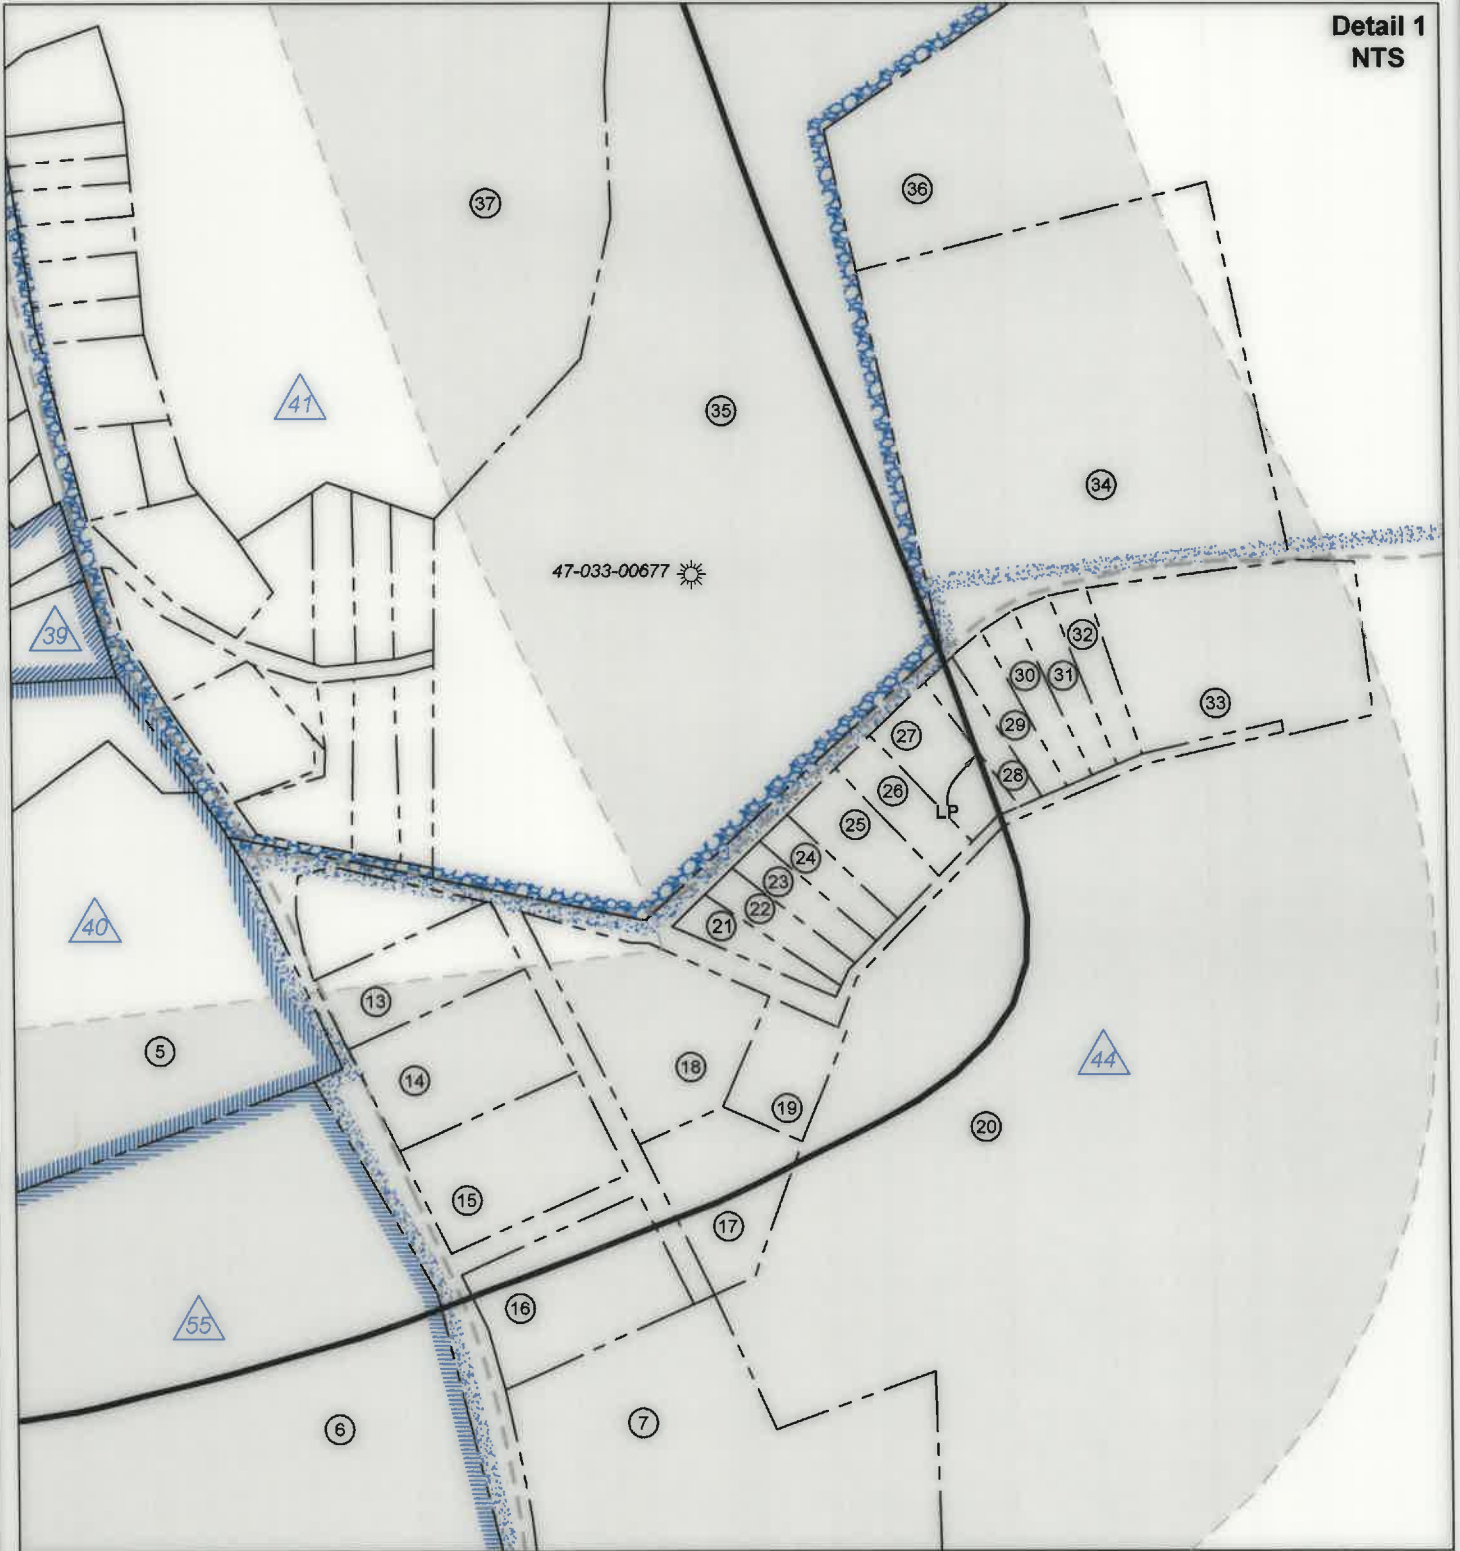

Detail 1
 NTS



FILE NO: 32-36-G-19
 DRAWING NO: Schoen 1205 N5H Well Plat
 SCALE: 1" = 2000'
 MINIMUM DEGREE OF ACCURACY:
 Submeter
 PROVEN SOURCE OF ELEVATION:
 CORS, Bridgeport, WV

STATE OF WEST VIRGINIA
 DEPARTMENT OF ENVIRONMENTAL PROTECTION
 OIL AND GAS DIVISION

DATE: May 14 20 25
 OPERATOR'S WELL NO. Schoen 1205 N-5H
 API WELL NO
 47 - 033 - 06009
 STATE COUNTY PERMIT

WELL TYPE: ☐ OIL ☒ GAS ☐ LIQUID INJECTION ☐ WASTE DISPOSAL
 (IF GAS) PRODUCTION: ☐ STORAGE ☐ DEEP ☒ SHALLOW

LOCATION: ELEVATION: 1,407.3' WATERSHED: Middle West Fork Creek

DISTRICT: Grant / Union

SURFACE OWNER: George & Rosanne Schoen

ROYALTY OWNER: Willa Post Robey, et al

LEASE NO: ACREAGE: 78.20


PROPOSED WORK: ☐ DRILL ☐ CONVERT ☐ DRILL DEEPER ☐ FRACTURE OR STIMULATE ☐ PLUG OFF OLD FORMATION
☐ PERFORATE NEW FORMATION ☒ OTHER PHYSICAL CHANGE IN WELL (SPECIFY) As-Drilled

☐ PLUG AND ABANDON ☐ CLEAN OUT AND REPLUG TARGET FORMATION: Marcellus Shale ESTIMATED DEPTH: 24,662' MD

Top: Mount Clare
 Btm: West Milford
 QUADRANGLE:
 COUNTY: Harrison
 ACREAGE: 65.00

WELL OPERATOR: HG Energy II Appalachia, LLC
 ADDRESS: 5260 Dupont Road
 Parkersburg, WV 26101

DESIGNATED AGENT: Diane C. White
 ADDRESS: 5260 Dupont Road
 Parkersburg, WV 26101

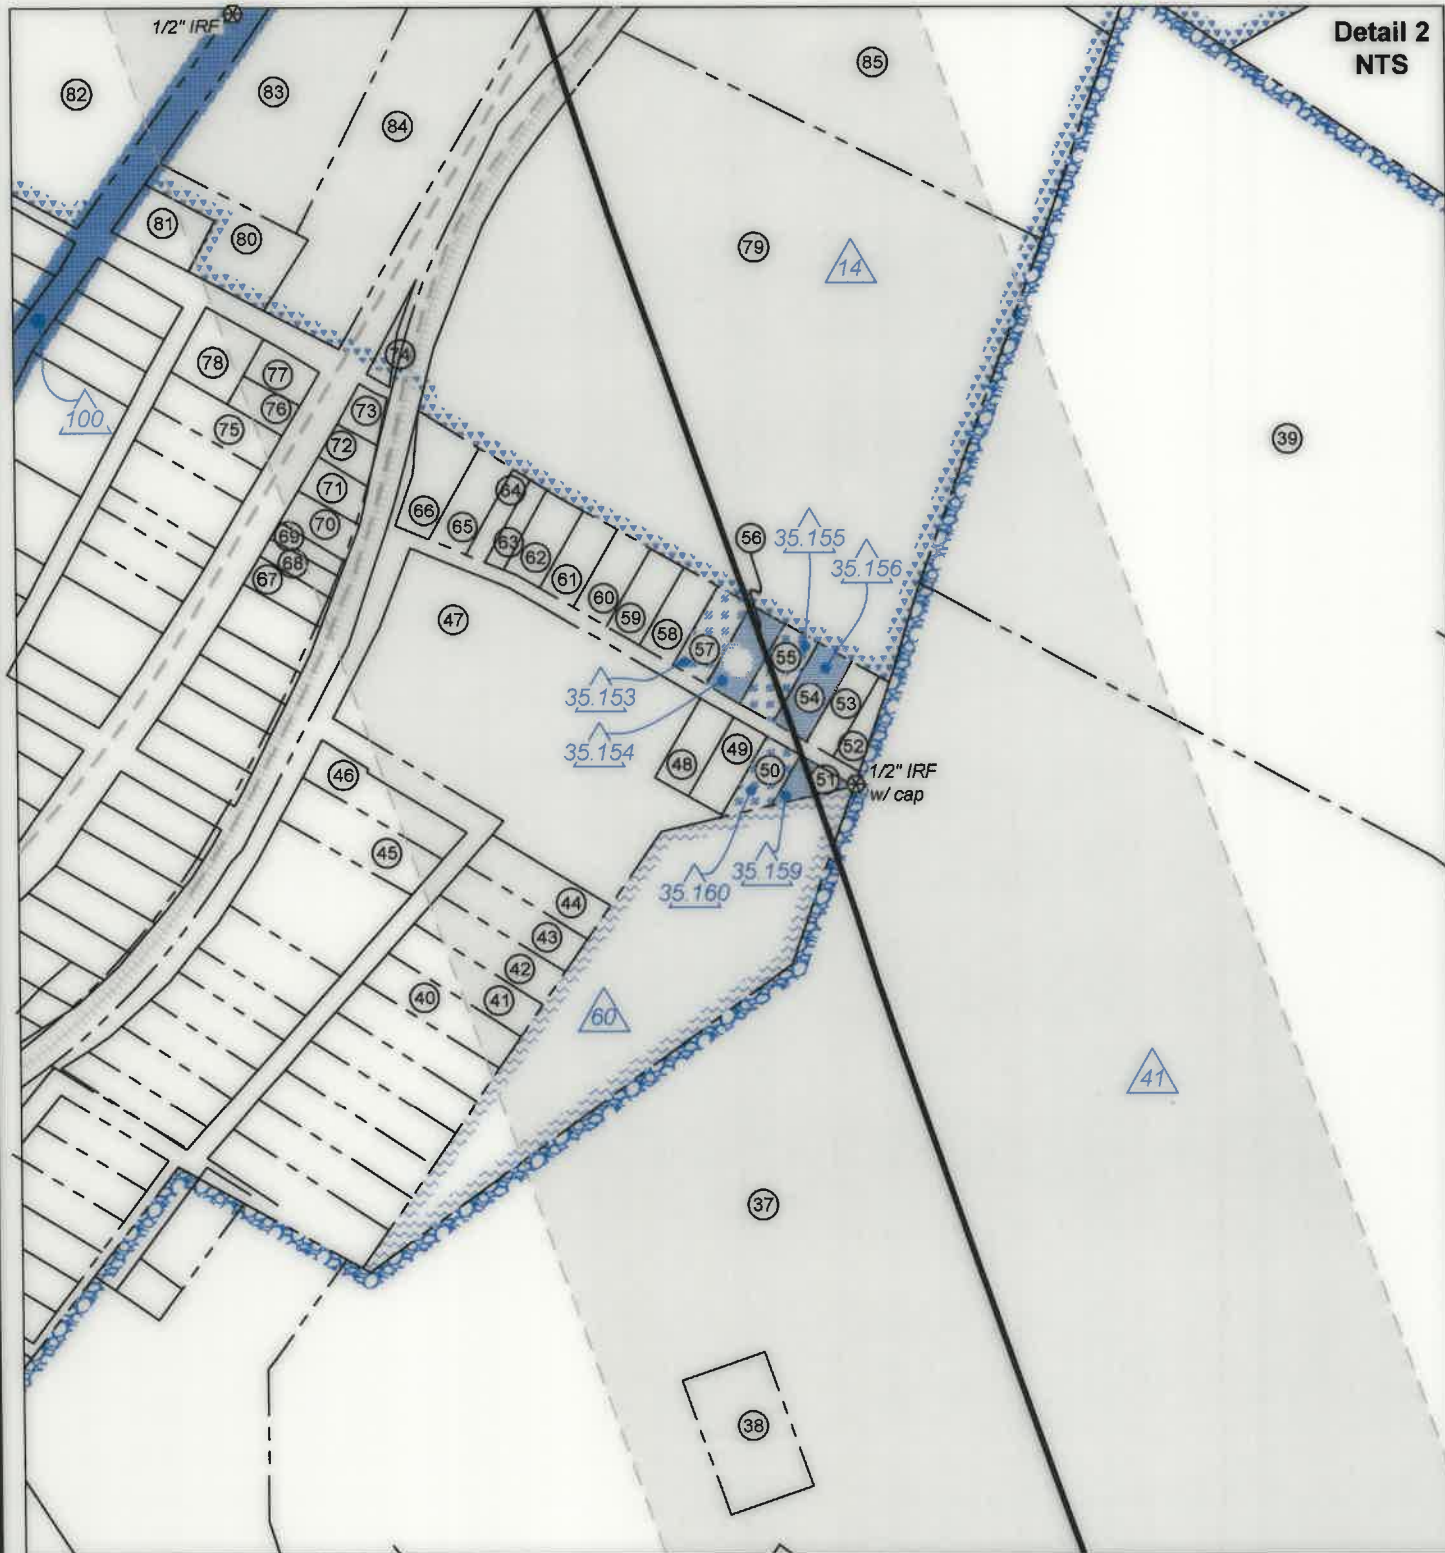

Detail 2
NTS

FILE NO: 32-36-G-19
 DRAWING NO: Schoen 1205 N5H Well Plat
 SCALE: 1" = 2000'
 MINIMUM DEGREE OF ACCURACY:
 Submeter
 PROVEN SOURCE OF ELEVATION:
 CORS, Bridgeport, WV

STATE OF WEST VIRGINIA
 DEPARTMENT OF ENVIRONMENTAL PROTECTION
 OIL AND GAS DIVISION

DATE: May 14 20 25
 OPERATOR'S WELL NO. Schoen 1205 N-5H
 API WELL NO
 47 - 033 - 06009
 STATE COUNTY PERMIT

WELL TYPE: ☐ OIL ☒ GAS ☐ LIQUID INJECTION ☐ WASTE DISPOSAL
 (IF GAS) PRODUCTION: ☐ STORAGE ☐ DEEP ☒ SHALLOW

LOCATION: ELEVATION: 1,407.3' WATERSHED: Middle West Fork Creek

DISTRICT: Grant / Union

SURFACE OWNER: George & Rosanne Schoen

ROYALTY OWNER: Willa Post Robey, et al

LEASE NO: ACREAGE: 78.20

PROPOSED WORK: ☐ DRILL ☐ CONVERT ☐ DRILL DEEPER ☐ FRACTURE OR STIMULATE ☐ PLUG OFF OLD FORMATION
☐ PERFORATE NEW FORMATION ☒ OTHER PHYSICAL CHANGE IN WELL (SPECIFY) As-Drilled

☐ PLUG AND ABANDON ☐ CLEAN OUT AND REPLUG TARGET FORMATION: Marcellus Shale ESTIMATED DEPTH: 24,662' MD

Top: Mount Clare
 Btm: West Milford
 QUADRANGLE:
 COUNTY: Harrison
 ACREAGE: 65.00

WELL OPERATOR: HG Energy II Appalachia, LLC

DESIGNATED AGENT: Diane C. White

ADDRESS: 5260 Dupont Road


ADDRESS: 5260 Dupont Road

Parkersburg, WV 26101


Parkersburg, WV 26101



Wellhead Layout (NTS)

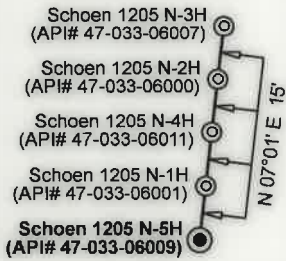


Well Location References
 Not to Scale

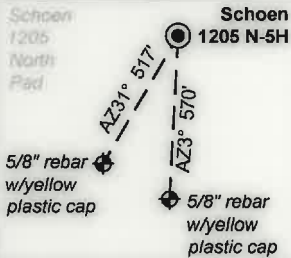


ID	Lease
3	Emory L. & Elzia P. Stout
4	Cassie G. Smith, et al
6	Edna M. Swisher, et al
8	Porter & Bertha B. Maxwell, et al
14	Mollie V. Bassell, et al
35.153	Brenda Joyce Cogar, et al
35.154	Charles D. Leeson
35.155	Charles D. Leeson
35.156	Charles D. Leeson
35.159	Charles D. Leeson
35.160	Charles D. Leeson
39	A.B. Post, et al
40	John H. & Charlotte C. Gerlach
41	D.L. & Margaret R. Nutter
44	Milton S. & Mary I. Davis
55	French S. & Anna J. Young
60	Betty J. & Isaac H. Maxwell, III
69	Jo Ann Murtha
100	WV DOT, Division of Highways

Detail 3
 NTS

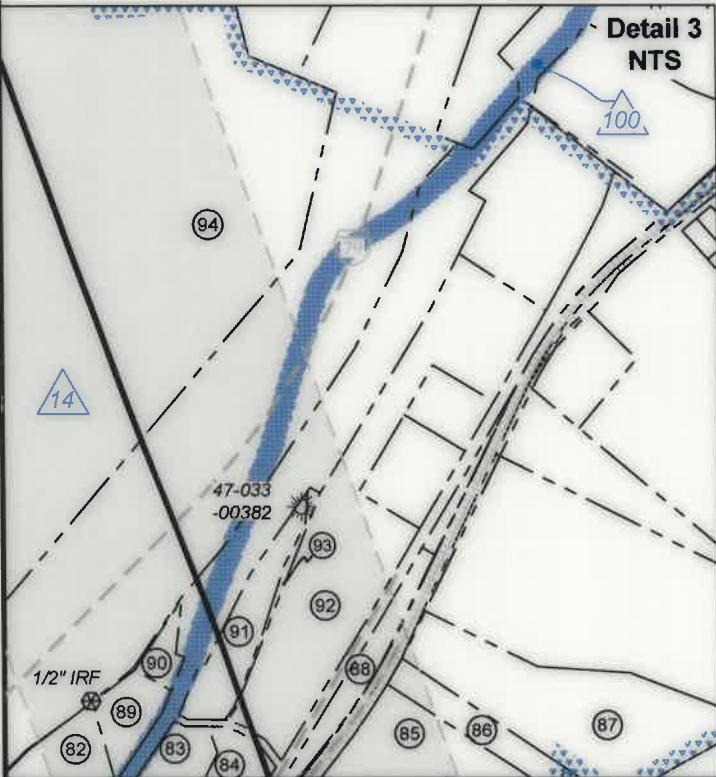

Detail 4
 NTS

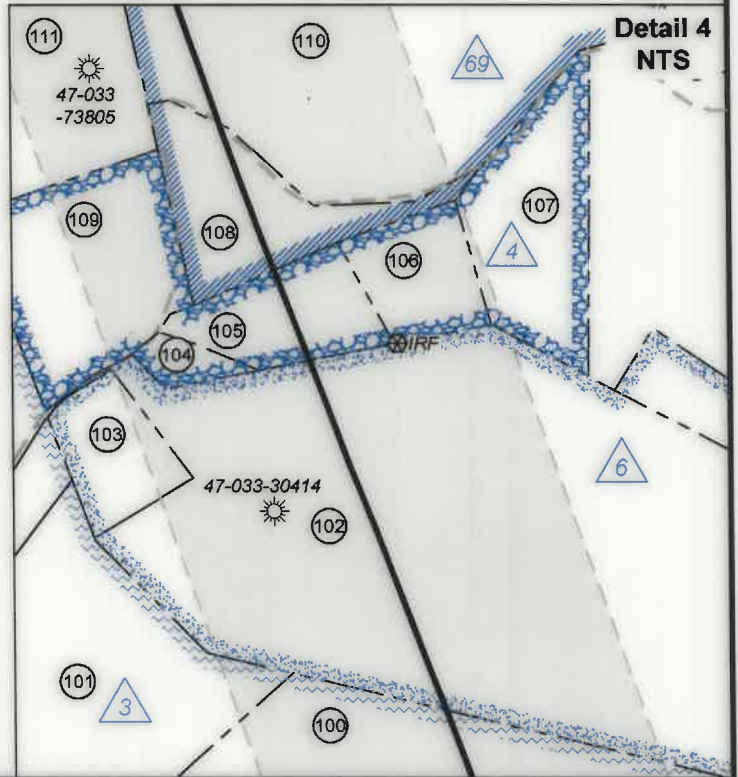

FILE NO: 32-36-G-19
 DRAWING NO: Schoen 1205 N5H Well Plat
 SCALE: 1" = 2000'
 MINIMUM DEGREE OF ACCURACY:
 Submeter
 PROVEN SOURCE OF ELEVATION:
 CORS, Bridgeport, WV

STATE OF WEST VIRGINIA
 DEPARTMENT OF ENVIRONMENTAL PROTECTION
 OIL AND GAS DIVISION

DATE: May 14 20 25
 OPERATOR'S WELL NO. Schoen 1205 N-5H

API WELL NO

47 - 033 - 06009
 STATE COUNTY PERMIT

WELL TYPE: ☐ OIL ☒ GAS ☐ LIQUID INJECTION ☐ WASTE DISPOSAL
 (IF GAS) PRODUCTION: ☐ STORAGE ☐ DEEP ☒ SHALLOW

LOCATION: ELEVATION: 1,407.3' WATERSHED: Middle West Fork Creek

DISTRICT: Grant / Union

SURFACE OWNER: George & Rosanne Schoen

ROYALTY OWNER: Willa Post Robey, et al

LEASE NO: ACREAGE: 78.20

PROPOSED WORK: ☐ DRILL ☐ CONVERT ☐ DRILL DEEPER ☐ FRACTURE OR STIMULATE ☐ PLUG OFF OLD FORMATION
☐ PERFORATE NEW FORMATION ☒ OTHER PHYSICAL CHANGE IN WELL (SPECIFY) As-Drilled

☐ PLUG AND ABANDON ☐ CLEAN OUT AND REPLUG TARGET FORMATION: Marcellus Shale ESTIMATED DEPTH: 7,412' TVD 24,662' MD

WELL OPERATOR: HG Energy II Appalachia, LLC

DESIGNATED AGENT: Diane C. White

ADDRESS: 5260 Dupont Road
 Parkersburg, WV 26101

ADDRESS: 5260 Dupont Road
 Parkersburg, WV 26101

Top: Mount Clare
 QUADRANGLE: Btm: West Milford
 COUNTY: Harrison
 ACREAGE: 65.00

09/19/2025



No.	TM / Par	Owner	Bk / Pg	Ac.
1	447 / 2	George & Rosanne Schoen	1148 / 1059	65.00
2	447 / 3	George & Rosanne Schoen	1253 / 302	10.06
3	447 / 3.4	Stephen M & Kimberly Goff	1257 / 189	7.67
4	447 / 3.3	Charlotte C. Gerlach	1070 / 1041	6.10
5	447 / 3.2	Michael Tillman & Mary Hencke	1257 / 193	5.86
6	447 / 4.1	Joseph & Karen Bowers	1295 / 887	21.87
7	447 / 6.1	Michael & Charlotte Moses	1364 / 7	7.20
8	447 / 4.14	Sarah N. & Andrew D. Spittler	1622 / 331	2.00
9	447 / 4.1	H. Keith & Diana L. Bramel	1438 / 63	7.46
10	447 / 4.10	John L. Breen	1512 / 1161	0.92
11	447 / 4.7	John L. Breen	1512 / 1161	2.21
12	447 / 4.12	John L. Breen	1512 / 1161	0.17
13	2105 / 119	Church of God Trustees	1097 / 818	Lot 23
14	2105 / 120	Church of God Trustees	1097 / 818	Lot 24
15	2105 / 121	Charles & Mitzie Reider	1646 / 958	0.88
16	2105 / 122	Janice Dean	1456 / 1011	0.99
17	2105 / 57	Thomas & Terri Hawkins	1558 / 1255	0.76
18	2105 / 56	Thomas & Terri Hawkins	1558 / 1255	1.41
19	2105 / 58	Thomas & Terri Hawkins	1558 / 1255	0.38
20	447 / 6	Thomas E. & Terri E. Hawkins	1558 / 1255	84.25
21	2105 / 59	Mary Ann Bowyer, et al	F1118 / 63	0.23
22	2105 / 60	Mary Ann Bowyer, et al	F118 / 63	0.22
23	2105 / 61	Lisa Hickman	1621 / 760	0.21
24	2105 / 62	Lisa Hickman	1621 / 760	0.20
25	2105 / 63	Lisa Hickman	1621 / 760	0.38
26	2105 / 64	David W. Stutler	1482 / 433	0.28
27	2105 / 65	Jean Riffle Estate	--- / ---	0.42
28	2105 / 67	Jean Riffle Estate	--- / ---	0.21
29	2105 / 68	Jean Riffle Estate	--- / ---	0.25
30	2105 / 69	Jean Riffle Estate	--- / ---	0.26
31	2105 / 70	Kevin R. Kolenda	1257 / 800	0.26
32	2105 / 71	Kevin R. Kolenda	1257 / 800	0.26
33	2105 / 73	Paul Wintners Estate	W201 / 472	1.53
34	427 / 28.1	Allen Scott Hall	1265 / 589	5.40
35	427 / 34	Worthy C. Hall	1577 / 626	27.00
36	427 / 28	Worthy C. Hall	1577 / 626	248.44
37	427 / 33	Isaac & Betty Maxwell	1539 / 141	72.00
38	427 / 33.1	Greater Harrison Co.	1424 / 1161	0.48
39	427 / 27	Worthy C. Hall	1577 / 626	51.75
40	2103 / 94	Candice S. Wheeler	W125 / 113	0.25
41	2103 / 88	Candice S. Wheeler	W125 / 113	0.24
42	2103 / 82	Candice S. Wheeler	W125 / 113	0.23
43	2103 / 75	Candice S. Wheeler	W125 / 113	0.22
44	2103 / 68	Candice S. Wheeler	W125 / 113	0.22
45	2103 / 74	Eugene N. & Linda S. Alkire	1131 / 636	0.23
46	2103 / 67	Charles Melton Estate, et al	--- / ---	0.26
47	2103 / 37	Christian R. Grymes	1516 / 139	2.95
48	2103 / 38	Charles D. Lesson	1585 / 664	---
49	2103 / 39	Charles D. Lesson	1585 / 664	---
50	2103 / 40	Charles D. Lesson	1585 / 664	---
51	2103 / 41	Charles D. Lesson	1585 / 664	---
52	2103 / 26	Charles D. Lesson	1585 / 664	---
53	2103 / 25	Charles D. Lesson	1585 / 664	---
54	2103 / 24	Charles D. Lesson	1585 / 664	---
55	2103 / 23	Charles D. Lesson	1585 / 664	---
56	2103 / 22	Charles D. Lesson	1585 / 664	---

No.	TM / Par	Owner	Bk / Pg	Ac.
57	2103 / 21	Joshua & Harley Miller Cogar	W174 / 683	---
58	2103 / 20	Joshua & Harley Miller Cogar	W174 / 683	---
59	2103 / 19	Dennis W. & Rose M. Chamberlain	1335 / 911	---
60	2103 / 18	Dennis W. & Rose M. Chamberlain	1335 / 911	---
61	2103 / 17	Jonah E. Cogar	1432 / 493	---
62	2103 / 16	Jonah E. Cogar	1432 / 493	---
63	2103 / 15.1	Jonah E. Cogar	1432 / 493	---
64	2103 / 15	Eugene R. Smith Jr.	1329 / 532	---
65	2103 / 14	Eugene R. Smith Jr.	1329 / 532	---
66	2103 / 13	Drexal L. Mullen	W134 / 323	---
67	2103 / 51	Judith A. Corkrean	1148 / 474	0.11
68	2103 / 46	Judith A. Corkrean	1148 / 474	---
69	2103 / 46.1	Judith A. Corkrean	1148 / 474	---
70	2103 / 36	Judith A. Corkrean	1148 / 474	---
71	2103 / 31	Beverly A. Foster	1096 / 205	---
72	2103 / 12	Beverly A. Foster	1096 / 20	---
73	2103 / 7	Beverly A. Foster	1096 / 205	---
74	2103 / 2	Beverly A. Foster	1096 / 205	---
75	2103 / 30	Gregory A. Foster	1404 / 455	---
76	2103 / 11	Gregory A. & Beverly A. Foster	1256 / 109	---
77	2103 / 6	Gregory A. & Beverly A. Foster	1256 / 109	---
78	2103 / 11.1	Joshua D. Messenger	1492 / 197	0.24
79	427 / 13	Dennis & Rose Chamberlain	1321 / 102	9.25
80	427 / 1.12	Jerry & Myrna Kincaid	1484 / 1045	0.30
81	2103 / 1	Jerry & Myrna Kincaid	1484 / 1045	0.19
82	427 / 1.6	Michel M. Lewis	1598 / 301	2.45
83	427 / 1.7	Apostolic Christian	1598 / 301	3.83
84	427 / 1.13	Apostolic Christian	1598 / 296	1.80
85	427 / 14	Debra & David Shriver	1218 / 787	4.19
86	427 / 15	Reid & Vicki Smith	1506 / 332	0.63
87	427 / 16	Reid & Vicy Smith	1336 / 710	4.21
88	427 / 1.10	Charles & Nancy Shock	1299 / 472	0.80
89	427 / 1.5	Michel M. Lewis	1444 / 142	0.76
90	427 / 1.4	Walter & David Nutter	0.25	0.25
91	427 / 1.8	Apostolic Christian	1466 / 825	1.41
92	427 / 1.9	Charles & Nancy Shock	1368 / 201	5.96
93	427 / 1.14	Apostolic Christian	1596 / 475	0.15
94	427 / 1	Walter E. Nutter & David H. Nutter	154 / 301	228.20
95	427 / 3	Walter Nutter	W154 / 301	8.00
96	427 / 48	Walter E. & David H. Nutter	W154 / 301	33.00
97	427 / 61	Walter E. & David H. Nutter	W154 / 301	116.16
98	407 / 25	Richard D. Mendez	W168 / 424	192.71
99	406 / 25	Isaac H. III & Betty Jean Maxwell	1509/934	255.20
100	406 / 27	James Stout	W161 / 306	43.50
101	406 / 11	Mildred Stout	1138 / 993	44.80
102	406 / 15	Danny Haggerty	1362 / 278	42.11
103	406 / 15.1	Danny E. Jr. & Lisa A. Haggerty	1497 / 995	2.02
104	406 / 13.3	Williard George Brown	1496 / 1170	0.58
105	406 / 13.2	Leonard C. Paugh	1524 / 1195	2.56
106	406 / 13	Leonard C. Paugh	1524 / 1195	2.12
107	406 / 14	Danny E. & Debra D. Haggerty	1061 / 11	4.00
108	406 / 127.1	Angela Renee Ricketts	1393 / 362	4.75
109	406 / 13.1	Angela Renee Ricketts	1408 / 44	4.50
110	386 / 127	Sherry Louise Ricketts	916 / 343	40.75
111	386 / 126	Sherry Louise Ricketts	W114 / 1014	7.12
112	386 / 125	Sherry Louise Ricketts	W114 / 1014	27.69

FILE NO: 32-36-G-19
 DRAWING NO: Schoen 1205 N5H Well Plat
 SCALE: 1" = 2000'
 MINIMUM DEGREE OF ACCURACY:
 Submeter
 PROVEN SOURCE OF ELEVATION:
 CORS, Bridgeport, WV

STATE OF WEST VIRGINIA
 DEPARTMENT OF ENVIRONMENTAL PROTECTION
OIL AND GAS DIVISION

DATE: May 14 20 25
 OPERATOR'S WELL NO. Schoen 1205 N-5H
API WELL NO
47 - 033 - 06009
 STATE COUNTY PERMIT

WELL TYPE: ☐ OIL ☒ GAS ☐ LIQUID INJECTION ☐ WASTE DISPOSAL
 (IF GAS) PRODUCTION: ☐ STORAGE ☐ DEEP ☒ SHALLOW

LOCATION: ELEVATION: 1,407.3' WATERSHED: Middle West Fork Creek

DISTRICT: Grant / Union

SURFACE OWNER: George & Rosanne Schoen

ROYALTY OWNER: Willa Post Robey, et al

LEASE NO: _____ ACREAGE: 78.20

PROPOSED WORK: ☐ DRILL ☐ CONVERT ☐ DRILL DEEPER ☐ FRACTURE OR STIMULATE ☐ PLUG OFF OLD FORMATION
☐ PERFORATE NEW FORMATION ☒ OTHER PHYSICAL CHANGE IN WELL (SPECIFY) As-Drilled

☐ PLUG AND ABANDON ☐ CLEAN OUT AND REPLUG TARGET FORMATION: Marcellus Shale ESTIMATED DEPTH: 7,412' TVD
24,662' MD

WELL OPERATOR: HG Energy II Appalachia, LLC

DESIGNATED AGENT: Diane C. White

ADDRESS: 5260 Dupont Road

ADDRESS: 5260 Dupont Road

Parkersburg, WV 26101

Parkersburg, WV 26101

Top: Mount Clare
 Btm: West Milford
 QUADRANGLE: 09/19/2025
 ACREAGE: 65.00