

**HG Energy II
Appalachia, LLC**
Well No. Schoen
1205 N-4H
As-Drilled




West Virginia Coordinate
System of 1927, North Zone
based upon Differential GPS
Measurements.

Notes: Well No.
Schoen 1205 N-4H
WVCS 1927, North Zone
Top Hole Coordinates
Lat: 39°09'08.25"
Lon: 80°21'07.61"
Landing Point Coordinates
Lat: 39°09'13.53"
Lon: 80°20'48.53"
Bottom Hole Coordinates
Lat: 39°10'57.28"
Lon: 80°21'35.65"

UTM Zone 17, NAD 1983
Plat orientation and corner and well references are
based upon the grid north meridian. Well location references
are based upon the magnetic meridian.

Notes: Well No.
Schoen 1205 N-4H
UTM NAD 1983 (USFS)
Top Hole Coordinates
N: 14,218,761.17'
E: 1,824,135.54'
Landing Point Coordinates
N: 14,219,306.08'
E: 1,825,634.54'
Bottom Hole Coordinates
N: 14,229,772.45'
E: 1,821,849.68'

Notes: Well No.
Schoen 1205 N-4H
UTM NAD 1983 (Meters)
Top Hole Coordinates
N: 4,333,887.072m
E: 555,997.625m
Landing Point Coordinates
N: 4,334,053.161m
E: 556,454.521m
Bottom Hole Coordinates
N: 4,337,243.317m
E: 555,300.893m

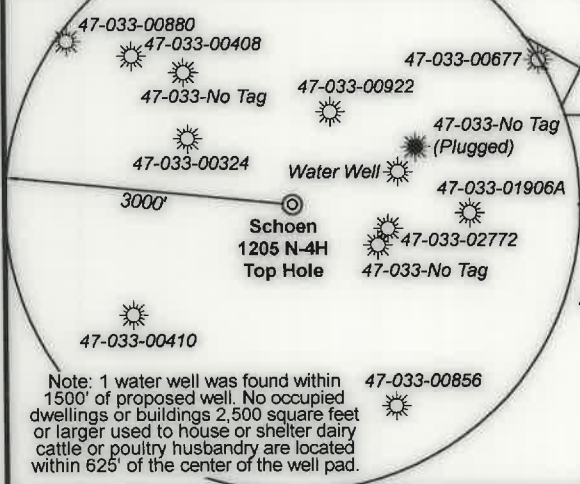

Note: 1 water well was found within
1500' of proposed well. No occupied
dwellings or buildings 2,500 square feet
or larger used to house or shelter dairy
cattle or poultry husbandry are located
within 625' of the center of the well pad.

GRID NORTH

7,529' to Bottom Hole

5,324' to Top Hole
BTM LATITUDE 39 - 12 - 30
TOP LATITUDE 39 - 10 - 00

Legend

- Proposed gas well
- Well Reference, as noted
- Monument, as noted
- Existing Well, as noted
- Existing Plugged Well, as noted
- Digitized Well, as noted
- Surface boundary (approx.)
- Interior surface tracts (approx.)
- Creek or Drain
- Existing Road
- Railroad Tracks

LONGITUDE 80 - 20 - 00

5,234' to Top Hole
9,378' to Bottom Hole




SEAL

I, the undersigned, hereby certify
that this plat is correct to the best
of my knowledge and belief and
shows all the information required
by law and the rules issued and
prescribed by the Department of
Environmental Protection.

Dwayne D. Matheny
Dwayne D. Matheny, P.S. 2070

Wellhead Layout (NTS)

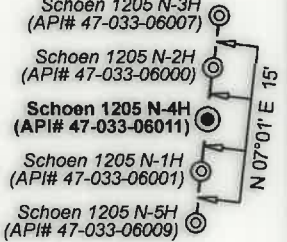

Schoen 1205 N-3H
(API# 47-033-06007)

Schoen 1205 N-2H
(API# 47-033-06000)

Schoen 1205 N-4H
(API# 47-033-06011)

Schoen 1205 N-1H
(API# 47-033-06001)

Schoen 1205 N-5H
(API# 47-033-06009)

Tag	Bearing	Dist.
L1	N 54°46' W	1,105.8'
L2	S 79°00' W	1,193.9'
L3	S 70°58' E	1,190.0'
L4	S 83°32' E	1,492.9'

FILE NO: 32-36-G-19
DRAWING NO: Schoen 1205 N4H Well Plat
SCALE: 1" = 2000'
MINIMUM DEGREE OF ACCURACY:
Submeter
PROVEN SOURCE OF ELEVATION:
CORS, Bridgeport, WV

STATE OF WEST VIRGINIA
DEPARTMENT OF ENVIRONMENTAL PROTECTION
OIL AND GAS DIVISION

DATE: May 14 20 25
OPERATOR'S WELL NO. Schoen 1205 N-4H
API WELL NO
47 - 033 - 06011
STATE COUNTY PERMIT

WELL TYPE: ☐ OIL ☒ GAS ☐ LIQUID INJECTION ☐ WASTE DISPOSAL
(IF GAS) PRODUCTION: ☐ STORAGE ☐ DEEP ☒ SHALLOW

LOCATION: ELEVATION: 1,407.3' WATERSHED: Middle West Fork Creek
DISTRICT: Grant / Union

SURFACE OWNER: George & Rosanne Schoen
ROYALTY OWNER: Willa Post Robey, et al LEASE NO: ACREAGE: 78.20

PROPOSED WORK: ☒ DRILL ☐ CONVERT ☐ DRILL DEEPER ☐ FRACTURE OR STIMULATE ☐ PLUG OFF OLD FORMATION
☐ PERFORATE NEW FORMATION ☒ OTHER PHYSICAL CHANGE IN WELL (SPECIFY) As-Drilled

☐ PLUG AND ABANDON ☐ CLEAN OUT AND REPLUG TARGET FORMATION: Marcellus Shale ESTIMATED DEPTH: 18,884' MD 7,419' TVD


WELL OPERATOR: HG Energy II Appalachia, LLC DESIGNATED AGENT: Diane C. White
ADDRESS: 5260 Dupont Road ADDRESS: 5260 Dupont Road
Parkersburg, WV 26101 Parkersburg, WV 26101



HG Energy II
Appalachia, LLC
Well No. Schoen
1205 N-4H
As-Drilled

Page 3 of 5

Detail 2 (NTS)

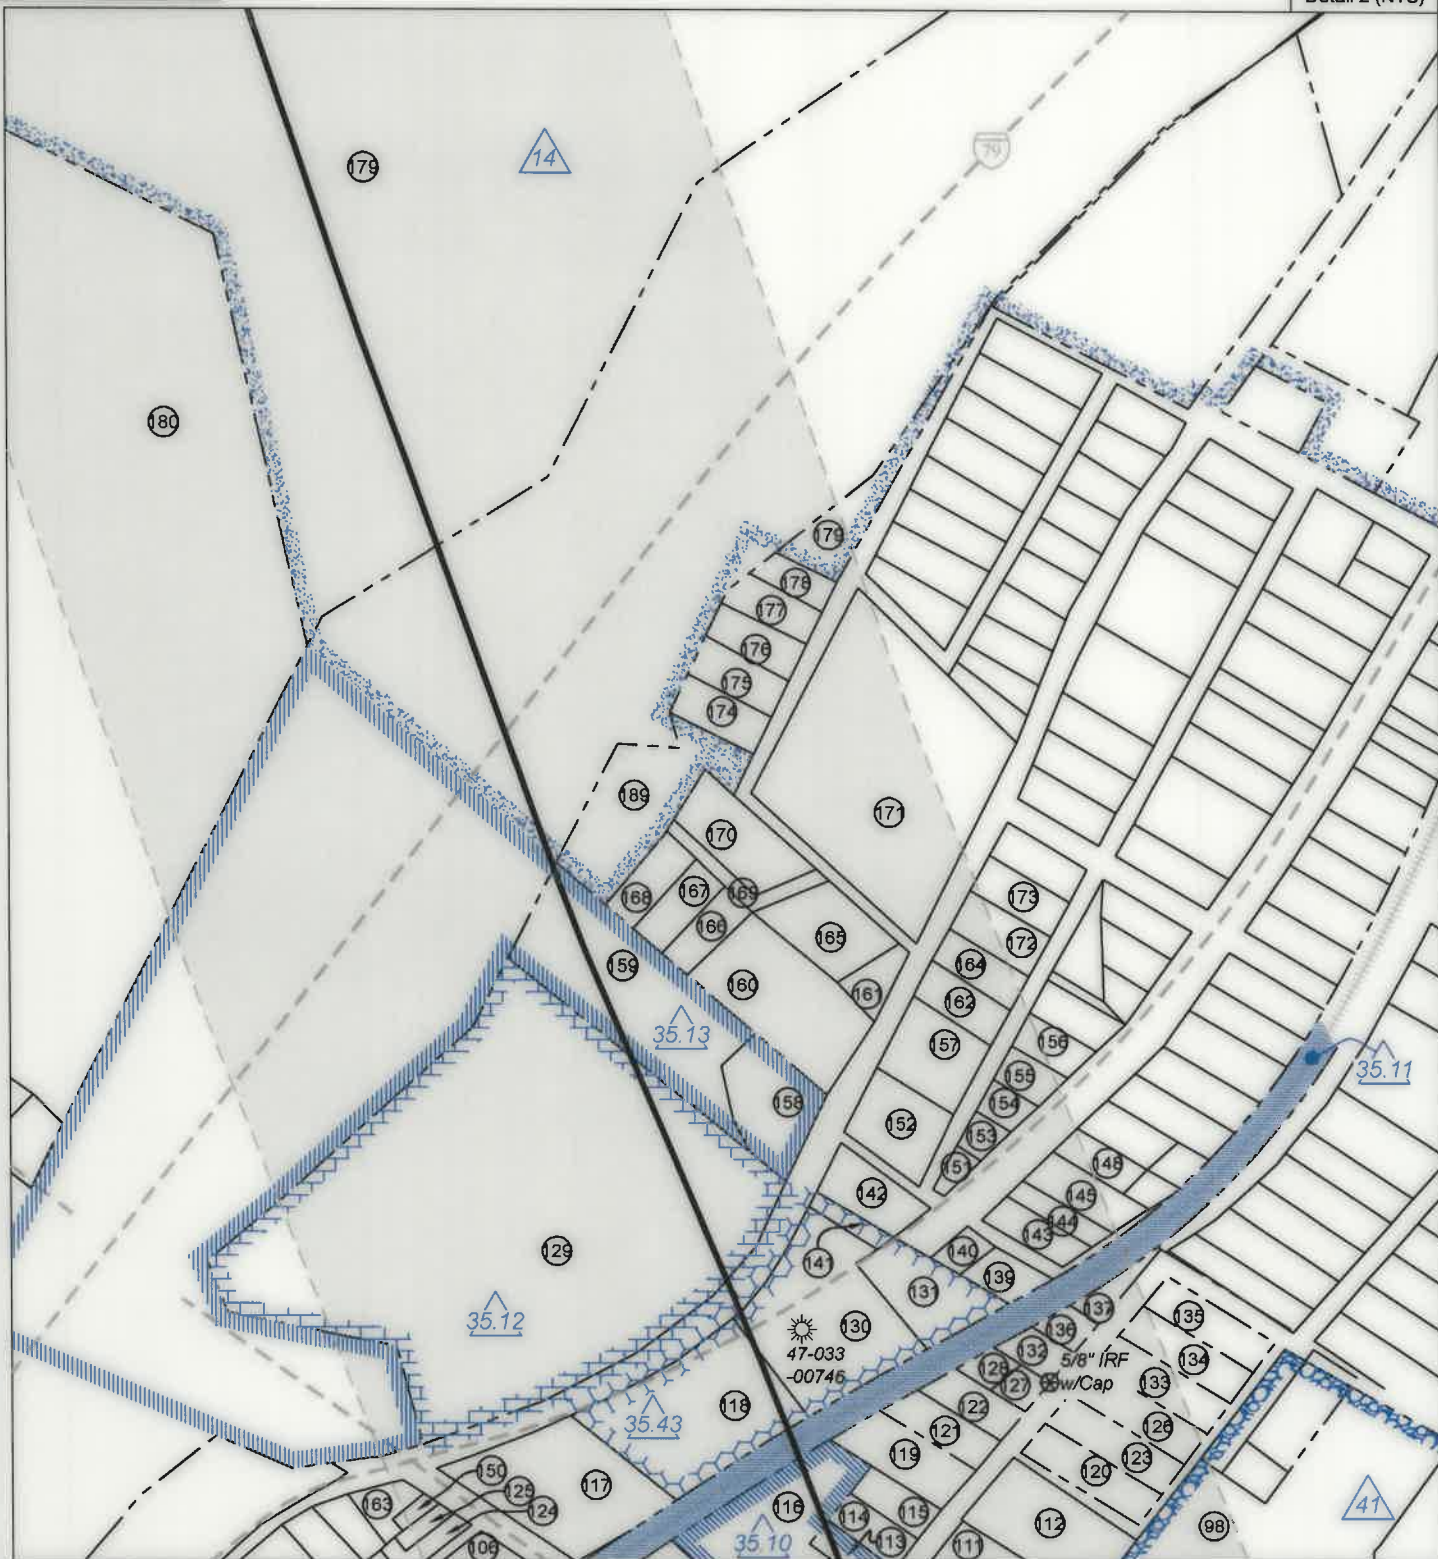

FILE NO: 32-36-G-19

DRAWING NO: Schoen 1205 N4H Well Plat

SCALE: 1" = 2000'

MINIMUM DEGREE OF ACCURACY:
Submeter

PROVEN SOURCE OF ELEVATION:
CORS, Bridgeport, WV

STATE OF WEST VIRGINIA
DEPARTMENT OF ENVIRONMENTAL PROTECTION
OIL AND GAS DIVISION

DATE: May 14 20 25

OPERATOR'S WELL NO. Schoen 1205 N-4H

API WELL NO

47 — 033 — 06011
STATE COUNTY PERMIT

WELL TYPE: ☐ OIL ☒ GAS ☐ LIQUID INJECTION ☐ WASTE DISPOSAL
(IF GAS) PRODUCTION: ☐ STORAGE ☐ DEEP ☒ SHALLOW

LOCATION: ELEVATION: 1,407.3' WATERSHED: Middle West Fork Creek

DISTRICT: Grant / Union

SURFACE OWNER: George & Rosanne Schoen

ROYALTY OWNER: Willa Post Robey, et al

LEASE NO: ACREAGE: 78.20

PROPOSED WORK: ☒ DRILL ☐ CONVERT ☐ DRILL DEEPER ☐ FRACTURE OR STIMULATE ☐ PLUG OFF OLD FORMATION
☐ PERFORATE NEW FORMATION ☒ OTHER PHYSICAL CHANGE IN WELL (SPECIFY) As-Drilled

☐ PLUG AND ABANDON ☐ CLEAN OUT AND REPLUG TARGET FORMATION: Marcellus Shale ESTIMATED DEPTH: 7,419' TVD 18,884' MD

WELL OPERATOR: HG Energy II Appalachia, LLC

DESIGNATED AGENT: Diane C. White

ADDRESS: 5260 Dupont Road
Parkersburg, WV 26101

ADDRESS: 5260 Dupont Road
Parkersburg, WV 26101

QUADRANGLE: Top: Mount Clare
Btm: West Milford

COUNTY: 09/19/2025


ACREAGE: 65.00



HG Energy II
Appalachia, LLC
Well No. Schoen
1205 N-4H
As-Drilled

Page 4 of 5

Well Location References
Not to Scale

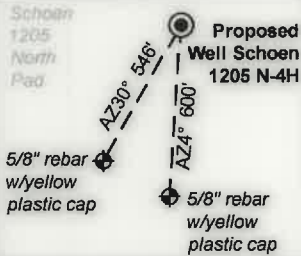

No.	TM / Par	Owner	Bk / Pg	Ac.
1	447 / 2	George & Roseanne Schoen	1148 / 1059	65.00
2	447 / 3	George & Roseanne Schoen	1253 / 302	10.06
3	447 / 3.4	Stephen M. & Kimberly Goff	1257 / 189	7.67
4	447 / 3.5	Charlotte Gerlach	1288 / 503	1.35
5	447 / 4.11	Joseph & Karen Bowers	1295 / 887	21.87
6	447 / 3.3	Charlotte C. Gerlach	1070 / 1041	6.10
7	447 / 3.2	Michael Tillman & Mary Hencke	1257 / 193	5.86
8	447 / 1	Dale H. Jordan	1437 / 672	6.70
9	427 / 32	Dale Jordan	1437 / 672	4.85
10	2105 / 123	Helen J. Vernon	W189 / 882	0.06
11	2105 / 115	Eugebe R. & Sharon L. Smith	1039 / 160	0.18
12	2105 / 114	Eugene R. & Sharon L. Smith	1039 / 160	0.27
13	2105 / 113	Roberts A. & Ruby A. Marks	1251 / 504	0.39
14	2105 / 111	Robert M. & Connie J. Lewis	1518 / 814	0.45
15	2105 / 40	Robert A. & Ruby A. Marks	1251 / 504	0.52
16	2105 / 110	Herman Suttle, et al	1345 / 1030	0.21
17	2105 / 105	Ronald Maxwell	1580 / 1167	---
18	2105 / 93	Joshua Burner & Nicole Hebb	1417 / 1075	1.39
19	2105 / 84	Joshua & Nicole Burner	1460 / 692	0.11
20	2105 / 95	Joseph Swick	1460 / 694	0.17
21	2105 / 89	James Frank Roby, et al	1491 / 941	0.50
22	2105 / 127	Dale Jordan	1626 / 1024	0.07
23	2105 / 128	Dale Jordan	1505 / 430	0.07
24	2105 / 82	Dale Jordan	1626 / 1024	0.11
25	2105 / 126	Dale Jordan	1626 / 1024	0.05
26	2105 / 83	Dale Jordan	1626 / 1024	0.15
27	2105 / 96	David B. & Thresa G. Davis	1263 / 196	0.20
28	2105 / 106	Ronald Maxwell	1580 / 1167	0.26
29	2105 / 107	Ronald Maxwell	1580 / 1167	0.20
30	2105 / 108	Ronald Maxwell	1580 / 1167	0.20
31	2105 / 109	Herman Suttle, et al	1345 / 1030	0.14
32	2105 / 39	Carol S. Bennett	1382 / 250	0.54
33	2105 / 38	Carol S. Bennett	1382 / 250	0.13
34	2105 / 37	Carol S. Bennett	1382 / 250	0.14
35	2105 / 35	Benjamin S. Yoke, et al	1544 / 1241	0.26
36	2105 / 104	Joshua R. & Stephanie L. Stalder	1525 / 989	0.23
37	2105 / 103	Joshua R. & Stephanie L. Stalder	1525 / 989	0.20
38	2105 / 102	Joshua R. & Stephanie L. Stalder	1525 / 989	0.20
39	2105 / 101	Joshua R. & Stephanie L. Stalder	1525 / 989	0.20
40	2105 / 100	Jeffrey A. Bassell, et al	W190 / 188	0.40

No.	TM / Par	Owner	Bk / Pg	Ac.
41	2105 / 97	Traci I. Tharp	1560 / 188	0.44
42	2105 / 87	David G. & Mary E. Short	1328 / 845	0.14
43	2105 / 86	David G. & Mary E. Short	1328 / 845	0.13
44	2105 / 85	Dale Jordan	1626 / 1024	0.11
45	2105 / 84	Dale Jordan	1626 / 1024	0.11
46	2105 / 125	Kenny J. & Randi E. Welch	1633 / 147	0.01
47	2105 / 78	Kenny J. & Randi E. Welch	1633 / 147	0.22
48	2105 / 80	Dale Jordan	1626 / 1024	0.11
49	2104 / 103	Daniel L. & Carla Ann Toothman	1436 / 151	0.32
50	2104 / 101	Willis Gene Kennedy	1412 / 590	0.14
51	2104 / 98	Willis Gene Kennedy	1412 / 590	0.54
52	2105 / 24	Charles M. & Joyce L. Hall	1364 / 280	0.40
53	2105 / 13	NAJ, LLC	1614 / 281	1.38
54	2105 / 13.1	Rodney K. Cooper, Sr., et al	W198 / 852	0.53
55	2105 / 28	Rebecca D. Stafford	1462 / 259	0.28
56	2105 / 29	Jeffrey A. Bassell, et al	W190 / 188	0.13
57	2105 / 30	Jeffrey A. Bassell, et al	W190 / 188	0.11
58	2105 / 31	William B. & Amy M. Messenger	1324 / 983	0.13
59	2105 / 32	William B. & Amy M. Messenger	1324 / 983	0.13
60	2105 / 33	Tracey R. Beall	1344 / 1213	0.19
61	2105 / 34	Tracey R. Beall	1344 / 1213	0.06
62	2105 / 18	Tracey R. Beall	1344 / 1213	0.80
63	2105 / 19	Town of Lost Creek	1110 / 480	1.01
64	2105 / 17	Town of Lost Creek	1110 / 505	---
65	2105 / 16.1	Lisa K. Maxwell	1515 / 823	0.19
66	2105 / 16	Ruth A. Backwell	1655 / 1214	0.25
67	2105 / 27	Shannon Q. & Srah R. Pitts	1333 / 203	0.38
68	2105 / 26	Shannon Q. & Sarah R. Pitts	1333 / 203	---
69	2105 / 16.2	Town of Lost Creek	1400 / 1227	0.25
70	2105 / 15	Town of Lost Creek	1110 / 473	---
71	2105 / 14	David A. & Linda J. Fultner	1467 / 325	0.18
72	427 / 33	Isaac & Betty Maxwell	1539 / 141	72.00
73	2104 / 96	Virginia May Harding	1054 / 1006	0.35
74	2105 / 6	Jimmie Langford Groves	1315 / 47	0.38
75	2105 / 5	Pamela & Stacy Ash Dutton	1388 / 865	0.33
76	2105 / 4	Sherman Riffle	1438 / 1331	0.27
77	2105 / 2	Sherman Riffle	1438 / 1331	0.71
78	2105 / 2.2	Gary Jones	1506 / 332	0.25
79	2105 / 2.1	Gary Jones	1506 / 332	0.17
80	2105 / 1	Gary Jones	1506 / 332	0.63
81	2103 / 176.2	Gary Jones	1506 / 332	0.05
82	2103 / 176.1	Patricia Booth	1301 / 834	0.46
83	2104 / 29.1	Walter Nutter	W154 / 30	---
84	2104 / 29	Keth E. Linger	1558 / 577	0.72
85	2104 / 39	Lost Creek UMC	1327 / 242	3.39
86	2103 / 176	Daniel T. & Lisa Booth	1311 / 899	0.43
87	2103 / 175	Daniel T. & Lisa Booth	1311 / 899	---
88	2104 / 28	Lisa I. Wageman	1239 / 457	0.06
89	2104 / 12	Parsons Ridge, LLC	1358 / 569	0.31
90	2104 / 27	Lost Creek UMC	786 / 520	---
91	2104 / 26	Trustees MP Church	144 / 447	---
92	2104 / 11	Lisa Wageman	1239 / 457	0.18
93	2104 / 10	George W. Dawson	1418 / 331	0.19
94	2104 / 25	Lost Creek UMC	1327 / 159	0.55
95	2104 / 9	Southern Area Library Inc.	1149 / 42	0.05
96	2104 / 8	Sharon Carol Smith	1286 / 730	0.44
97	2103 / 174	Betty Jean Maxwell	1315 / 502	1.50
98	2103 / 162	Betty Jean Maxwell	1315 / 502	4.20
99	2103 / 173	Issac & Betty Maxwell	1327 / 238	0.58
100	2103 / 172	Issac & Betty Maxwell	1428 / 684	0.50

FILE NO: 32-36-G-19

DRAWING NO: Schoen 1205 N4H Well Plat

SCALE: 1" = 2000'

MINIMUM DEGREE OF ACCURACY:
Submeter

PROVEN SOURCE OF ELEVATION:
CORS, Bridgeport, WV

STATE OF WEST VIRGINIA
DEPARTMENT OF ENVIRONMENTAL PROTECTION
OIL AND GAS DIVISION

DATE: May 14 20 25

OPERATOR'S WELL NO. Schoen 1205 N-4H

API WELL NO

47 - 033 - 06011
STATE COUNTY PERMIT

WELL TYPE: ☐ OIL ☒ GAS ☐ LIQUID INJECTION ☐ WASTE DISPOSAL
(IF GAS) PRODUCTION: ☐ STORAGE ☐ DEEP ☒ SHALLOW

LOCATION: ELEVATION: 1,407.3' WATERSHED: Middle West Fork Creek

DISTRICT: Grant / Union

SURFACE OWNER: George & Rosanne Schoen

ROYALTY OWNER: Willa Post Robey, et al

PROPOSED WORK: ☒ DRILL ☐ CONVERT ☐ DRILL DEEPER ☐ FRACTURE OR STIMULATE ☐ PLUG OFF OLD FORMATION
☐ PERFORATE NEW FORMATION ☒ OTHER PHYSICAL CHANGE IN WELL (SPECIFY) As-Drilled

☐ PLUG AND ABANDON ☐ CLEAN OUT AND REPLUG TARGET FORMATION: Marcellus Shale ESTIMATED DEPTH: 7,419' TVD 18,884' MD

WELL OPERATOR: HG Energy II Appalachia, LLC

DESIGNATED AGENT: Diane C. White

ADDRESS: 5260 Dupont Road

ADDRESS: 5260 Dupont Road

Parkersburg, WV 26101

Parkersburg, WV 26101

Top: Mount Clare
Btm: West Milford

COU 09/19/2025

ACREAGE: 65.00

ACREAGE: 78.20



HG Energy II
Appalachia, LLC
Well No. Schoen
1205 N-4H
As-Drilled

Page 5 of 5

No.	TM / Par	Owner	Bk / Pg	Ac.
101	2103 / 171.1	Dennis W. & Rose M. Chamberlain	1491 / 105	0.16
102	2104 / 7	Harrison County Bank	1064 / 1081	0.46
103	2104 / 25.1	Harrison County Bank	1067 / 224	0.13
104	2104 / 21	Associated Pharmacists	1362 / 948	0.10
105	2104 / 6	Town of Lost Creek	1398 / 283	---
106	2104 / 5	Sue Bennett	1132 / 132	0.29
107	2103 / 169	Chamberlain Brothers, Inc.	1206 / 1228	0.24
108	2103 / 170.1	Kimberly & Sharon Wriston	W83 / 97	0.29
109	2103 / 171	Carla McGlumphy	1398 / 55	0.09
110	2103 / 164	Carla McGlumphy	1398/55	0.06
111	2103 / 167	Timothy Maxwell	1541 / 298	0.50
112	2103 / 161	Cathy D. Bennett	F115 / 867	0.51
113	2103 / 164.1	Kimberly P. Smith, et al	1064 / 787	0.17
114	2103 / 165	Cathy D. Bennett	F115 / 867	0.12
115	2103 / 166	Cathy D. Bennett	F115 / 867	0.12
116	2103 / 170	Kimberly Wriston, et al	W87 / 97	0.54
117	2103 / 168	Chamberlain Brothers Inc.	1206 / 1228	0.75
118	2103 / 163	Chamberlain Brothers Inc.	1206 / 1228	0.79
119	2103 / 152	Cathy D. Bennett	F115 / 867	0.26
120	2103 / 160	Amanda Nutter	1437 / 204	0.21
121	2103 / 153	Jerry A. Hebb, et al	1307 / 78	0.16
122	2103 / 154	Barbara Jo Butcher	1446 / 539	0.13
123	2103 / 159	Brian Riffle	1507 / 119	0.20
124	2104 / 4	Carol S. Bennett	1582 / 290	0.07
125	2104 / 3	Town of Lost Creek	1110 / 493	---
126	2103 / 158	Sharon L. Smith, et al	F96 / 94	0.20
127	2103 / 155.1	Barbara Jo Butcher	1446 / 539	0.06
128	2103 / 155	Sharon L. Smith, et al	F96 / 94	---
129	427 / 26	Stanley & Marilyn Coleman	1236 / 37	5.57
130	2103 / 150	Darrell W. & Kathryn Goldsmith	1314 / 124	1.01
131	2103 / 150.1	John & Beth Elko	1358 / 606	0.31
132	2103 / 156	Mark Alen Duty	1581 / 305	0.05
133	2103 / 147	Sharon Smith, et al	F96 / 94	0.20
134	2103 / 133	Sharon Smith, et al	F96 / 94	0.19
135	2103 / 134	Kathryn Lynn Goldsmith, et al	1630 / 492	0.19
136	2103 / 146	Joshua Cogar, et al	W174 / 683	0.04
137	2103 / 132	Joshua Cogar, et al	W174 / 683	---
138	2104 / 39.1	Lost Creek UMC	1327 / 159	0.31
139	2103 / 145	Joshua Cogar	W174 / 683	0.11
140	2103 / 144	Joshua T. Cogar	1476 / 90	0.07
141	2103 / 149.1	Erika Langford & Aimee Ziemann	1597 / 972	0.07
142	2103 / 143	Erika Langford & Aimee Ziemann	1597 / 972	0.16
143	2103 / 131	Joshua Cogar	1476 / 90	0.13
144	2103 / 130	Joshua Cogar	W174 / 683	0.13
145	2103 / 129	Joshua Cogar	W174 / 683	0.19
146	2104 / 22	Associated Pharmacists	1362 / 948	0.04
147	2104 / 23	Associated Pharmacists	1362 / 948	0.07
148	2103 / 127	David & Brenda Cogar	1516 / 166	0.13
149	2104 / 20	Susan Randall, et al	W111 / 841	0.07
150	2104 / 2	Denny W. Chamberlain	1436 / 1170	0.03

ID	Lease
8	Porter & Bertha B. Maxwell, et al
12	E.S. & Nettie M. Swisher, et al
14	Mollie V. Bassell, et al
19	Emma A. Post, et vir, et al
35.01	Emily Post Fenton
35.02	William F. Vieweg
35.03	Terrance L. Bassell
35.04	Ario Minerals, LLC
35.05	Alicia N. & Donald Thompson
35.06	NAJ, LLC
35.07	Judith A. Suess Memear
35.08	Isaac H. Maxwell, III, et ux

ID	Lease
35.09	Isaac H. Maxwell, III, et ux
35.10	Kimberly Smith Wriston
35.11	WV DOT Rail Authority
35.12	Stanley J. Coleman, et ux
35.13	Stanley J. Coleman
35.14	Shannon Q. & Sarah R. Pritts
35.43	Allen Stalnaker, et ux
35.44	Carla McGlumphy
39	A.B. Post, et al
40	Charlotte C. Gerlach, et vir
41	D.L. Nutter, et ux
55	French S. Young, et ux

No.	TM / Par	Owner	Bk / Pg	Ac.
151	2103 / 121	David N. Daugherty	1499 / 649	0.03
152	2103 / 120	David N. Daugherty	1367 / 808	0.30
153	2103 / 122	David N. Daugherty	1499 / 649	0.05
154	2103 / 123	Randall B. Burrows, Jr.	1549 / 737	0.07
155	2103 / 124	Susan E. Desjardins	1664 / 73	0.08
156	2103 / 111	Susan E. Desjardins	1664 / 73	0.11
157	2103 / 119	David N. Daugherty	1423 / 404	0.30
158	427 / 26.1	Everett & Richard Casto	1390 / 822	0.34
159	427 / 26.3	Harold & Wilford Vanhorn	1230 / 301	1.03
160	2103 / 118	Judith Vanhorn	1428 / 1118	0.60
161	2103 / 109.1	Betty & Emerson Vanhorn	1601 / 43	0.10
162	2103 / 110	Board of Education	376 / 483	0.14
163	2104 / 1	Denny W. Chamberlain	1436 / 1170	0.13
164	2103 / 101	Board of Education	376 / 483	0.14
165	2103 / 108	Emerson & Betty Vanhorn	1601 / 43	0.32
166	2103 / 117	David A. & Vanessa L. Fisher	1083 / 778	0.14
167	2103 / 116	David A. & Vanessa L. Fisher	1083 / 778	0.14
168	2103 / 115	David A. & Vanessa L. Fisher	1083 / 778	0.14
169	2103 / 178	David & Vanessa Fisher	1108 / 565	0.12
170	2103 / 106	David A. & Vanessa L. Fisher	1083 / 778	0.31
171	2103 / 77	Board of Education	240 / 114	1.90
172	2103 / 95	Steve & Gwen Lake	1268 / 659	0.15
173	2103 / 90	Rhonda Martin	1551 / 277	0.14
174	2103 / 89	Board of Education	593 / 315	0.13
175	2103 / 83	Board of Education	593 / 315	0.13
176	2103 / 76	Board of Education	593 / 315	0.13
177	2103 / 69	Board of Education	593 / 315	0.13
178	2103 / 62	Board of Education	593 / 315	0.13
179	427 / 1	Walter E. Nutter & David H. Nutter	W154 / 301	228.23
180	426 / 62	Dorothy Dawson	W148 / 1062	16.13
181	426 / 36	George Wesley & Amy June Dawson	1310 / 247	61.96
182	426 / 35.5	Lost Creek Salvage LLC	1503 / 933	11.53
183	426 / 35.8	Lost Creek Salvage LLC	539 / 1088	85.23
184	426 / 12	Annette J. Cobun	1496 / 38	84.79
185	406 / 48	Annette J. Cobun	1496 / 39	15.43
186	406 / 47	Annette J. Cobun	1496 / 39	72.13
187	406 / 24	Clearnece H. Ford, II & Connie Ferguson	414 / 352	160.49
188	406 / 25	Isaac, III & Betty Jean Maxwell	1509 / 934	255.21
189	427 / 26.2	David A. & Vanessa L. Fisher	1101 / 533	13.75
190	427 / 31	Willis G. Kennedy	1412 / 590	18.60

FILE NO: 32-36-G-19

DRAWING NO: Schoen 1205 N4H Well Plat

SCALE: 1" = 2000'

MINIMUM DEGREE OF ACCURACY:
Submeter

PROVEN SOURCE OF ELEVATION:
CORS, Bridgeport, WV

STATE OF WEST VIRGINIA
DEPARTMENT OF ENVIRONMENTAL PROTECTION
OIL AND GAS DIVISION

DATE: May 14 20 25

OPERATOR'S WELL NO. Schoen 1205 N-4H

API WELL NO

47 - 033 - 06011
STATE COUNTY PERMIT

WELL TYPE: ☐ OIL ☒ GAS ☐ LIQUID INJECTION ☐ WASTE DISPOSAL
(IF GAS) PRODUCTION: ☐ STORAGE ☐ DEEP ☒ SHALLOW

LOCATION: ELEVATION: 1,407.3' WATERSHED: Middle West Fork Creek

DISTRICT: Grant / Union

SURFACE OWNER: George & Rosanne Schoen

ROYALTY OWNER: Willa Post Robey, et al

LEASE NO: ACREAGE: 78.20

PROPOSED WORK: ☒ DRILL ☐ CONVERT ☐ DRILL DEEPER ☐ FRACTURE OR STIMULATE ☐ PLUG OFF OLD FORMATION
☐ PERFORATE NEW FORMATION ☒ OTHER PHYSICAL CHANGE IN WELL (SPECIFY) As-Drilled

☐ PLUG AND ABANDON ☐ CLEAN OUT AND REPLUG TARGET FORMATION: Marcellus Shale ESTIMATED DEPTH: 7,419' TVD 18,884' MD

WELL OPERATOR: HG Energy II Appalachia, LLC

DESIGNATED AGENT: Diane C. White

ADDRESS: 5260 Dupont Road

ADDRESS: 5260 Dupont Road

Parkersburg, WV 26101

Parkersburg, WV 26101

Top: Mount Clare
Btm: West Milford

QUADRANGLE: 09/19/2025

ACREAGE: 65.00